


RECORD DRAWING  
1/9/2008  
MLT

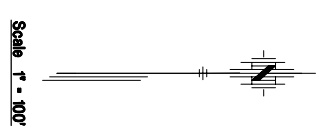

**LEGEND**

- = Direction of Flow
- = Temporary Seeding Area (200 lbs/acre Rye Grass)
- = Permanent Seeding Area (350 lbs/acre KS Premium Blend Fescue)
- = Back of Curb Protection (w/ Temporary Seeding)
- = Sediment Barrier (Ditch Check/Inlet)

**Storm Water Pollution Prevention Plan - Phase 2**

**TERRADYNE WEST**

An Addition to Wichita - Sedgwick County, Kansas

**NOTES:**

1. Contractor shall grade all right-of-way areas according to elevations shown on Lot Grading Plan. (Cost subsidiary to Site Clearing/Restoration.)
2. Contractor shall seed all disturbed areas within Reserves B, C, and D with temporary grass. See General Notes for seeding information. Total Area = 2.26 Acres.
3. Contractor shall seed ditch grading within Rights-of-Way with permanent grass. See General Notes for seeding information. Total Area = 0.27 Acres.
4. Back of curb protection shall be installed behind all curbs as shown with a width of not less than 8', and the protected area shall be seeded with temporary grass (see temporary seeding area). Total Area = 6,938 SY

No.	Date	By	Approved	Revision
1	1/9/08	MLT	JPD	Moved Curb Inlet South to New Location

TERRADYNE WEST ADDITION  
STREET & STORM SEWER IMPROVEMENTS  
STORM WATER POLLUTION PREVENTION PLAN  
CITY OF WICHITA, KANSAS  
JAMES L. ARMOUR, P.E. - CITY ENGINEER  
Private Project # 179PPP OCA# 607879

**POE & ASSOCIATES, INC.**  
CONSULTING ENGINEERS  
5940 E. Central, Suite 200 ■ Wichita, KS 67208-4242  
Phone 316/685-4114 ■ FAX 316/685-4444



<b>FINAL</b>	
Designed By:	J. Ubert / J. Dickman
Drawn By:	M. Tucker
Poe Job No.:	1809
Date:	April 2007