


3	KANSAS	1970	155	224
---	--------	------	-----	-----

150

FINAL SURVEY	SURVEYED PLOTTED TEMPLATE AREAS	AREAS CH
NOTE BOOK		
NO.		

ORIGINAL SURVEY	SURVEYED PLOTTED
NOTE BOOK	TEMPLATE AREAS

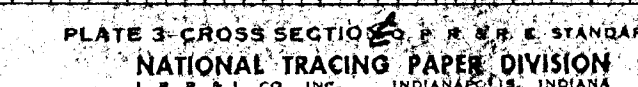

ML Sta. 282+00 to Sta. 285+00