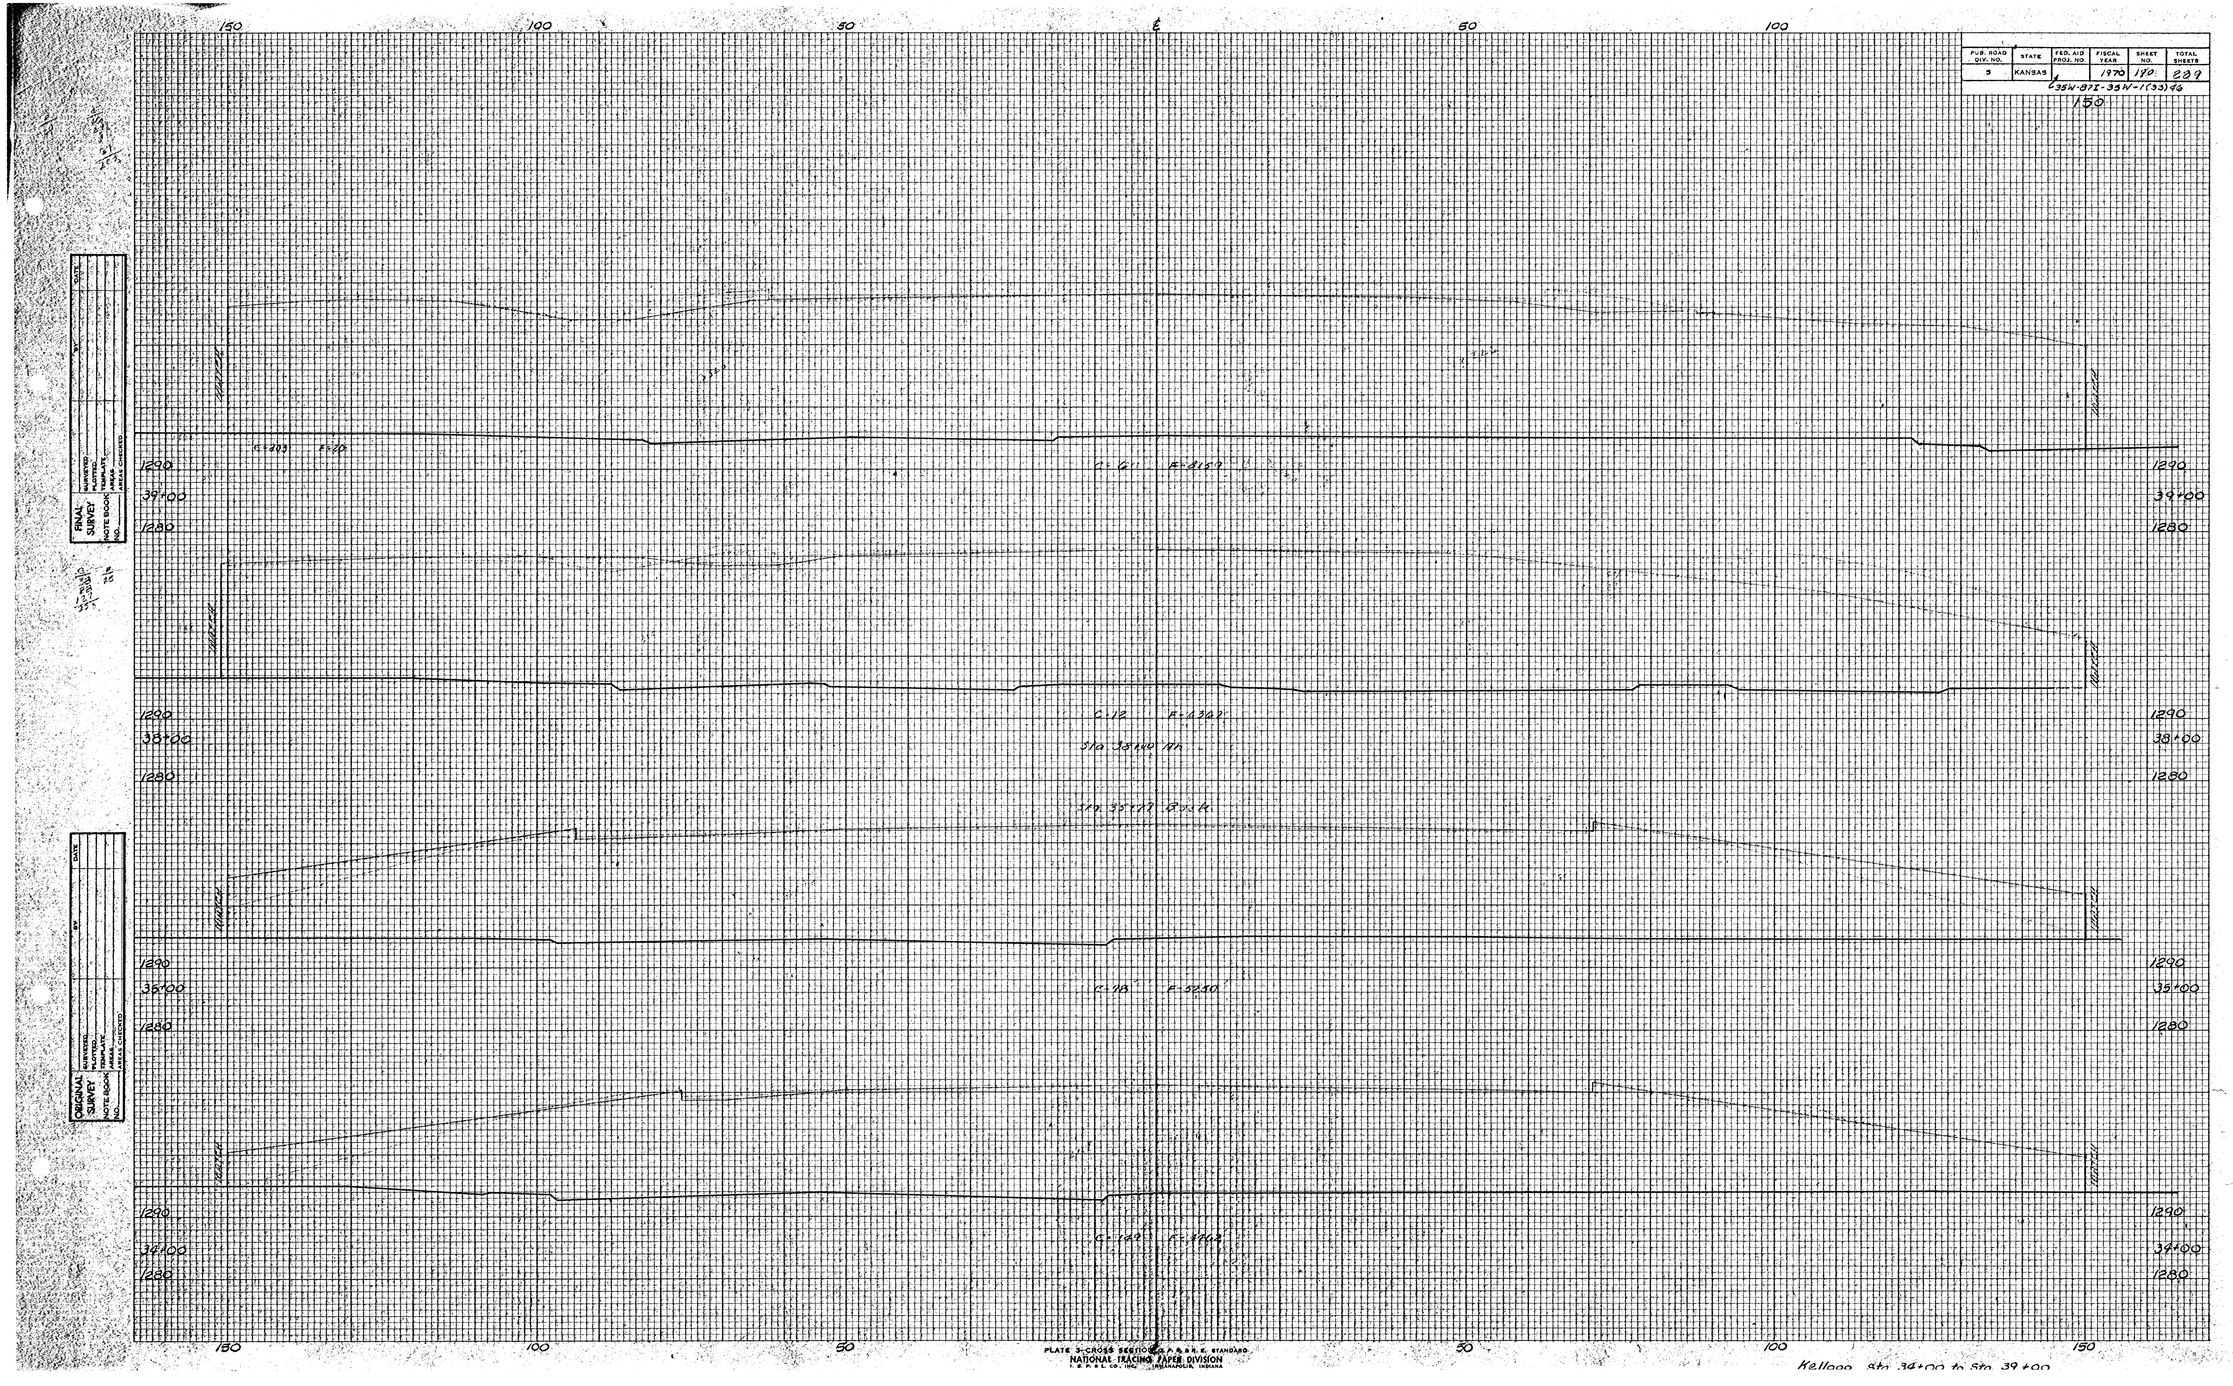
150
100
50
℄
50
100
150
PUB. ROAD DIV. NO. 3
STATE KANSAS
FED. AID PROJ. NO. 4-35W-8(7)-35W-1(33)46
FISCAL YEAR 1970
SHEET NO. 170
TOTAL SHEETS 239
FINAL SURVEY
ORIGINAL SURVEY
SURVEYED
PLOTTED
NOTE BOOK
AREAS CHECKED
C=20.3 E=1.0
C=6 E=21.5?
C=12 E=43.9?
Sta 38+40 ℄
Sta 38+17 Bridge
C=18 E=52.0
C=14? E=41.0?
1290
1280
39+00
38+00
35+00
34+00
PLATE S-CROSS SECTION C.E.P.R.R.E. STANDARD
NATIONAL TRACING PAPER DIVISION
I. E. P. & L. CO., INC. INDIANAPOLIS, INDIANA
Kellogg Sta 34+00 to Sta 39+00