

FHWA REGION NO.	STATE	PROJECT NO.	YEAR	SHEET NO.	TOTAL SHEETS
7	KANSAS		1978	14	143

PROJ NO. (BC) 96-87 K-044-1 (28) PTS. I & II

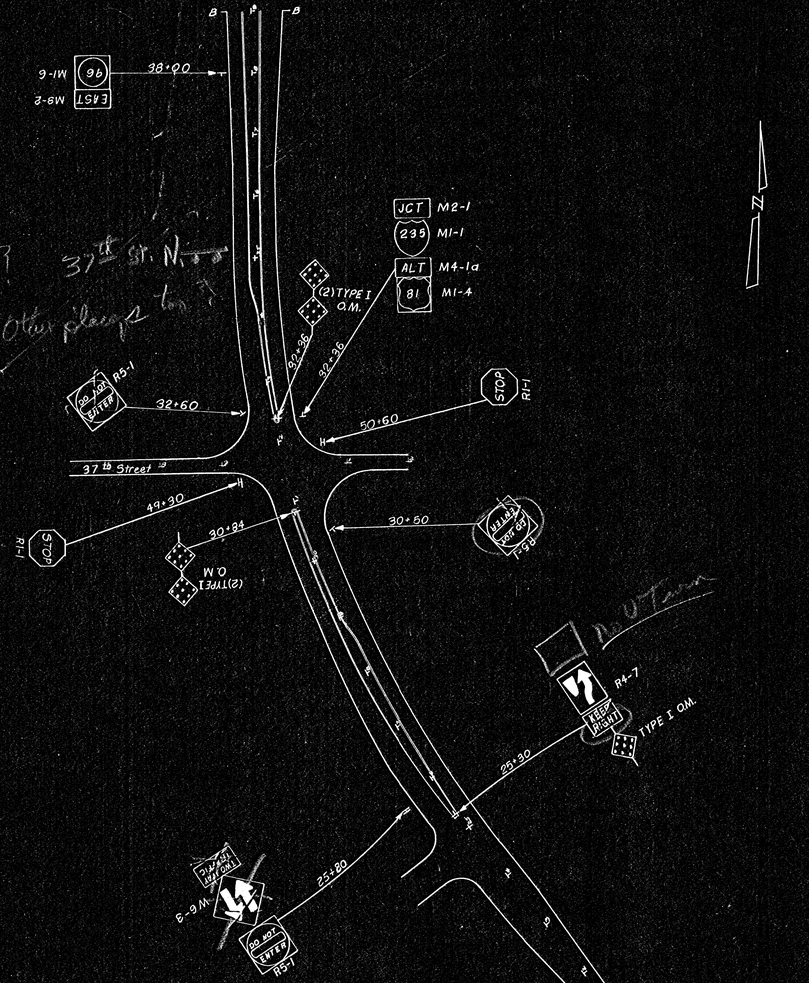

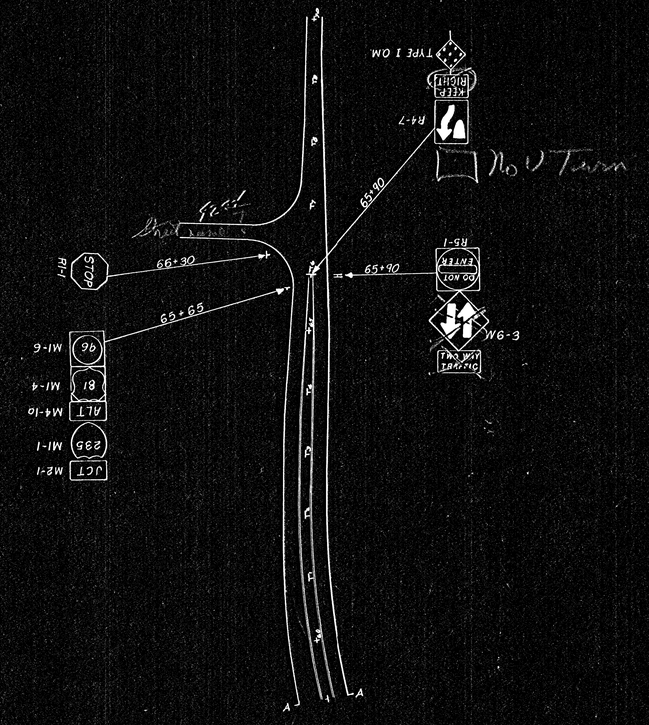

NOTE: Signs & Copy Not To Scale

NO.	DATE	REVISIONS	BY	APP'D
3				
2				
1				

DEPARTMENT OF TRANSPORTATION — KANSAS

MERIDIAN AVENUE
Sta: 17+00 to Sta: 39+00 &
Sta: 59+00 to Sta: 70+00

SHEET NO. 14 OF 143	SCALE 1" = 100'-0"	APP'D	
DESIGNED W	DETAILED W	QUANTITIES	TRACED W
DESIGN CK.	DETAIL CK.	QUAN. CK.	TRACE CK.