


FIELD NO.	STATE	PROJECT NO.	YEAR	SHEET NO.	TOTAL SHEETS
7	KANSAS		1978	15	143

PROJ. NO. (BC) 96-87 K-044-1(28) PTS. I & II

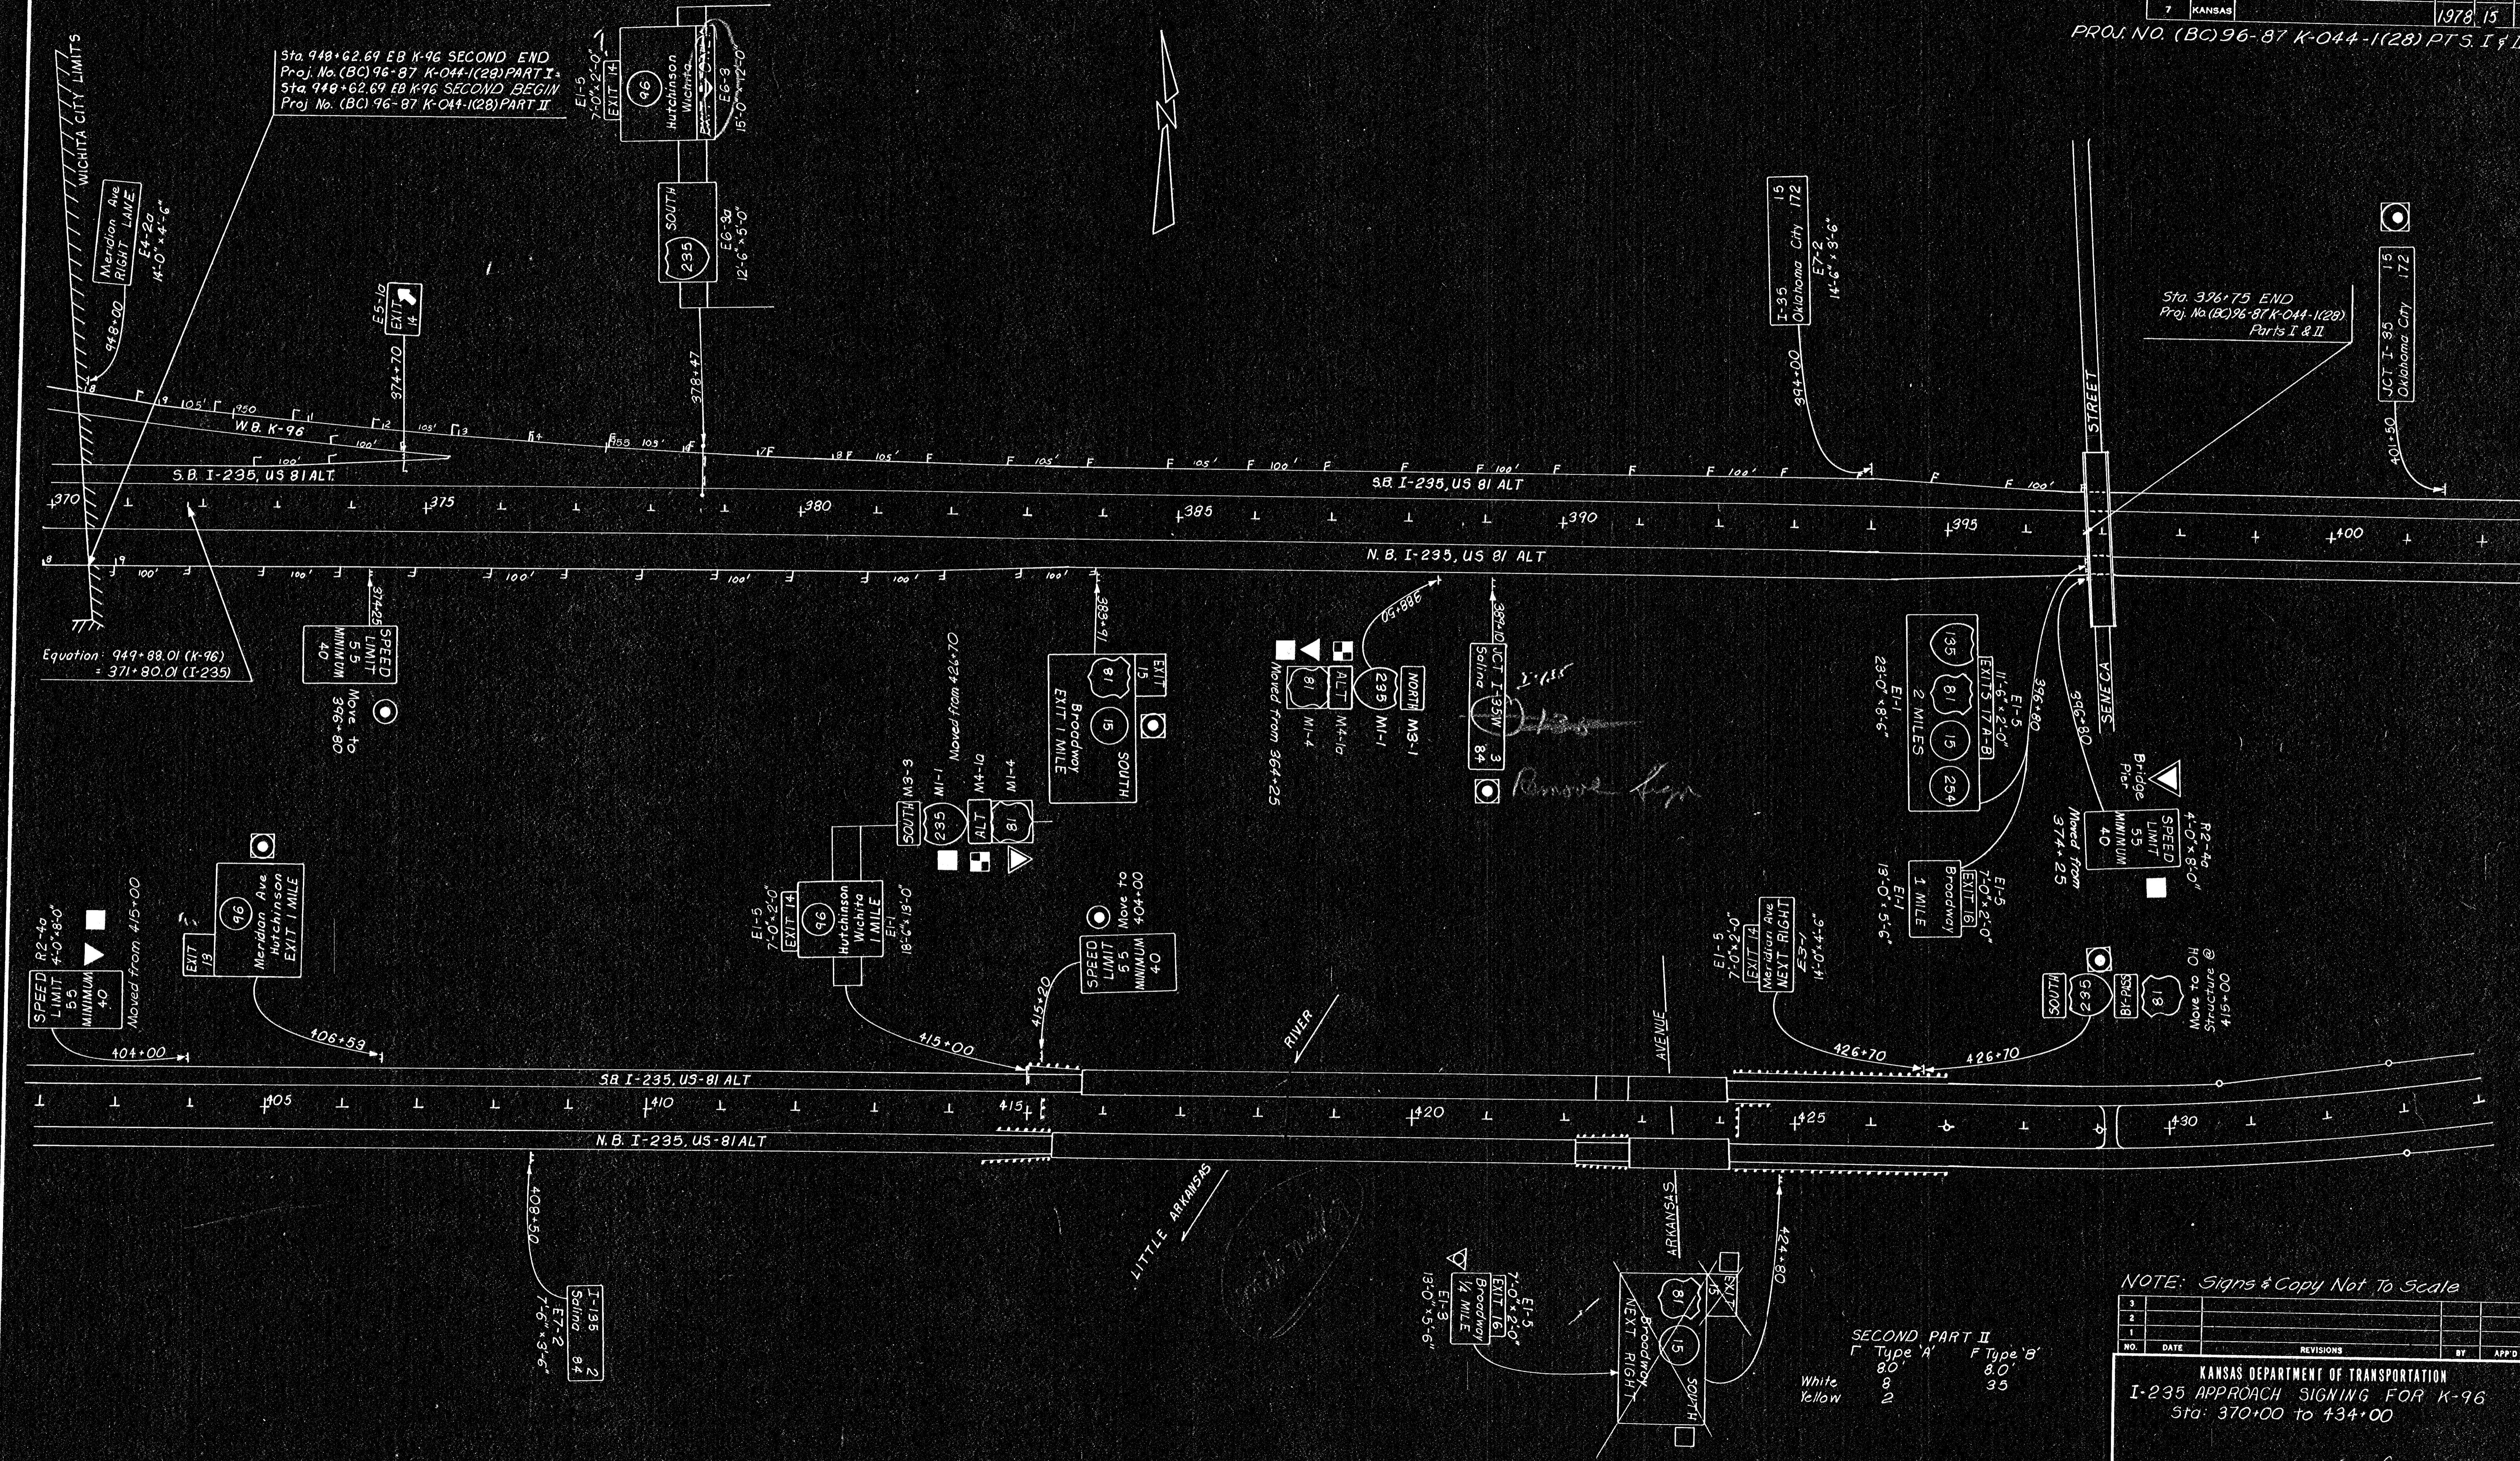

NOTE: Signs & Copy Not To Scale

NO.	DATE	REVISIONS	BY	APP'D
3				
2				
1				

KANSAS DEPARTMENT OF TRANSPORTATION
 I-235 APPROACH SIGNING FOR K-96
 Sta: 370+00 to 434+00

SHEET NO. 15 OF 143	SCALE 1" = 100'	APP'D	DESIGNED DDG	DETAILED DDG	QUANTITIES	TRACES DDG
DESIGN CK.	DETAIL CK.	QUAN. CK.				

SECOND PART II
 Type 'A' 80'
 Type 'B' 35'
 White
 Yellow