
| FINAL REVISION NO. | STATE | PROJECT NO. | YEAR | SHEET NO. | TOTAL SHEETS |
|---|---|---|---|---|---|
| 7 | KANSAS | | 1978 | 16 | 143 |

PROJ. NO. (BC) 96-87 K-044-1(28) PTS. I & II

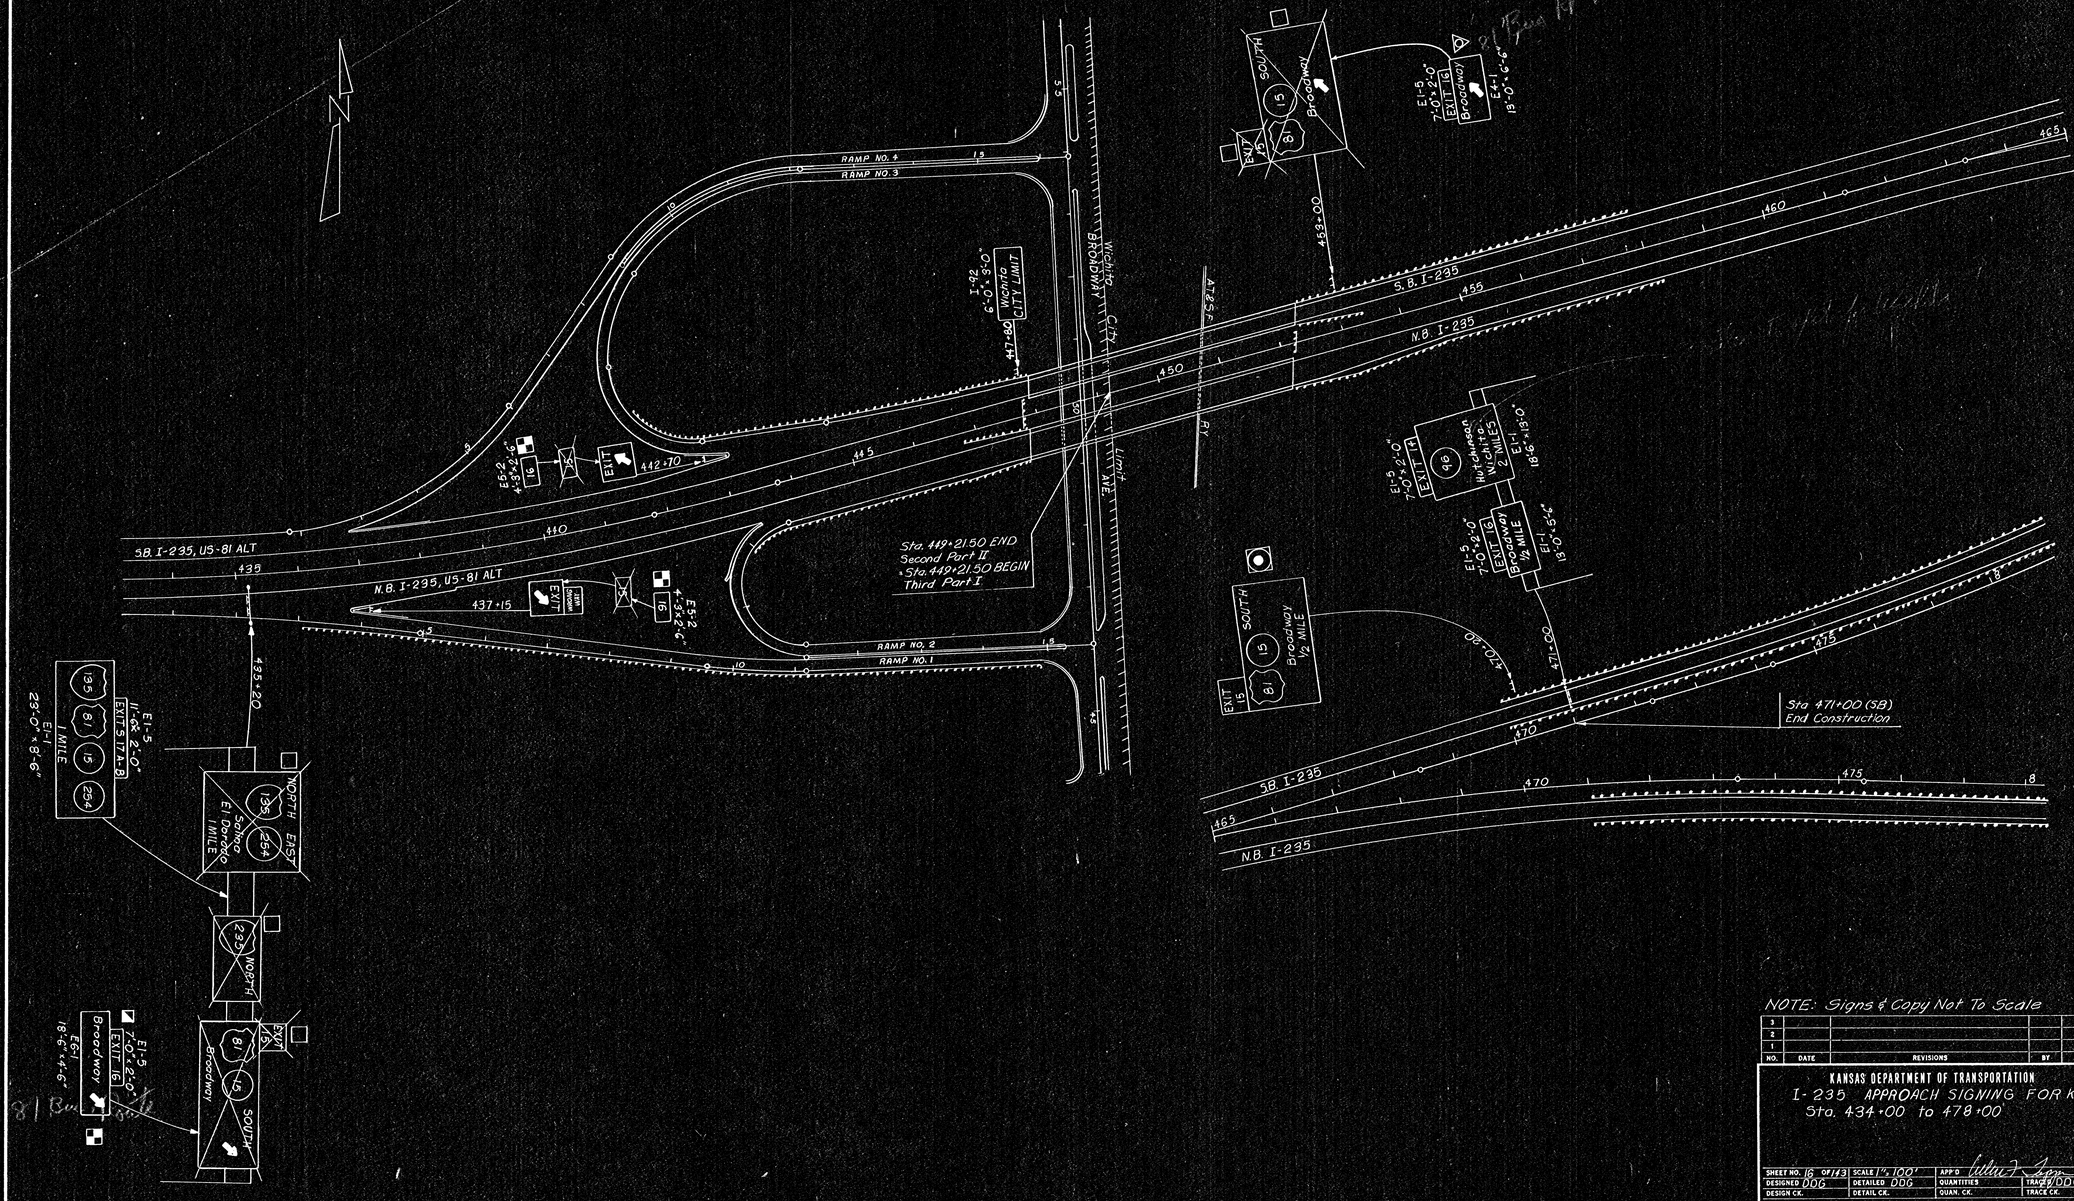


NOTE: Signs & Copy Not To Scale

| NO. | DATE | REVISIONS | BY | APP'D |
|---|---|---|---|---|
| 3 | | | | |
| 2 | | | | |
| 1 | | | | |

KANSAS DEPARTMENT OF TRANSPORTATION

I-235 APPROACH SIGNING FOR K-96

Sta. 434+00 to 478+00

| | | | |
|---|---|---|---|
| SHEET NO. 16 OF 143 | SCALE 1"=100' | APP'D | |
| DESIGNED DDG | DETAILED DDG | QUANTITIES | TRACED DDG |
| DESIGN CK. | DETAIL CK. | QUAN. CK. | TRACE CK. |