


| FHWA REGION | STATE  | PROJECT NO. | YEAR | SHEET NO. | TOTAL SHEETS |
|-------------|--------|-------------|------|-----------|--------------|
| 7           | KANSAS |             | 1978 | 16        | 143          |

PROJ. NO. (BC)96-87 K-044-1(28) PTS. I & II

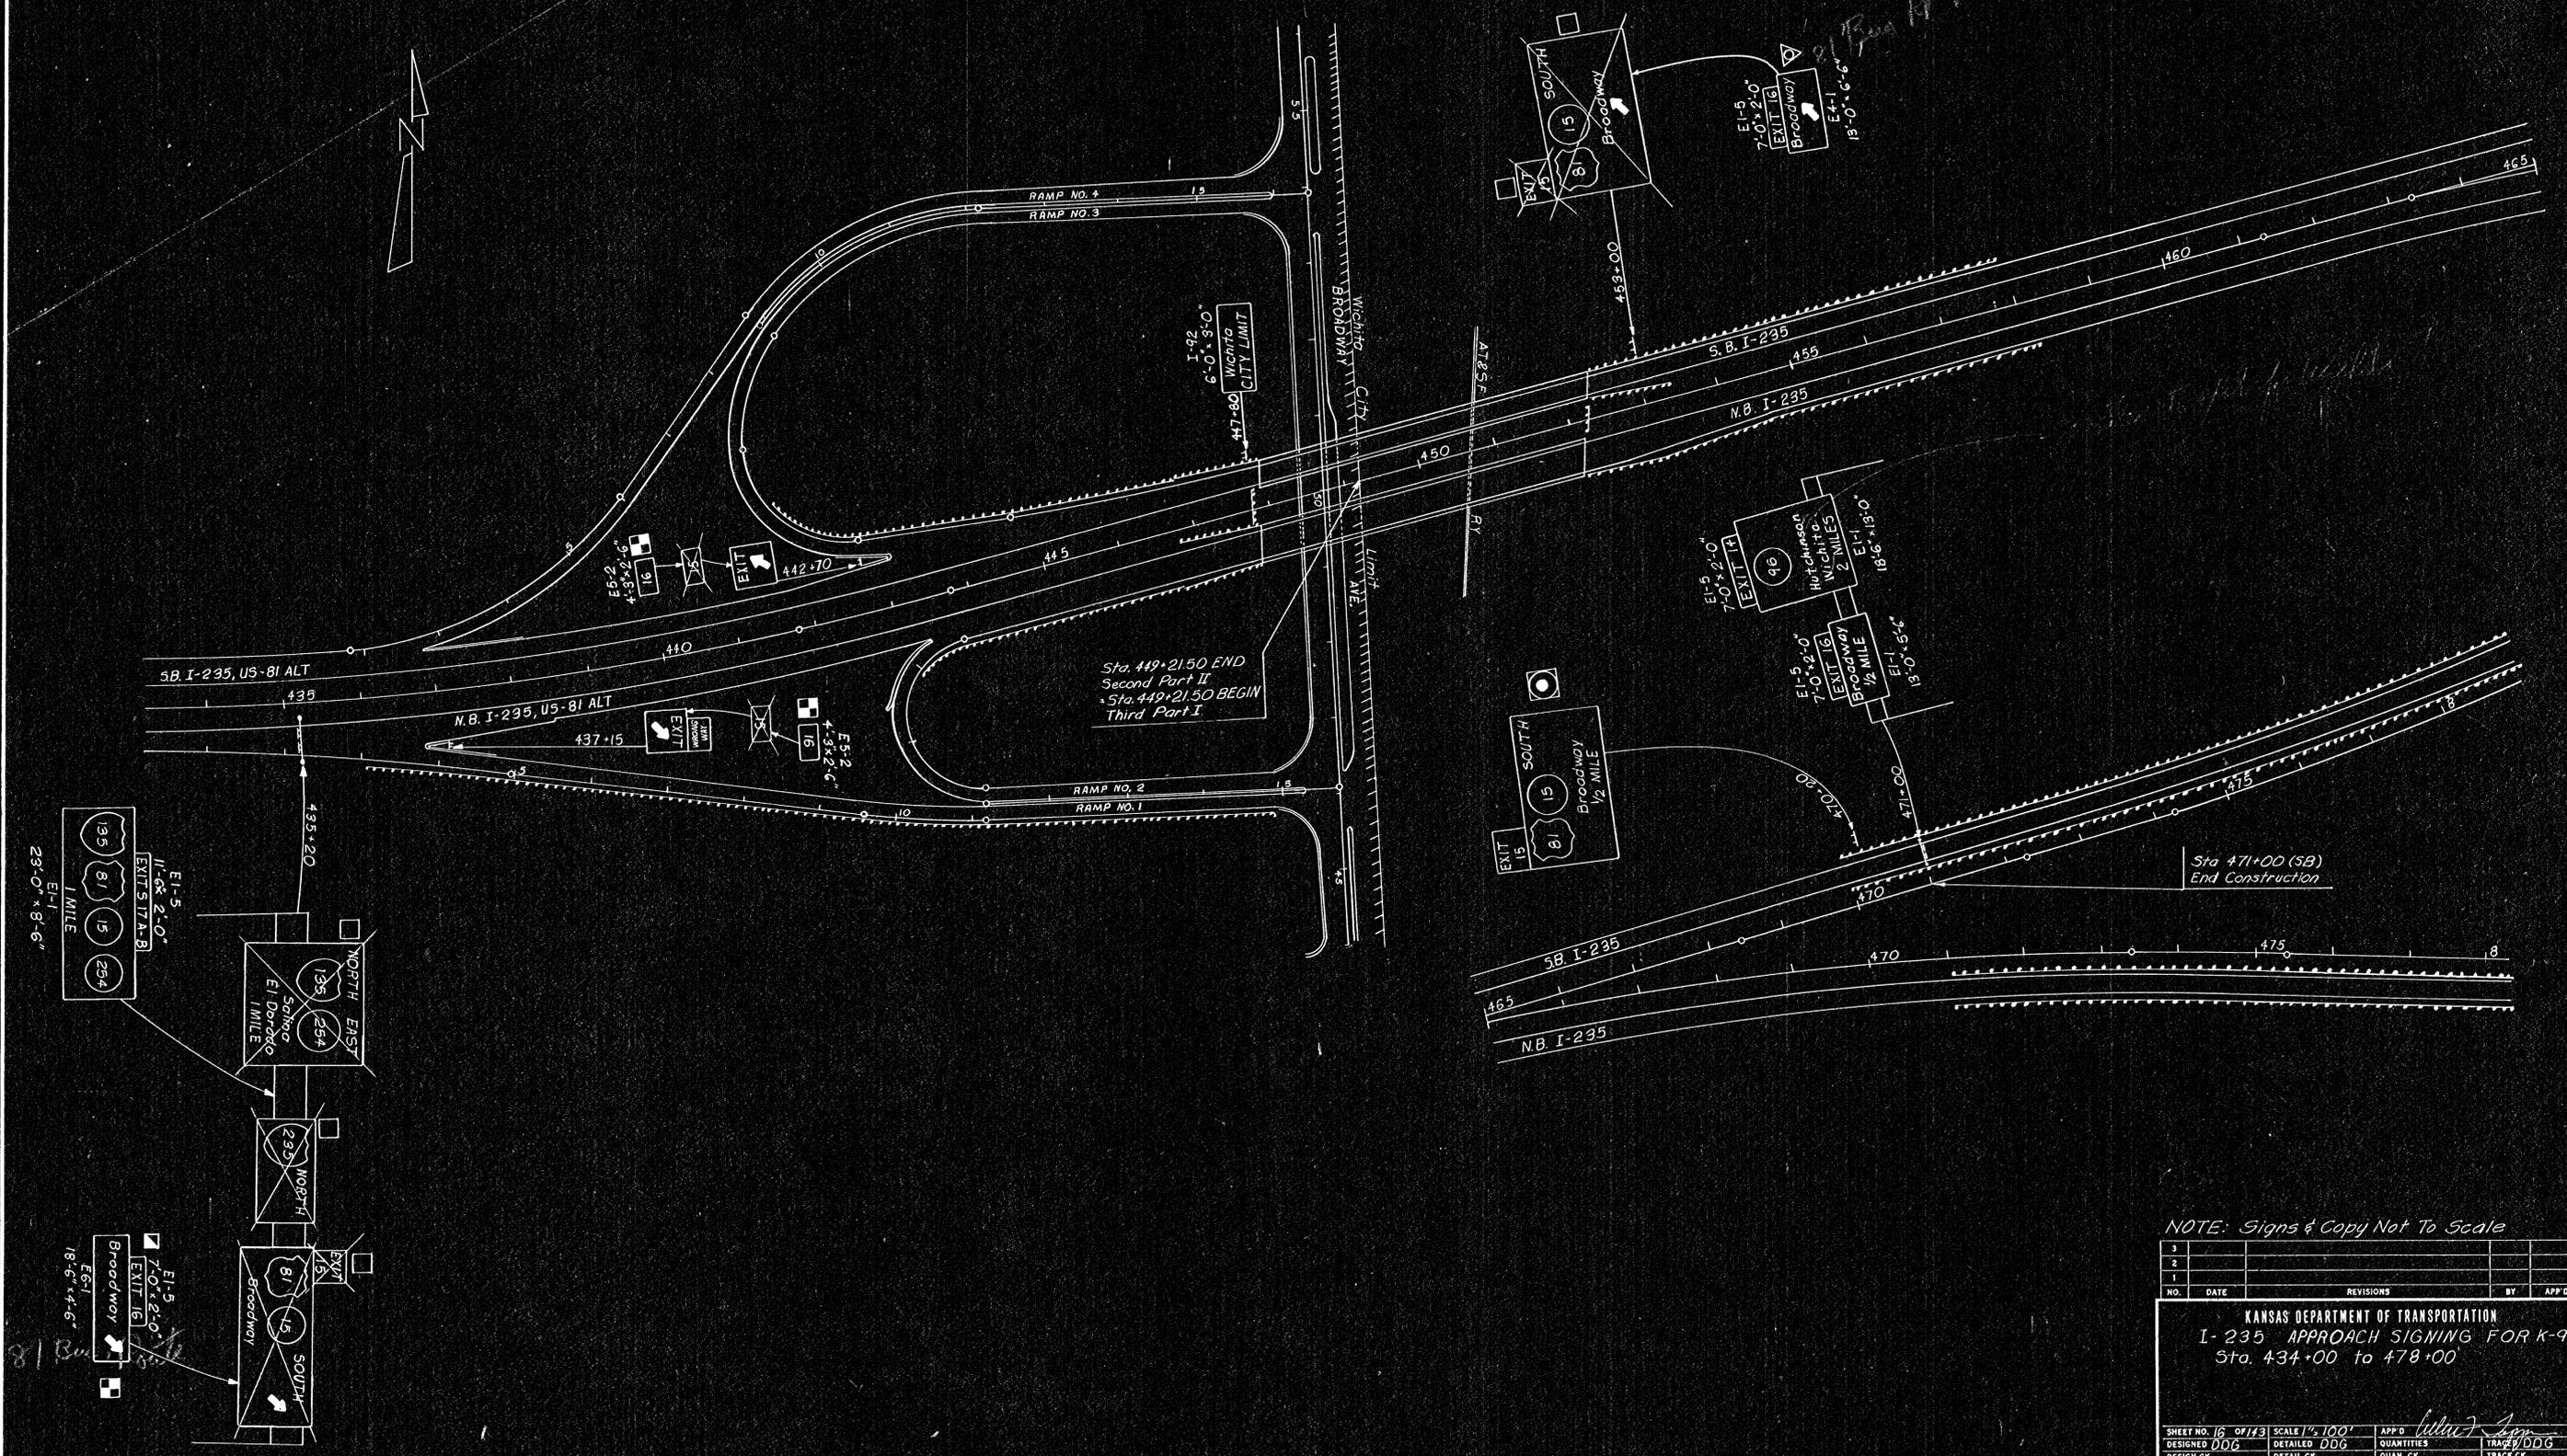

NOTE: Signs & Copy Not To Scale

| NO. | DATE | REVISIONS | BY | APP'D |
|-----|------|-----------|----|-------|
| 1   |      |           |    |       |
| 2   |      |           |    |       |

KANSAS DEPARTMENT OF TRANSPORTATION  
 I-235 APPROACH SIGNING FOR K-96  
 Sta. 434+00 to 478+00

|                     |                   |                          |
|---------------------|-------------------|--------------------------|
| SHEET NO. 16 OF 143 | SCALE 1/2" = 100' | APP'D <i>[Signature]</i> |
| DESIGNED DDG        | DETAILED DDG      | QUANTITIES               |
| DESIGN CK.          | DETAIL CK.        | QUAN. CK.                |
|                     |                   | TRACE CK.                |