


PLAN	DATE	BY	CHKD.	DATE	BY	CHKD.
NO.						
NO.						
NO.						

PROFILE	DATE	BY	CHKD.	DATE	BY	CHKD.
NO.						
NO.						
NO.						

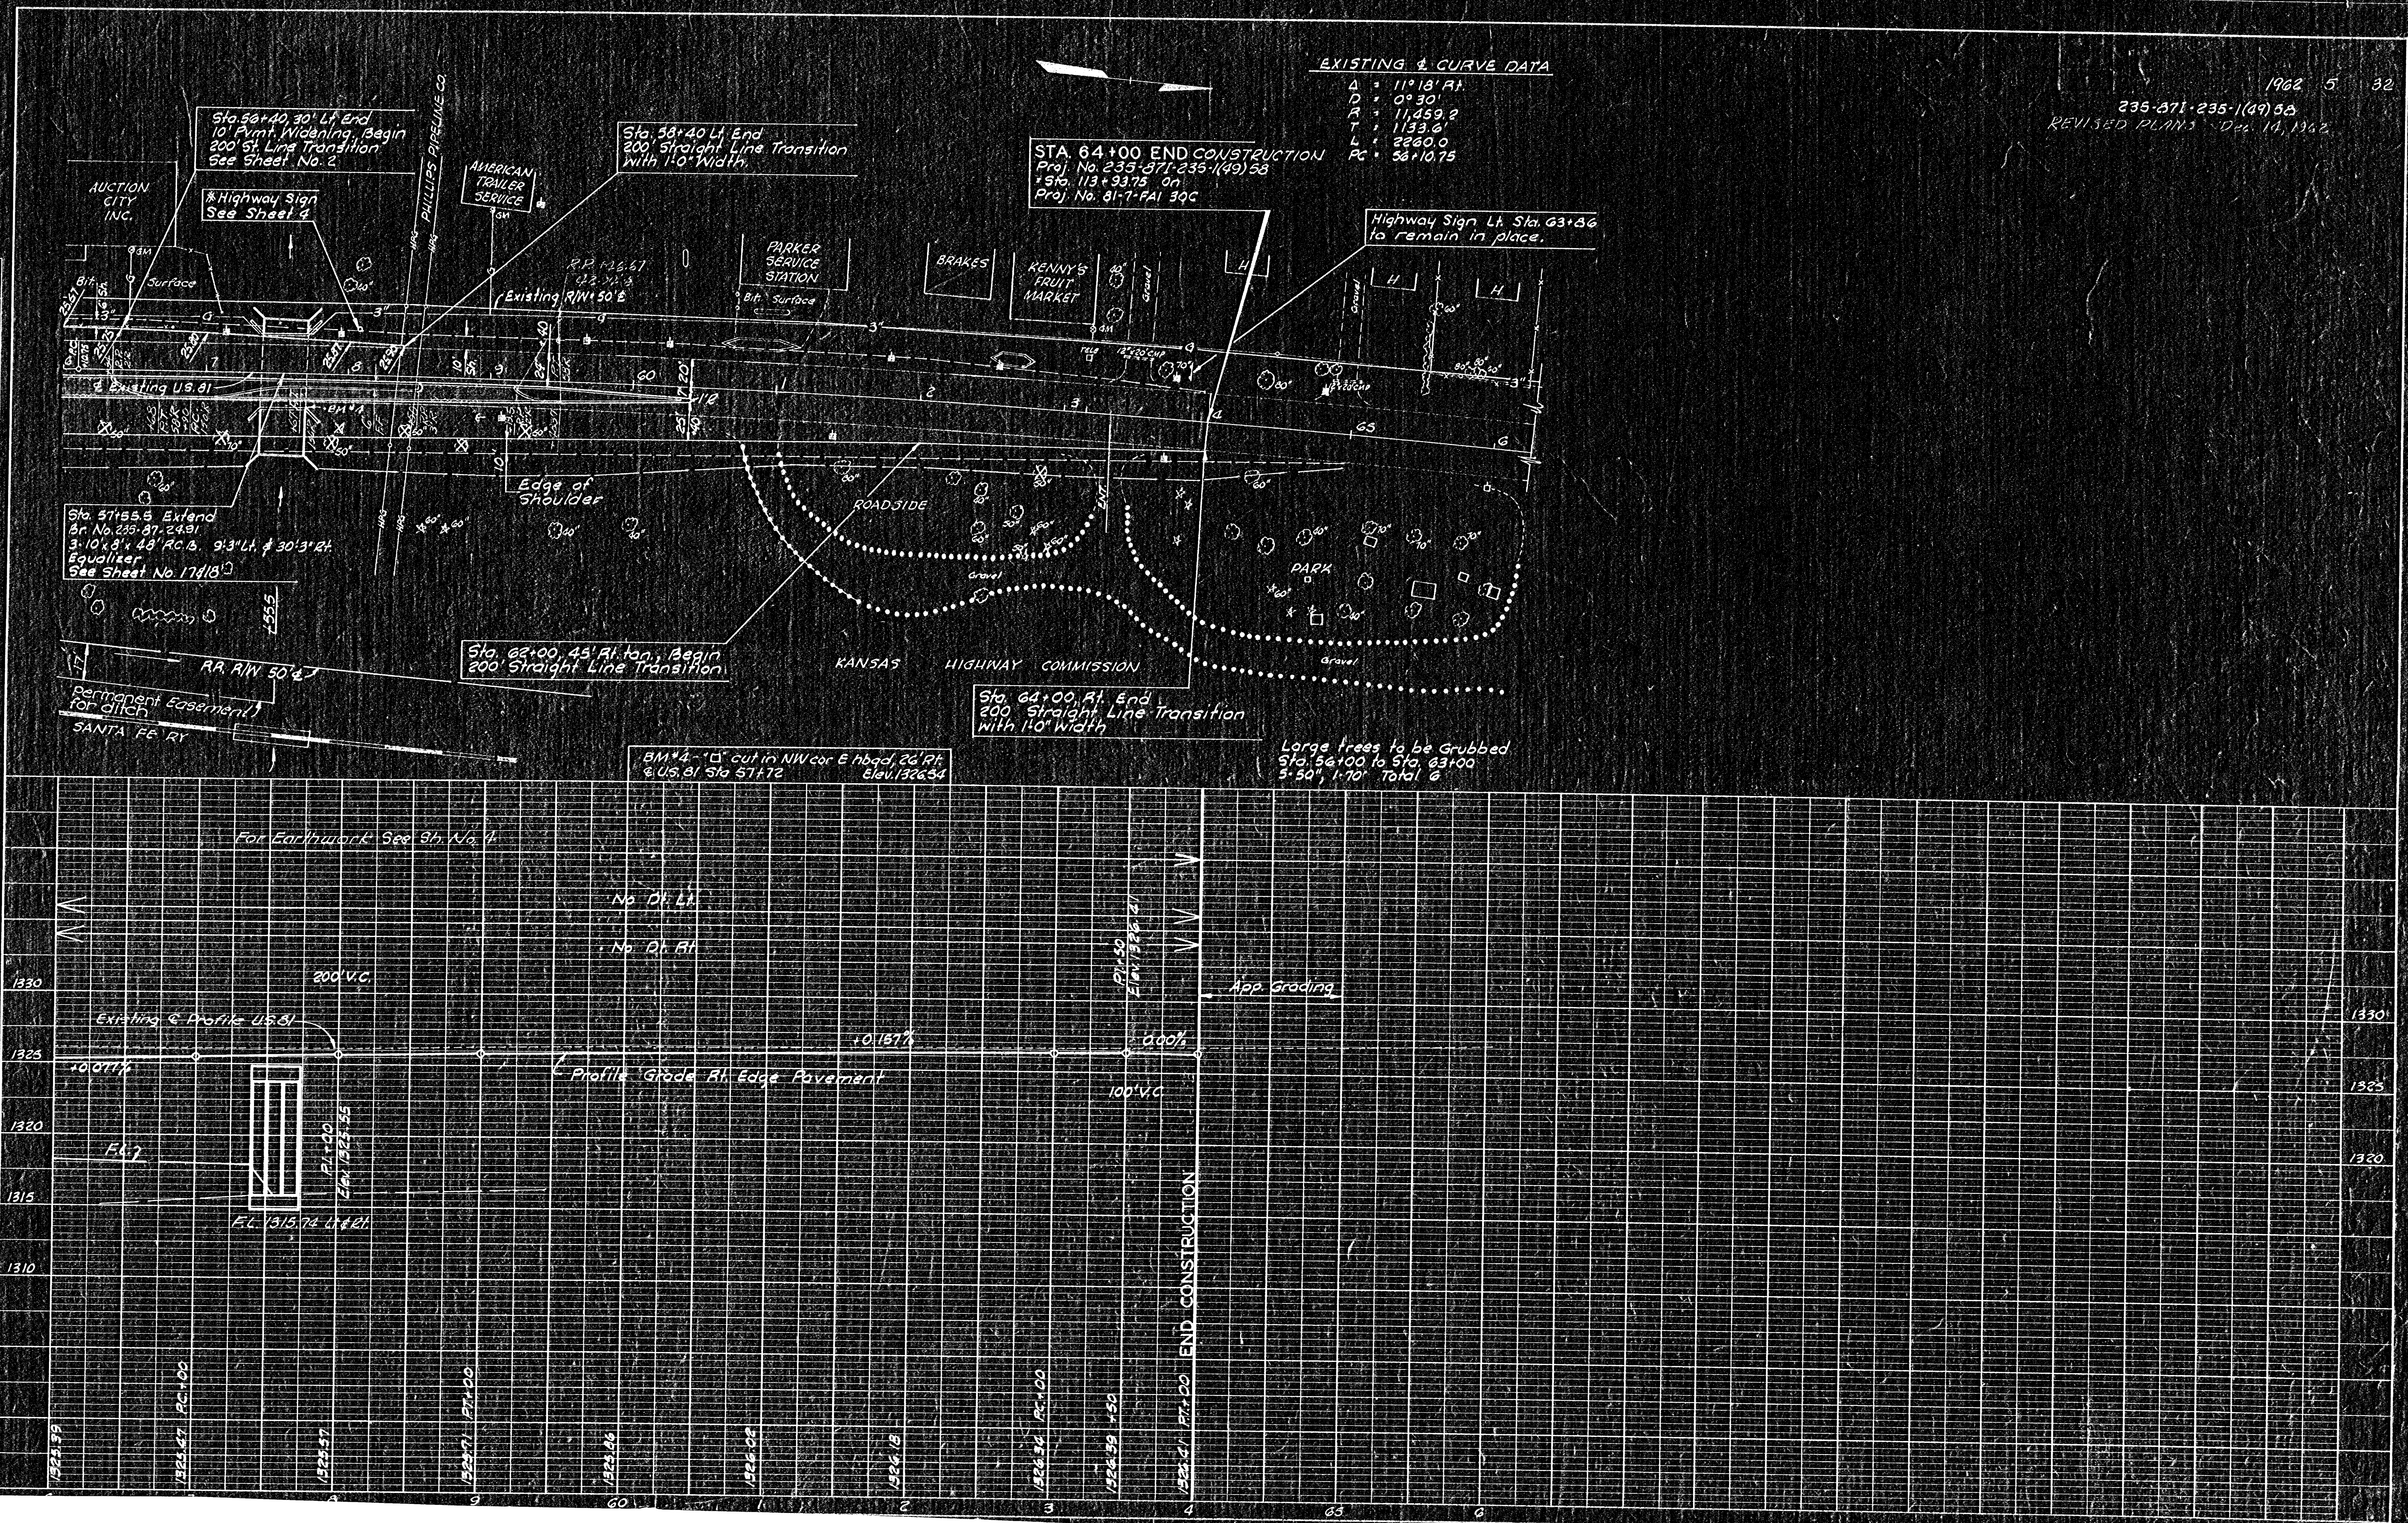

1962 5 32
235-371-235-1(49) 58
REVISED PLANS Dec. 14, 1962