

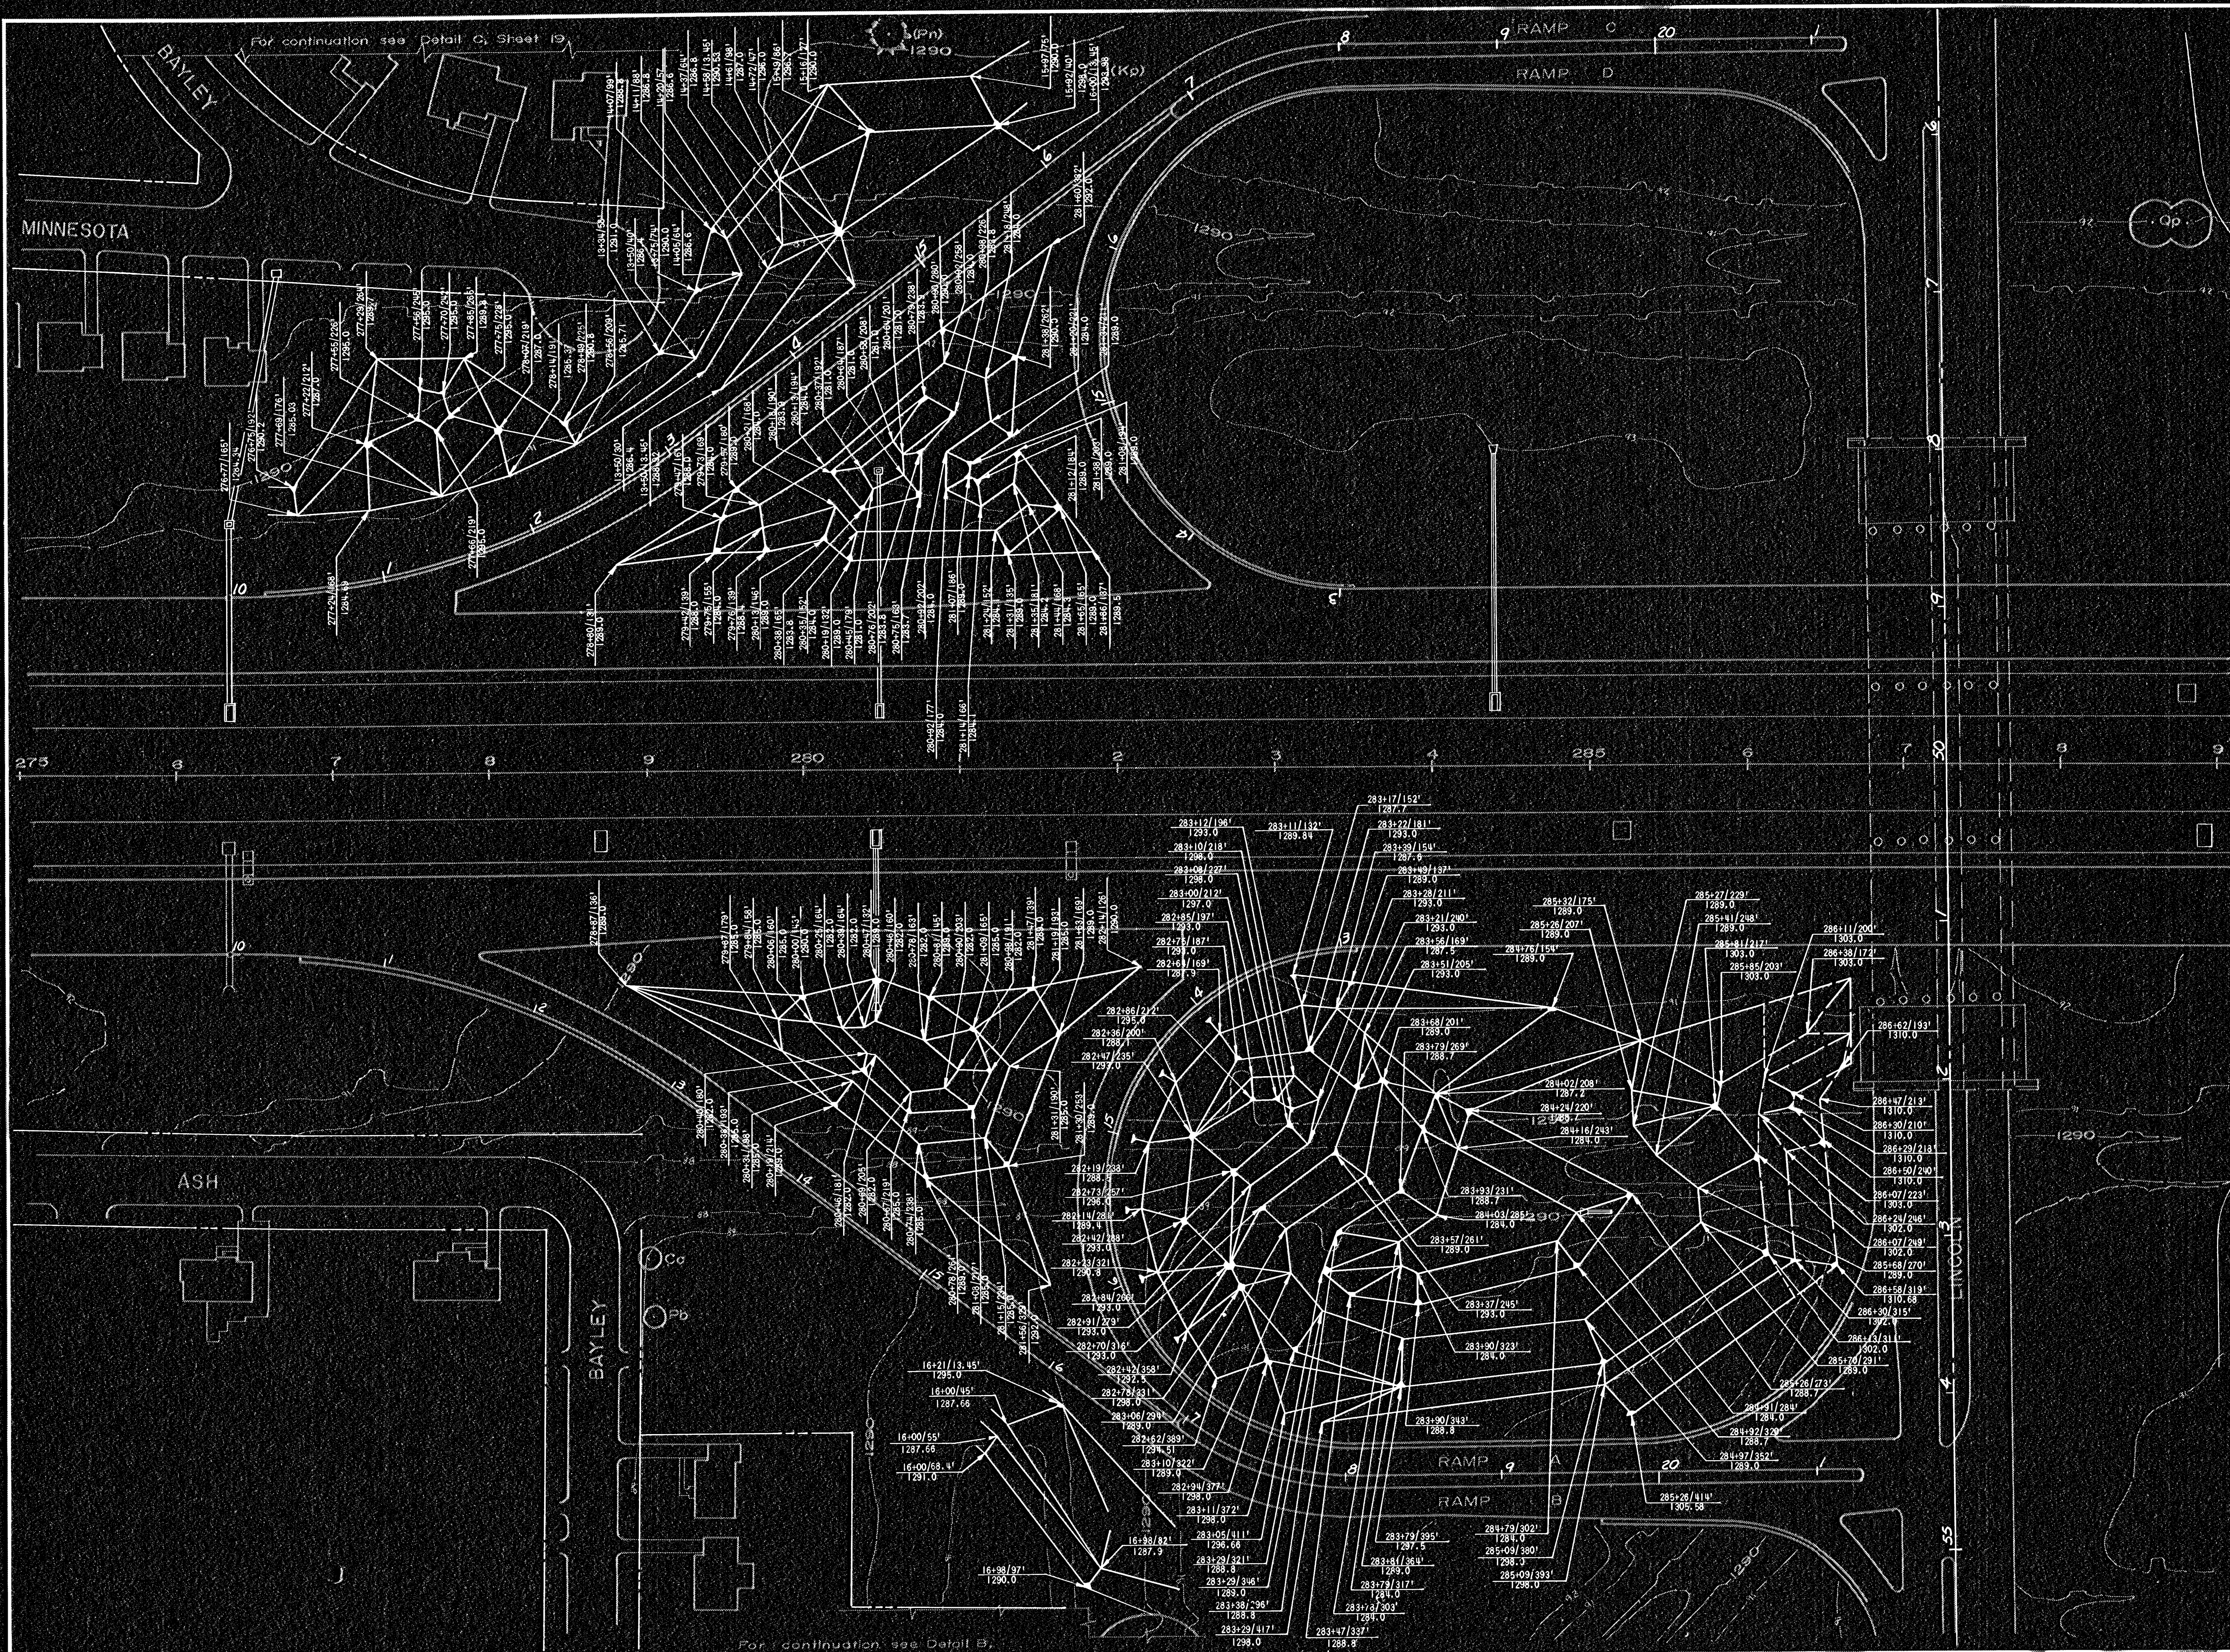
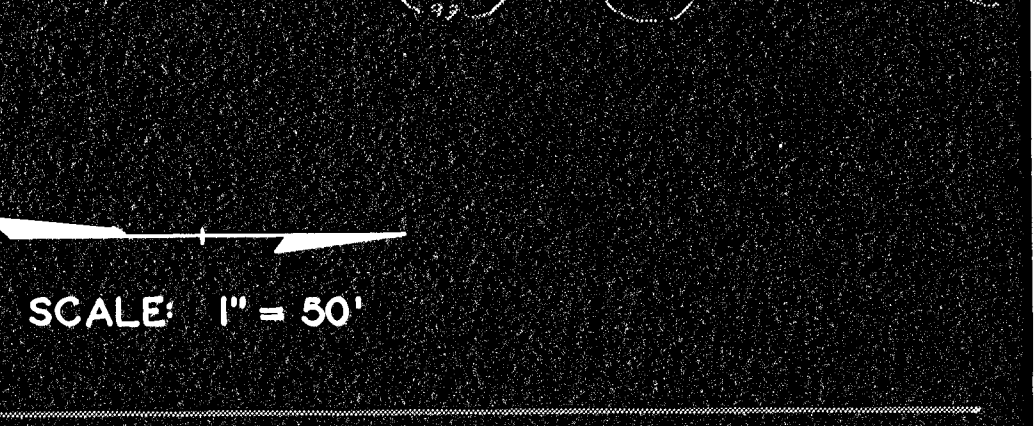


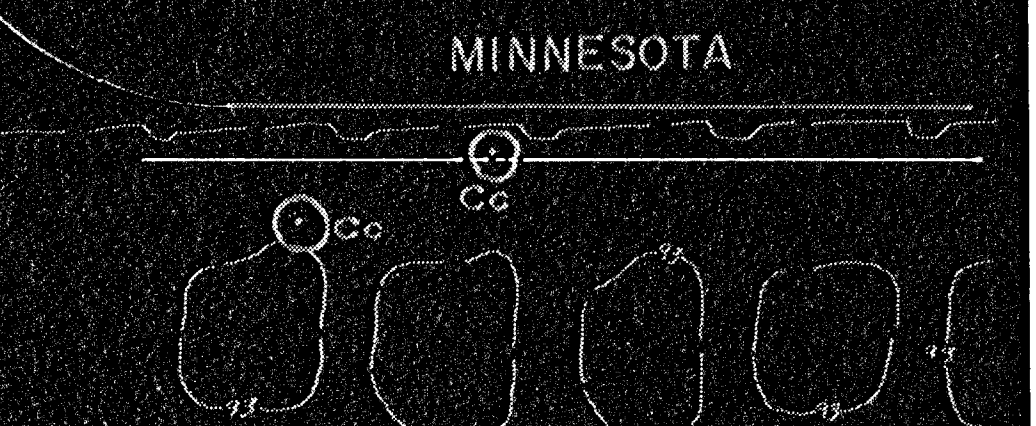


P. H. & A. REGION NO.	STATE	PROJECT NO.	FISCAL YEAR	SHEET NO.	TOTAL SHEETS
7	KANSAS	4	1976	178	304

#35W-97.1 35W-1(39)46

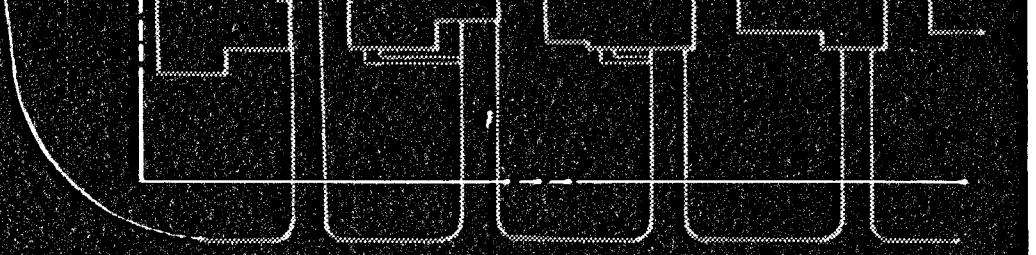

THE LOCATIONS AND ELEVATIONS OF THE REFERENCE POINTS AS SHOWN ON THESE PLANS ARE APPROXIMATE AND WERE USED ONLY FOR DETERMINING QUANTITIES AND TO INSURE PROPER DRAINAGE. ALL SURFACES OF THE LANDFORMS SHALL BE ROUNDED DURING CONSTRUCTION TO GIVE A FREE-FORM APPEARANCE. THE VERTICAL ELEVATIONS MAY BE VARIED PLUS OR MINUS ONE-HALF FOOT DURING CONSTRUCTION AS APPROVED BY THE ENGINEER IN THE FIELD.

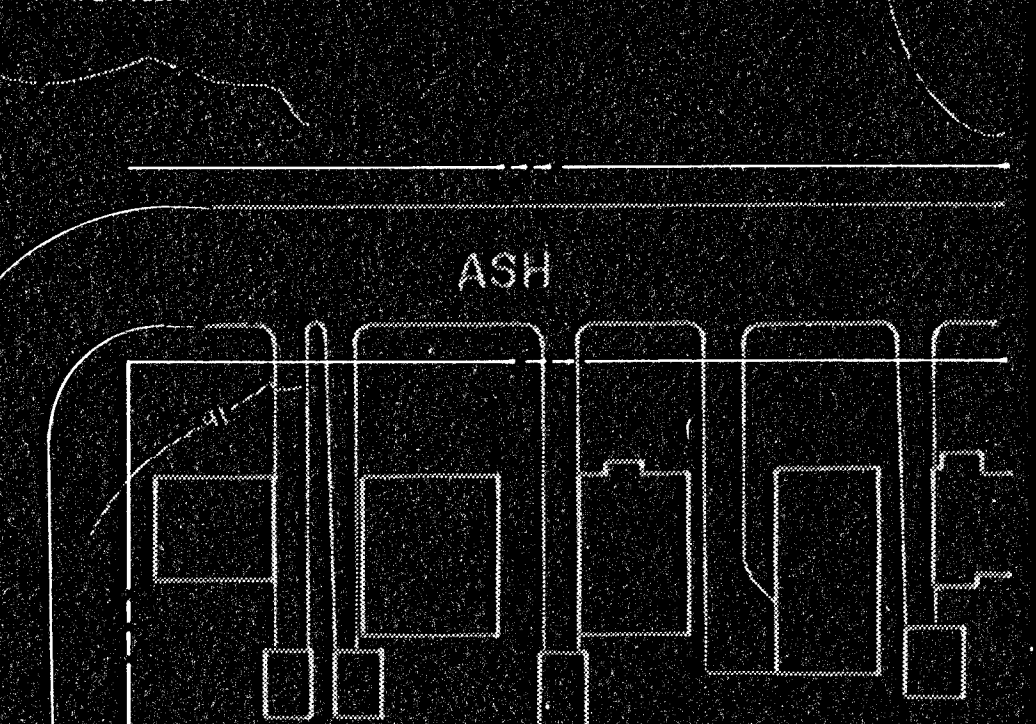

Note: Dashed Lines Indicate Completed Work.					
5	5-12-75	Raise Dt. Rt. Sta. 16+00 to 17+78.5 R. B.	SRT	JWW	
4	5-12-75	Remove Landform Rt. Sta. 10+00 R. B.	SRT	JWW	
NO.	DATE	REVISIONS	BY	APP'D	
STATE HIGHWAY COMMISSION OF KANSAS					
I 35 W					
GRADING PLAN					
WILSON & COMPANY ENGINEERS & ARCHITECTS SALINA, KANSAS					
DESIGNED	JWW	TRACED	MJV	CHECKED	SRT