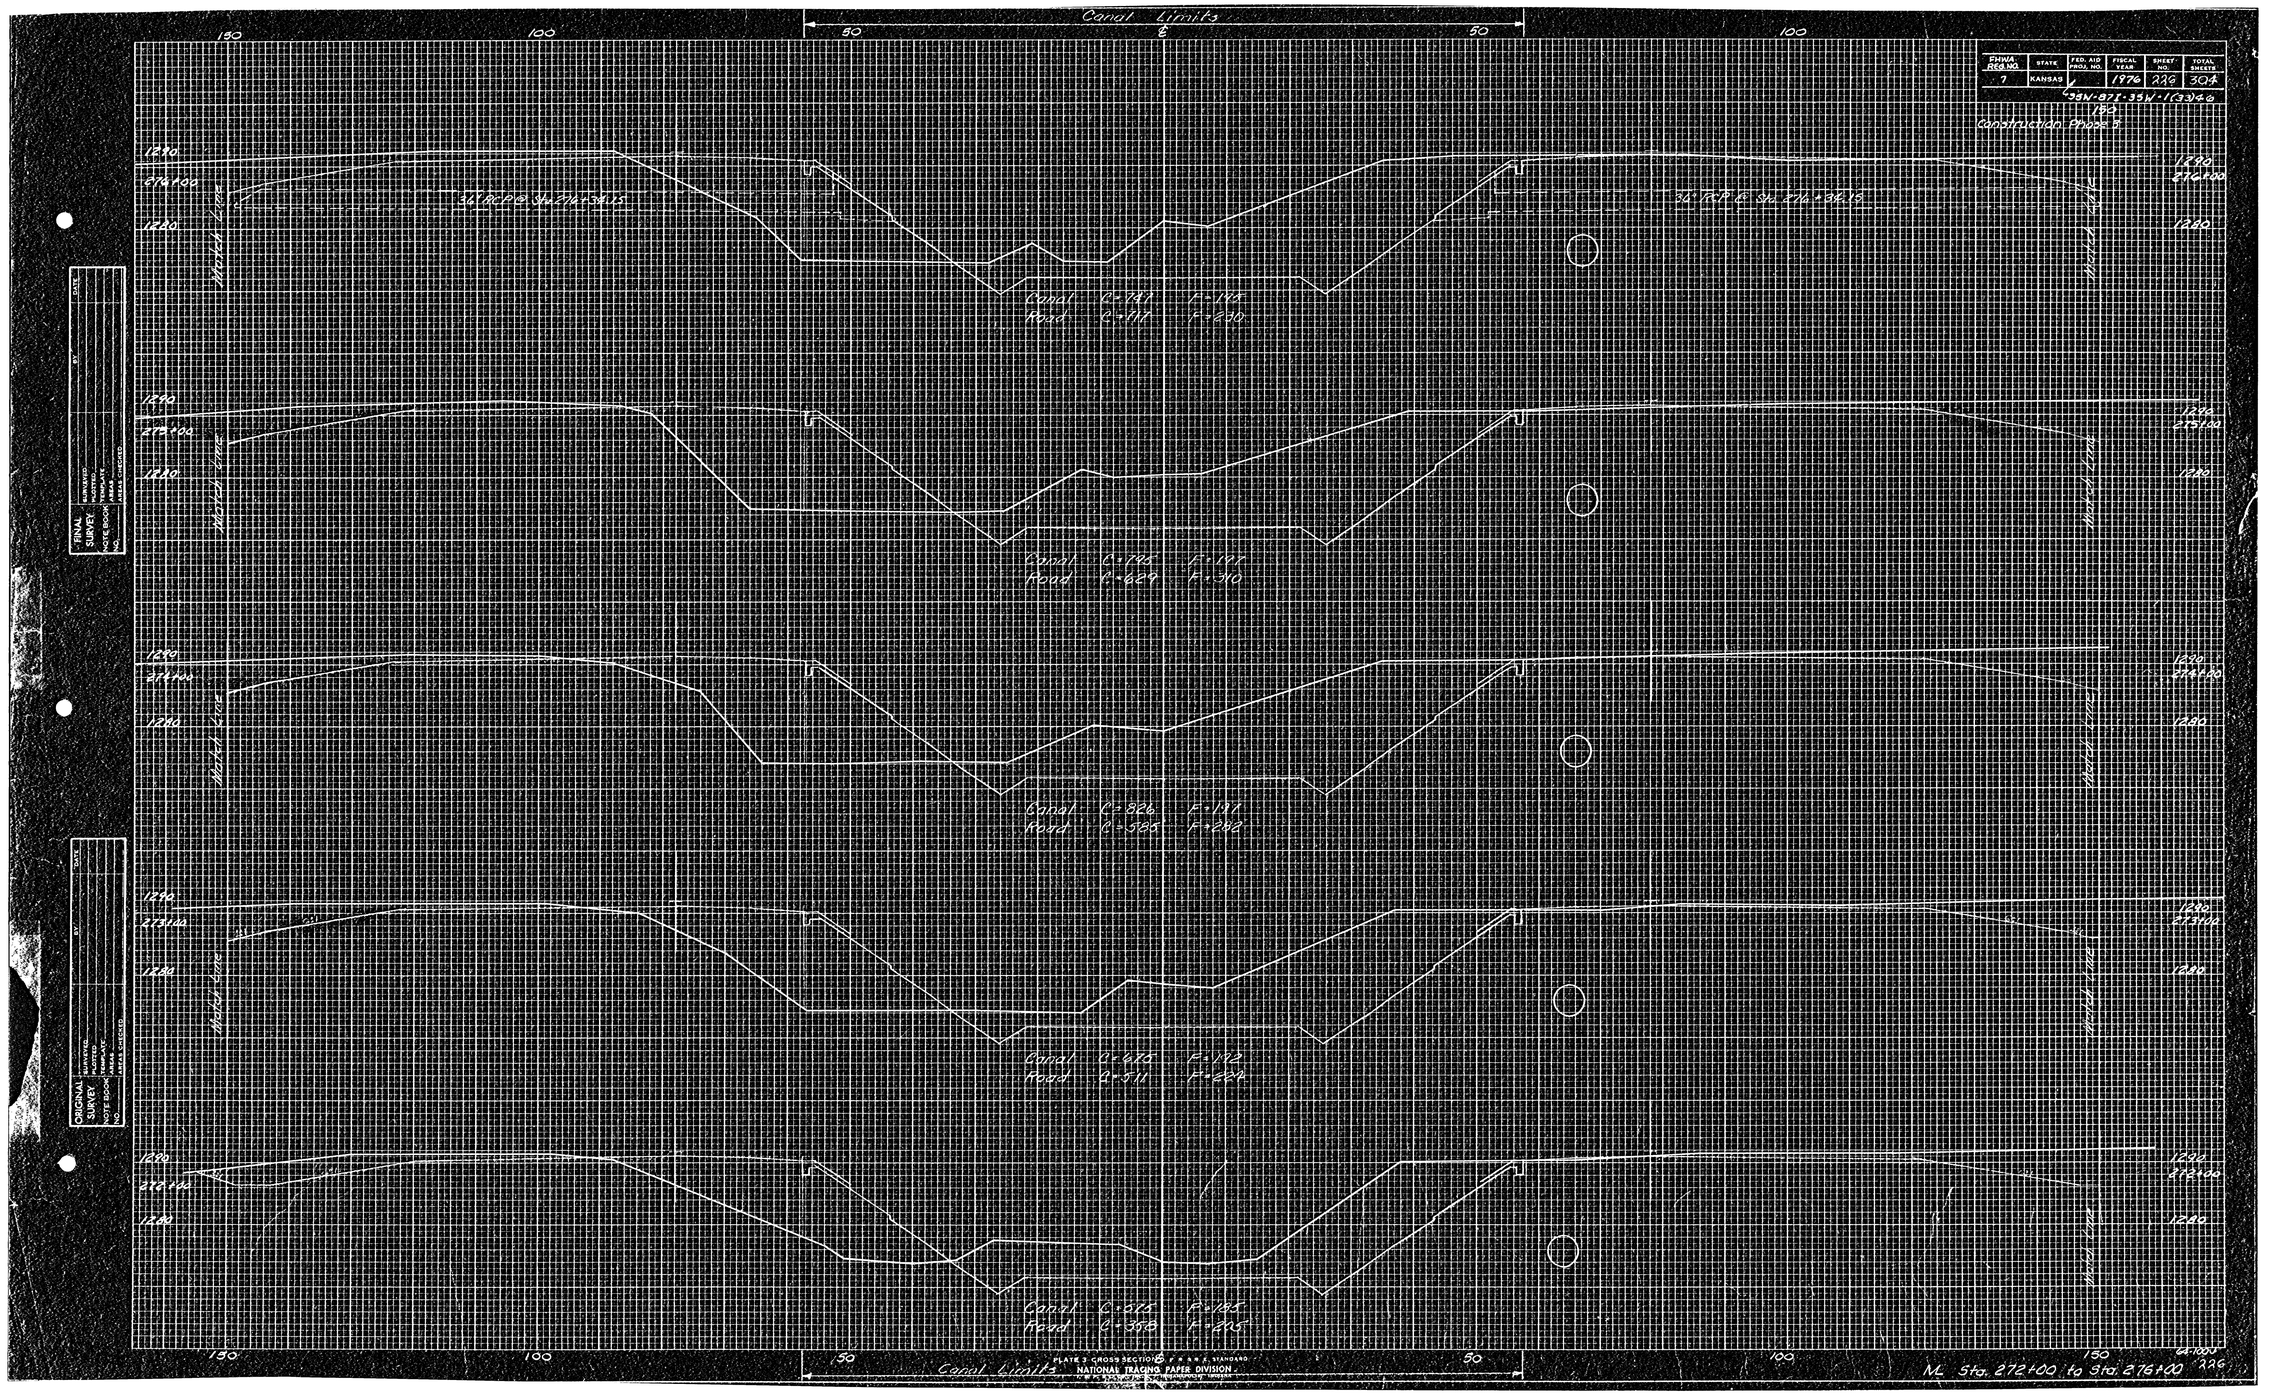
Canal Limits
℄
150
100
50
50
100
150
FINAL SURVEY
ORIGINAL SURVEY
SURVEYED
PLOTTED
TRANSFER
NOTE BOOK
NO.
DATE
BY
AREAS CHECKED
Match Line
Match Line
Match Line
Match Line
Canal C=787 F=192
Road C=417 F=230
Canal C=784 F=197
Road C=629 F=310
Canal C=826 F=198
Road C=568 F=282
Canal C=678 F=192
Road C=511 F=224
Canal C=614 F=182
Road C=398 F=215
Construction Phase 2
1976
Sta. 272+00 to Sta. 276+00
226