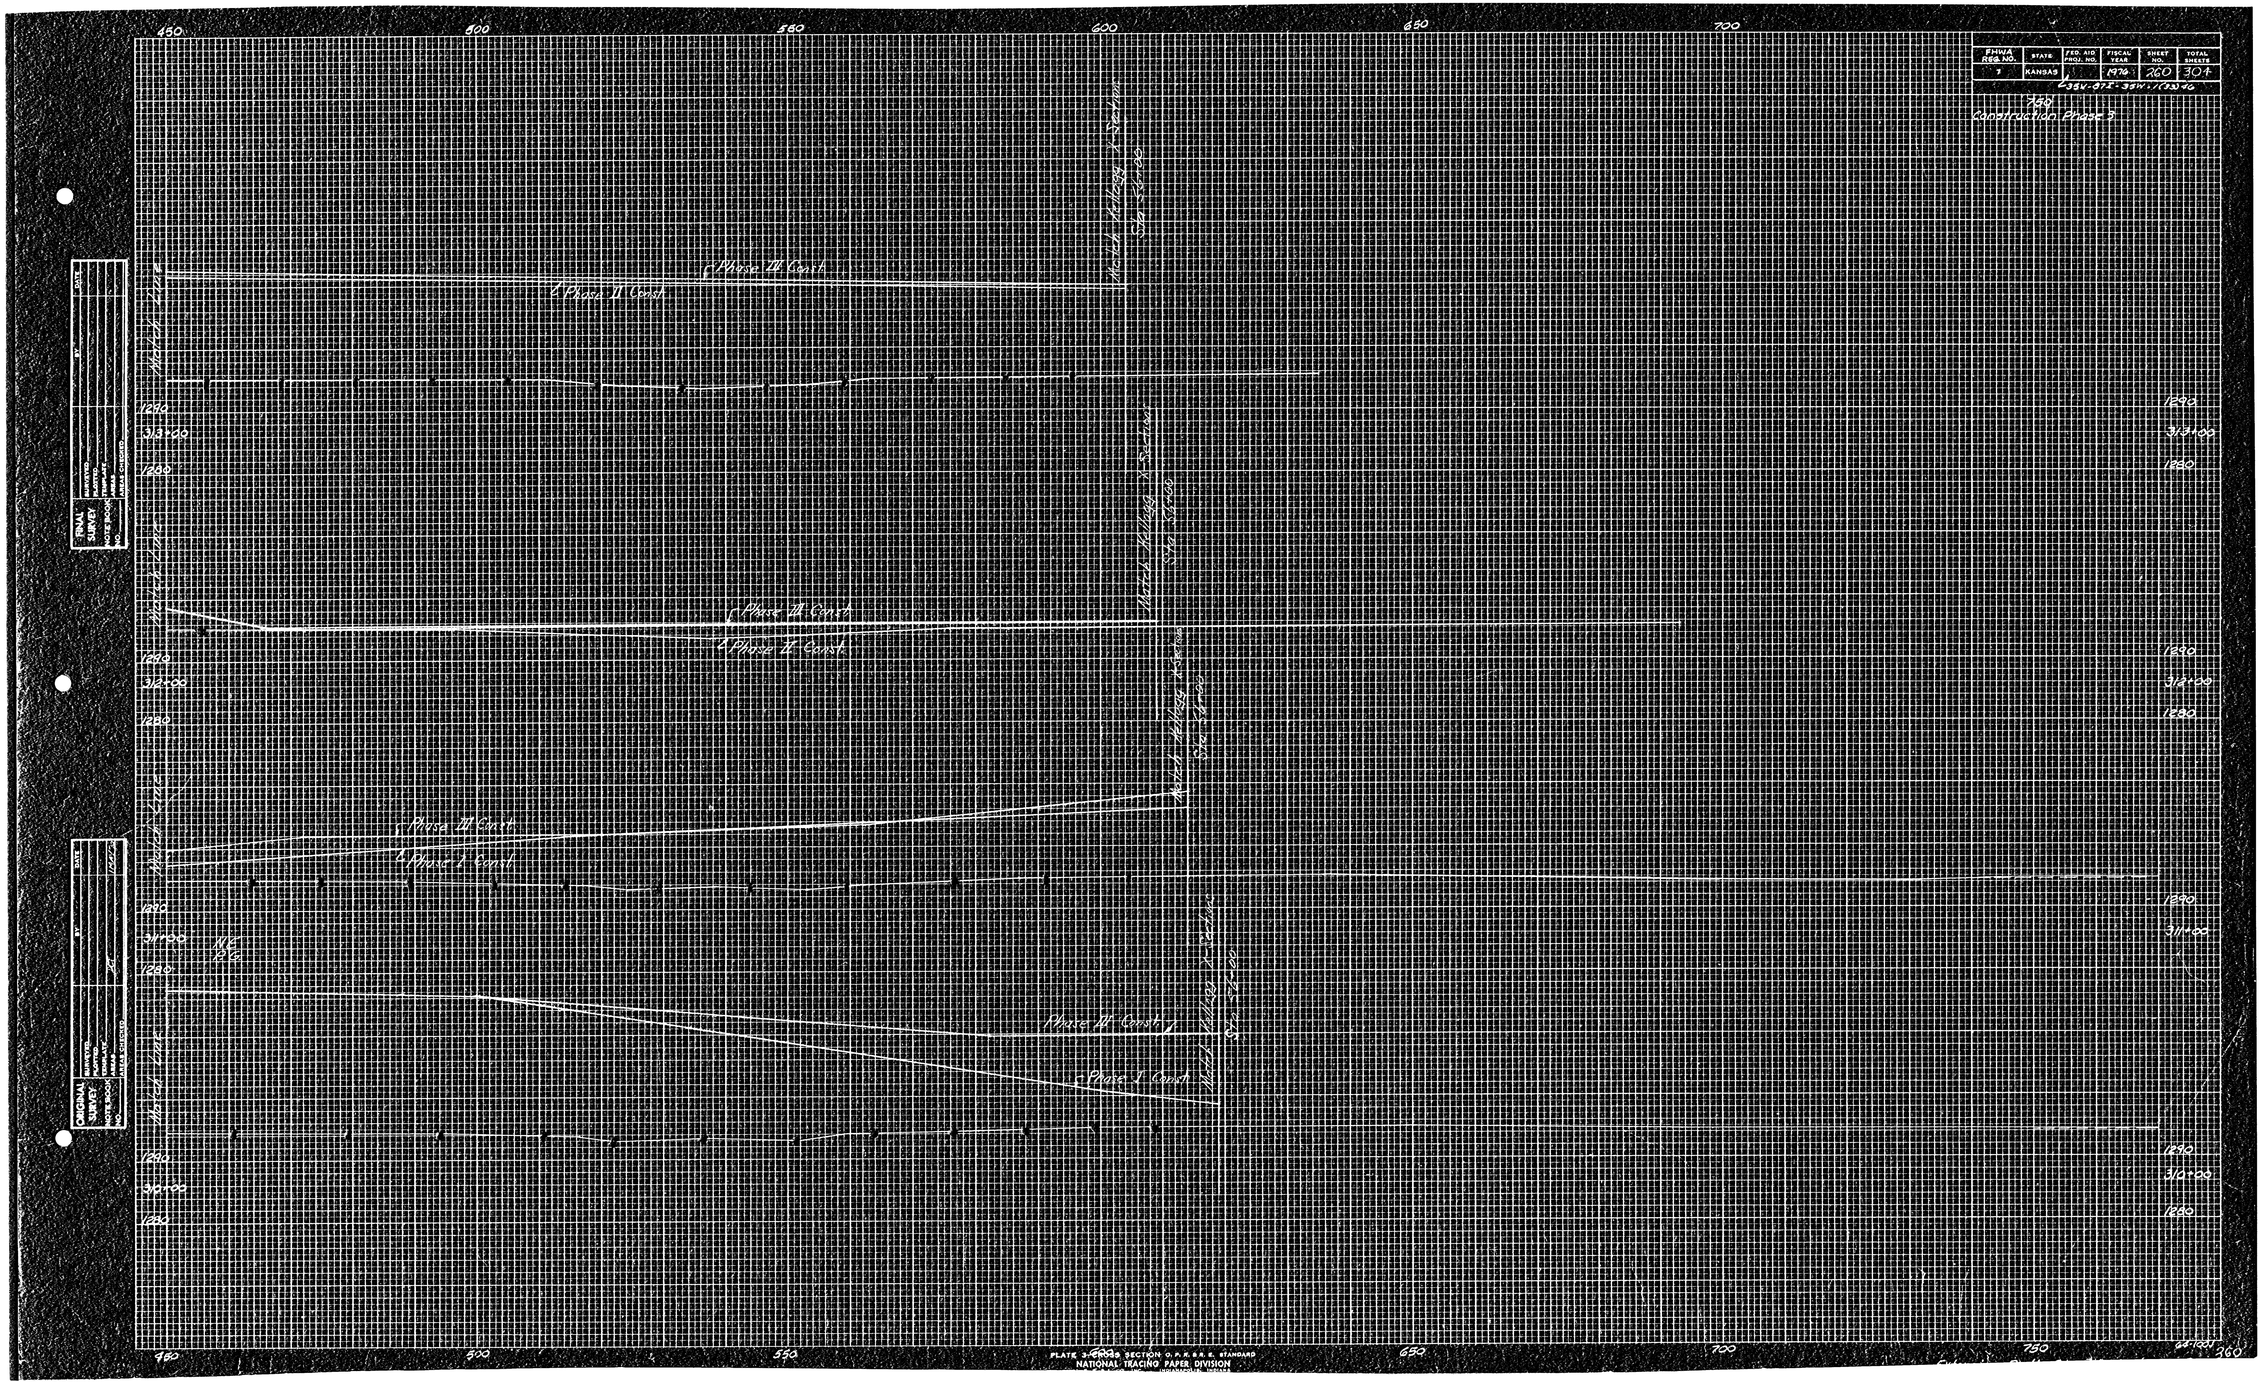
FHWA REG NO. 7
STATE KANSAS
FED. AID PROJ. NO.
FISCAL YEAR 1976
SHEET NO. 260
TOTAL SHEETS 304
F-35V-07Z-35W-1020-46
Phase III Const.
Phase II Const.
Phase I Const.
Phase III Const.
Phase II Const.
Phase III Const.
Phase I Const.
Phase III Const.
Phase I Const.
FINAL SURVEY
ORIGINAL SURVEY
PLATE 3-E(RD) SECTION O.P.R.B.B.E. STANDARD
NATIONAL TRACING PAPER DIVISION
260