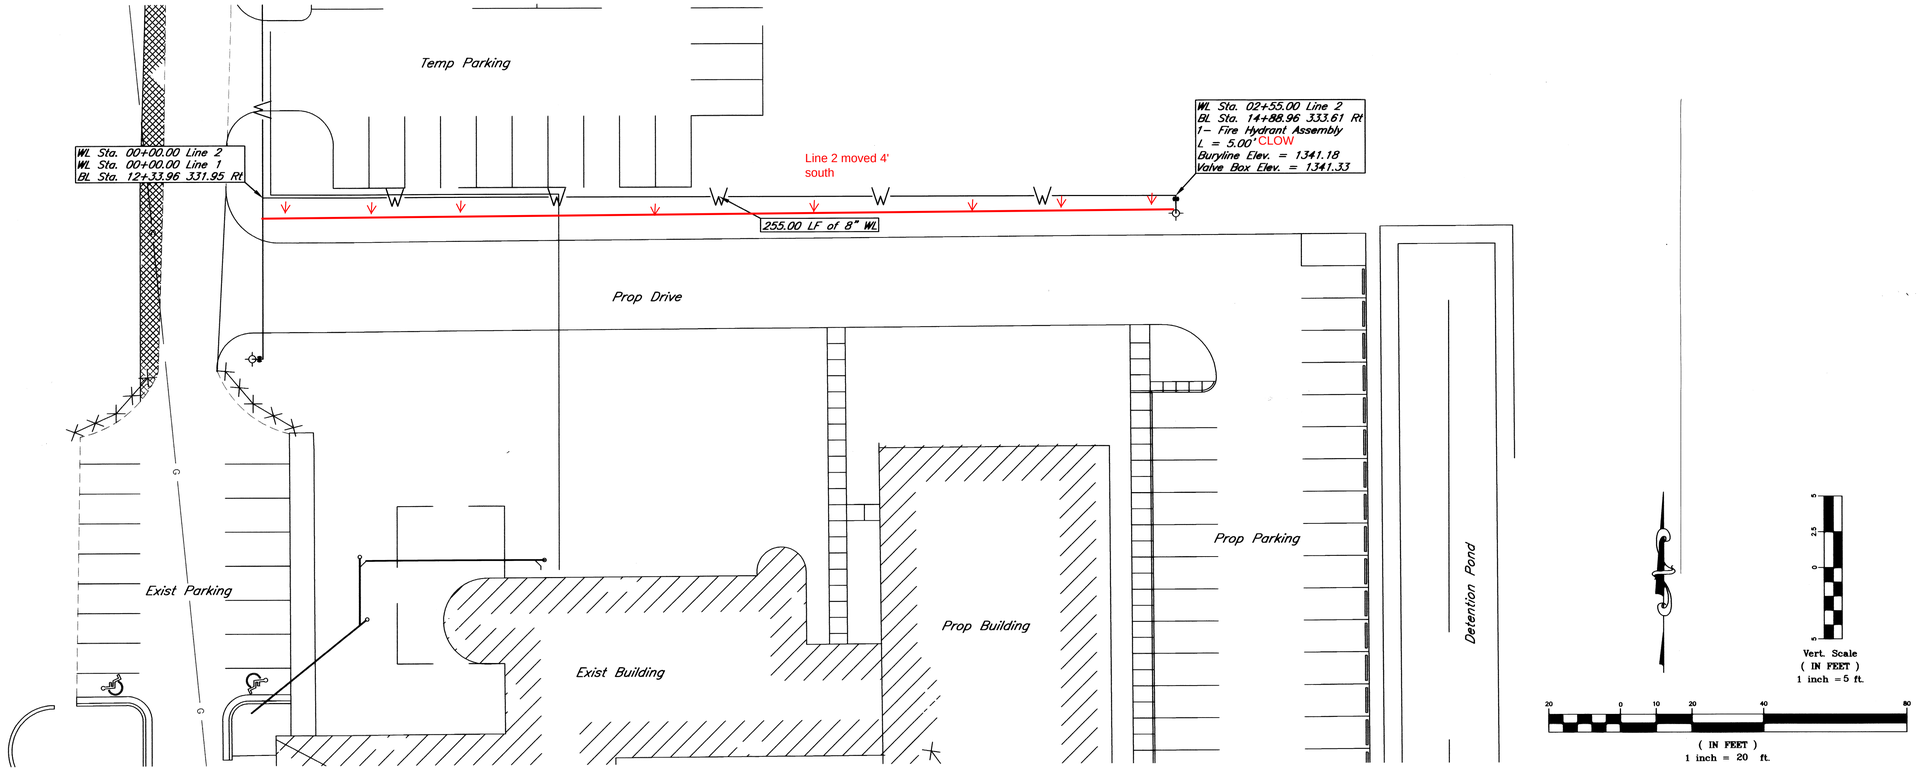

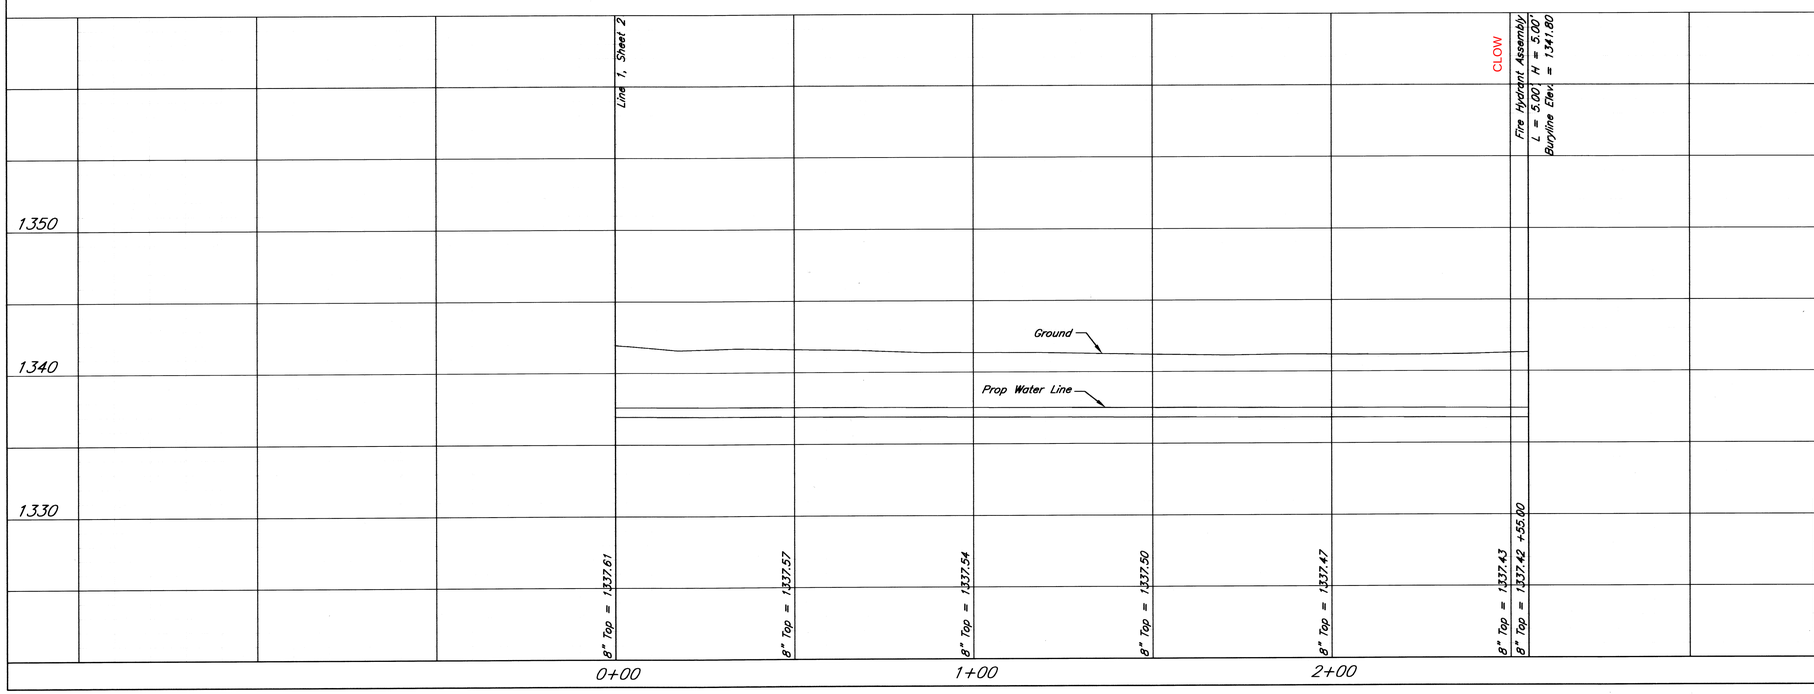

Sunflower Broadcasting, Inc.

Water Line 2

Wichita, Kansas

kemiller engineering
516 S. Market,
Wichita, KS 67202
316/264-0242

PROJECT NUMBER			
KEM NO. 07190	FILE plan	DATE 12/2007	SHEET 3
DESIGN KM	DRAWN NS	REVISED	OF 4