


# BENCHMARK

□ Cut on Crosswalk Signal Pole Base  
6.4' N and 25.3' E of the Ne Corner  
SE ¼, NW ¼ Section 29-26S-1E  
Elev. = 1323.41

SCALE:  
1" = 20' HORIZONTAL  
1" = 5' VERTICAL

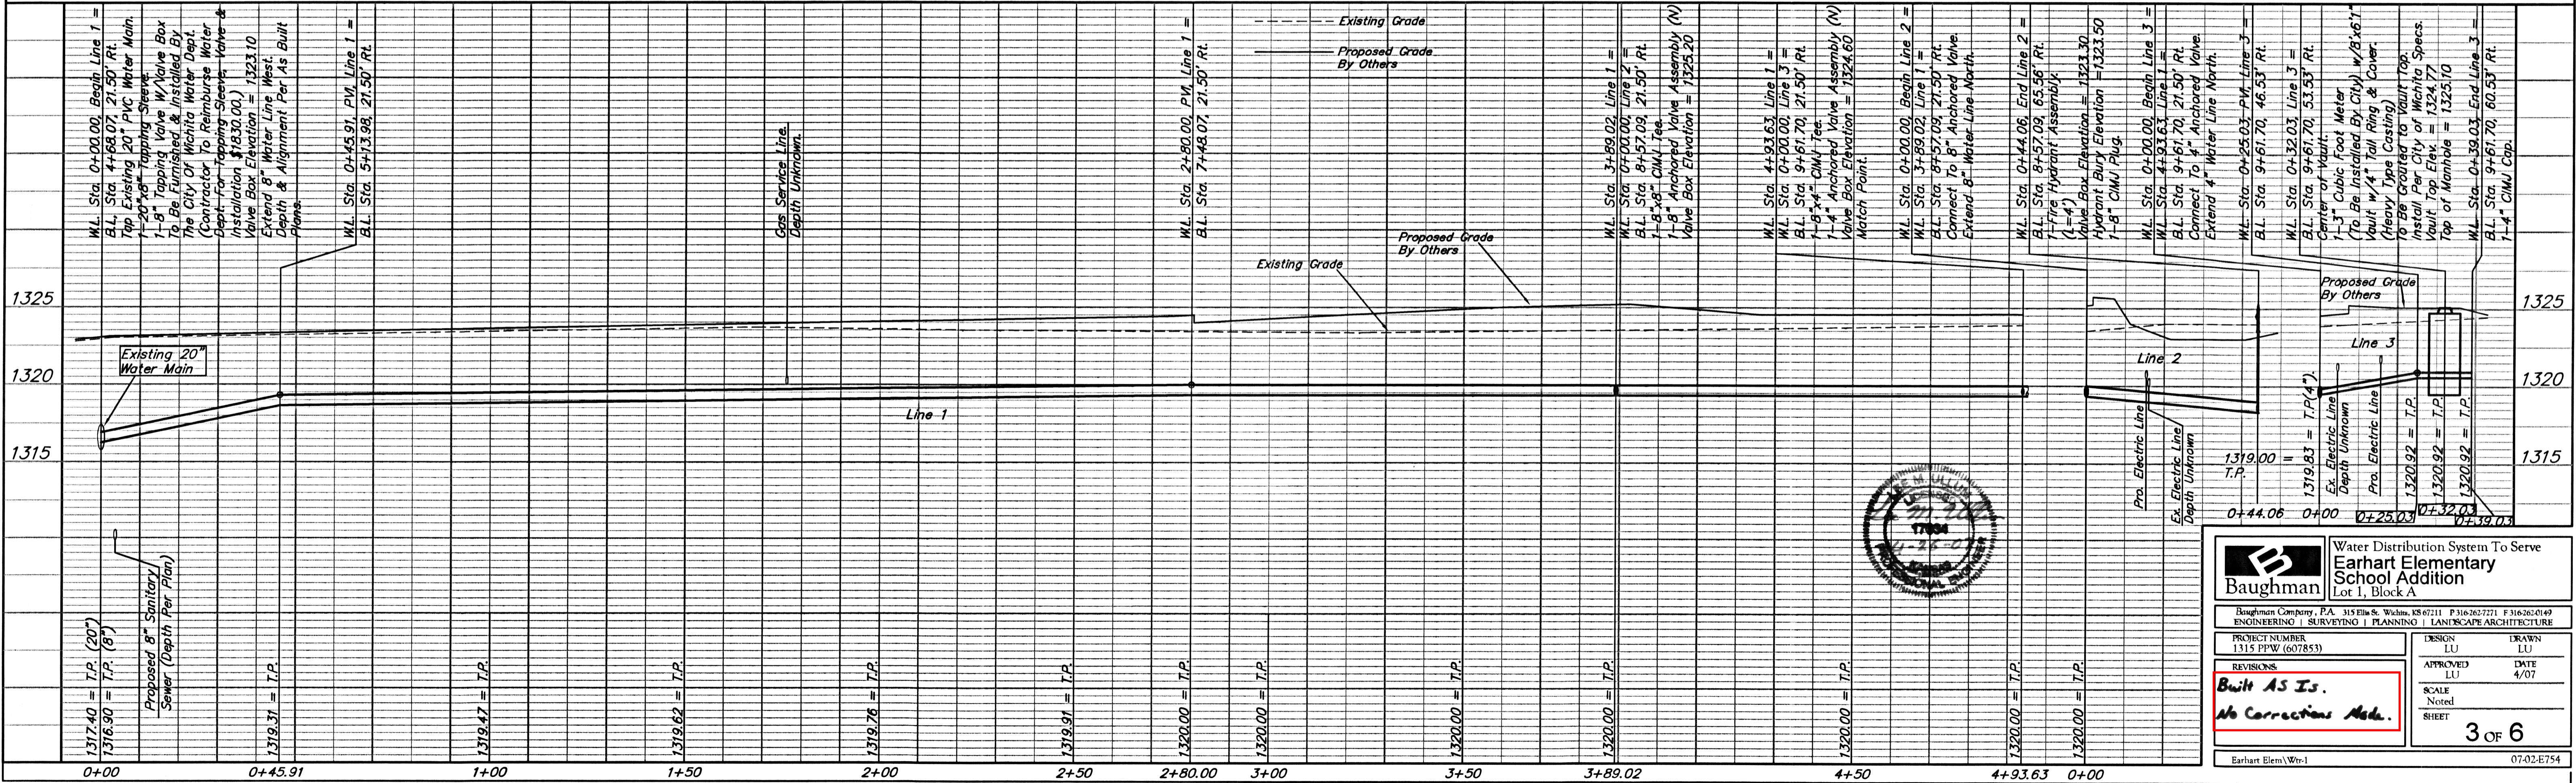

**Baughman** Engineering, P.A.  
315 Ellis St., Wichita, KS 67211 P 316-262-7271 F 316-262-0149  
ENGINEERING | SURVEYING | PLANNING | LANDSCAPE ARCHITECTURE

PROJECT NUMBER: 1315 P/W (607853)  
DESIGN: LU  
DRAWN: LU

APPROVED: LU  
DATE: 4/07

REVISIONS:  
**Built AS IS.**  
*No Corrections Made.*

SCALE: Noted  
SHEET: 3 OF 6

Earhart Elem/Wtr-1 07-02-E754