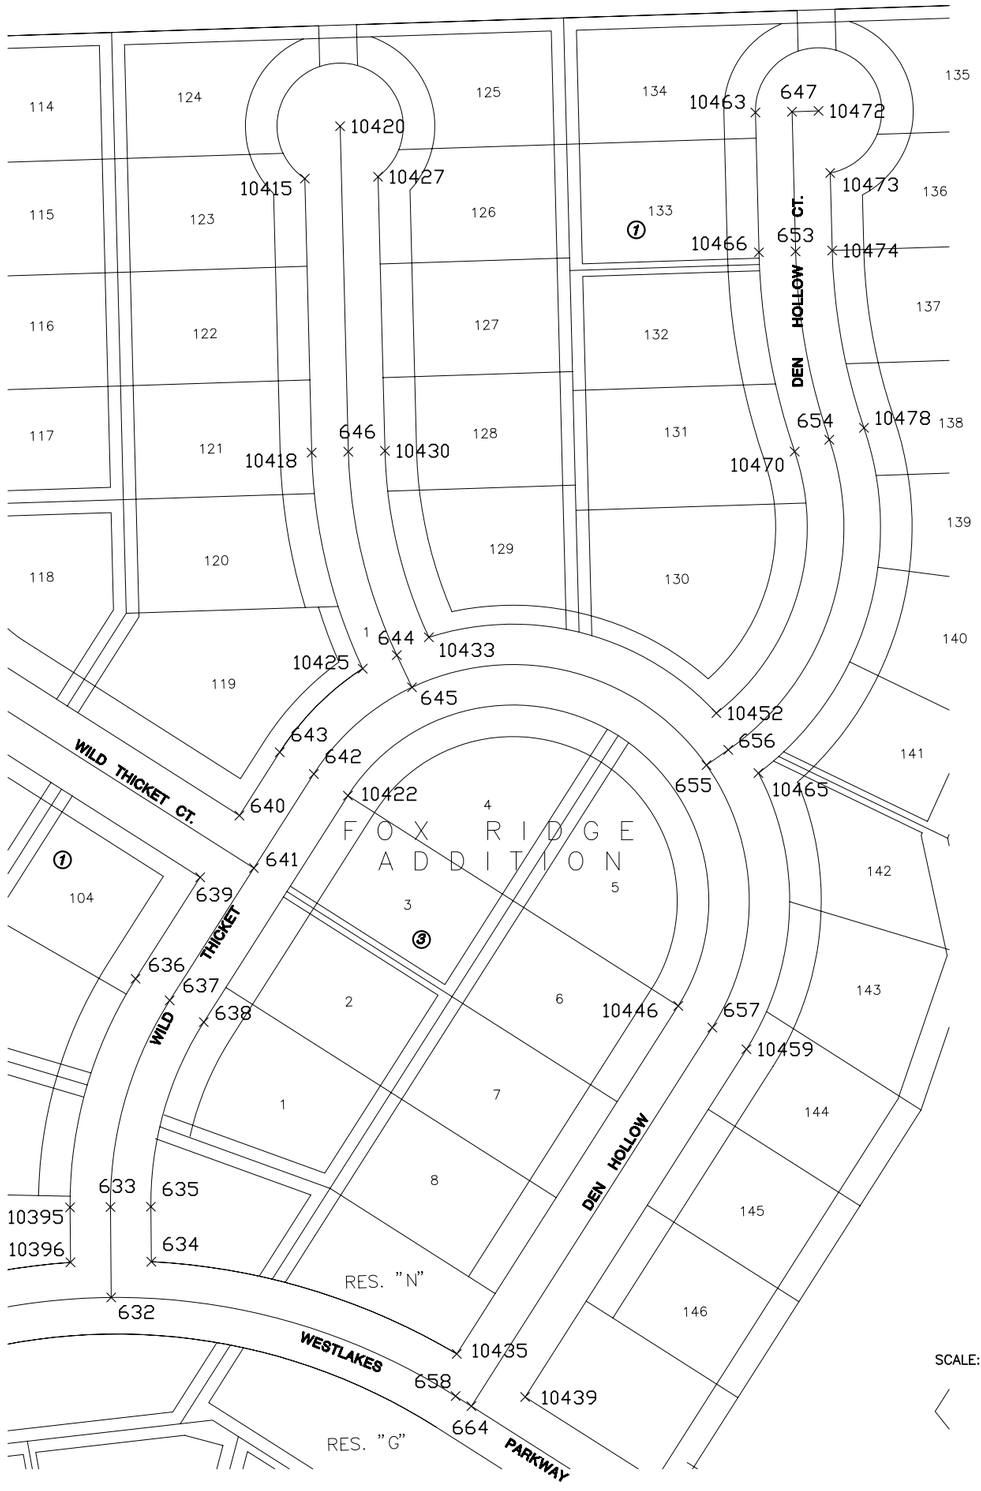

Point No.	North	East
632	1615601	1705668
633	1615601	1705740
634	1615633	1705696
635	1615633	1705740
636	1615620	1705920
637	1615647	1705903
638	1615674	1705886
639	1615672	1706001
640	1615703	1706050
641	1615714	1706008
642	1615762	1706083
643	1615735	1706100
644	1615827	1706177
645	1615839	1706151
646	1615789	1706338
647	1616140	1706607
653	1616143	1706496
654	1616170	1706347
655	1616072	1706090
656	1616090	1706102
657	1616077	1705882
658	1615874	1705590
664	1615886	1705582
10395	1615569	1705739
10396	1615569	1705696
10415	1615754	1706554
10418	1615760	1706337
10420	1615782	1706595
10422	1615789	1706065
10425	1615800	1706166
10427	1615812	1706555
10430	1615818	1706338
10433	1615853	1706191
10435	1615875	1705623
10439	1615929	1705589
10446	1616050	1705899
10452	1616080	1706131
10459	1616104	1705865
10463	1616111	1706606
10465	1616114	1706083
10466	1616114	1706496
10470	1616142	1706338
10472	1616161	1706608
10473	1616170	1706558
10474	1616172	1706497
10478	1616197	1706357

G:\CIVIL\99118\DWG\PAVPH13 PART1\99118BM.DWG

MKEC ENGINEERING CONSULTANTS
411 N. WEBB ROAD
WICHITA, KS. 67206
316 - 684 - 9600

FOX RIDGE ADDITION - PHASE 13 - PART 1
PROJECT NAME

BUBBLE MAP
SHEET TITLE

DFL	MKrk	GJA
DESIGN BY:	DRAWN BY:	CHECKED BY:
SEPTEMBER 2005	99118	21 / 22
DATE	JOB NO.	SHEET/OF