


SCALE 1" = 40' HORIZ.
1" = 5' VERT.
IRON = ●

SEWER SERVICE TABLE

NUMBER	TYPE	LOCATION			STATION \ DIRECTION	FOR INFORMATION ONLY	
		LOT NO.	BLOCK NO.	LINE NO.		APPROXIMATE LENGTH 4" PIPE	VERTICAL
1	12" X 4" Tee Saddle	1	3	1	4+ 00.00 00.70	8'	6.5'
2	12" X 4" Tee Saddle	2	3	1	4+ 00.00 87.81	8'	6.0'

NOTE: Vertical Riser Pipe shall be extended to 2' minimum above ground water elevation and 4' maximum below proposed ground elevation.

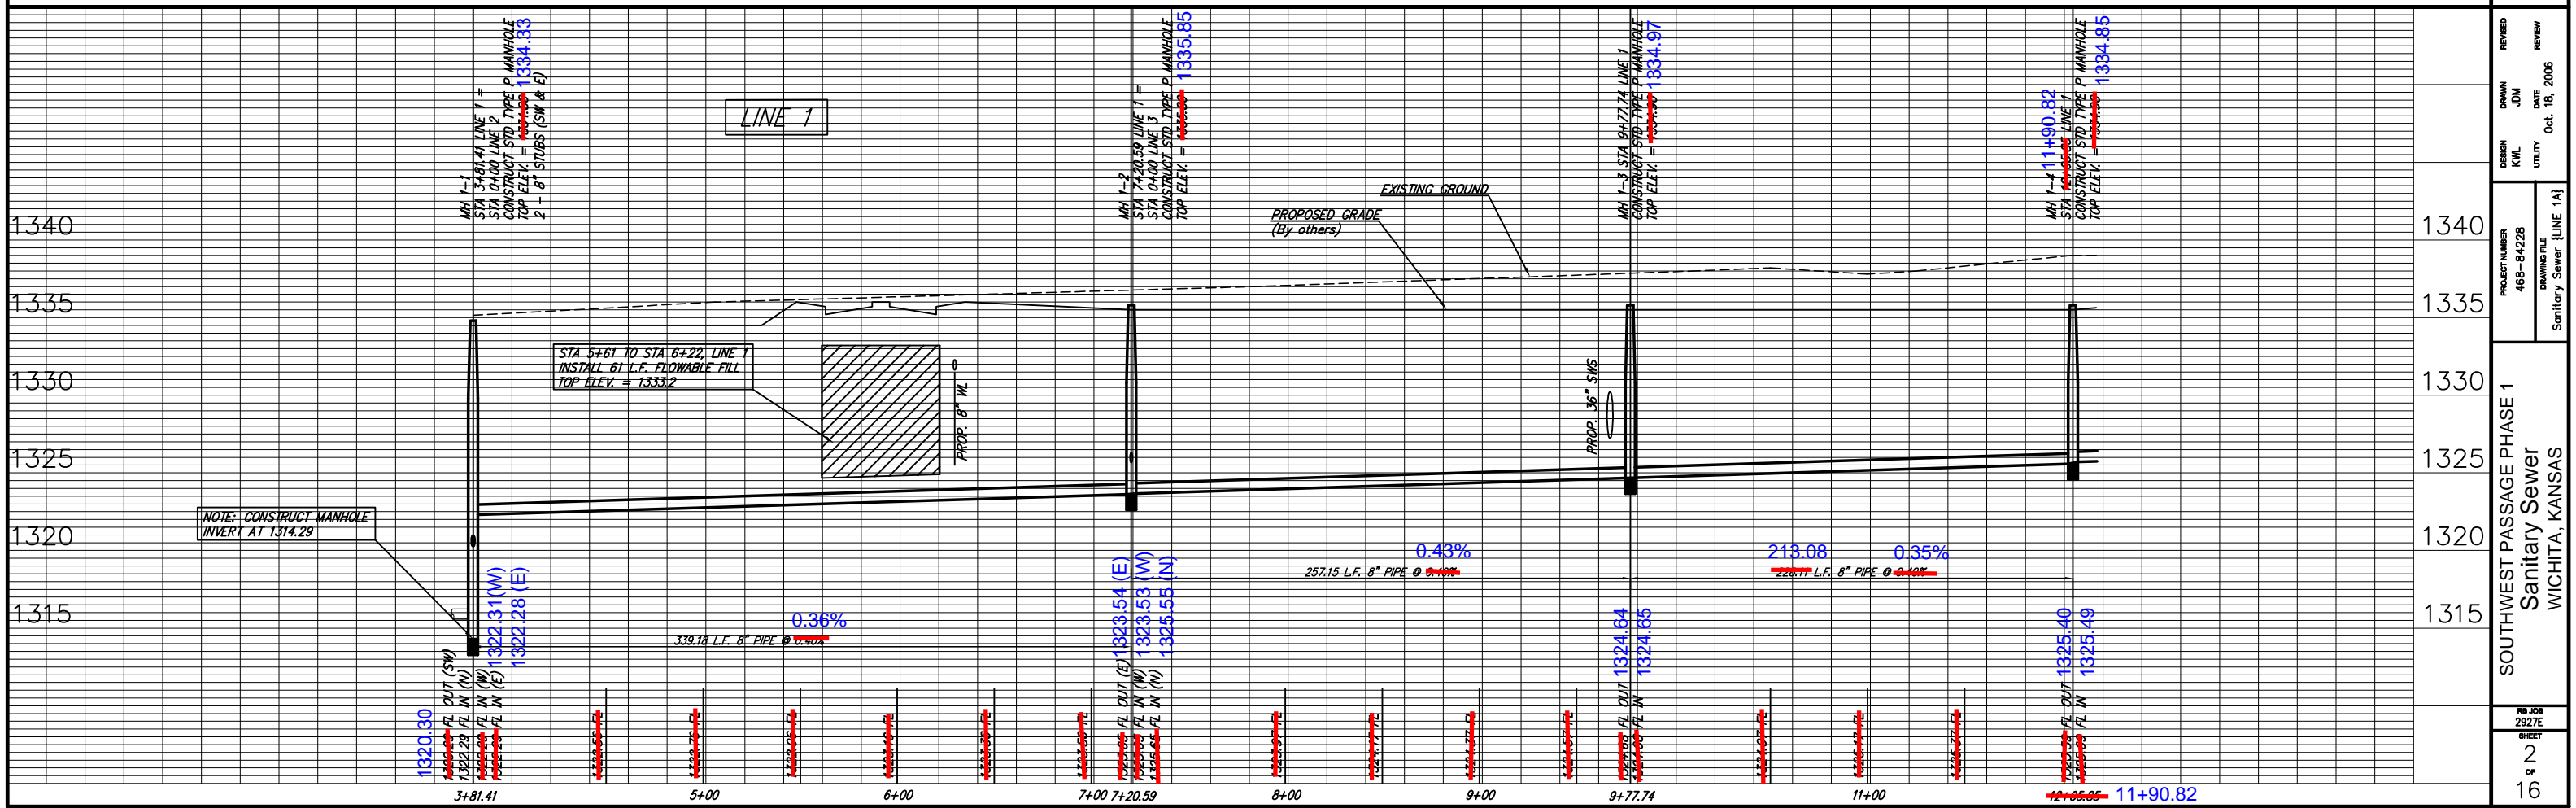

Ruggles & Bohm, P.A.
Engineering, Surveying, Land Planning

PROJECT NUMBER: 468-84228
DRAWING FILE: Sanitary Sewer [LINE 1A]
DESIGN: KWL
DRAWN: JDM
DATE: Oct. 16, 2006
REVIEW: []

SOUTHWEST PASSAGE PHASE 1
Sanitary Sewer
WICHITA, KANSAS

RB JOB: 2927E
SHEET: 2
16