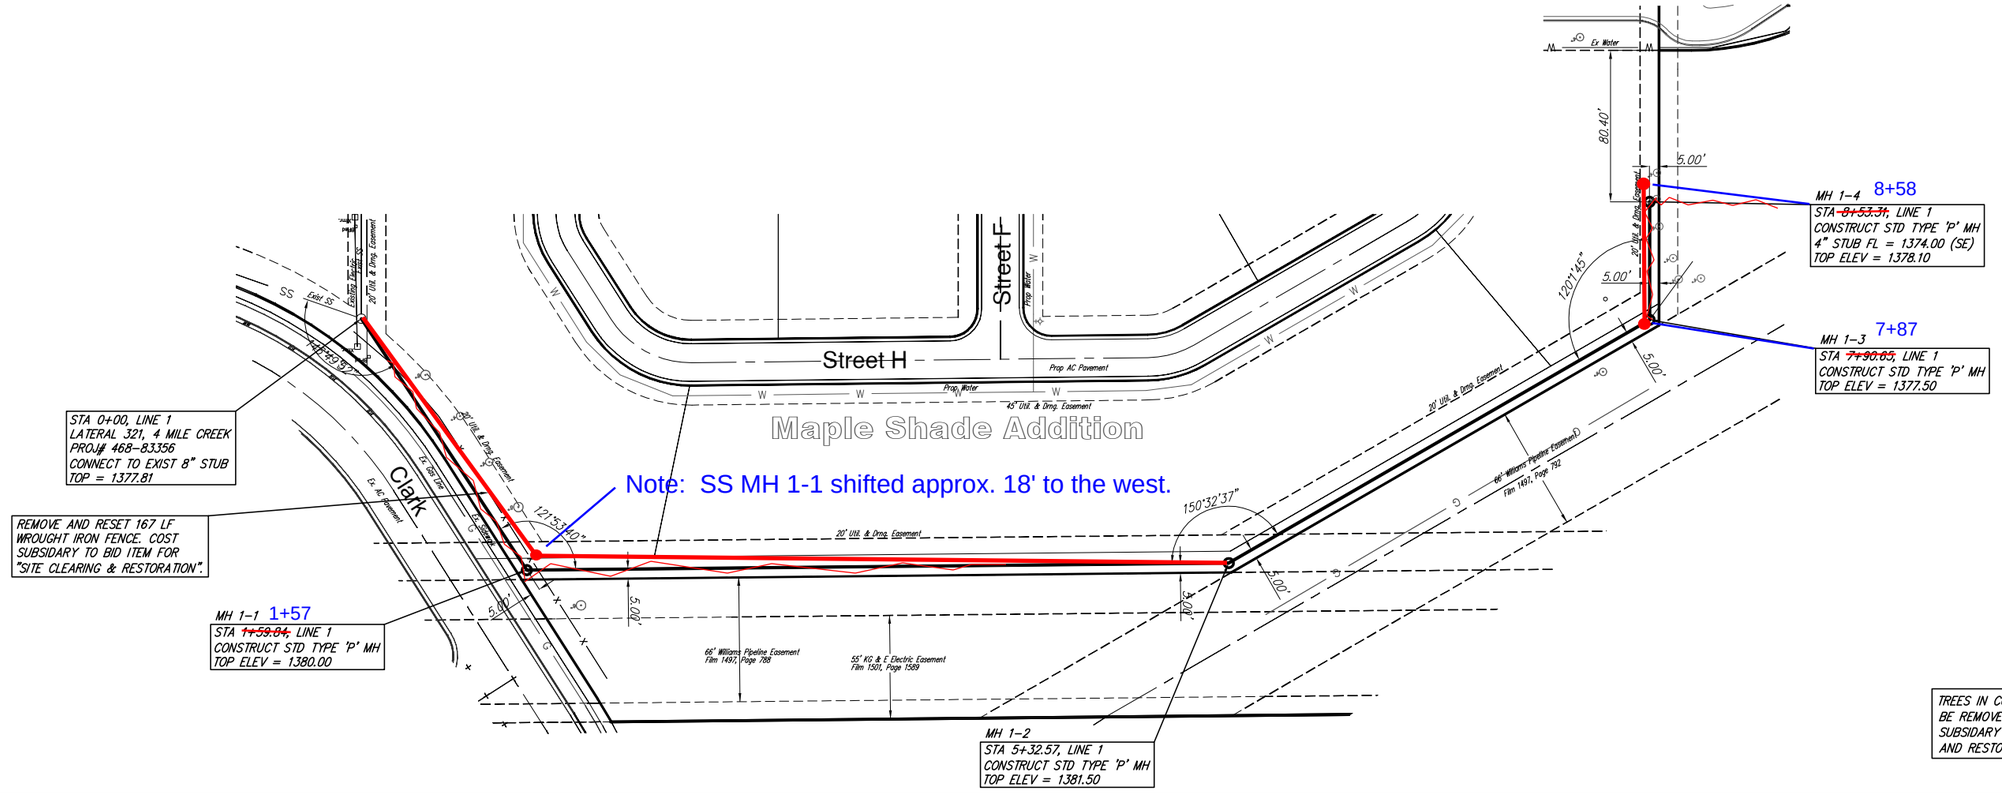
Street H
Street F
Maple Shade Addition
Clark
Ex. Water
Prop. Water
Prop. AC Pavement
45' Util. & Drng. Easement
20' Util. & Drng. Easement
66' Williams Pipeline Easement
Film 1497, Page 788
55' KG & E Electric Easement
Film 1501, Page 1589
