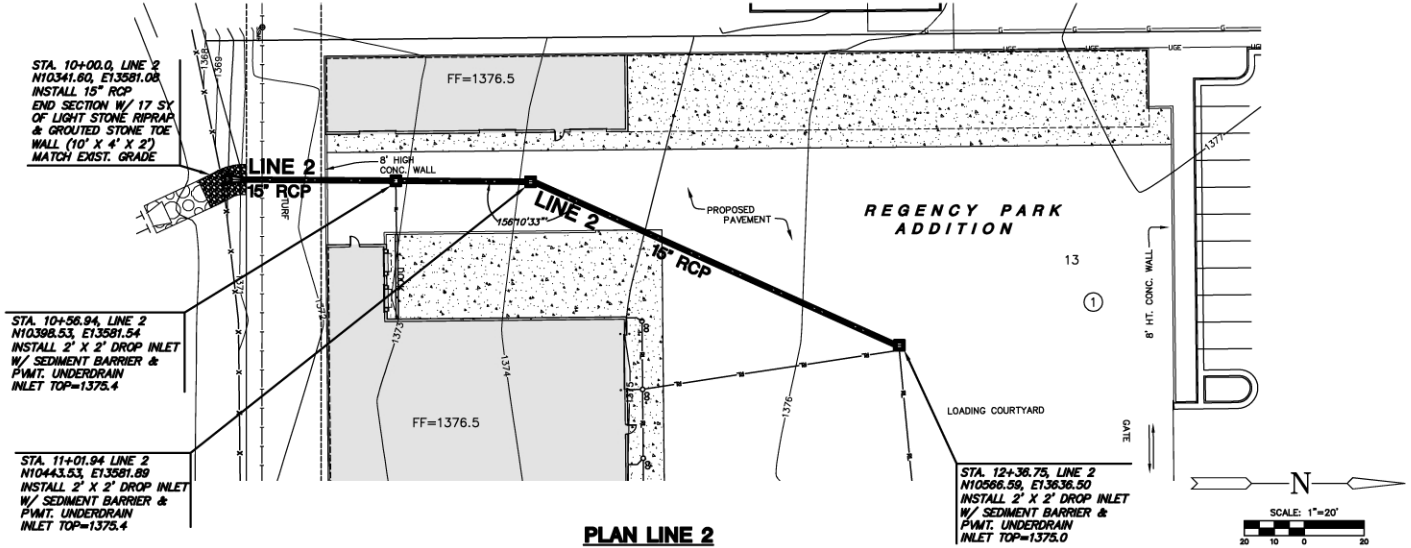

PLAN LINE 2

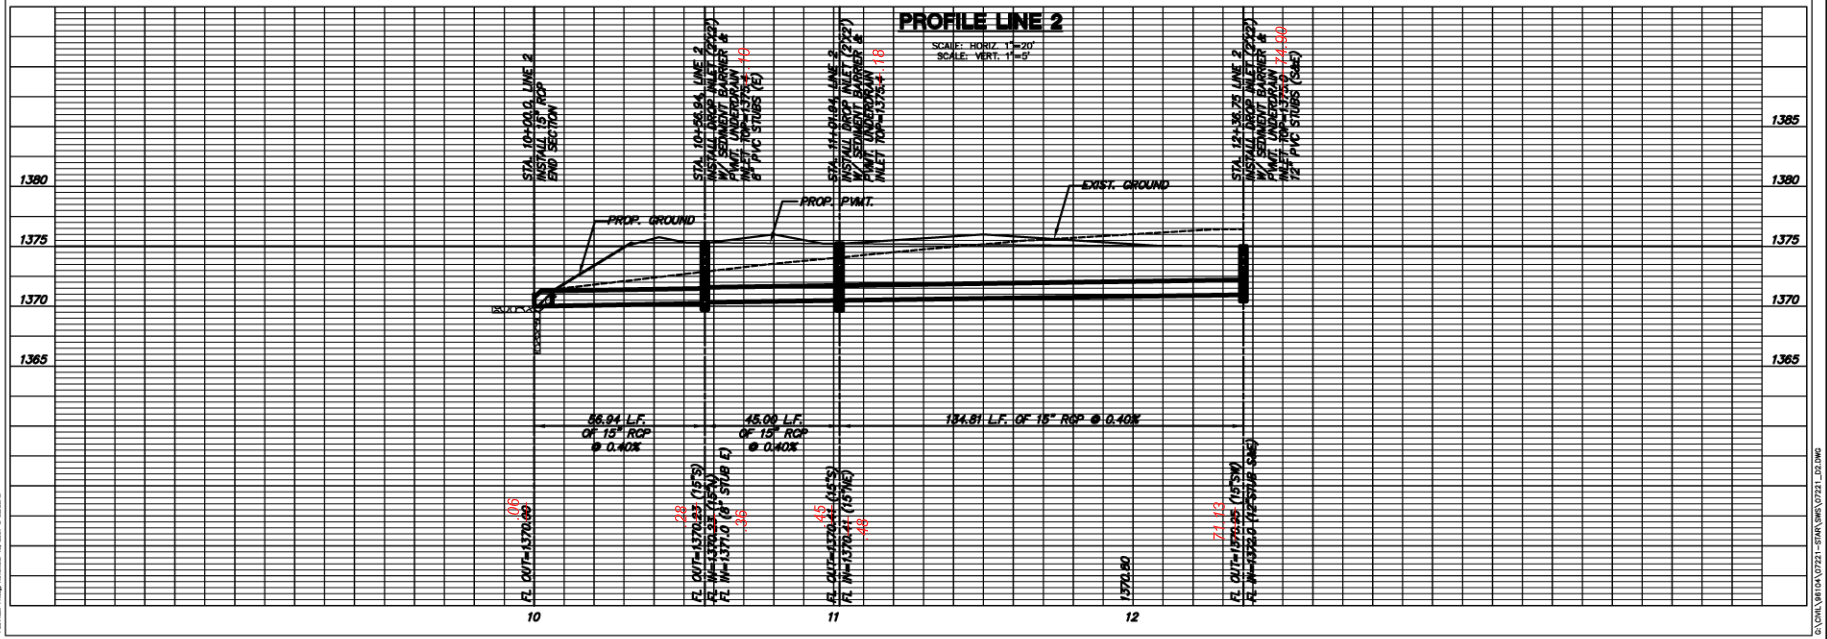

MKEC
ENGINEERING
CONSULTANTS, INC.
411 N. WEBB ROAD
WICHITA, KS. 67206
316-684-9600

PRIVATE STORM WATER SEWER PLANS
STAR LUMBER & SUPPLY CO.
LOT 13, BLOCK 1 REGENCY PARK ADDITION

SHEET TITLE: LINE 2
PROJECT NUMBER: 07221
DESIGN BY: SRS
DRAWN BY: JWC
CHECKED BY: MAB
ISSUED: JULY 2007
REVISED: NOV. 2007 (ADD INLETS)
SHEET NO.: 2 of 2

Q:\CML\96104\07221-STAR\SWS\07221_D2.DWG