
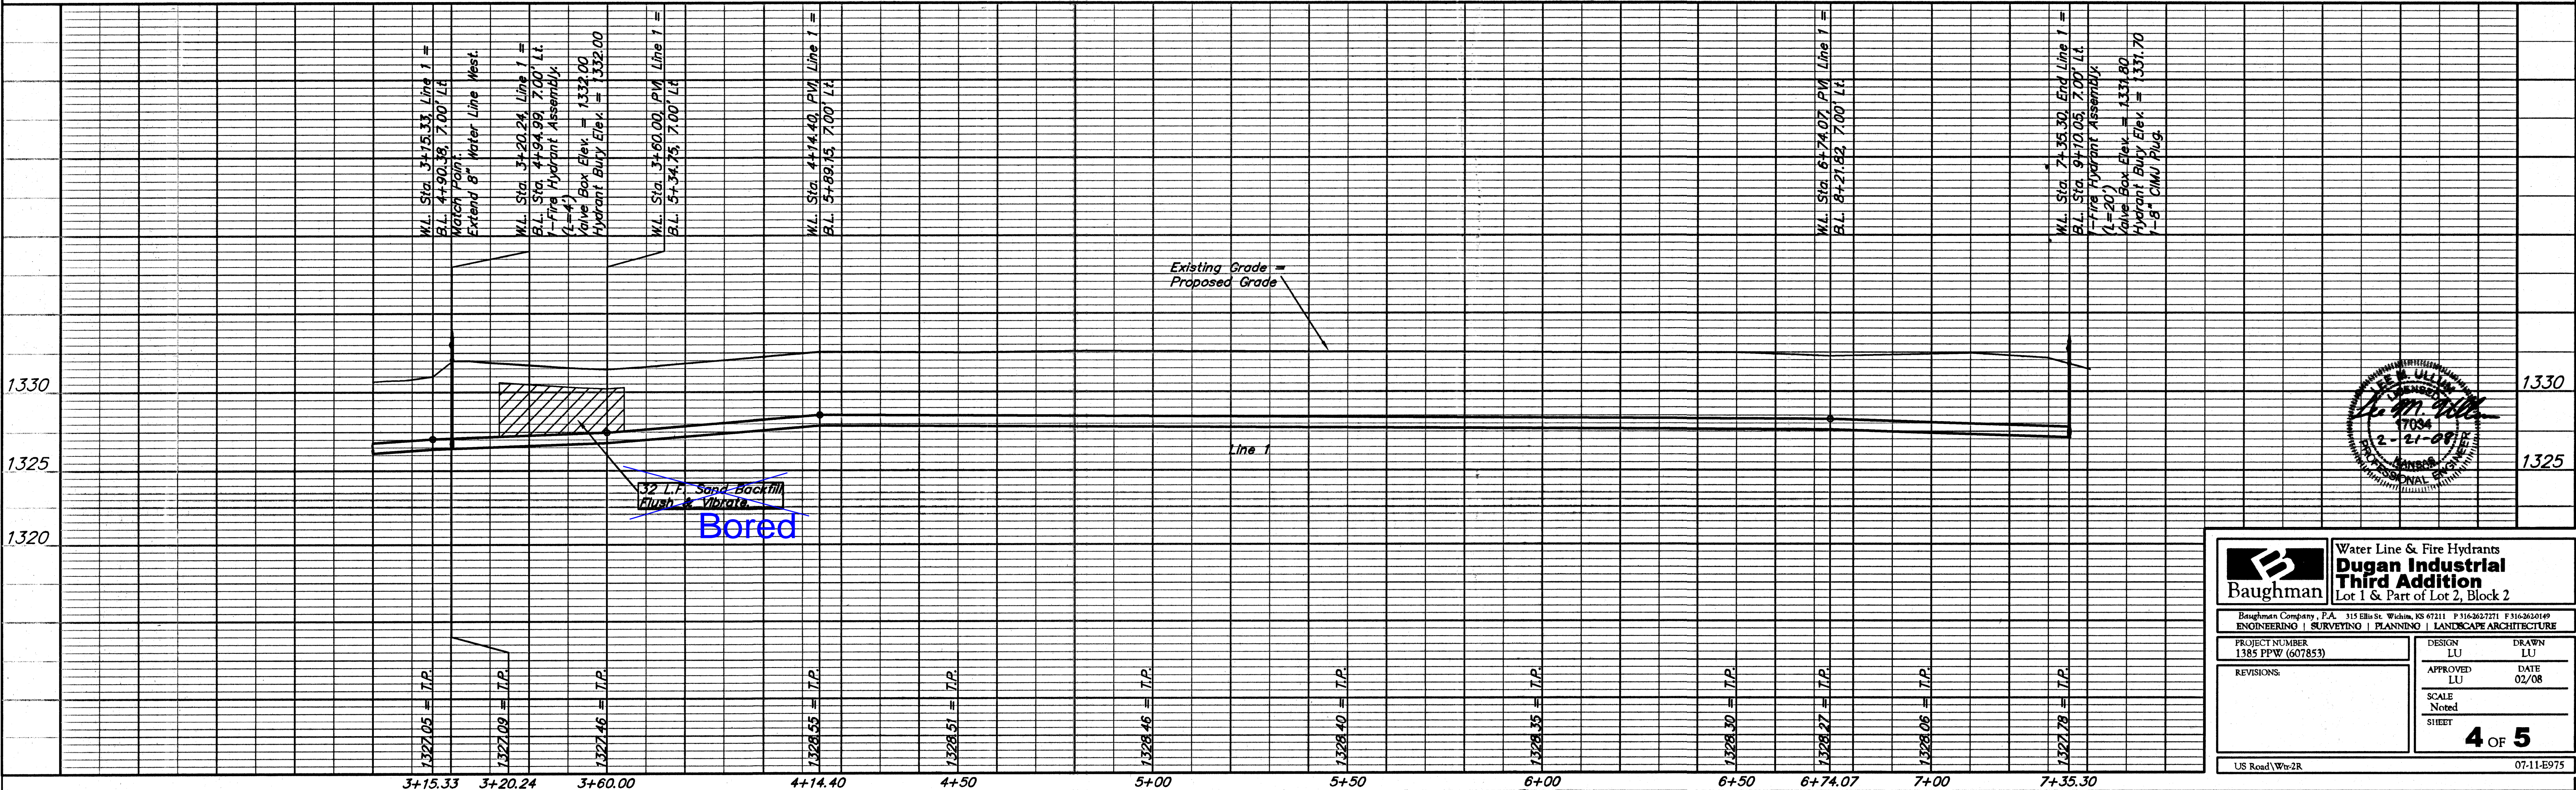


Bench Marks:

Small Railroad spike in Power Pole
Approximately 103' South of center
of South drive on West side of Maize
Road.
Elevation = 1331.01 (NGVD 29)

SCALE:
1" = 20' HORIZONTAL
1" = 5' VERTICAL

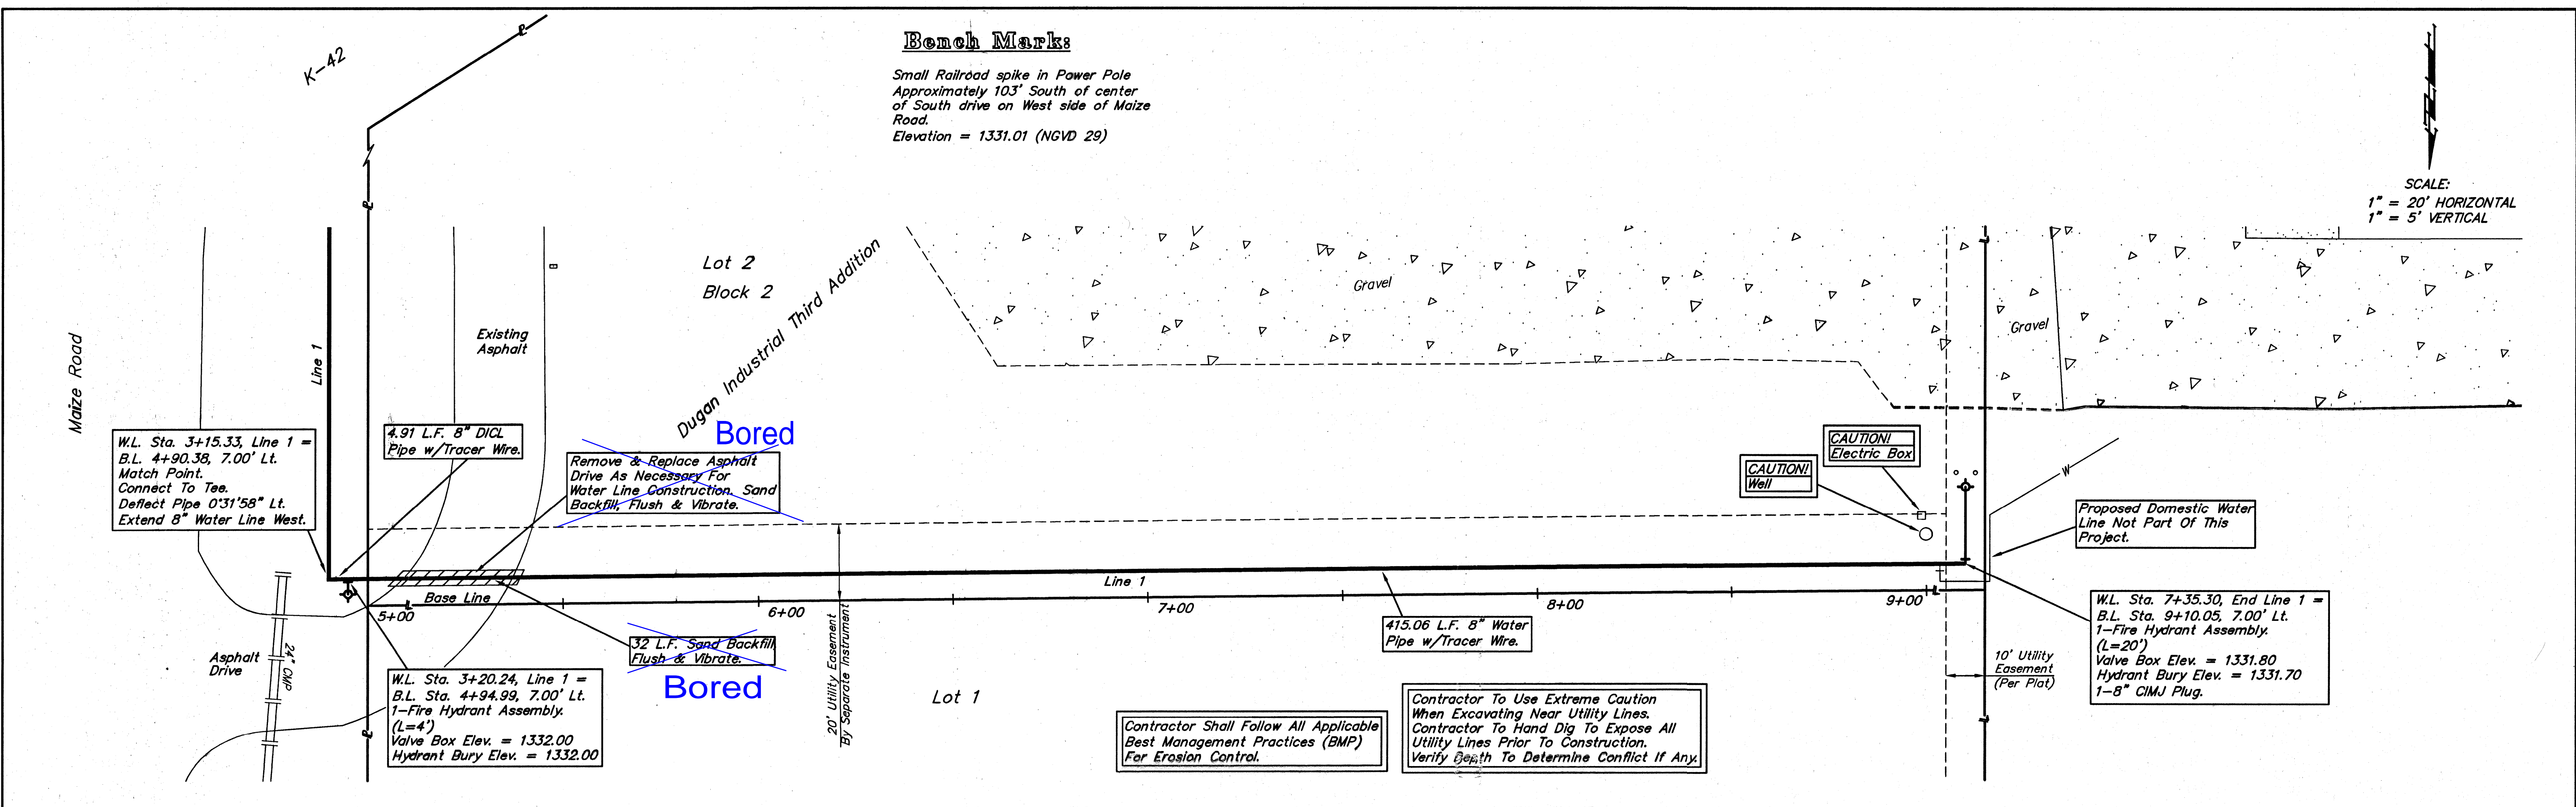

		Water Line & Fire Hydrants Dugan Industrial Third Addition Lot 1 & Part of Lot 2, Block 2	
<small>Baughman Company, P.A. 315 Ellis St. Wichita, KS 67211 F 316-262-7271 F 316-262-0149 ENGINEERING SURVEYING PLANNING LANDSCAPE ARCHITECTURE</small>			
PROJECT NUMBER 1385 FPW (607853)	DESIGN LU	DRAWN LU	DATE 02/08
REVISIONS:	APPROVED LU	SCALE Noted	SHEET 4 OF 5
<small>US Road/Wtr-2R</small>		<small>07-11-E975</small>	