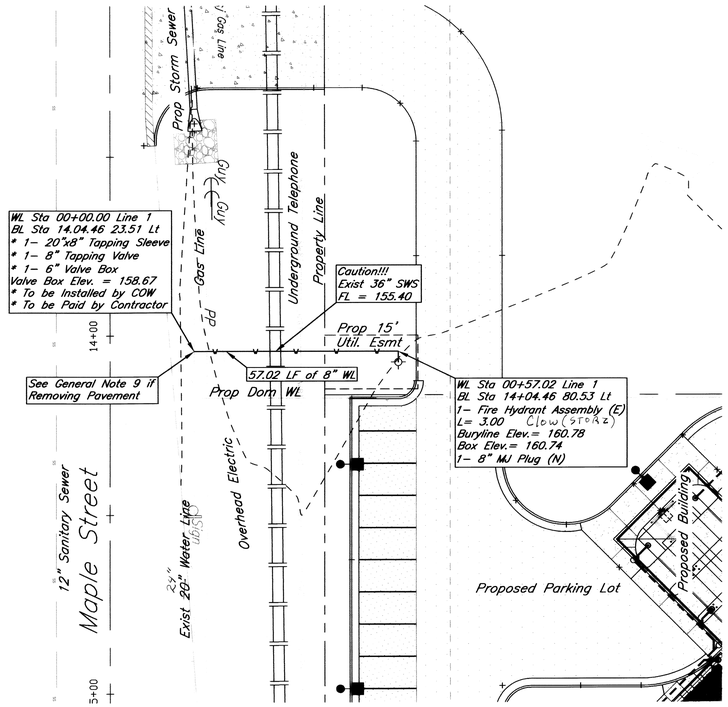

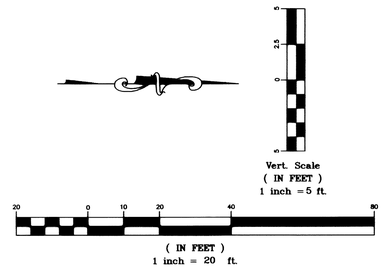

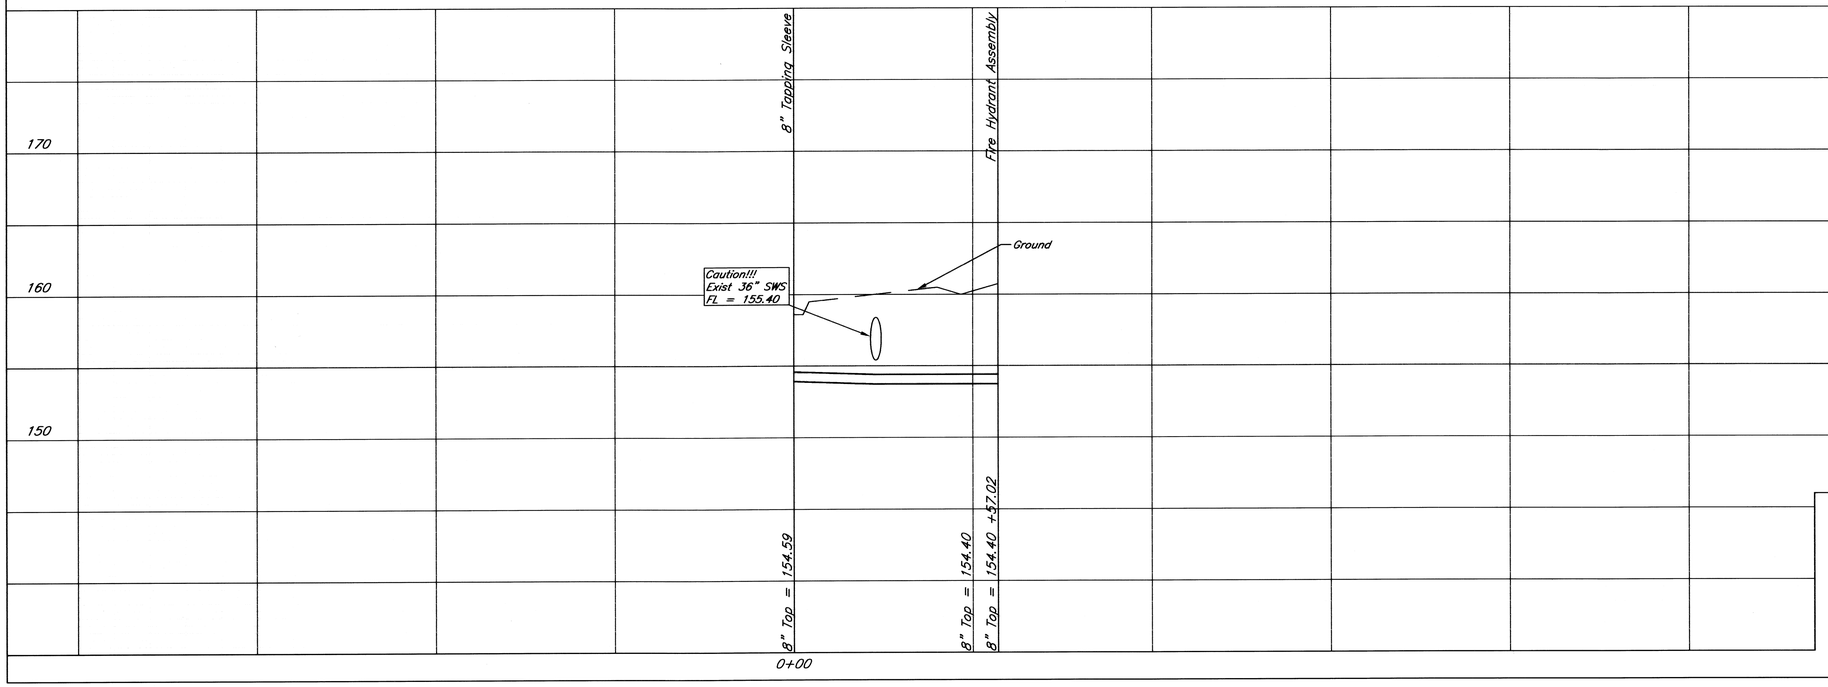

Boeing Wichita Credit Union

Water Line 1

135th & Maple Wichita, Kansas

kemiller engineering
516 S. Market,
Wichita, KS 67202
316/264-0242

PROJECT NUMBER			
KEM NO. 07134	FILE P&P	DATE 9/07	SHEET 2
DESIGN KM	DRAWN NS	REVISED	OF 3