
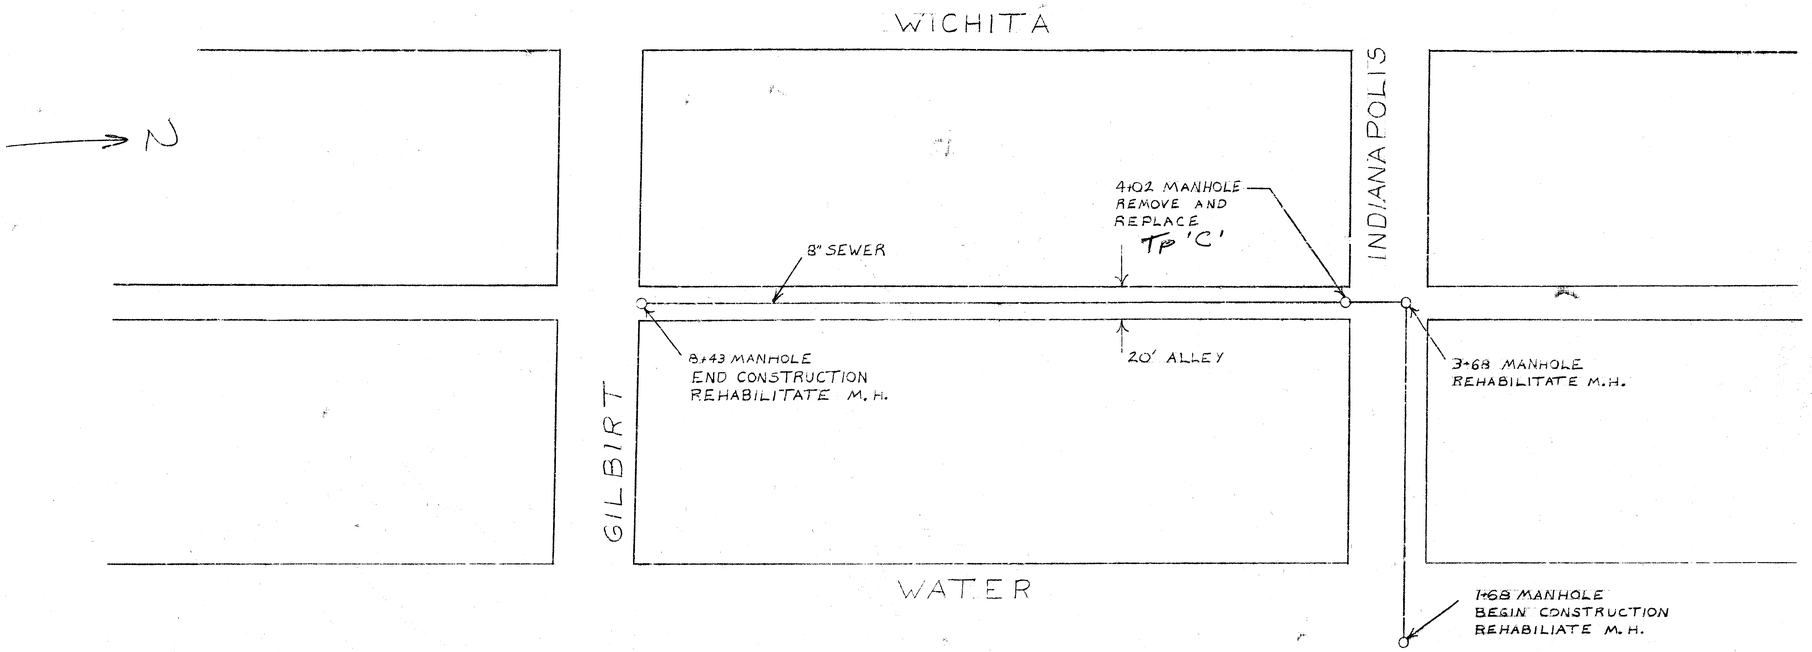


TAP+Y LOCATIONS	
STATION	DIRECTION
2+95	NORTH
4+08	EAST
4+33	WEST
4+53	WEST
4+57	EAST
4+85	EAST
5+05	WEST
5+50	WEST
6+24	WEST
6+27	EAST
6+69	WEST
6+70.5	EAST
7+15	WEST
7+19	WEST
7+21	EAST
8+19	EAST

SITE 1

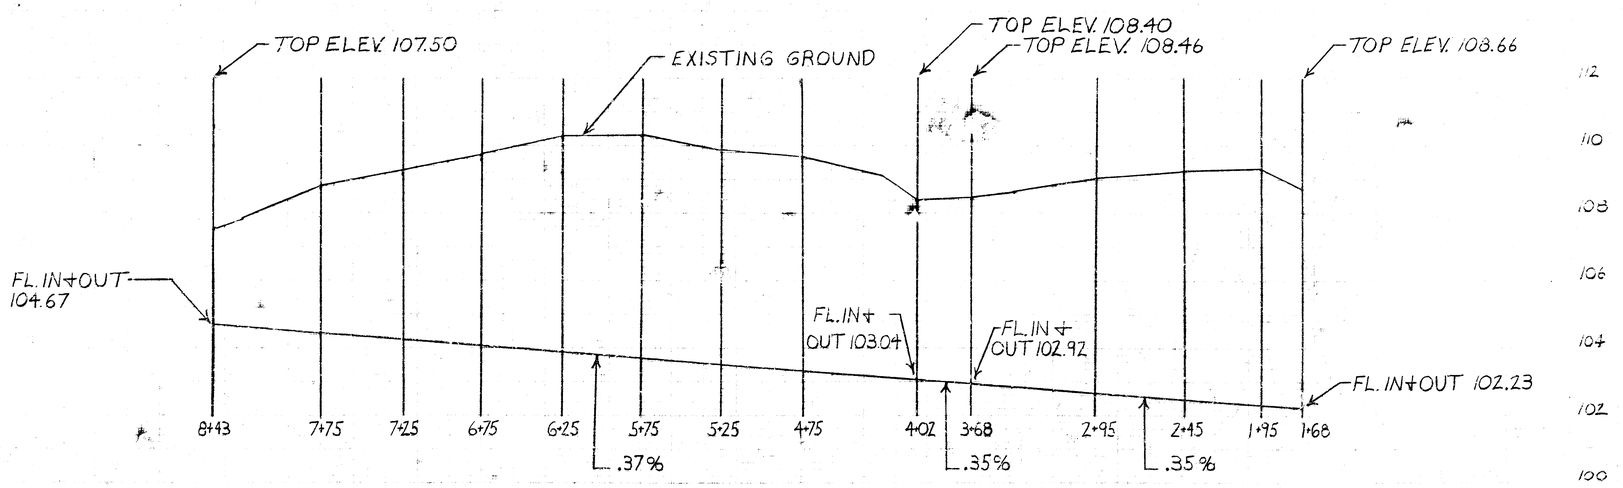

1990 S.S. Rehabilitation Proj II
BID 3 0426
9:18-82080
AS BUILT

MAIN

N

GILBIRT

INDIANAPOLIS

4+32 MANHOLE BEGIN CONSTRUCTION REHABILITATE M.H.

20'ALLEY

8" SEWER


7+47 REHABILITATE M.H.


10+62 REHABILITAE M.H. END CONSTRUCTION

TAP+Y LOCATIONS	
STATION	DIRECTION
10+23.5	WEST
10+21.5	EAST
10+18	WEST
10+11	WEST
9+67	EAST
8+26	EAST
8+02.6	EAST
7+78.5	EAST
7+76.8	WEST
7+50	WEST
6+96.2	WEST
6+24.5	WEST
6+01	WEST
5+54.6	WEST
5+05	WEST
4+82	WEST
4+37	WEST
4+39	EAST

MARKET


SITE 2

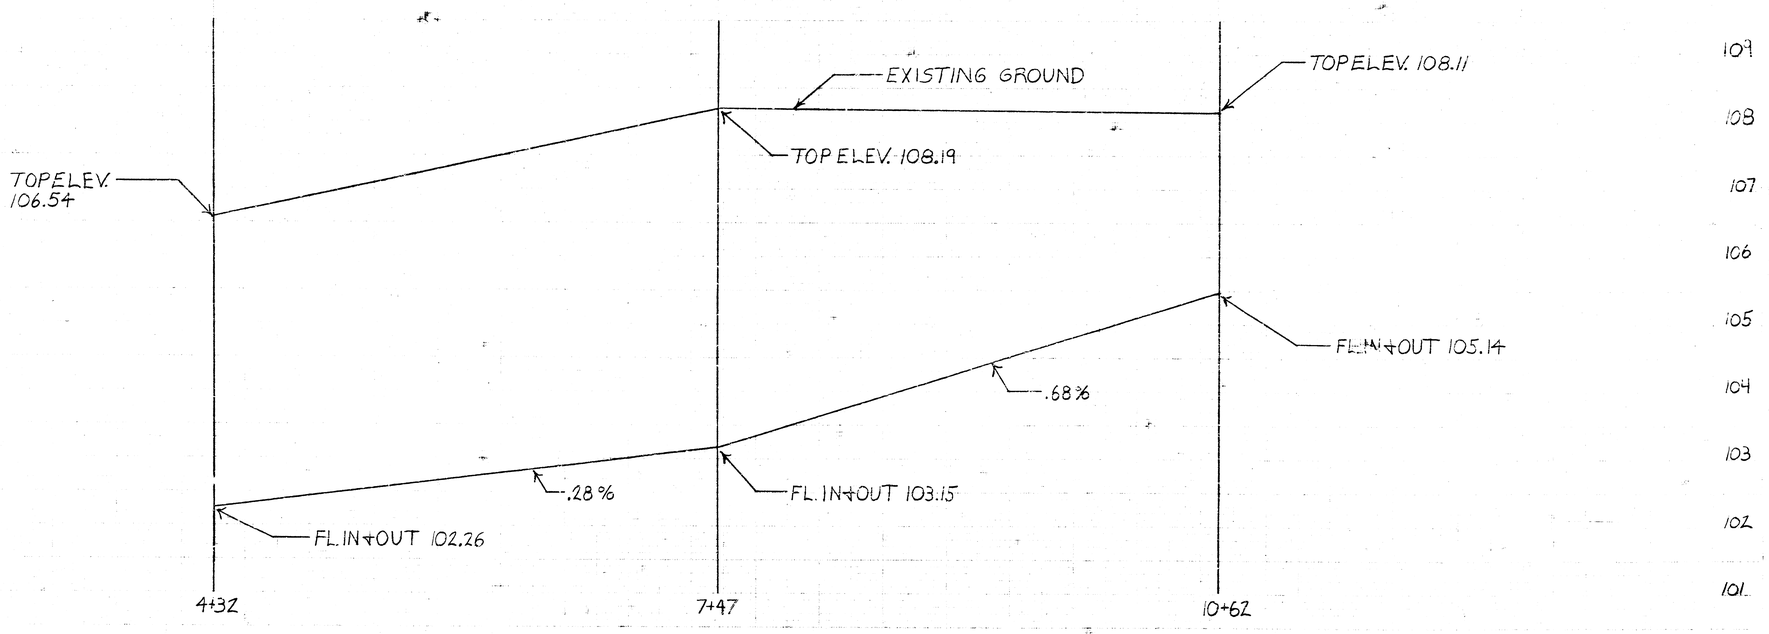

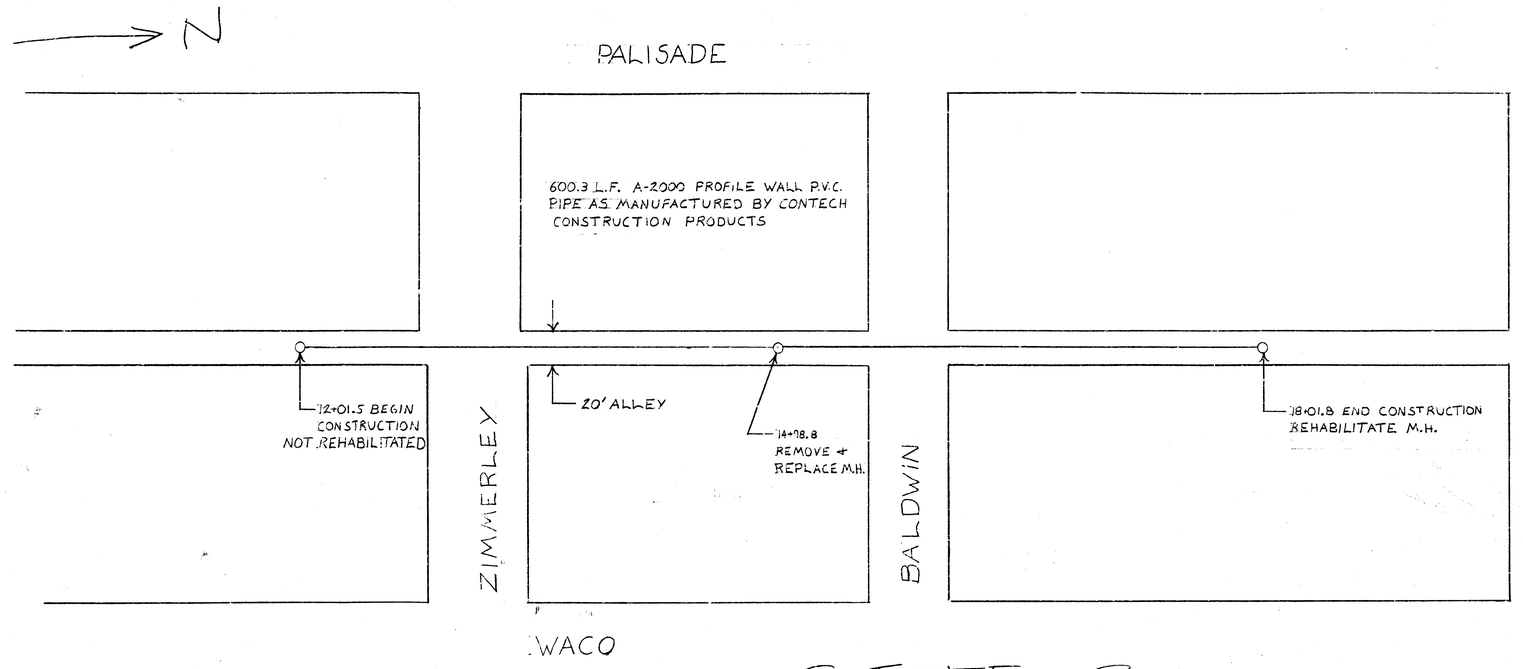

TAP-TV LOCATIONS	
STATION	DIRECTION
12+17	EAST
12+20	WEST
12+32.5	WEST
12+34	WEST
12+35.5	EAST
13+81	EAST
14+33	WEST
14+55	EAST
15+06	EAST
15+16	WEST
15+33	EAST
16+50	EAST
16+52	WEST
17+04	EAST
17+02	WEST
17+47	EAST
17+50	WEST
18+02	EAST
17+97	WEST

SITE 3

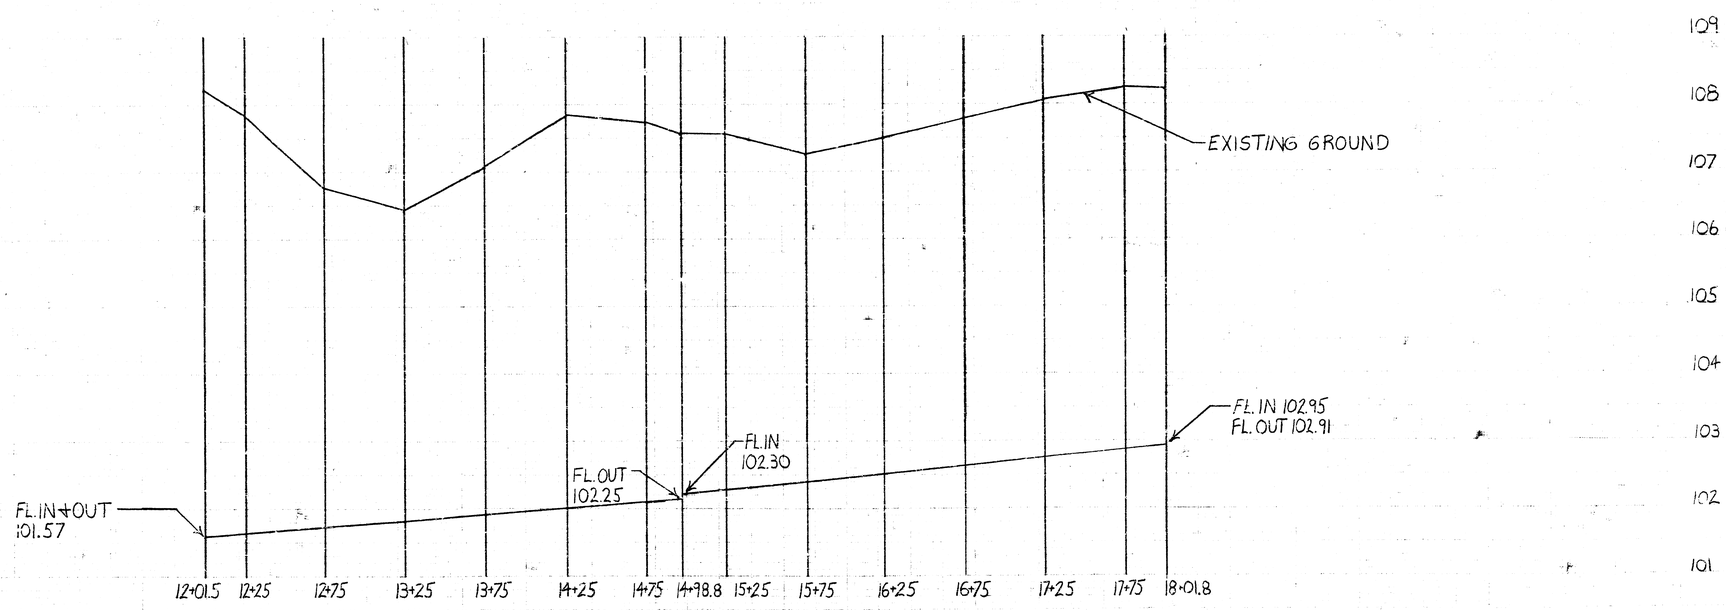

→ N

TOPEKA

551.1 L.F. ULTRA-RIB P.V.C. PIPE AS MANUFACTURED BY EXTRUSION TECHNOLOGIES INC.

20' ALLEY

0+39.3 BEGIN CONSTRUCTION REHABILITATE M.H.

2+95.5 REHABILITATE M.H.

5+90.4 END CONSTRUCTION REHABILITATE M.H.


HARRY


BOSTON

TAP-IN LOCATIONS	
STATION	DIRECTION
0+49	EAST
0+73	WEST
1+50	EAST
1+77	EAST
2+02	WEST
2+22	EAST
2+34	WEST
2+75	WEST
3+02	EAST
3+22	EAST
3+25	WEST
3+55	EAST
3+76	WEST
4+06	EAST
4+21	EAST
4+47	WEST
4+74	EAST
4+76	WEST
4+98	EAST
5+27	WEST
5+48	EAST
5+74	EAST
5+76	WEST


SITE 5


EMPORIA

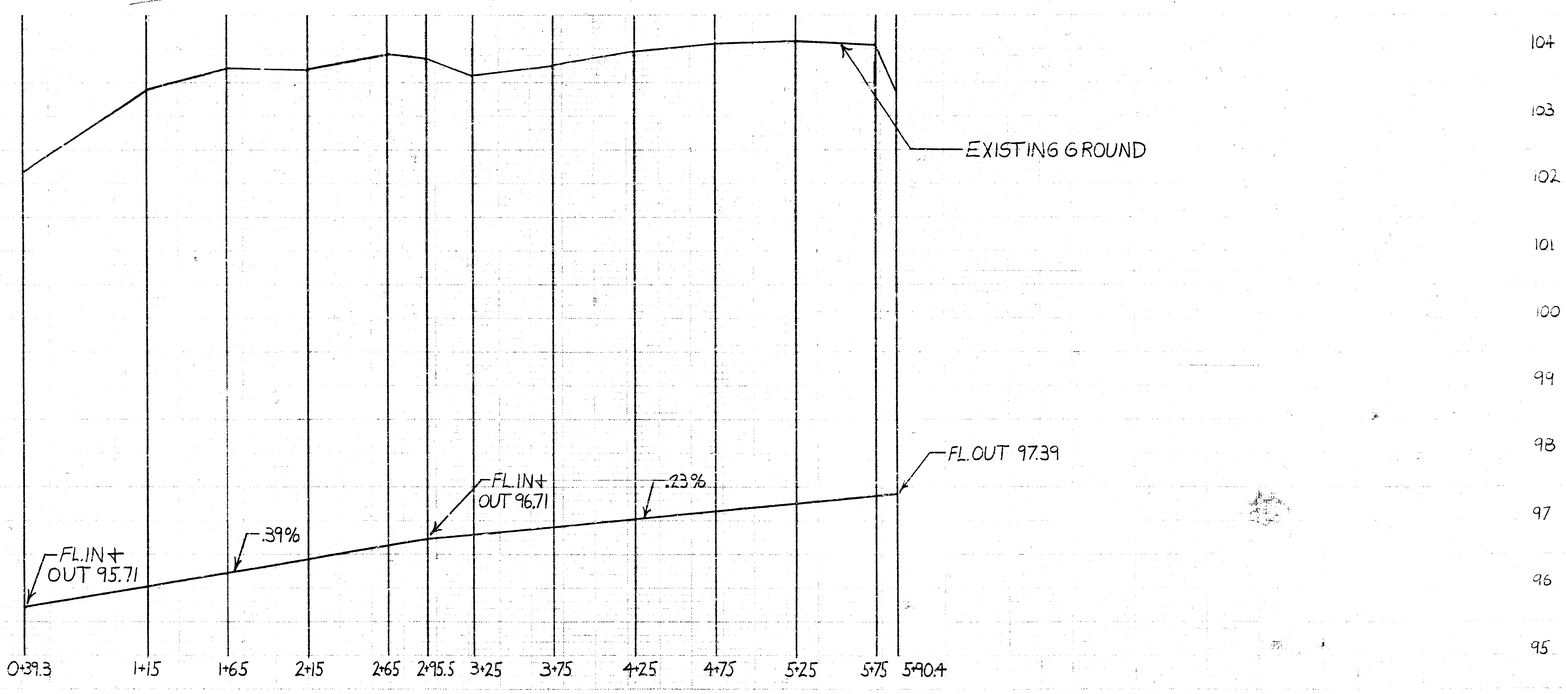

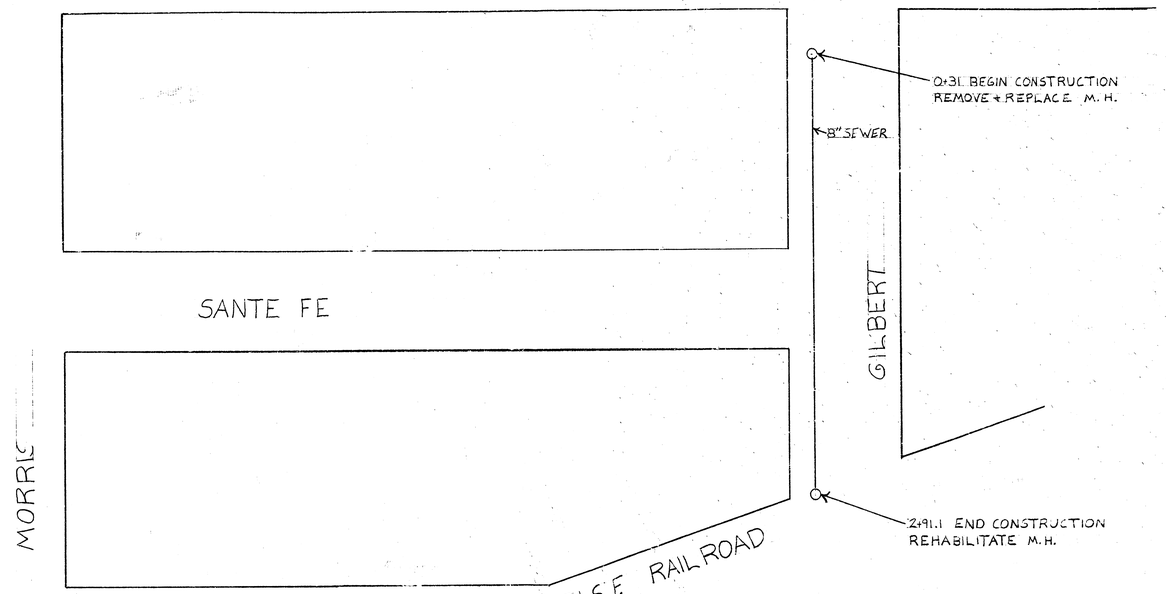
SANTE FE
MORRIS
A.T.&S.F. RAILROAD
GILBERT
0+31 BEGIN CONSTRUCTION
REMOVE & REPLACE M.H.
8" SEWER
2+91.1 END CONSTRUCTION
REHABILITATE M.H.
N


SITE 8

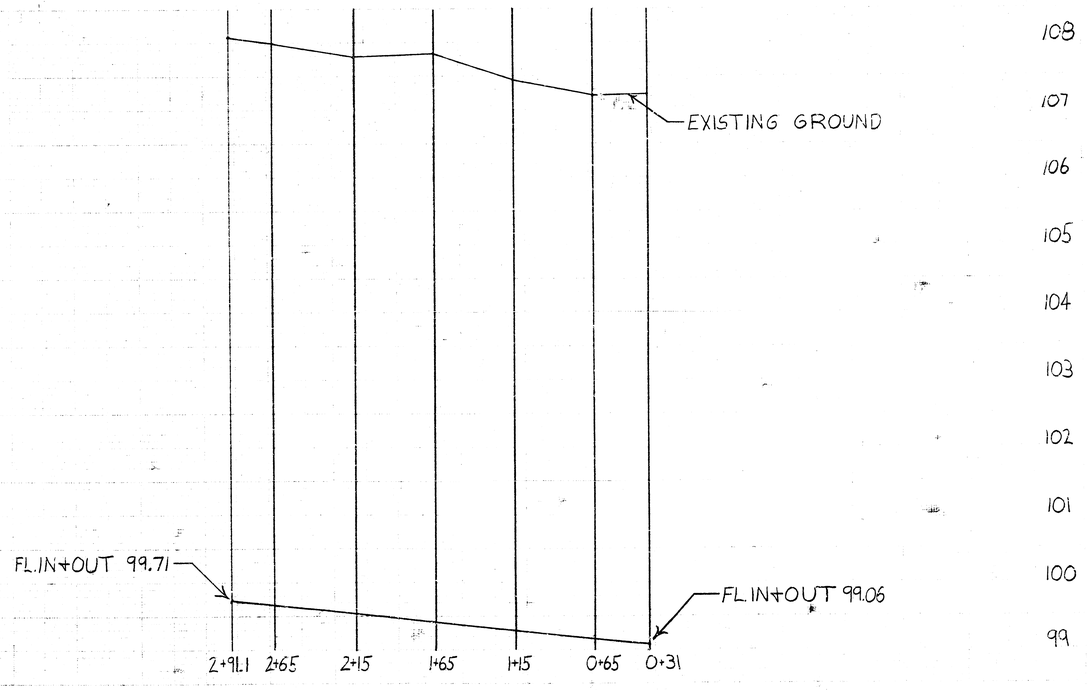

108
107
106
105
104
103
102
101
100
99
EXISTING GROUND
FL. IN+OUT 99.71
FL. IN+OUT 99.06
2+91.1
2+65
2+15
1+65
1+15
0+65
0+31

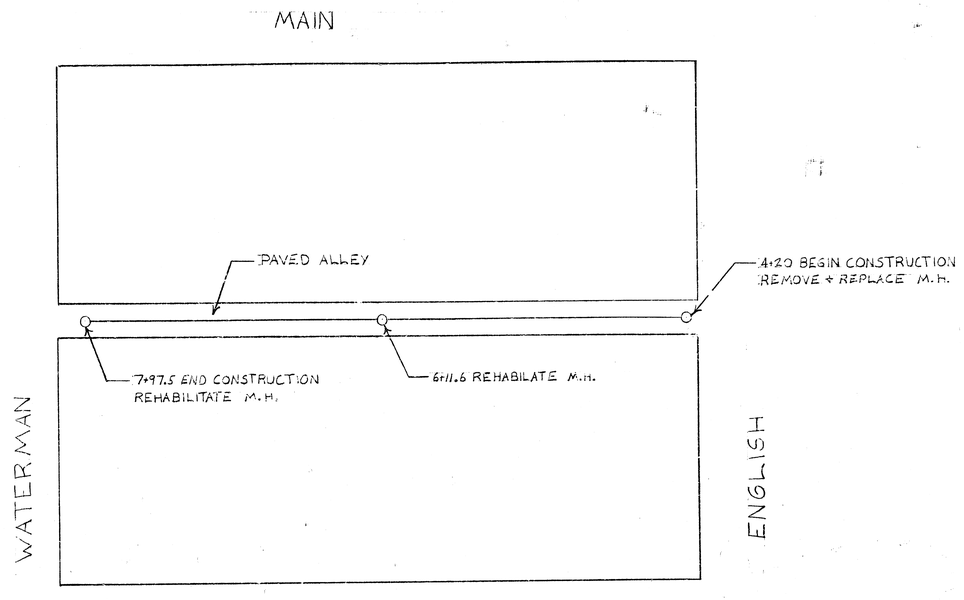


TAP-IN LOCATIONS	
STATION	DIRECTION
4+35	EAST
5+08	EAST
5+13	WEST
5+60	EAST
6+87	WEST
7+13	WEST
7+22	WEST

SITE 12

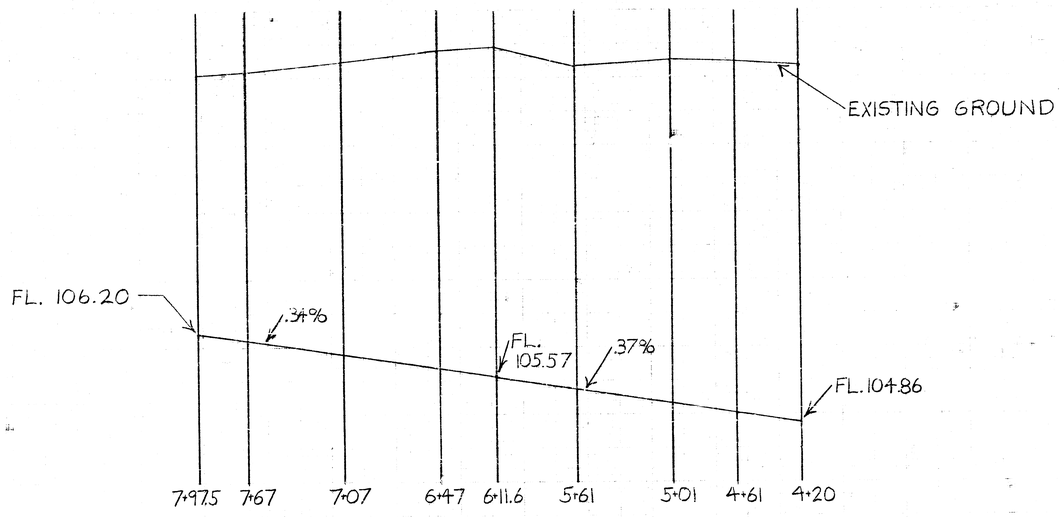

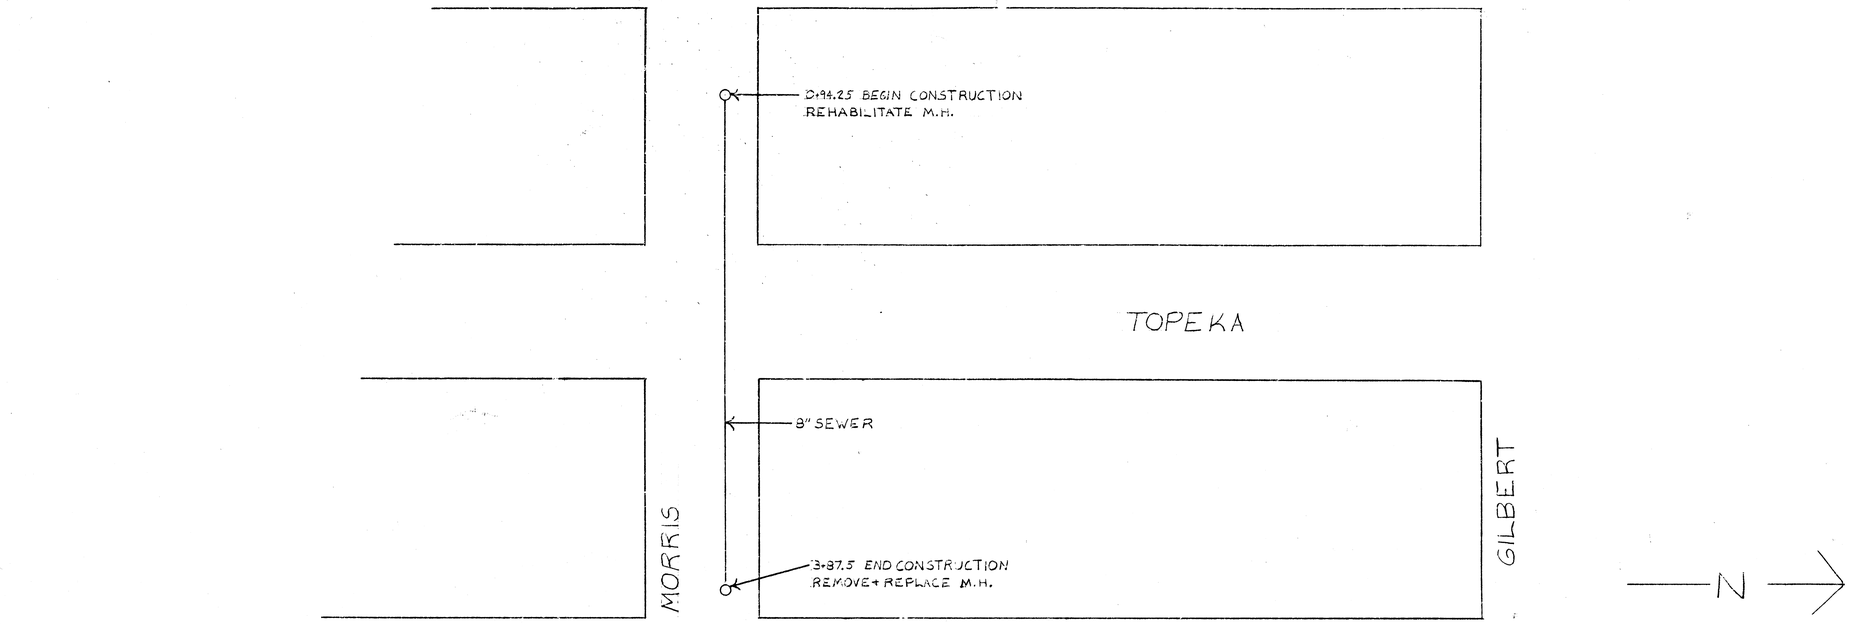



SITE 15

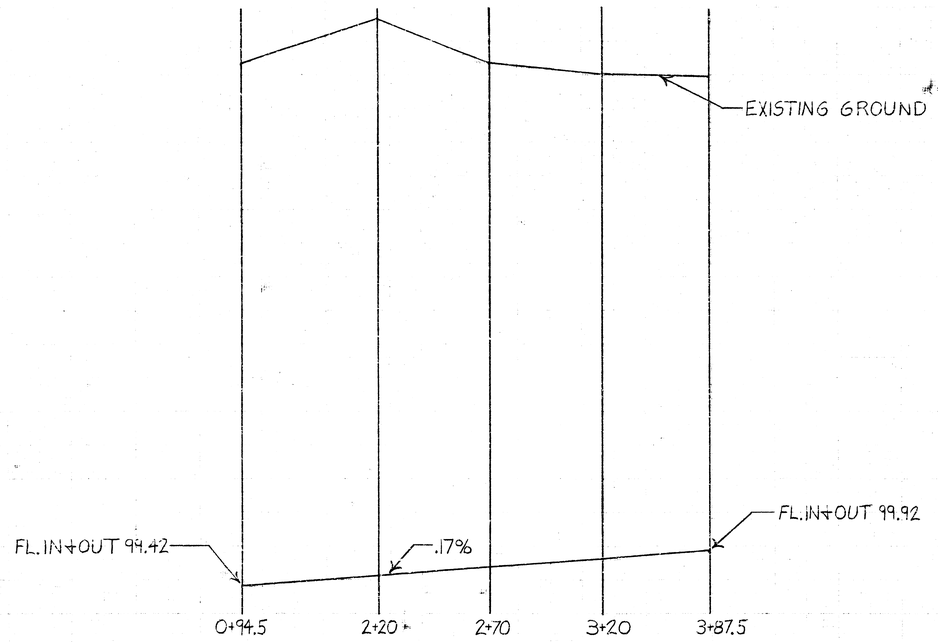


107
106
105
104
103
102
101
100
99

TAPPY LOCATIONS	
STATION	DIRECTION
4+29	WEST
4+38	EAST
4+59	WEST
5+02	EAST
5+40	EAST
5+63	WEST
5+65	EAST
6+07	EAST
6+65	EAST
6+84	WEST
7+10	EAST
7+15	WEST
7+34	EAST
7+38	WEST
7+91	WEST
8+10	EAST
8+33	WEST
8+35	WEST
8+60	EAST

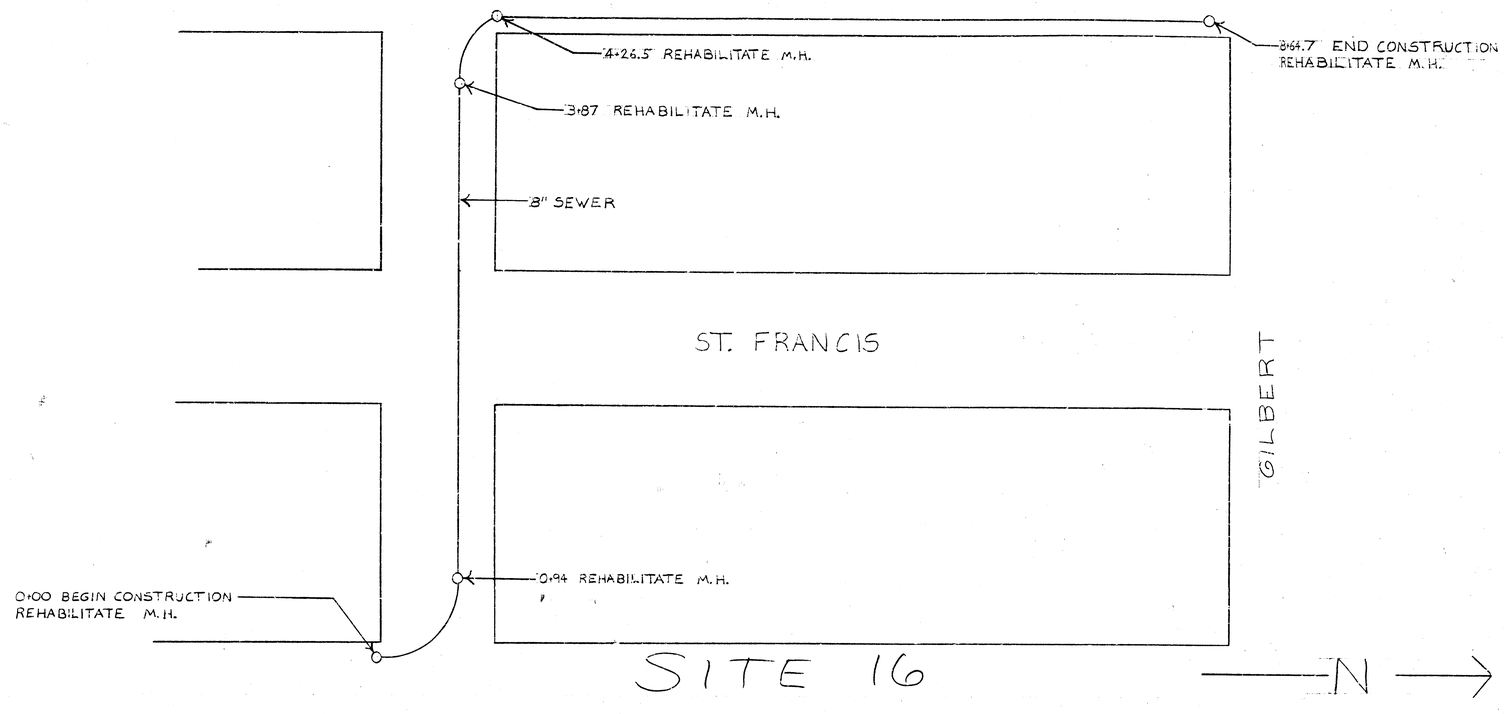

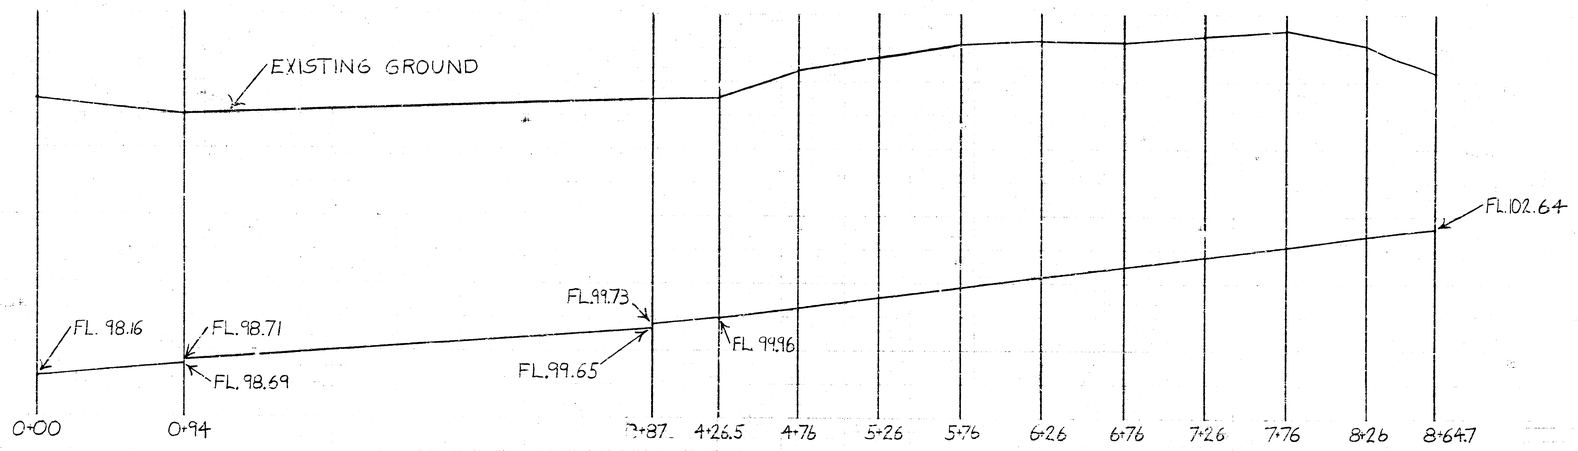

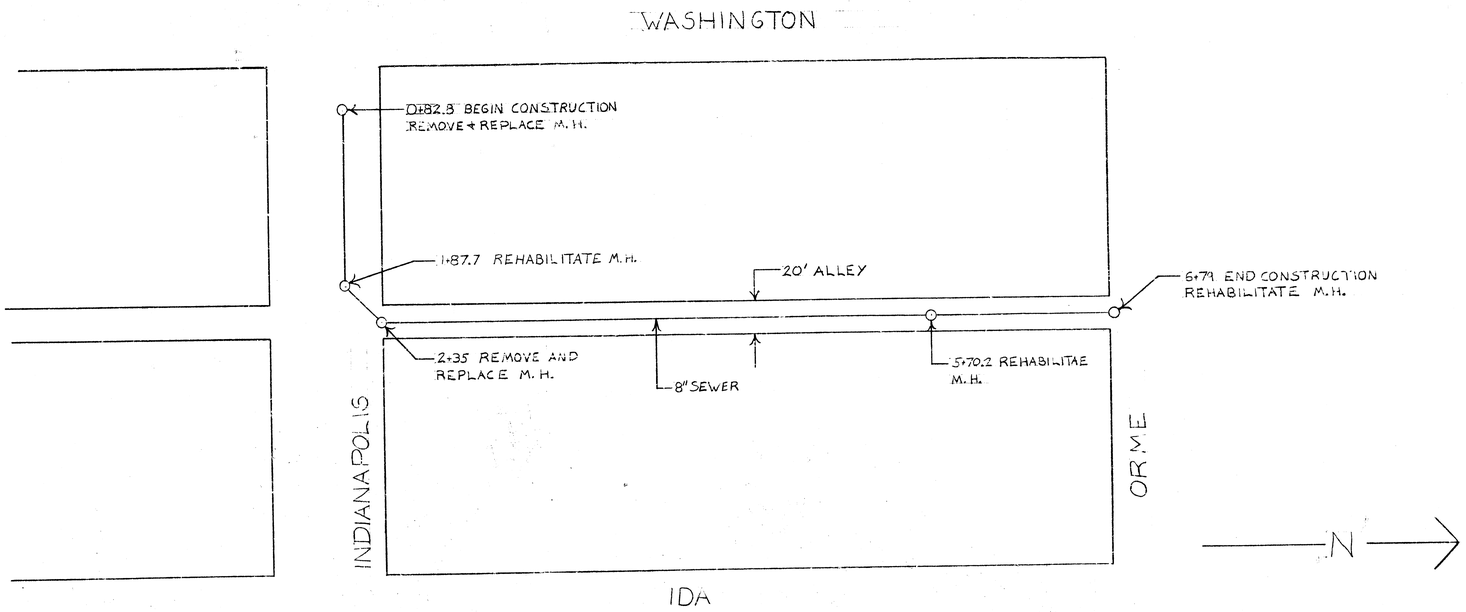

TAP-IN LOCATIONS	
STATION	DIRECTION
6+17.5	EAST
5+66	WEST
5+38.7	EAST
5+13.7	EAST
4+67.5	WEST
4+65	EAST
3+91.20	WEST
3+89.50	EAST
3+65.50	WEST
3+40.30	EAST
3+17	WEST
2+85.5	WEST
2+67.5	WEST
2+31	EAST

SITE 24

