


1947

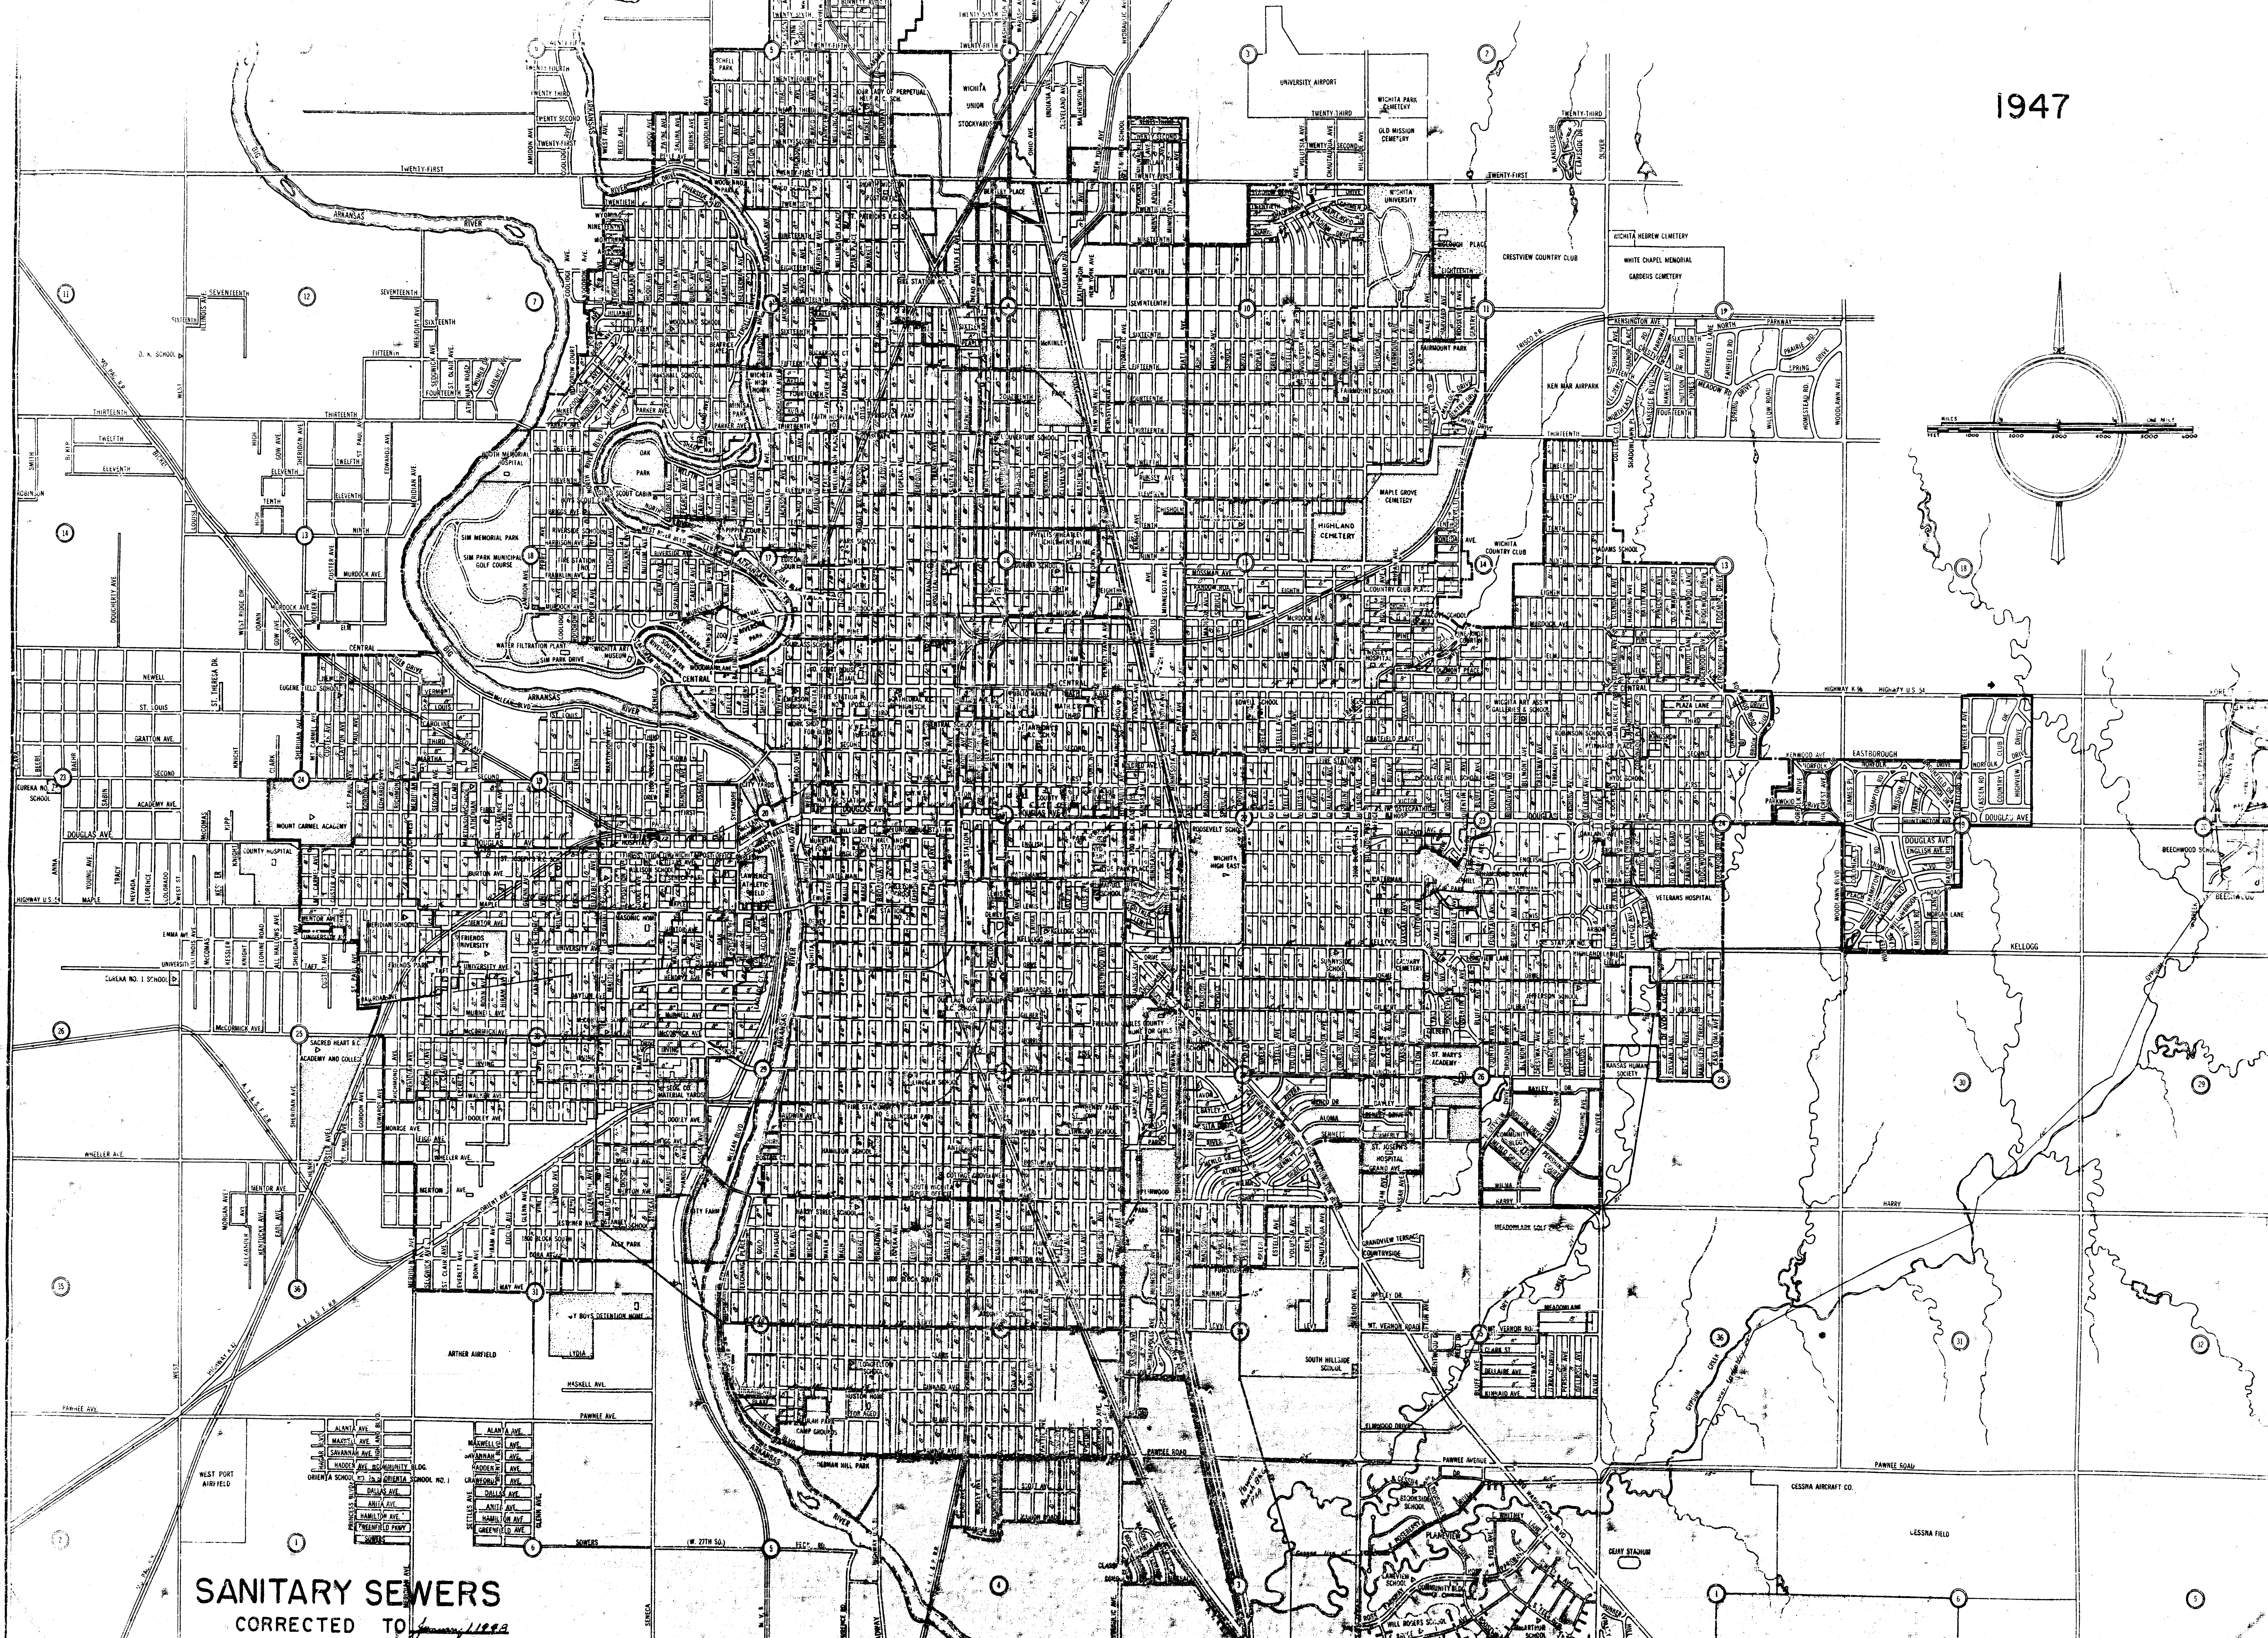

SANITARY SEWERS

CORRECTED TO January 1, 1947