

B-53

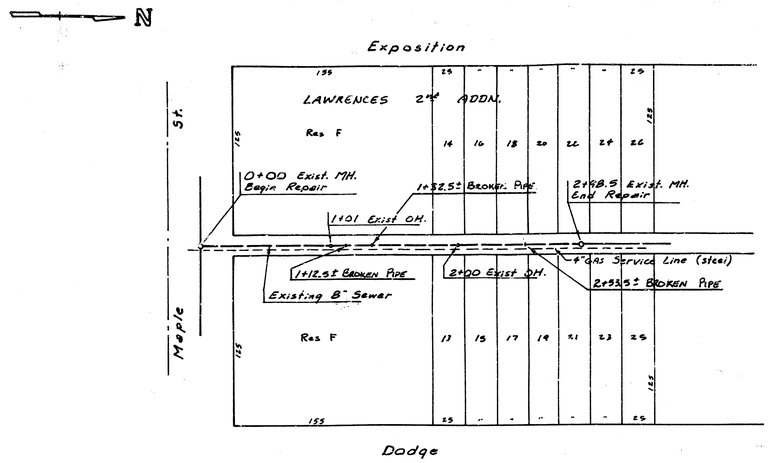



D-102

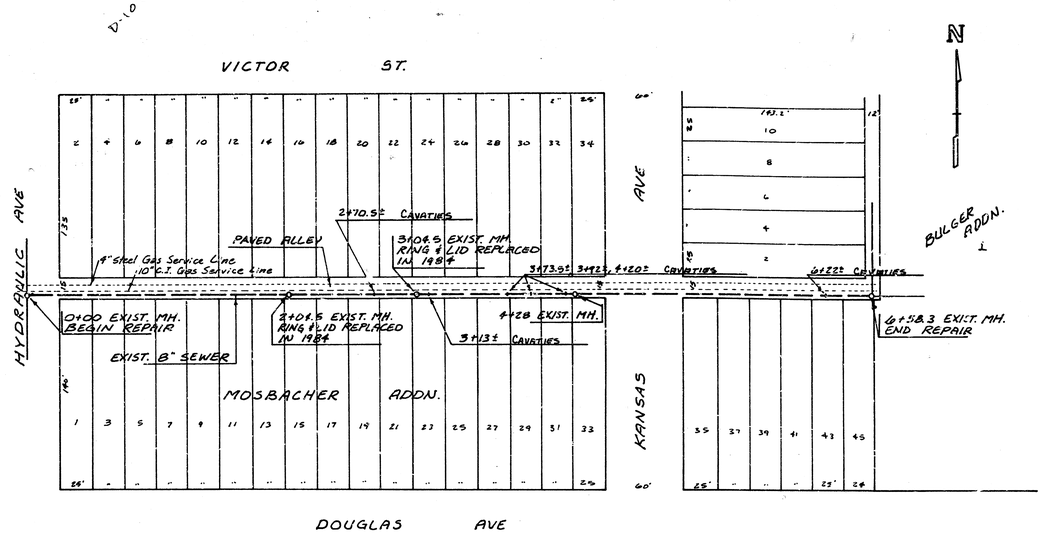



NOTE : CONTRACTOR TO MAINTAIN MINIMUM OF TWO-WAY ONE LANE TRAFFIC ON MAPLE AND HYDRAULIC.

NOTE : ARKLA GAS LINE - 2" IN E PARKING HYDRAULIC - 1½" PLASTIC GOING E. IN ALLEY - CHANGES TO 4" STEEL AND TERMINATES AT W.L. KANSAS.

SCALE PLAN 1"=50'
PROFILE 1"=50' HORZ.
1"=5' VERT.

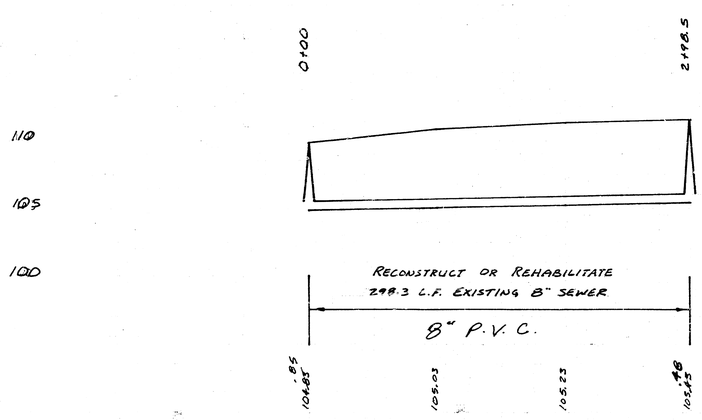

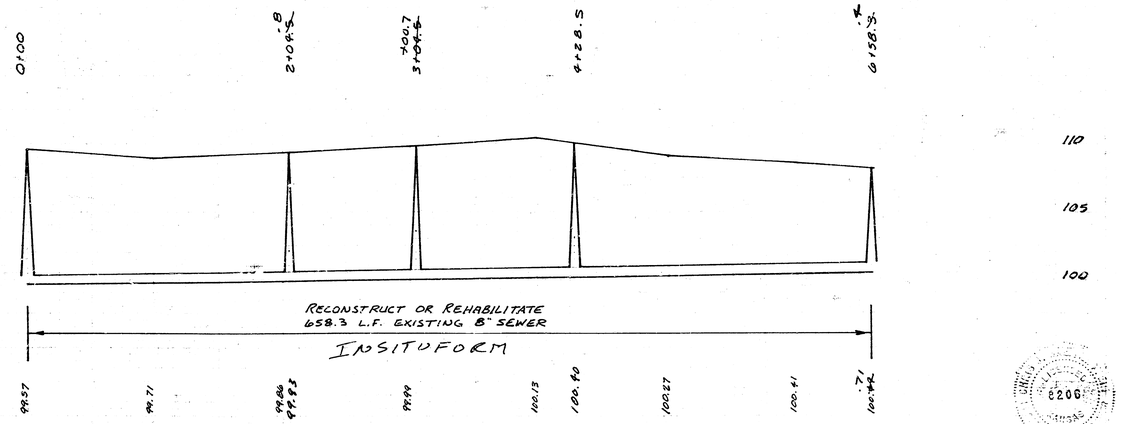
AS BUILT
R.D.L.
5-6-86

ALTER, REPAIR, RECONSTRUCT OR CONSTRUCT A SEWER TO SUPPLEMENT A PORTION OF LATERAL 13, SANITARY SEWER NO. 8 DISTRICT L, SANITARY SEWER NO. 20

M.E. LINDEBAK — CITY ENGINEER

PROJECT NUMBER
468-76-245-81541-000-000-001

1/3

FILMED FROM THE BEST AVAILABLE COPY

| FHWA REGION NO. | STATE | PROJECT NO. | FISCAL YEAR | SHEET NO. | TOTAL SHEETS |
|---|---|---|---|---|---|
| 7 | KANSAS | | 1986 | 2 | 3 |

P.O.S.T. Sta.28+34.72 ℄ Ridge Road = Sta.59+00 ℄ School Street
1. PK Nail at P.O.S.T.
2. No References

NE 1/4 Sec. 16, T27S, R1W

LT. & RT. E.P. CURVE DATA
P.I.'s 27.50' Lt. & Rt. Sta. 30+87.77 & 22.00' Lt. & Rt. Sta. 31+93.19
Δ=2°30'38"
D=2°00'00"
R=2,864.79'
T=62.77'
L=125.53'
E=0.69'

N
Scale 1"=50'

Sta.28+95.50 Construct Inlet (Type 22 Special) Rt. Install 16.50'x2.0' Storm Sewer (NE) See Sh. Nos 13,28,35,36

S.R. Sta.48+25.00, 26.0' Lt. to S.R. Sta.49+09.00, 26.0' Lt. Construct 84.00 L.F. Gravity Type Retaining Wall. S.R. Sta.49+09.00, 25.33' ± Lt. to M.L. Tang. Abd. Sta.28+69.71 ± Construct 81.00 L.F. "L" Type Retaining Wall. See Sh. No.45

Sta.42+95.50 Construct Inlet (Type 22 Special) Lt. Install 16.50'x2.0' Storm Sewer (SE) See Sh. Nos.13,28,35,36

Sta.28+07.00, 52' Lt. Adjust Exist. San. Sewer Manhole See Sh. No.34

S.R. Sta.49+40.00, ℄ Const. Manhole (Spec. Std.) Connect to 9'x4' RCB See Sh. Nos.13,30,37

S.R. Sta.49+33.00 ℄ to S.R. Sta.50+12.11, 7.37' Rt. Const. 9'x4'x79' RCB See Sh. Nos.13,40,42,43

Sta.30+46.00 Construct Inlet (Spec. Curb Opening) Lt. Install 36"x59" Storm Sewer (E) See Sh. Nos.13,29,35,37

COUNTRY ACRES SECOND ADDITION

Milford S. L. Bingstad
Bessie Bingstad

Sylvester J. Breit

Stephen D. Neff
Karen Neff

Judy Dunnemuth

Billy R. Hobson
Martha Jane Hobson

Wayne E. Roberts
Sharon K. Roberts

Jon P. Stuhlsatz
Celeste S. Stuhlsatz

Jen-Chung Cheng
Wei Yun Cheng

HOLE IN PIPE

SPOT REPAIR - REMOVE & REPLACE 10" VCP AS REQUIRED

RIDGE ROAD

Leonard P. Hamilton
Cynthia L. Hamilton

SUMMITLAWN ADDITION

SCHOOL ST.

Sylvester B. Dick
Bernice I. Dick

See Sh. No 22 for Intersection Details

Melvin C. Trammell
Mary A. Trammell

Lawrence R. Foley
Debra L. Foley

Charles L. Herrington
Louise C. Herrington

Jerry B. Wallace

Charley F. Thomas II
Sharon L. Thomas

COUNTRY ACRES FOURTH ADDITION

℄ Sta.28+45.29, 35.39' Rt. to ℄ Sta.30+43.15, 35.33' Rt. Const. 6'x4'x197'-6" RCB See Sh. Nos.13,40,42,43

Sta.30+46.00 Construct Inlet (Spec. Curb Opening) Rt. Connect to 6'x4'x207' RCB Storm Sewer (S) See Sh. Nos.13,29,35,37

℄ Sta.28+22.21, 33.20' Rt. to ℄ Sta.28+25.29, 35.39' Rt. Const. RCB Transition See Sh. Nos.13,40,42,43

℄ Sta.28+34.14, 36.68' Rt. Const. Manhole (Spec. Std.) Connect to RCB Transition See Sh. Nos.13,30,37

NW 1/4 Sec. 15, T27S, R1W

Datum BM
SW #5 - C.O.W. SW Disc 49' W. ℄ Ridge Rd. & 34' S. ℄ School St. 46' Lt. Sta. 27+98 Elev. 1132.19

UTILITIES

| | |
|---|---|
| Power | KG&E |
| Telephone | Southwestern Bell Tel. Co. |
| Cable TV | Air Capital Cablevision |
| Gas 1 | KPL Gas Service Co. |
| Gas 2 | Arkla Gas Co. |
| San. Sewer | Wichita Sewer Maintenance Div. |
| Water | Wichita Water Dept. |

ALTER, REPAIR, RECONSTRUCT OR CONSTRUCT A SEWER TO SUPPLEMENT A PORTION OF COUNTRY ACRES SANITARY SEWER
PROJ. NO. 468-76-245-81541-000-000-001

M. E. LINDEBAK — CITY ENGINEER
WICHITA, KANSAS

| Designed by | | Checked by | | |
|---|---|---|---|---|
| Drawn by | | Date Dec., 1985 | Job No. | 2/3 12 |

J-187

FILMED FROM THE BEST AVAILABLE COPY


| FHWA REGION NO. | STATE | PROJECT NO. | FISCAL YEAR | SHEET NO. | TOTAL SHEETS |
|---|---|---|---|---|---|
| 7 | KANSAS | | 1986 | 3 of 3 | |

NE 1/4 Sec. 10, T27S, R1W

LT. E.P. CURVE DATA
P.I. 19.93' Lt. ℄ Sta. 45+58.78
Δ=7°26'56"
D=2°00'00"
R=2,864.79'
T=61.23'
L=122.44'
E=0.65'

N
Scale: 1"=20'

COUNTRY ACRES THIRD ADDITION

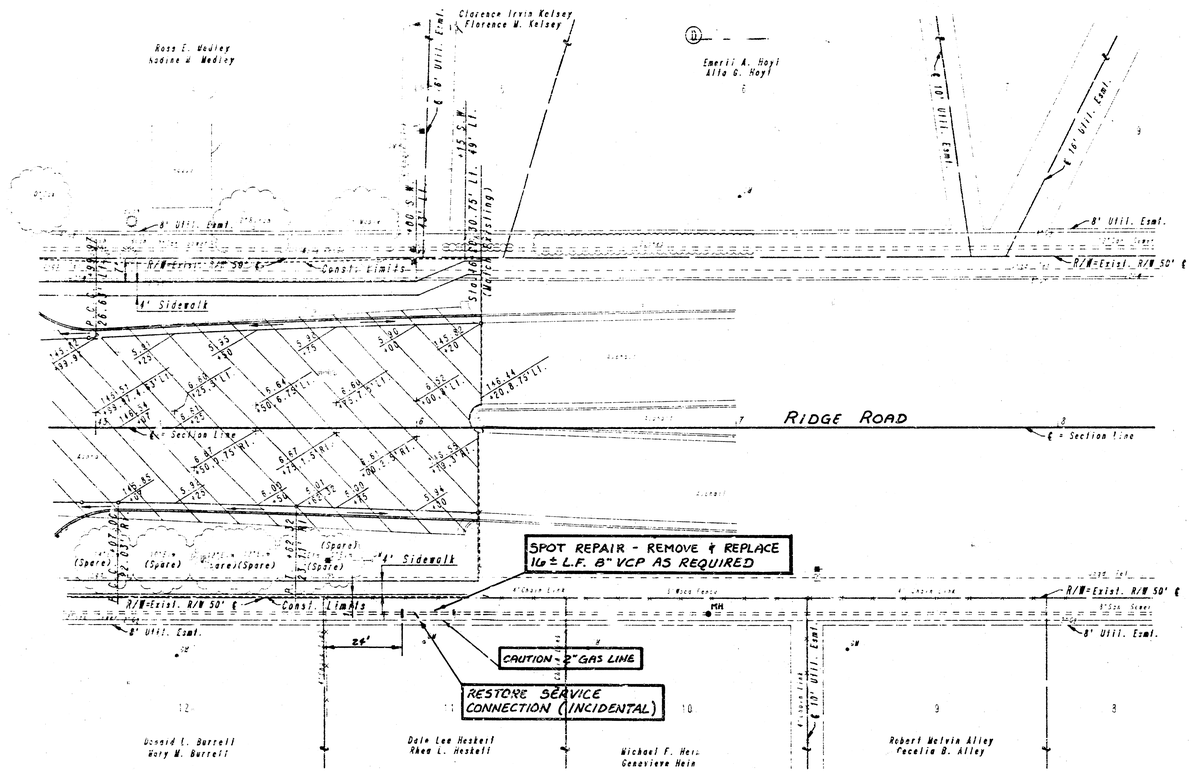


COUNTRY ACRES FOURTH ADDITION

~~STA. 46+20.00 END~~
~~Proj. No. SG-U-1037-01 =~~
~~Ridge Road STA. 46+40.30 on~~
~~Proj. No. 875-SU-1372(1)~~

RT. E.P. CURVE DATA
P.I. 22.00' Rt. ℄ Sta. 45+29.00
Δ=1°54'33"
D=2°51'53"
R=2,000.00'
T=33.32'
L=66.64'
E=0.28'

NW 1/4 Sec. 15, T27S, R1W

BM 67 - Chis. "O" Back W. Median Curb at P.C. of Back Curb. 4.5' Lt. Sta. 46+20. Elev.=147.12

SW Cor. Sec. 10, T27S, R1W
Fd. 1/2" Rebar in Thimble (Sta. 52+60.30)
2. Chis. "X" in Curb 71.40' NE
3. Chis. "X" in Curb 71.65' NW
4. Chis. "X" in Curb 74.00' SW
5. Chis. "X" in Curb 68.92' SE

UTILITIES

| | |
|---|---|
| Power | KG&E |
| Telephone | Southwestern Bell Tel. Co. |
| Cable TV | Air Capitol Cablevision |
| Gas 1 | CPL Gas Service Co. |
| Gas 2 | Arkla Gas Co. |
| San. Sewer | Wichita Sewer Maintenance Div. |
| Water | Wichita Water Dept. |

ALTER, REPAIR, RECONSTRUCT OR CONSTRUCT A SEWER TO SUPPLEMENT A PORTION OF COUNTRY ACRES SANITARY SEWER
PROJ. NO. 468-76-245-81541-000-000-001

M. E. LINDEBAK — CITY ENGINEER
WICHITA, KANSAS

| Designed by | | Checked by | |
|---|---|---|---|
| Drawn by | | Date Dec., 1985 | 3/3 |

FILMED FROM THE BEST AVAILABLE COPY