

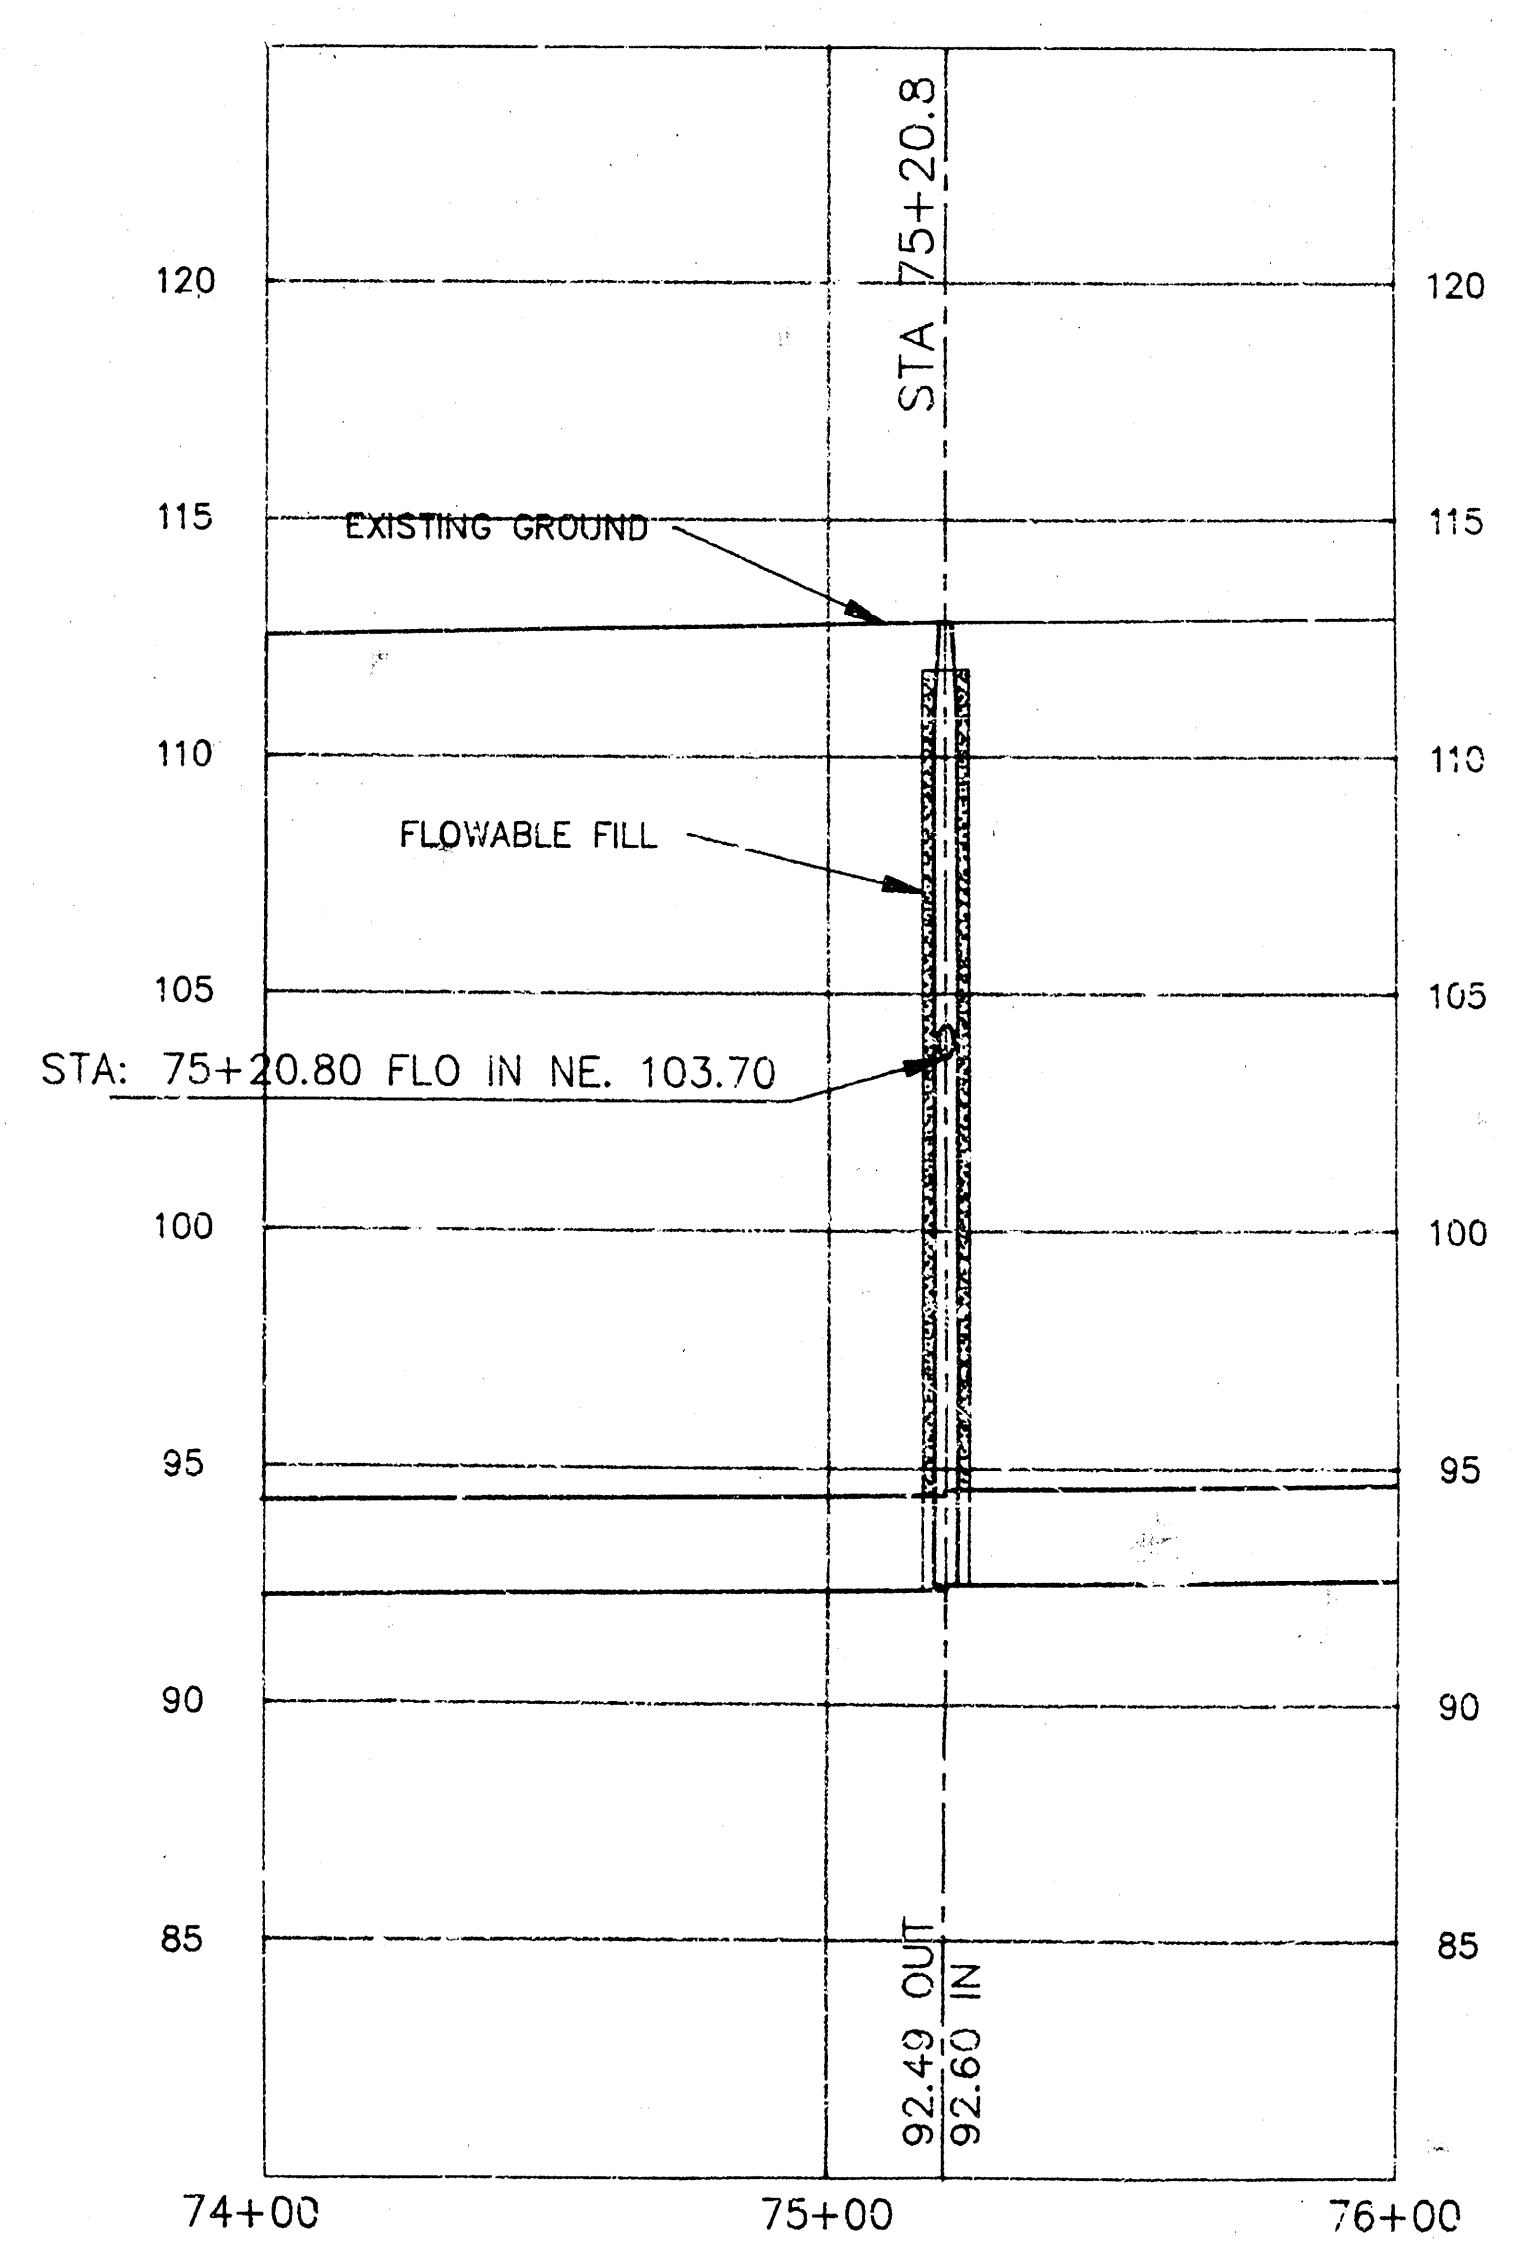
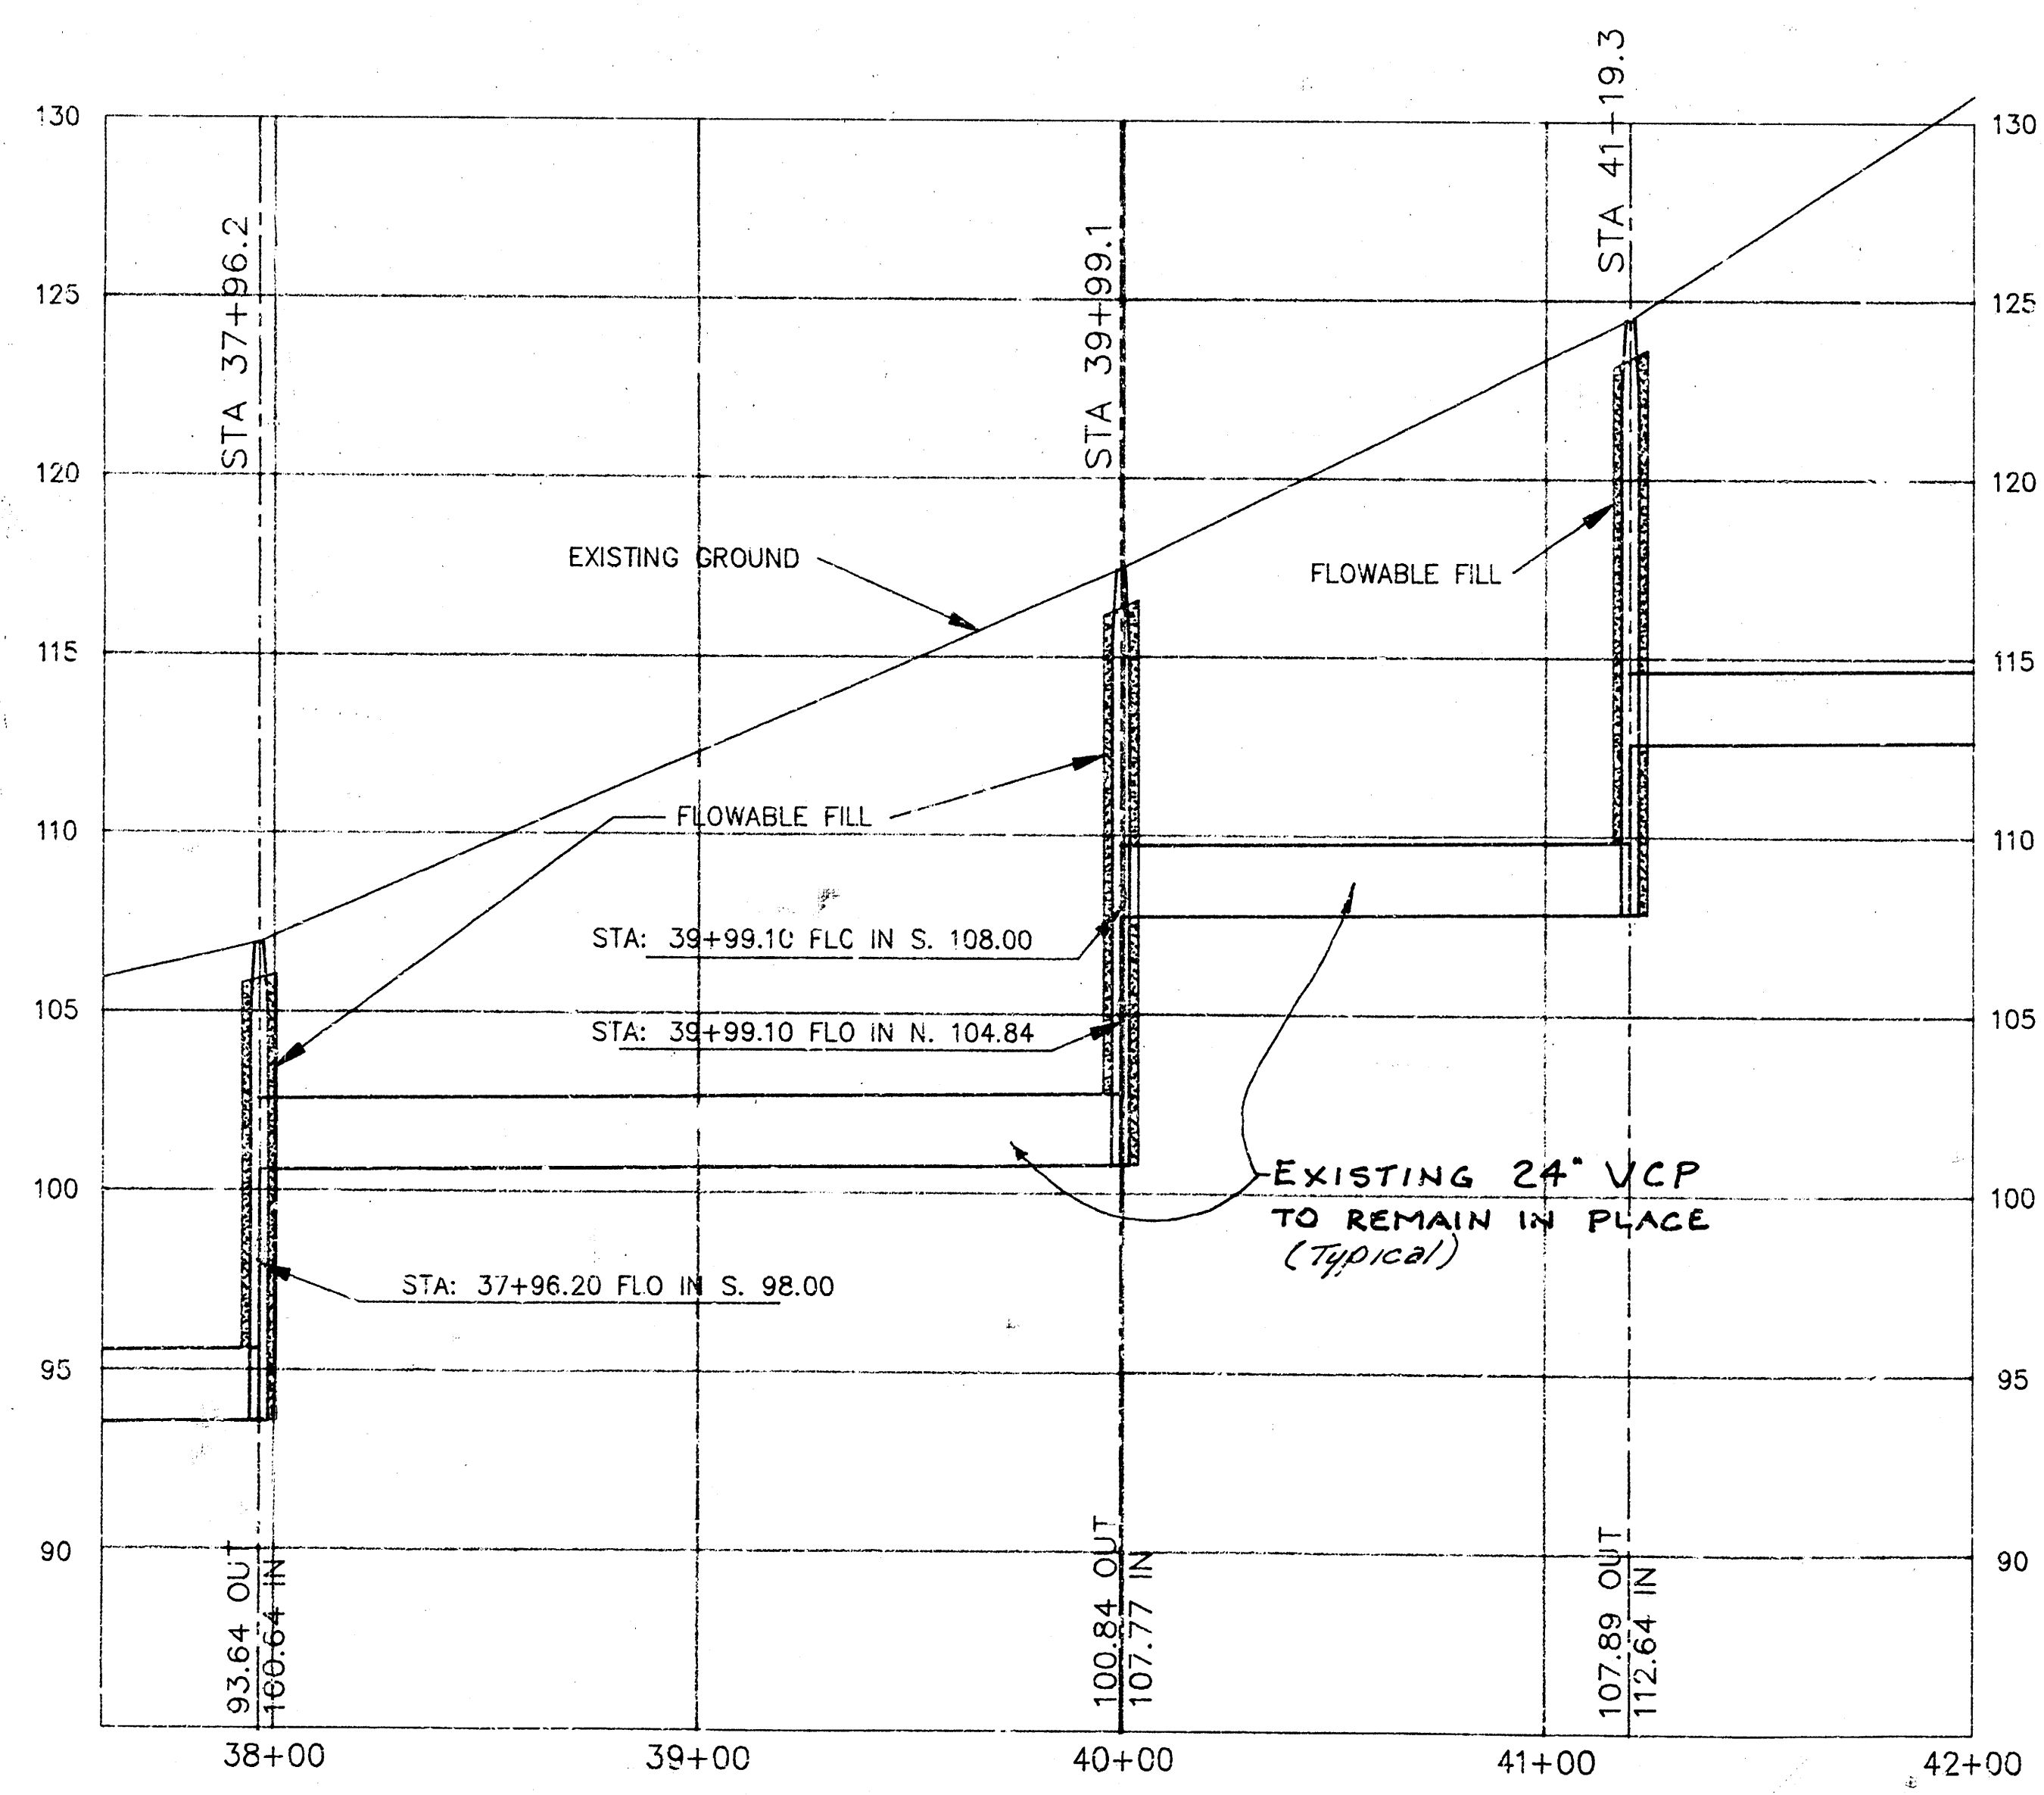


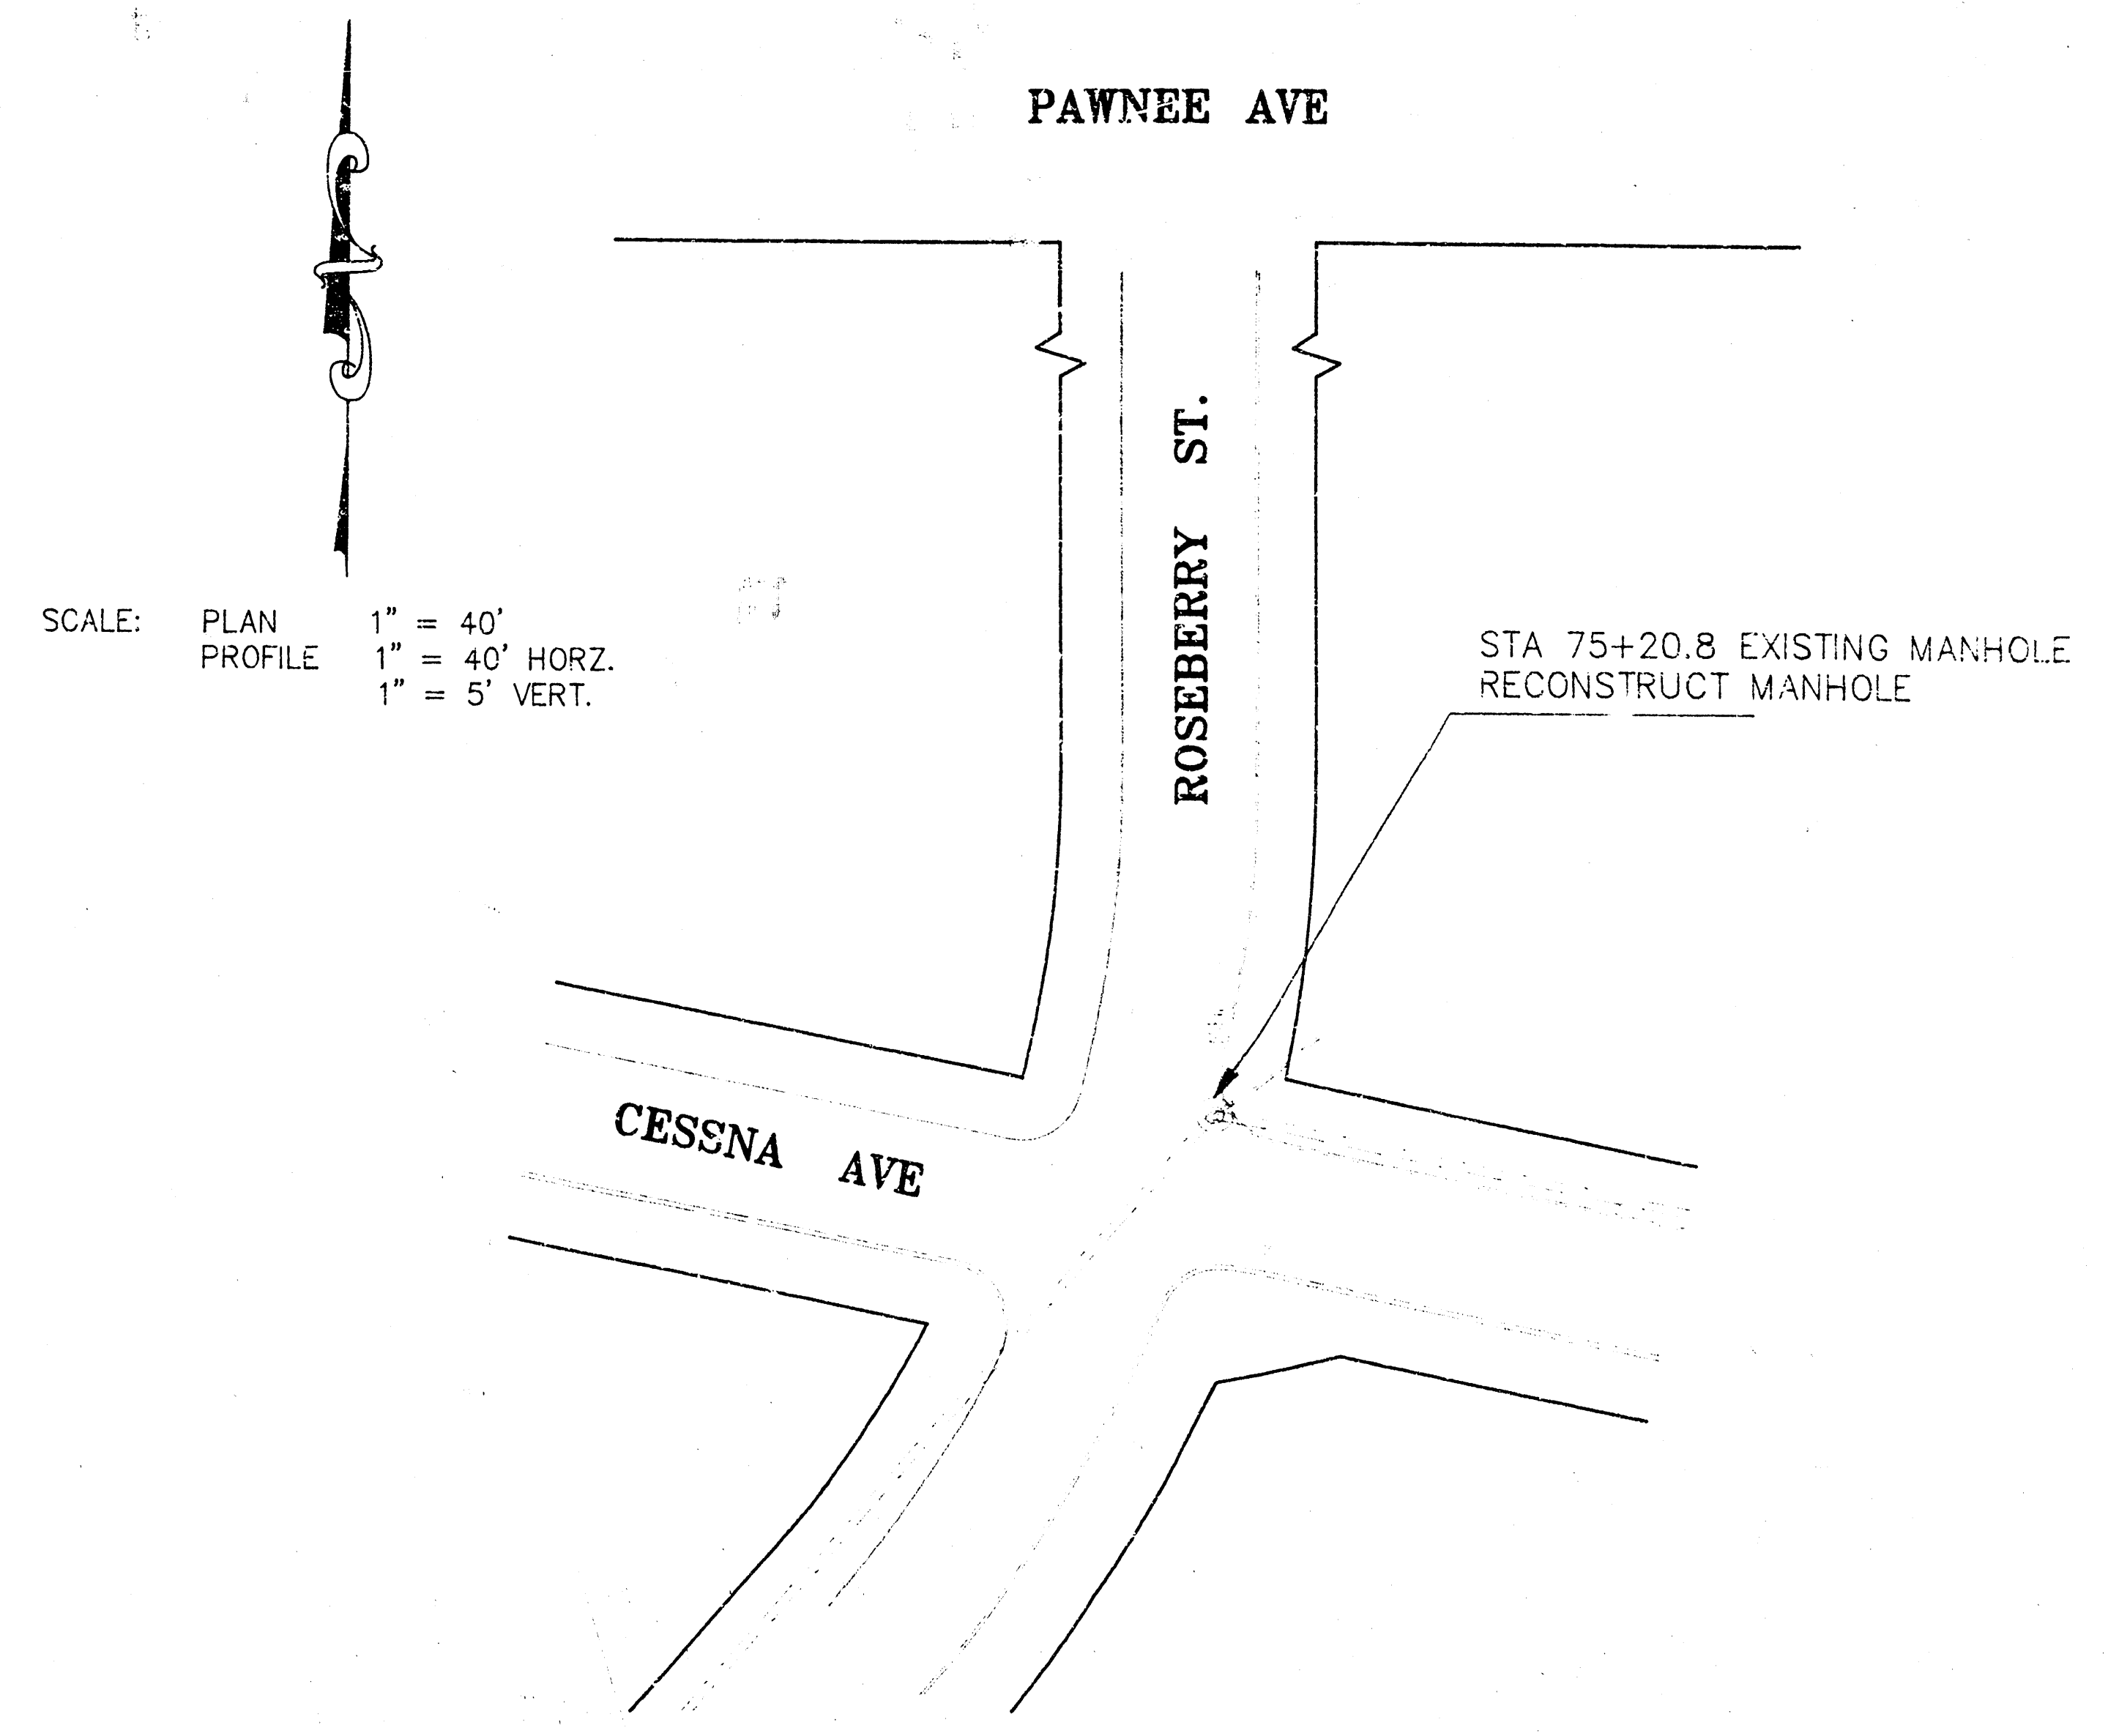

Booked
As per plan
10-17-94

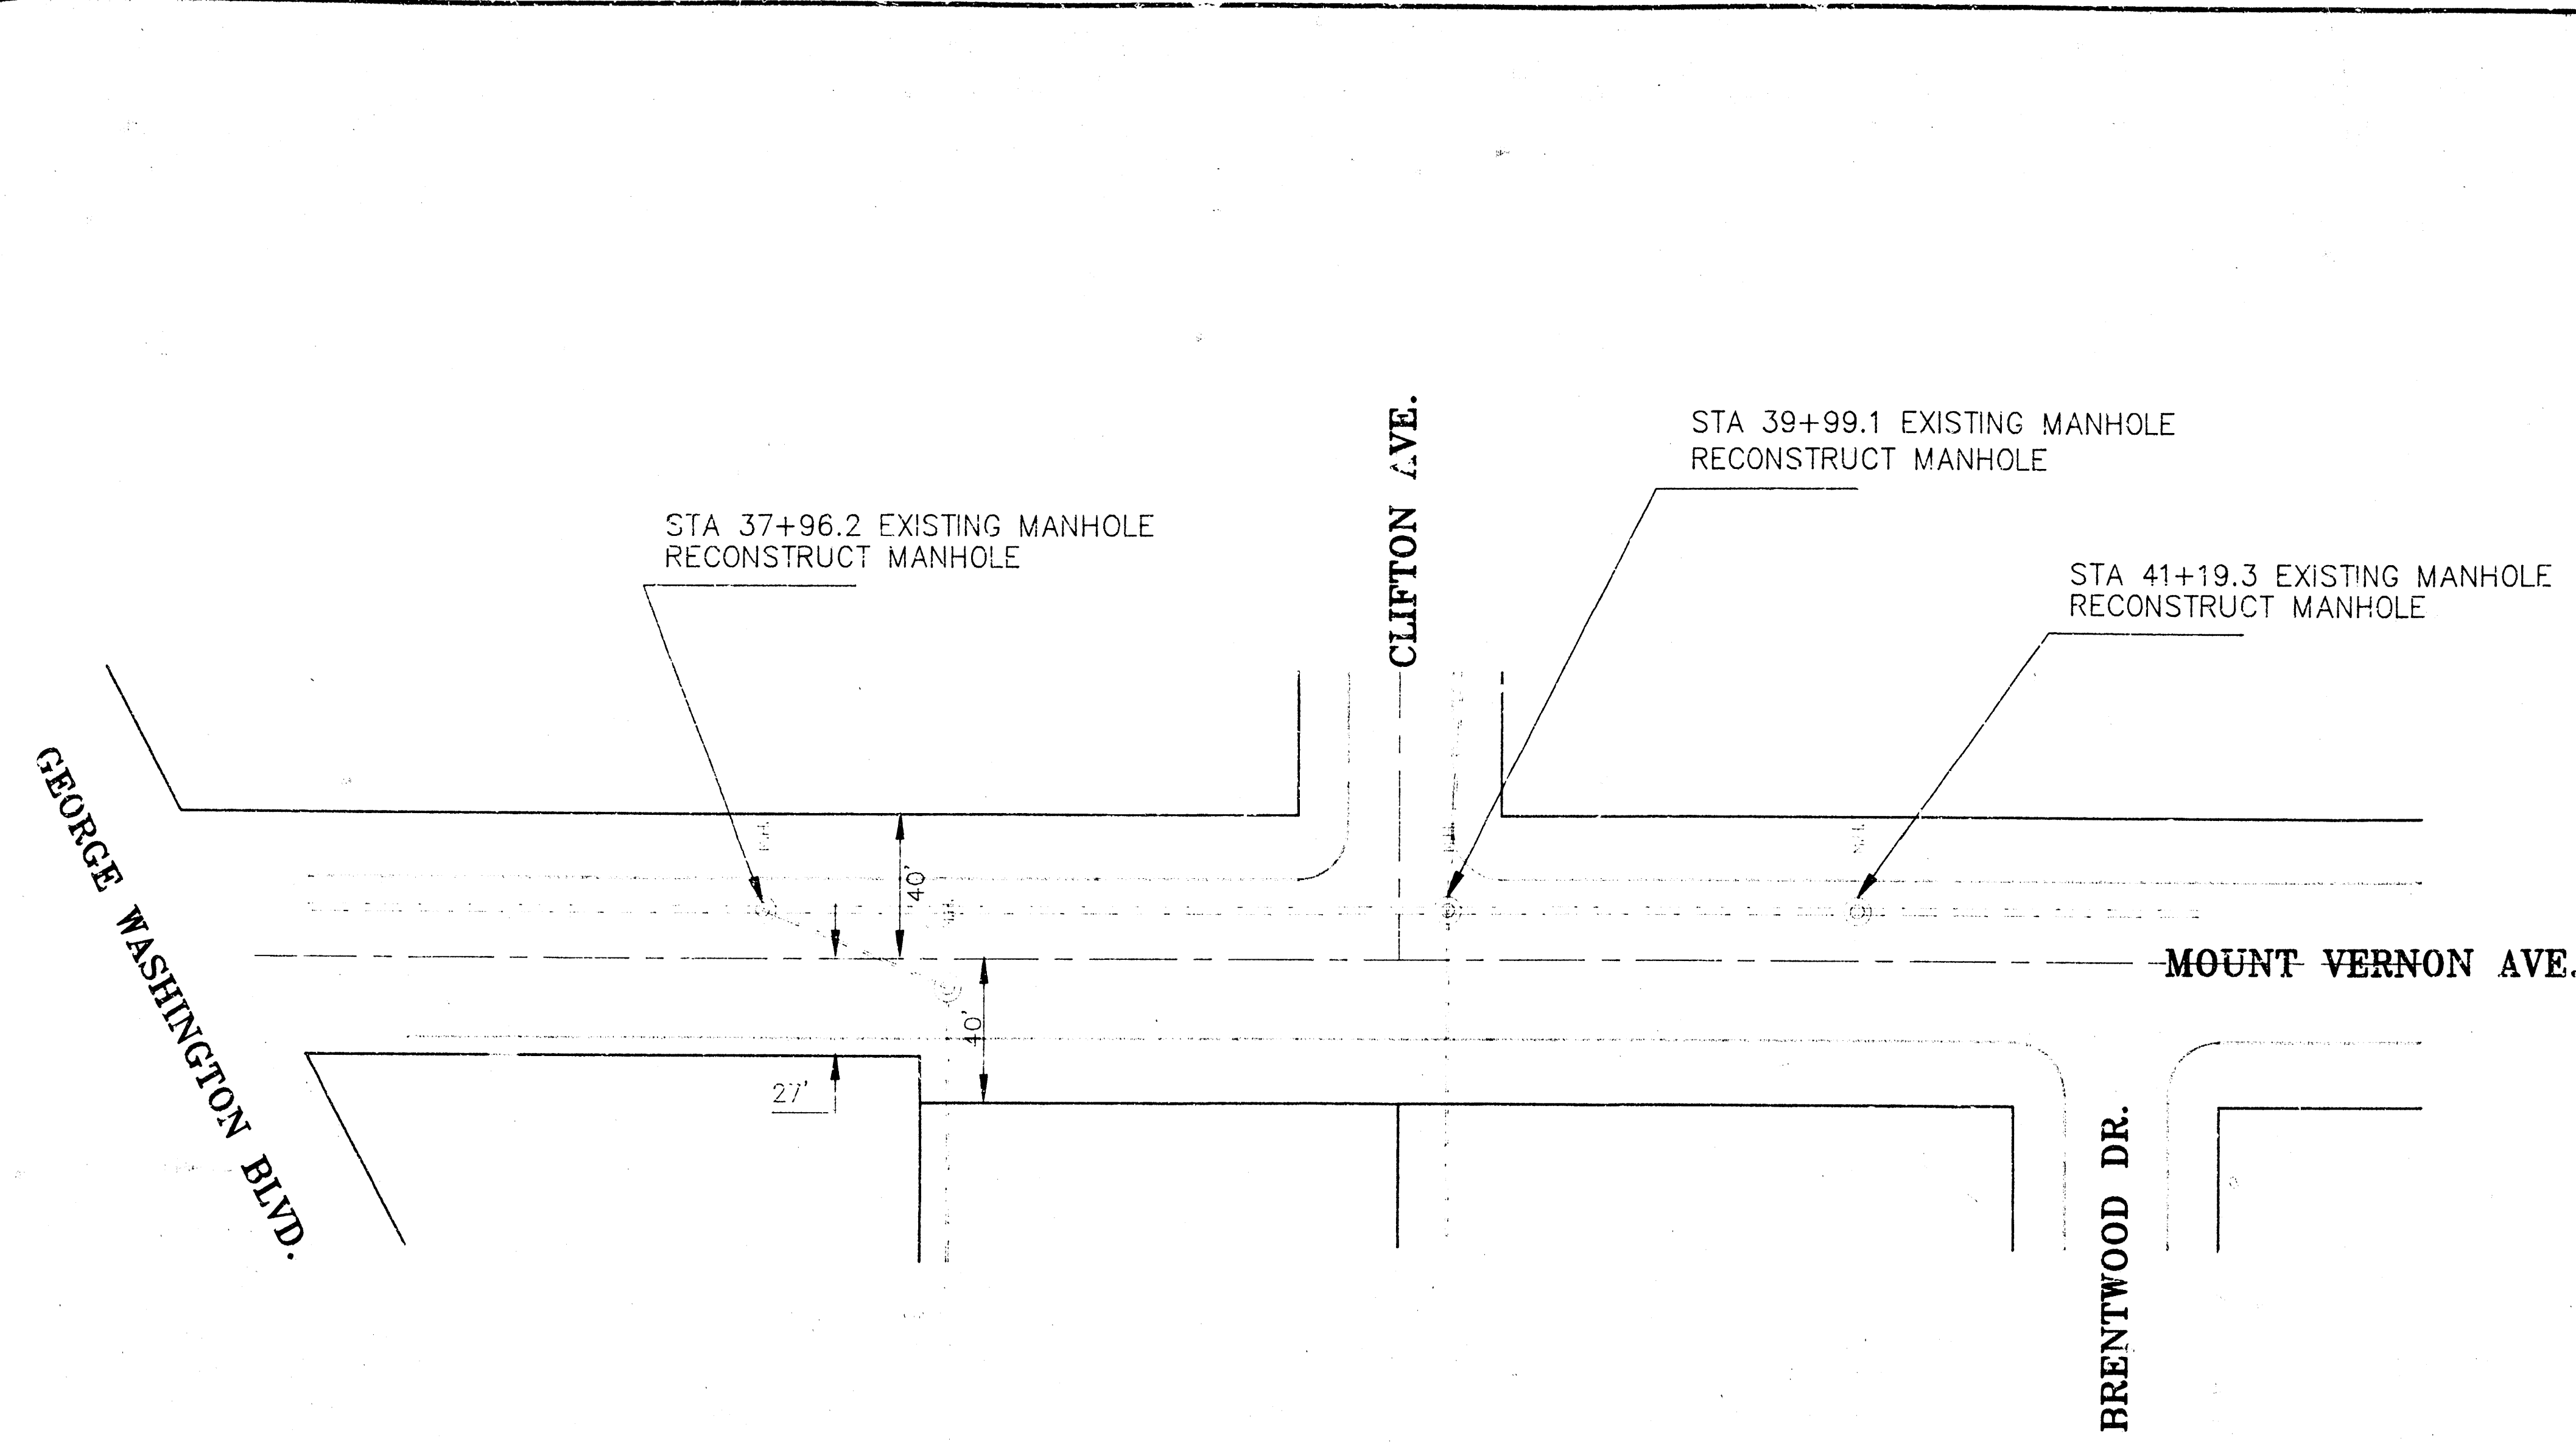