DORA STREET

KESSLER ST.

WEST STREET

200' 200' 200' 200' 200'

1 2 3 4 5

11

10 9 8 7 6

200' 200' 200' 200' 200'

CONST. TYPE "A" MANHOLE W/ 8" STUBOUTS AS SHOWN WITH INSIDE DROP

SCALE 1" = 100'

CONST. TYPE "A" MANHOLE W/ INSIDE DROP

52'±

EXISTING 8" SANITARY

NOTE: ALL OF LOT 11 IS A SANITARY SEWER EASEMENT

MAY STREET

120

110

100

120

110

100

7-20-76

APPROVED AS NOTED
By CITY ENGINEER OF WICHITA
Sanitary Sewers A.E.B.
Storm Sewers
Driveway Approaches

NOTE TO CONTRACTOR
This project will be constructed under the supervision of the CITY ENGINEER and conforming to the SPECIFICATIONS of the CITY OF WICHITA. The CONTRACTOR will reimburse the City of Wichita for all cost of Engineering, Plans, and Inspection.

REVISED

SANITARY SEWER CONNECTION


UTILITY CONTRACTORS
RLF

WEST WAREHOUSE ADDITION

UT60

14 10 1 2

SANITARY SEWER

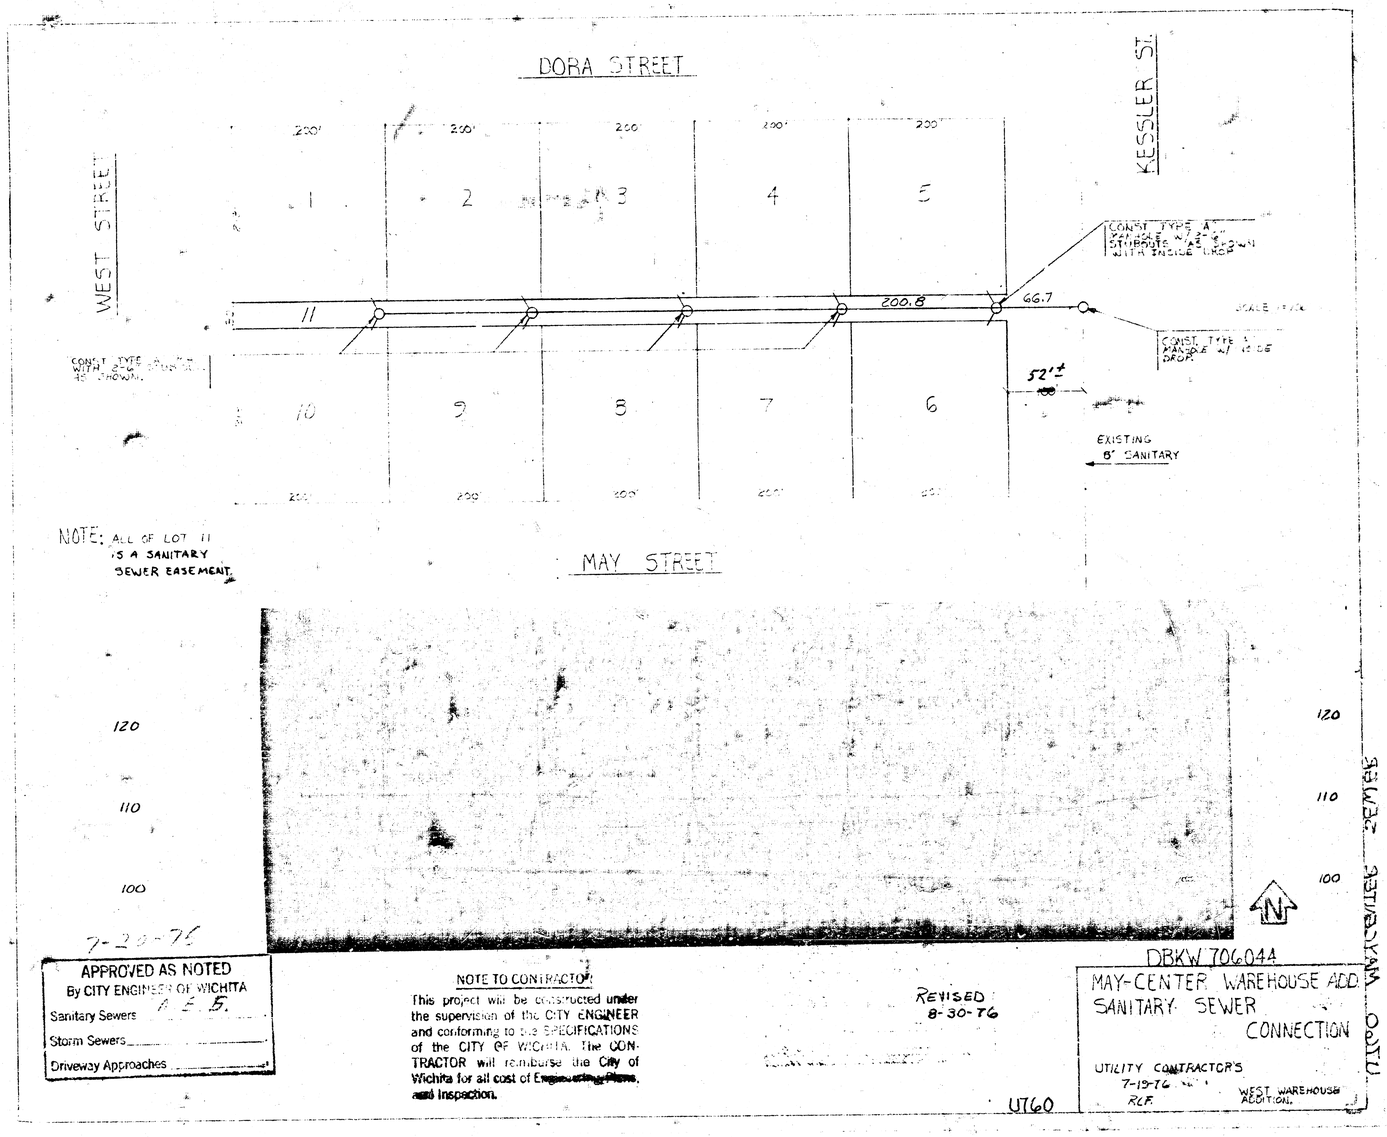

APPROVED AS NOTED
By CITY ENGINEER OF WICHITA
Sanitary Sewers 7-20-76 R.E.S.
Storm Sewers
Driveway Approaches

NOTE TO CONTRACTOR:
This project will be constructed under the supervision of the CITY ENGINEER and conforming to the SPECIFICATIONS of the CITY OF WICHITA. The CONTRACTOR will reimburse the City of Wichita for all cost of Engineering, Plans, and Inspection.

REVISED
8-30-76

U160

DBKW 706044

MAY-CENTER WAREHOUSE ADD.
SANITARY SEWER
CONNECTION

UTILITY CONTRACTOR'S
7-19-76
RCF

WEST WAREHOUSE ADDITION.

WATER & SEWER