

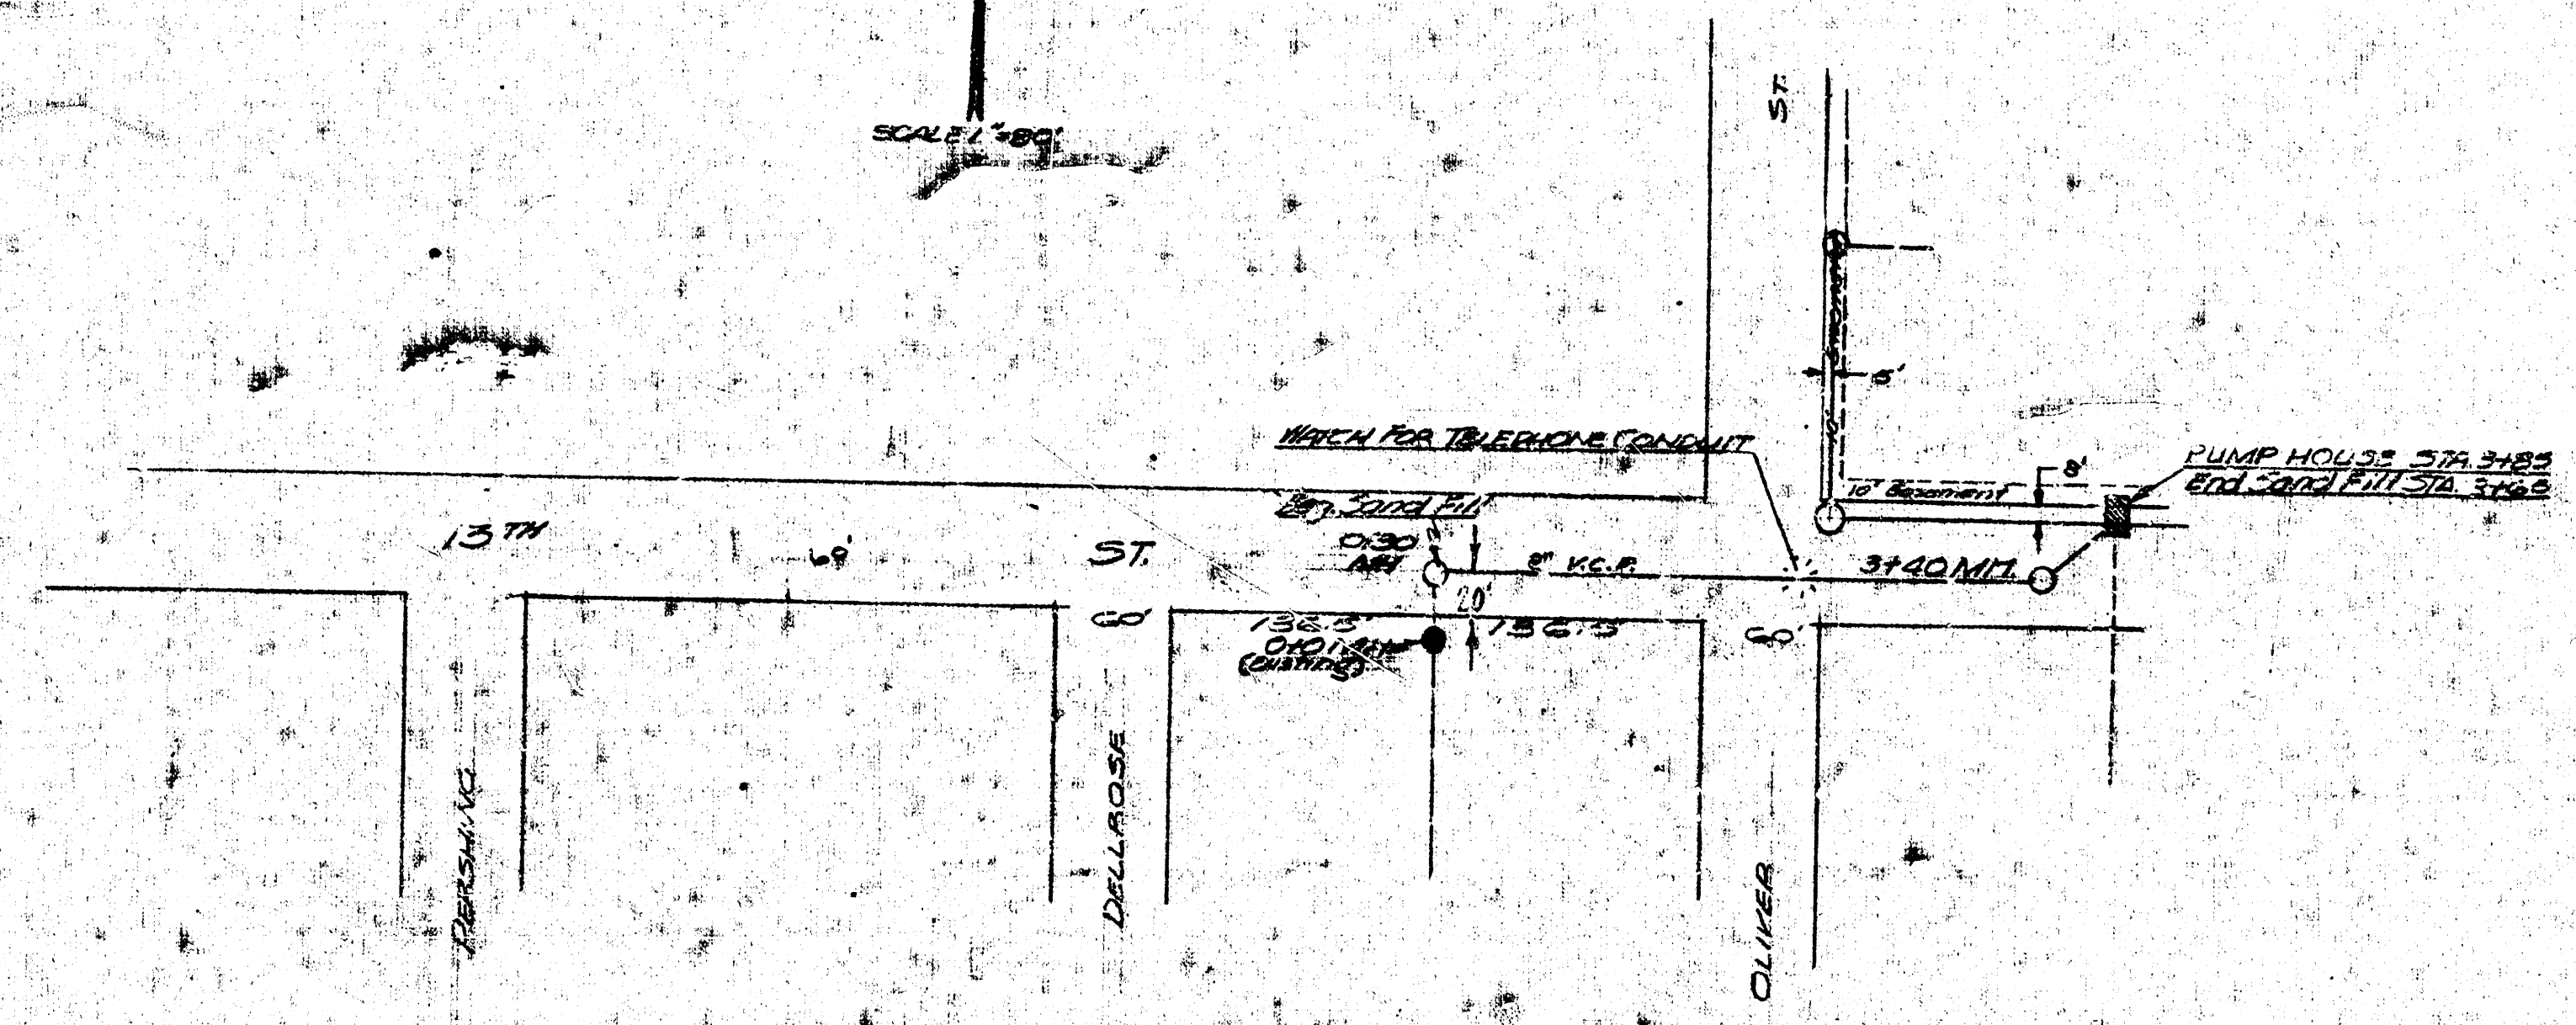


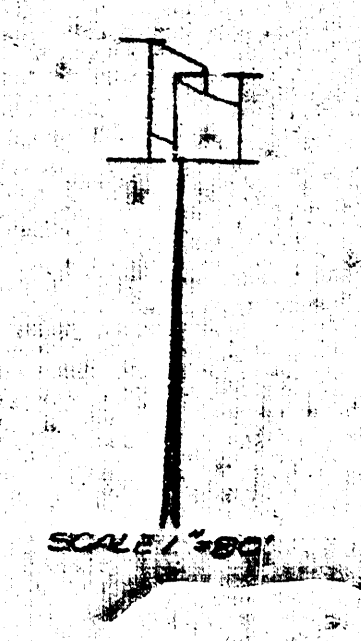

Force Main Line & Pump House @
13th & Oliver. Presently Abandoned.

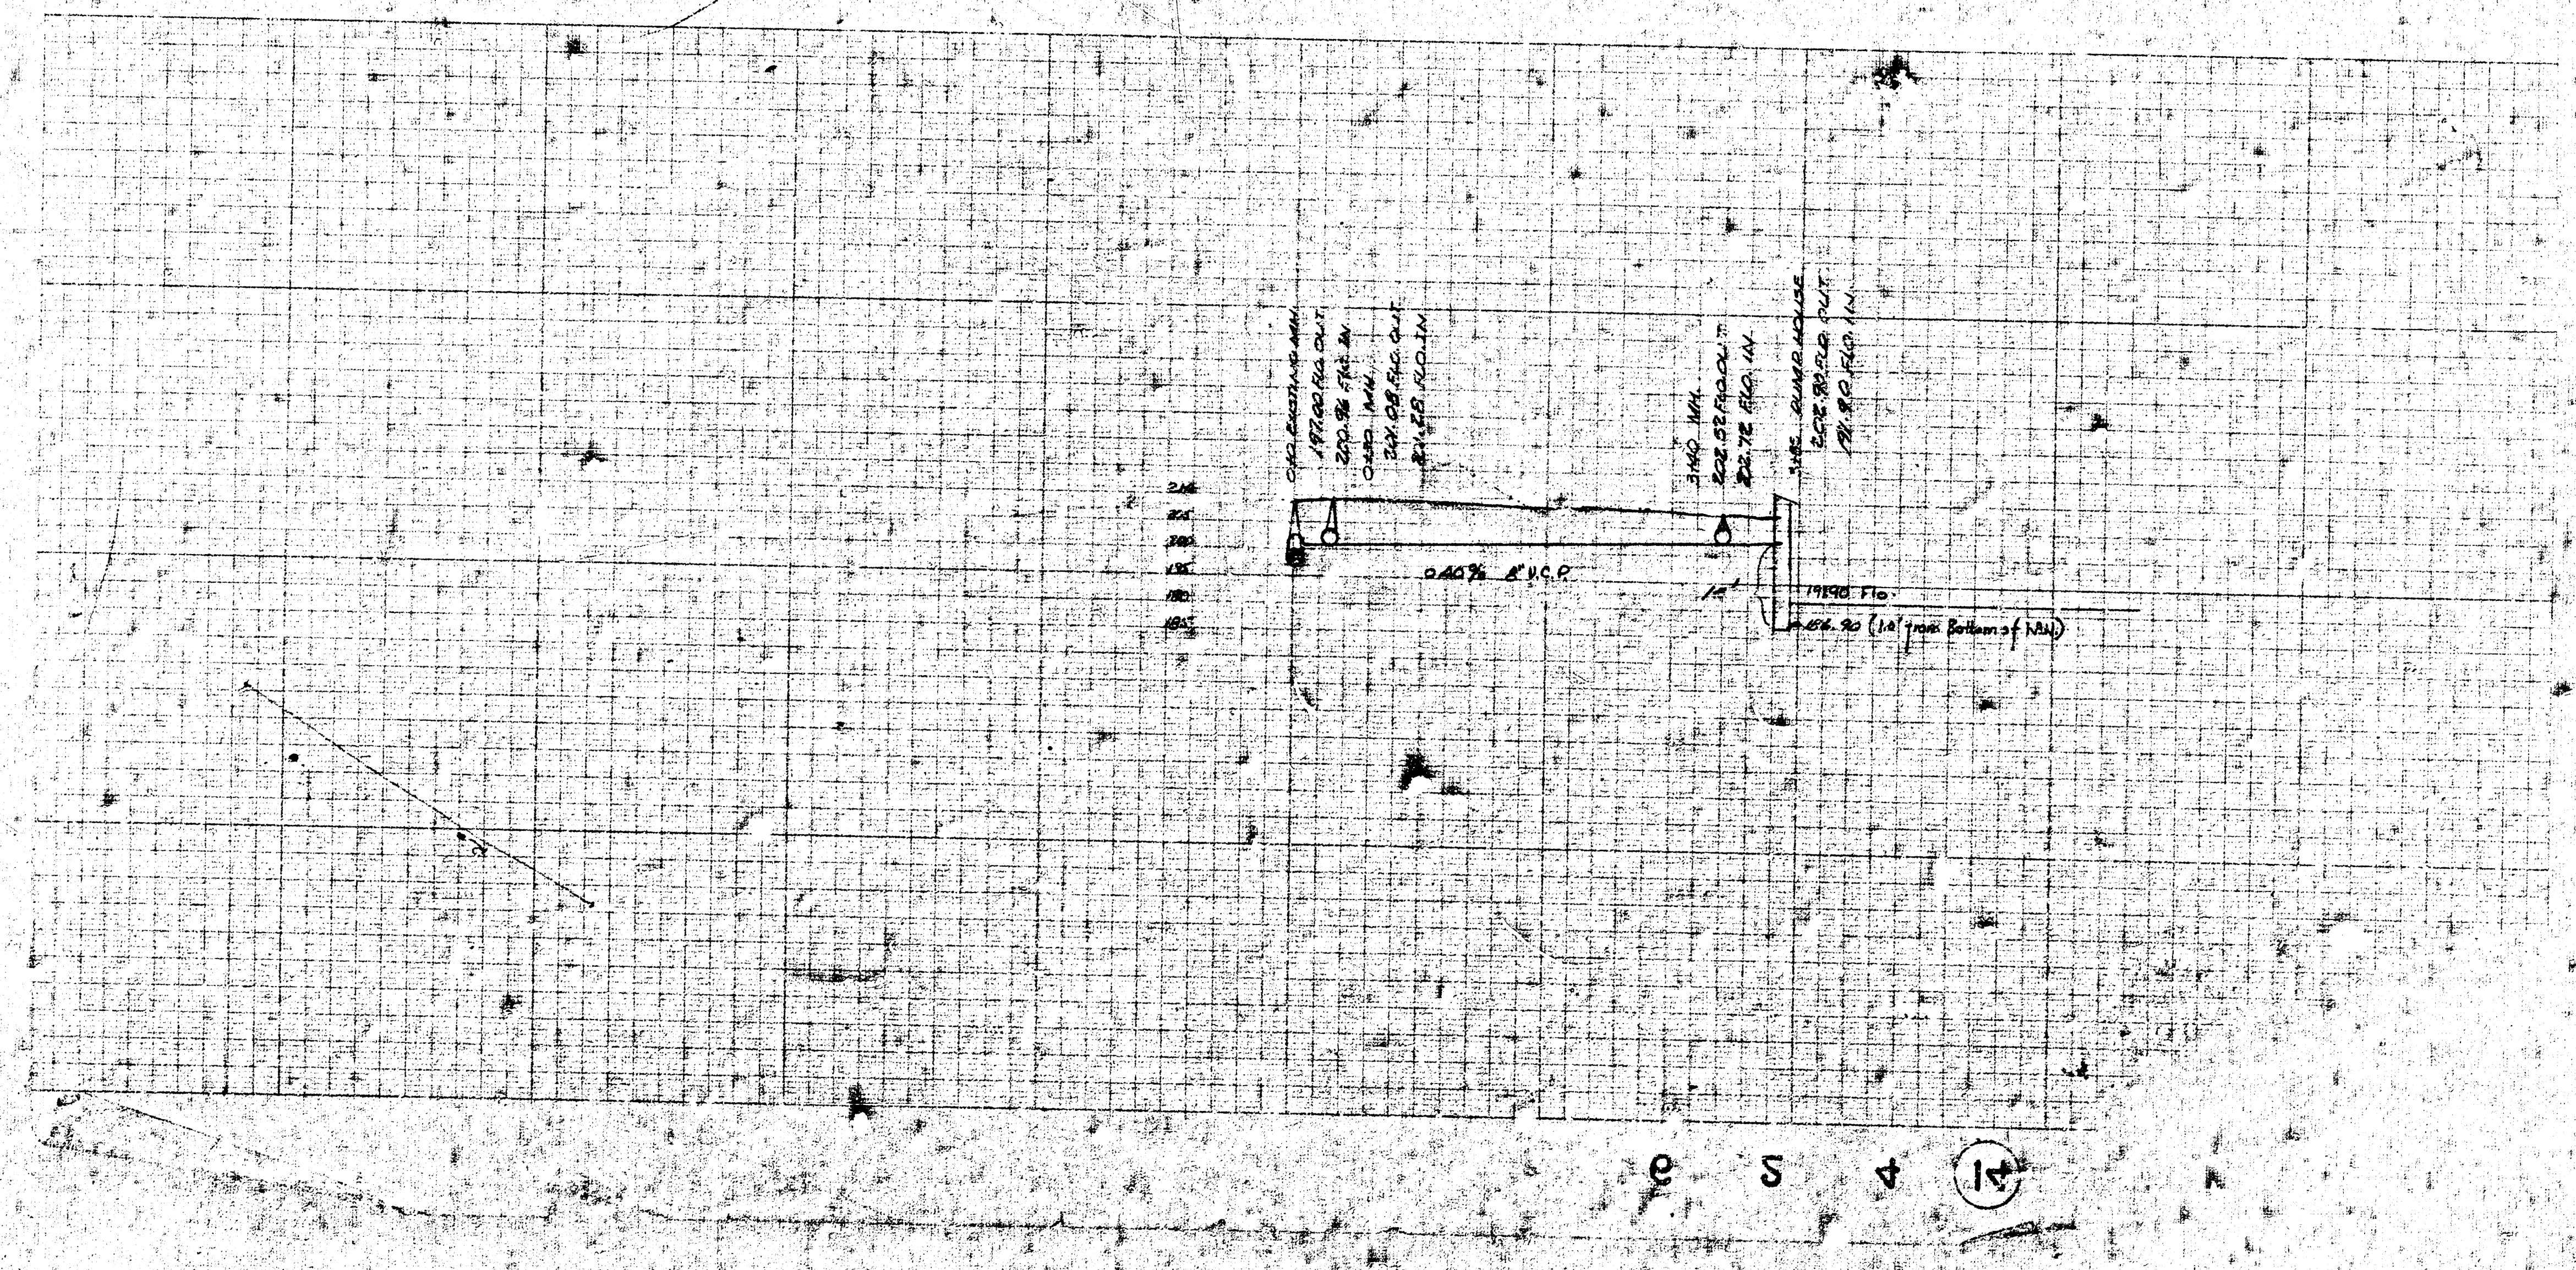

13 5 4 12