


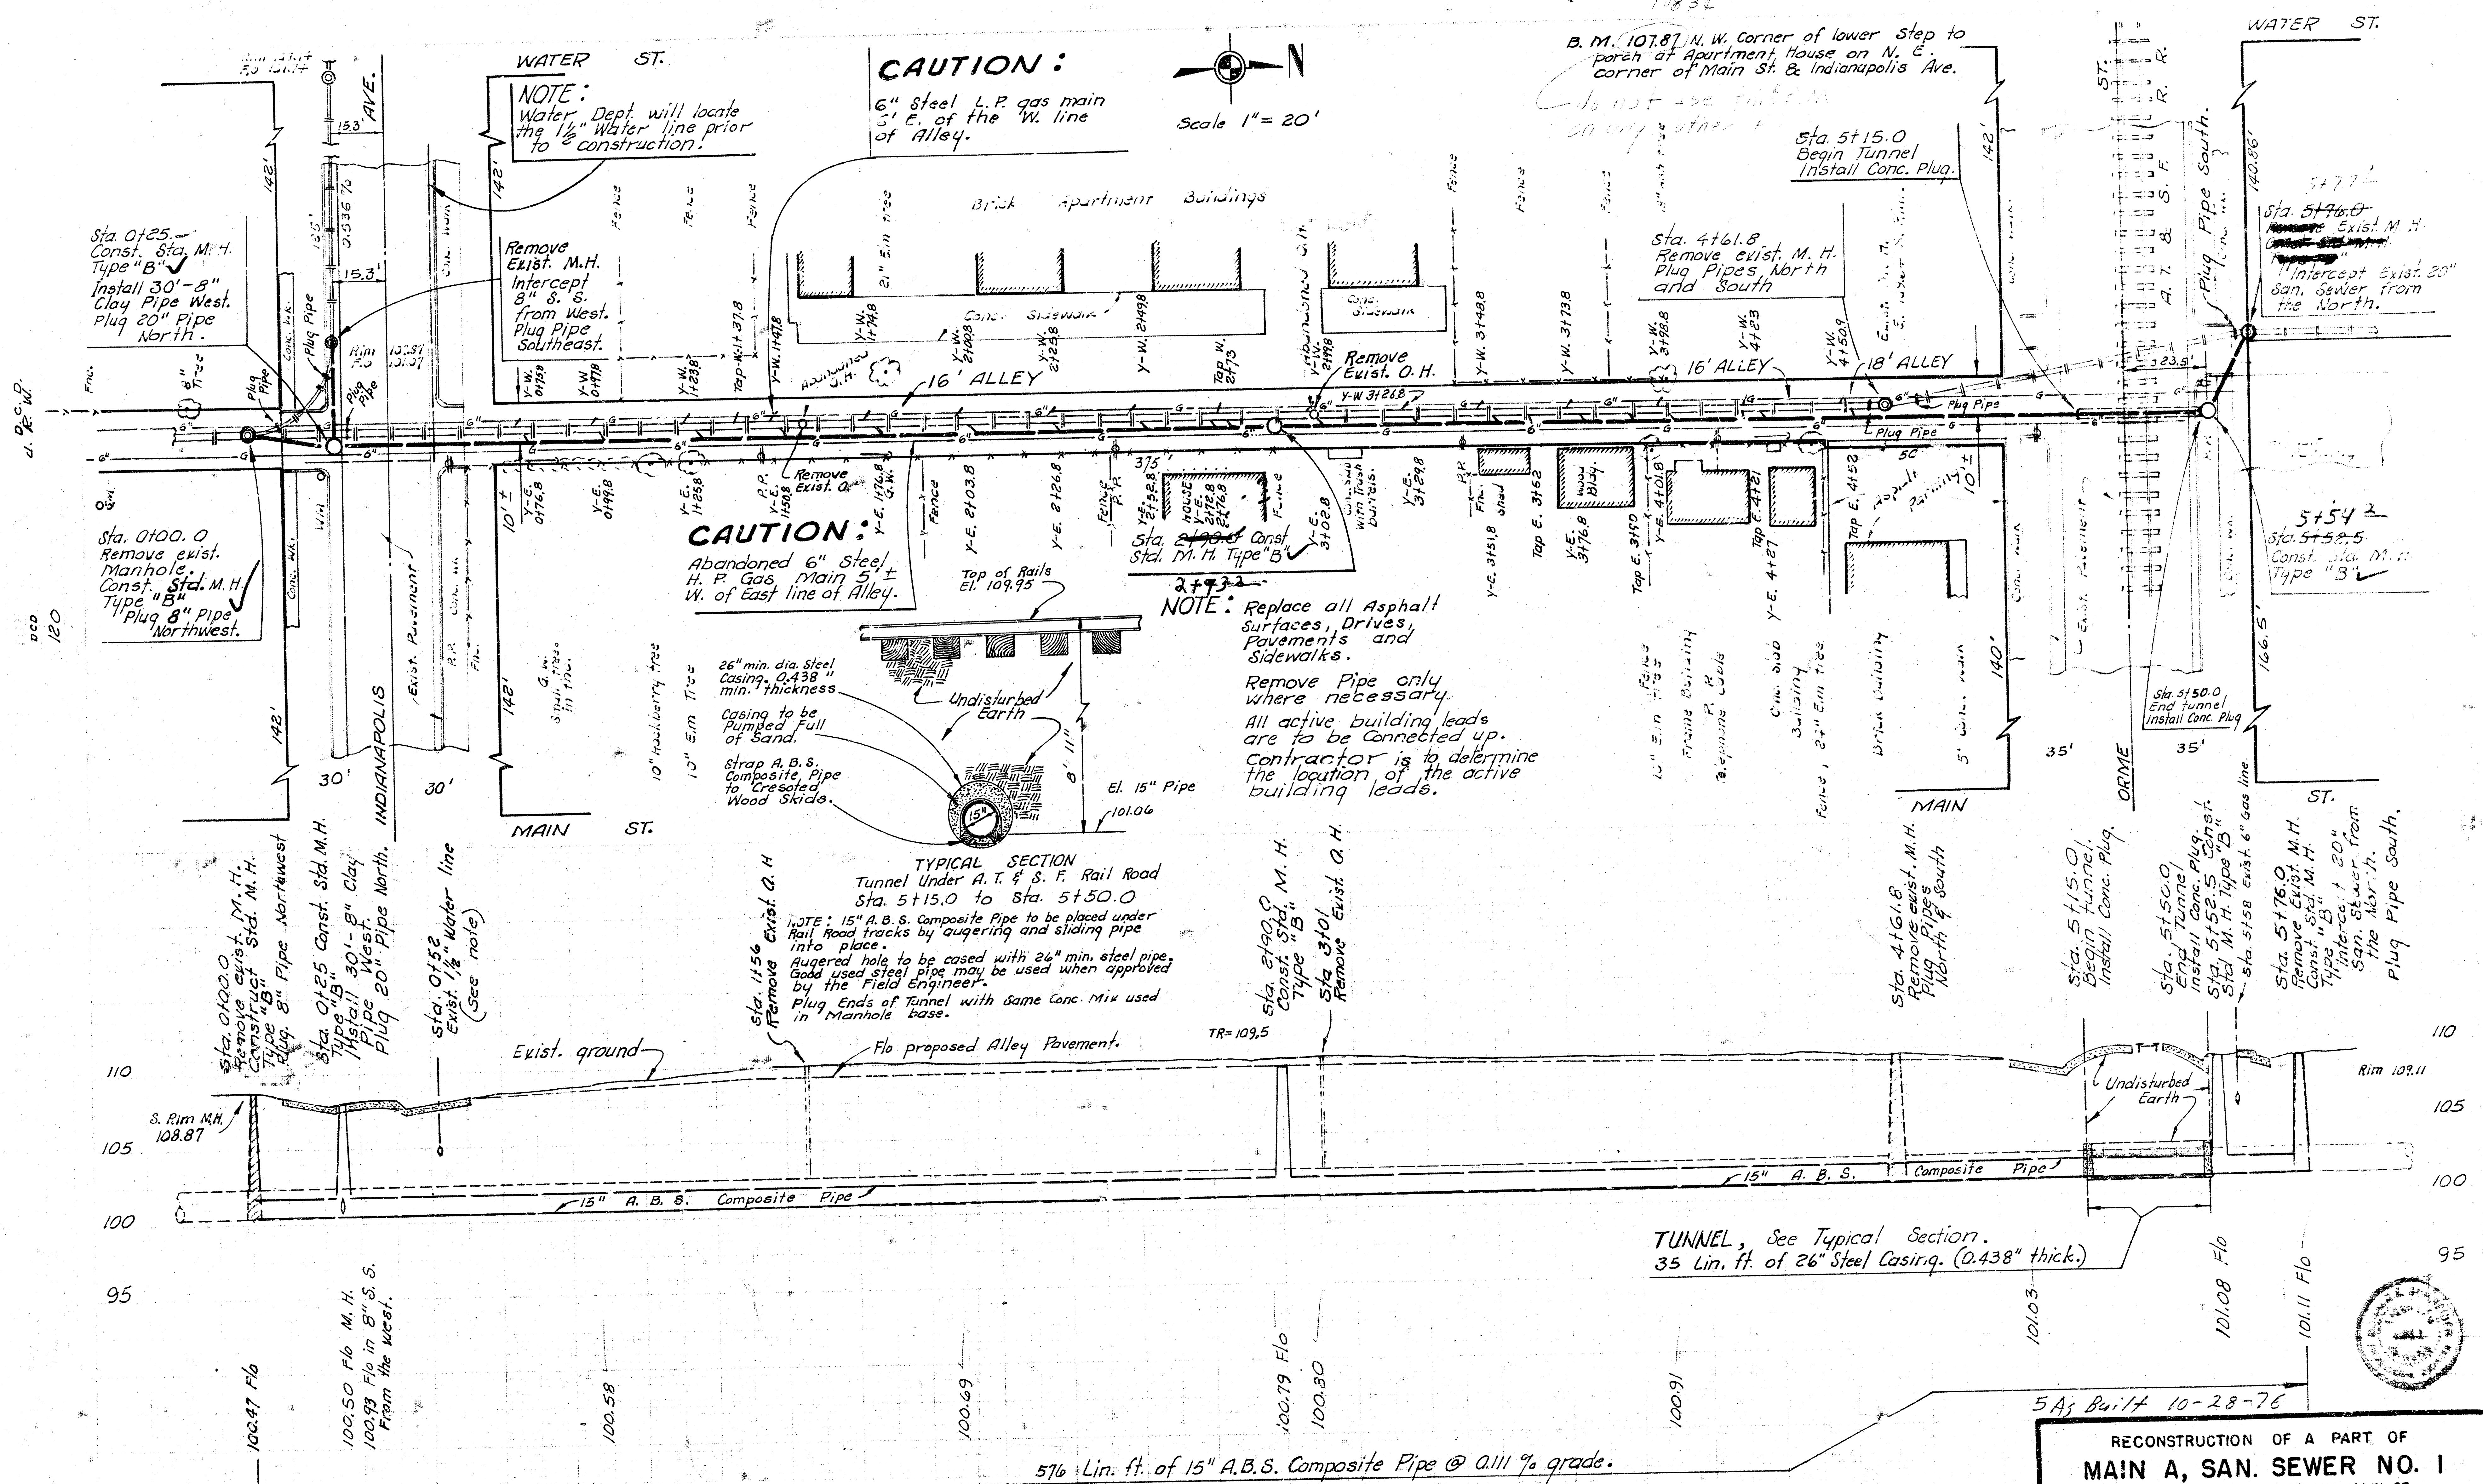

RECONSTRUCTION OF A PART OF
MAIN A, SAN. SEWER NO. 1
 IN ALLEY BETW. WATER ST. AND MAIN ST.
 FROM INDIANAPOLIS AVE. TO ORME ST.
 CITY OF WICHITA, KANSAS
R. W. LINN — **CITY ENGINEER**
 APRIL 1976 PROJECT NO. DBKM 576015