
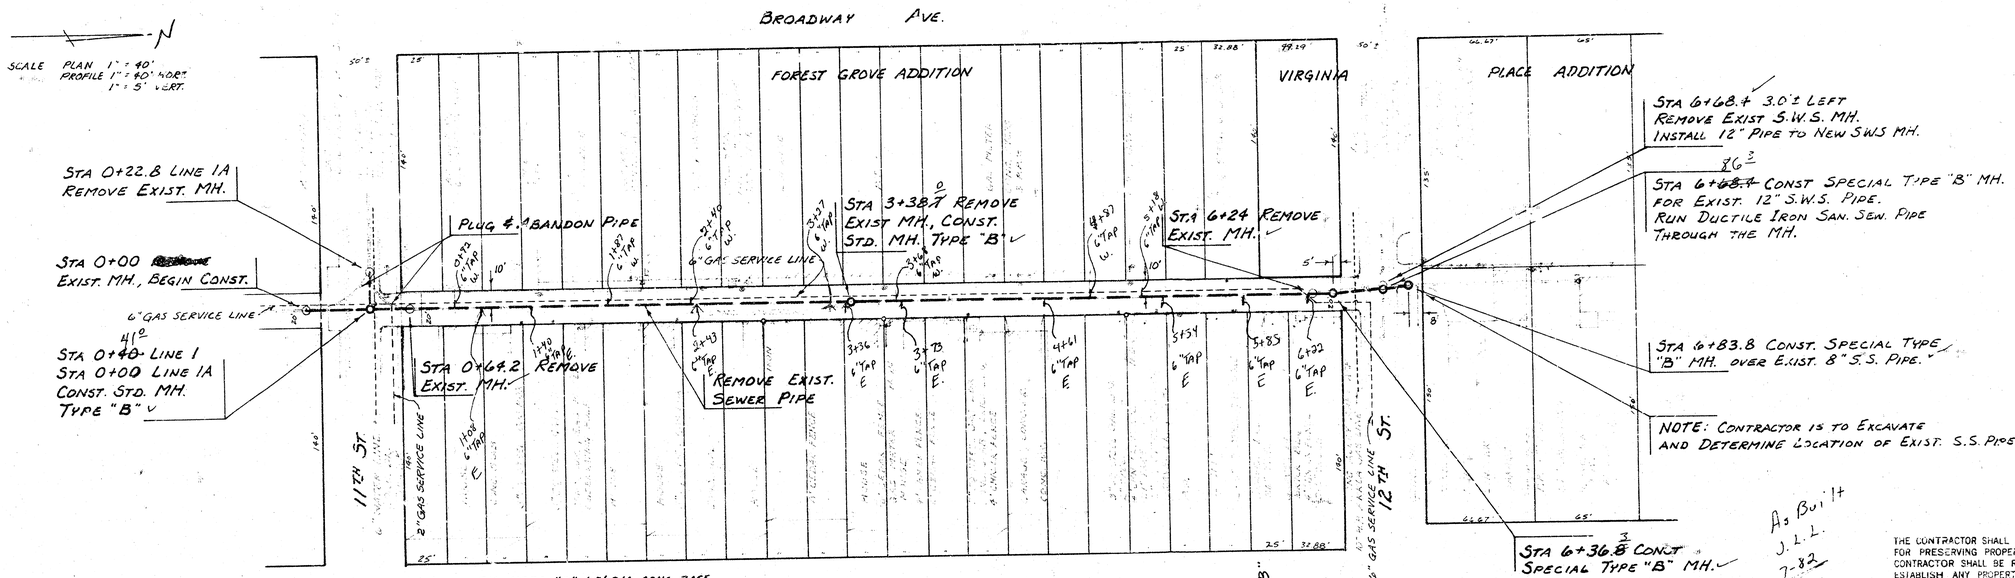


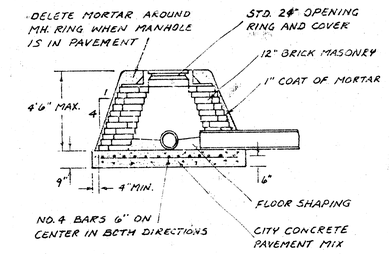

SPECIAL TYPE "B" MANHOLE DETAIL

As Built
J. L. L.
7-82

THE CONTRACTOR SHALL BE RESPONSIBLE FOR PRESERVING PROPERTY IRONS. THE CONTRACTOR SHALL BE REQUIRED TO RE-ESTABLISH ANY PROPERTY IRONS WHICH ARE DAMAGED OR DESTROYED BY HIS CONSTRUCTION OPERATIONS. SUCH IRONS SHALL BE RE-ESTABLISHED BY A LICENSED LAND SURVEYOR OR A LICENSED PROFESSIONAL ENGINEER IN ACCORDANCE WITH STATE LAWS.

RECONSTRUCTION OF A PORTION OF EAST SUBMAIN B, S. S. #1 IN THE ALLEY BETWEEN BROADWAY AND TOPEKA FROM 11th ST. TO 12th ST.

CITY OF WICHITA, KANSAS
R. W. BRUGGEMAN DIRECTOR OF ENGINEERING / CITY ENGINEER
PROJ. NO. 468-76-245-81181-000-000-001

B. RAMBAR 1/82
R. COMIS 1/82

BR-83