B.M.: 1114.97 'D' cut on walk @ S.L. ENGLISH and E.L. MAIN STREET.
B.M.: 1108.5 'D' cut on back walk N.L. ENGLISH & 8' W. W.L. Alley bet BROADWAY & MARKET
B.M.: 1110.9 'D' cut top curb Alley ret S.L. WILLIAM & W. curb Alley bet BROADWAY & MARKET.

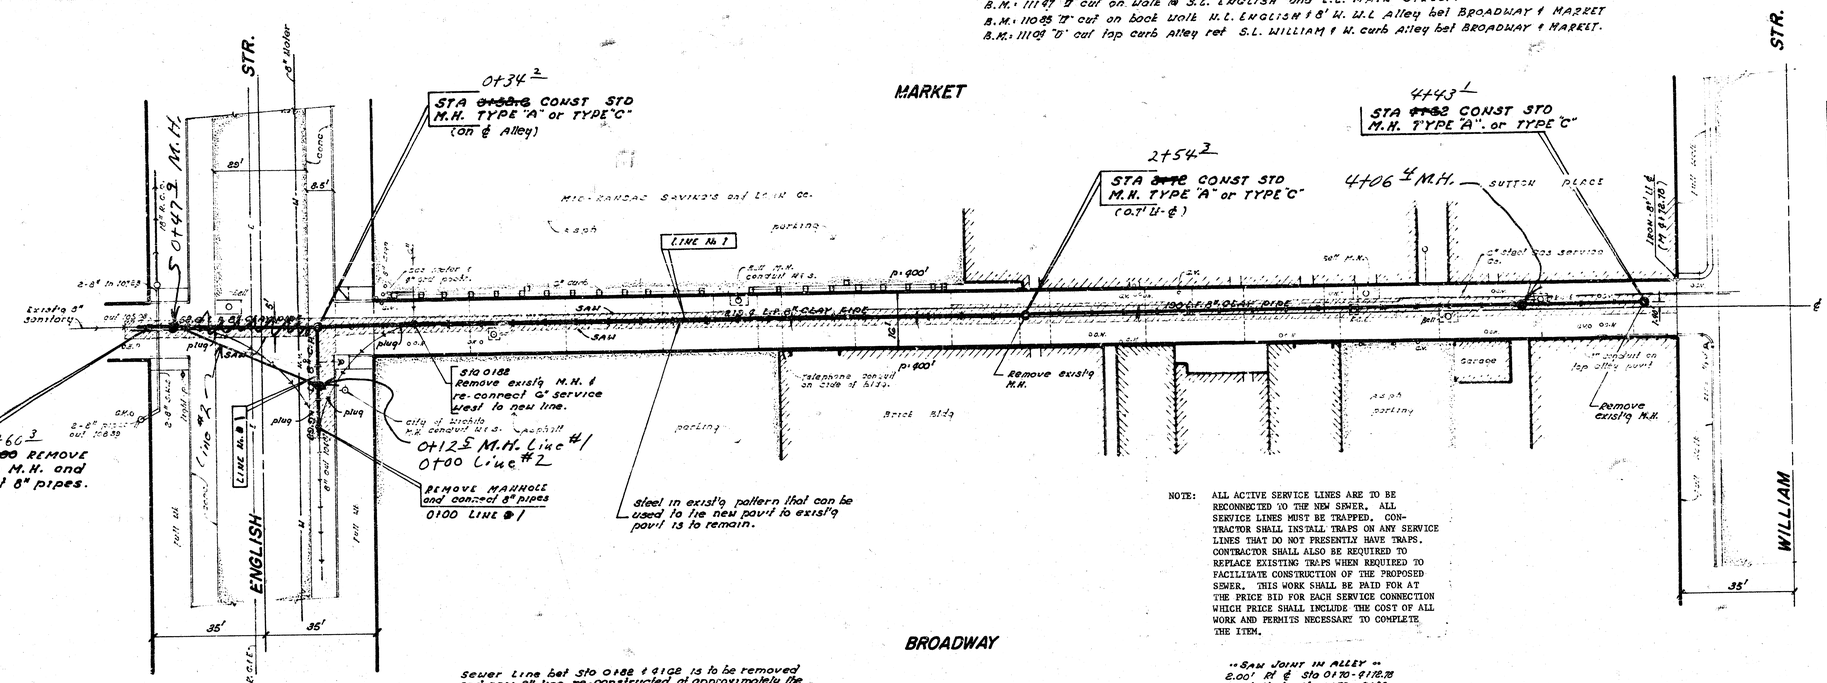

NOTE: ALL ACTIVE SERVICE LINES ARE TO BE RECONNECTED TO THE NEW SEWER. ALL SERVICE LINES MUST BE TRAPPED. CONTRACTOR SHALL INSTALL TRAPS ON ANY SERVICE LINES THAT DO NOT PRESENTLY HAVE TRAPS. CONTRACTOR SHALL ALSO BE REQUIRED TO REPLACE EXISTING TRAPS WHEN REQUIRED TO FACILITATE CONSTRUCTION OF THE PROPOSED SEWER. THIS WORK SHALL BE PAID FOR AT THE PRICE BID FOR EACH SERVICE CONNECTION WHICH PRICE SHALL INCLUDE THE COST OF ALL WORK AND PERMITS NECESSARY TO COMPLETE THE ITEM.

"SAW JOINT IN ALLEY"
2.00' Rt ℄ Sta 0170 - 4170.78
3.00' Lt ℄ Sta 0170 - 2150
4.00' Lt ℄ Sta 2150 - 4170.78

Sewer Line bet Sta 0182 & 4162 is to be removed and new 8" line re-constructed at approximately the same elevation & line. All active service laterals are to be re-connected.

PLAN SCALE 1" = 20'
PROFILE 1" = 80' HORZ
" 1" = 2' VERT.

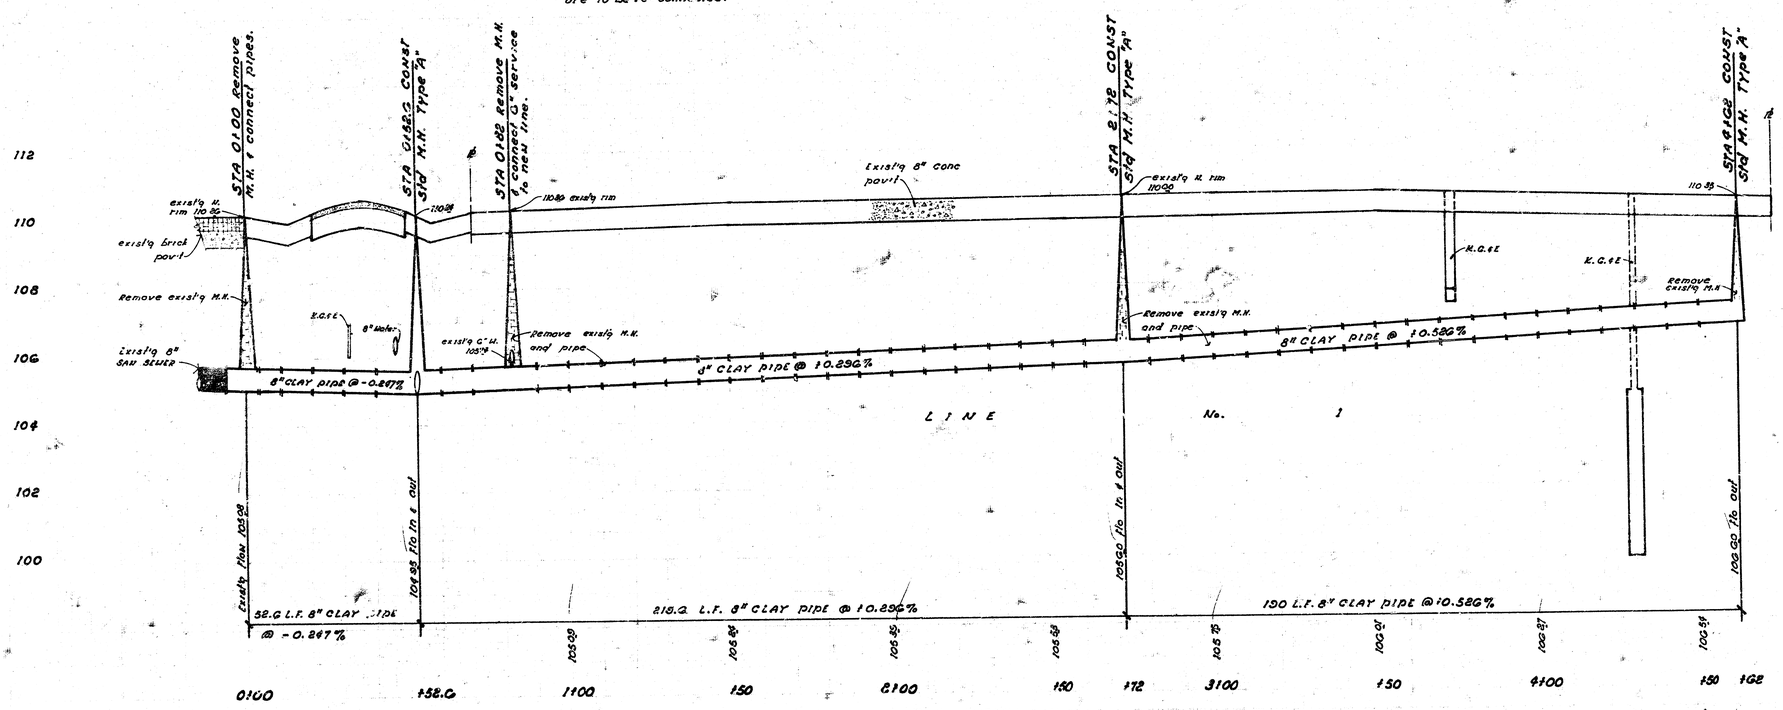

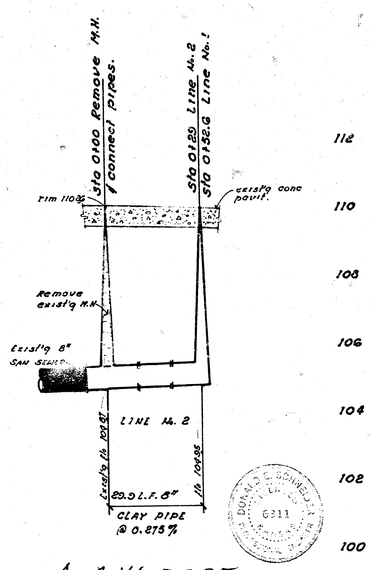

As Built 5-9-75

Reconstruction of a portion of a Lateral north from English between Market & Broadway on West Submain B, Sanitary Sewer No. 1.
CITY of WICHITA, KANSAS
R.W. LINN City Engineer
Date Feb '75 Proj No. DBKL574086

CAUTION
UNDERGROUND UTILITIES
Please check with K.G.&E. or Southwestern Bell Telephone Co. for Location