



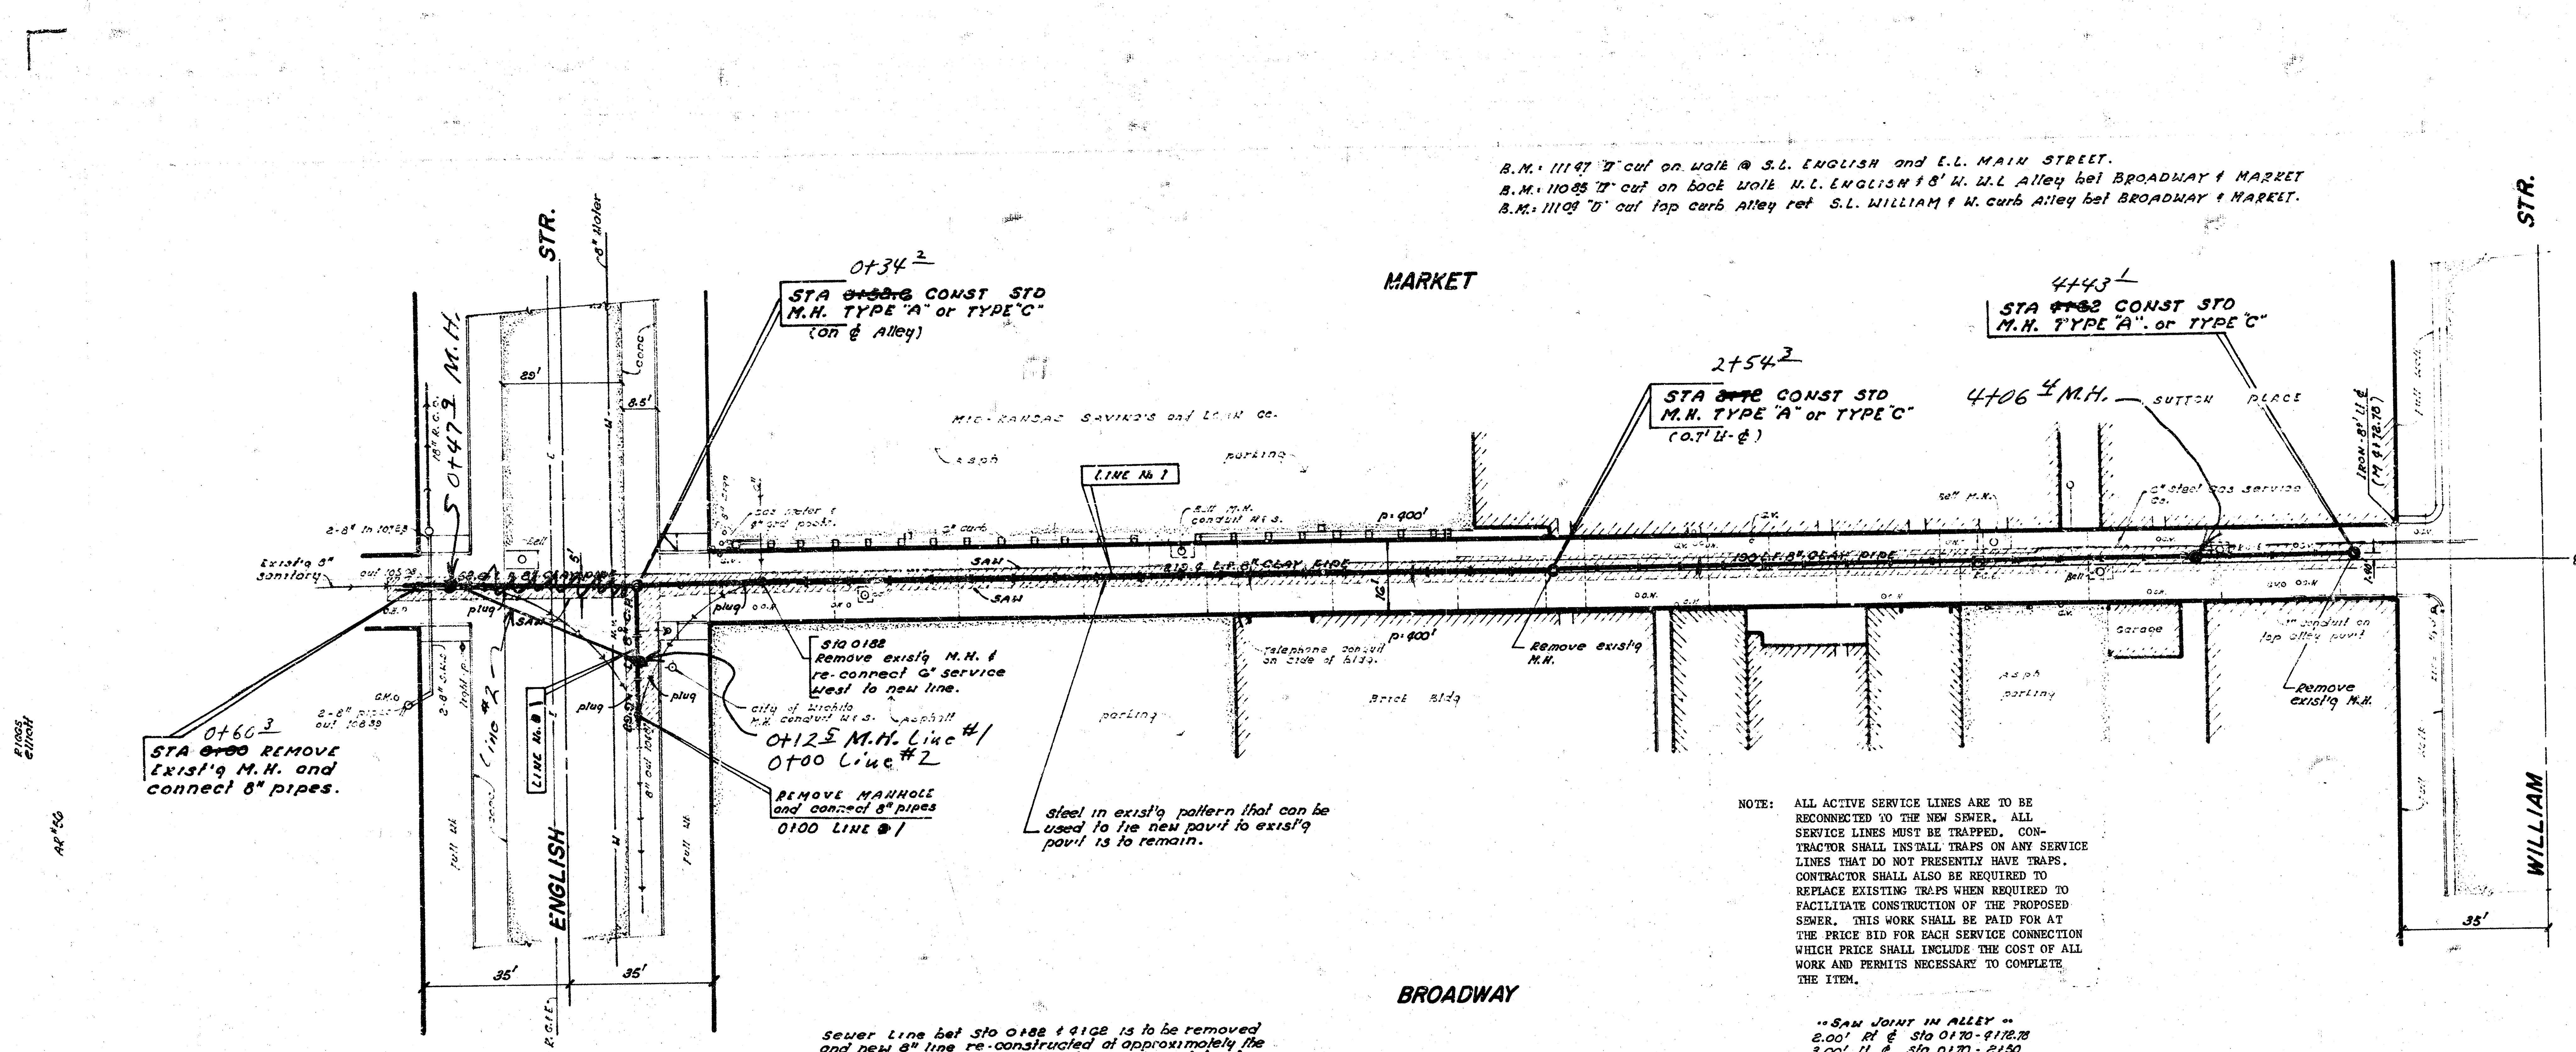

NOTE: ALL ACTIVE SERVICE LINES ARE TO BE RECONNECTED TO THE NEW SEWER. ALL SERVICE LINES MUST BE TRAPPED. CONTRACTOR SHALL INSTALL TRAPS ON ANY SERVICE LINES THAT DO NOT PRESENTLY HAVE TRAPS. CONTRACTOR SHALL ALSO BE REQUIRED TO REPLACE EXISTING TRAPS WHEN REQUIRED TO FACILITATE CONSTRUCTION OF THE PROPOSED SEWER. THIS WORK SHALL BE PAID FOR AT THE PRICE BID FOR EACH SERVICE CONNECTION WHICH PRICE SHALL INCLUDE THE COST OF ALL WORK AND PERMITS NECESSARY TO COMPLETE THE ITEM.

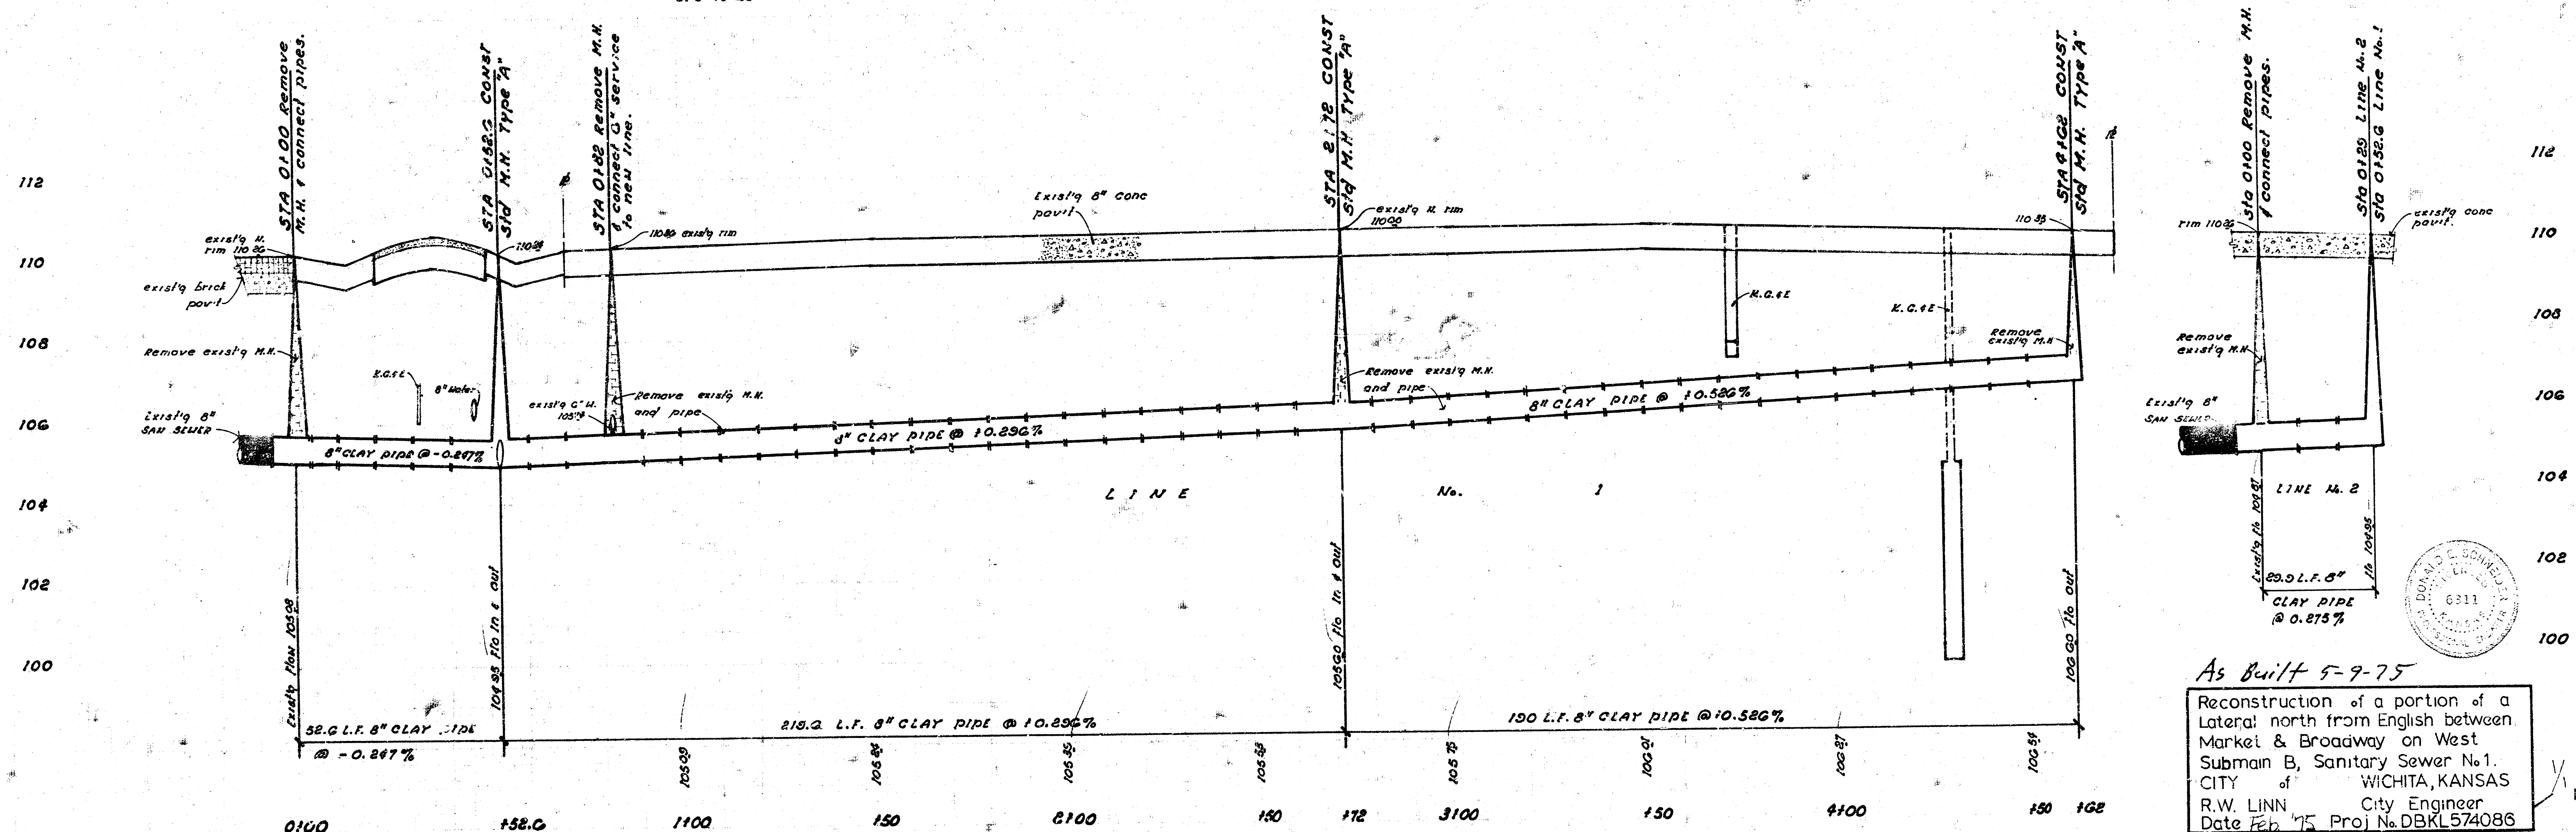

As Built 5-9-75

Reconstruction of a portion of a Lateral north from English between Market & Broadway on West Submain B, Sanitary Sewer No 1.
CITY of WICHITA, KANSAS
R.W. LINN City Engineer
Date Feb '75 Proj No. DBKL574086