

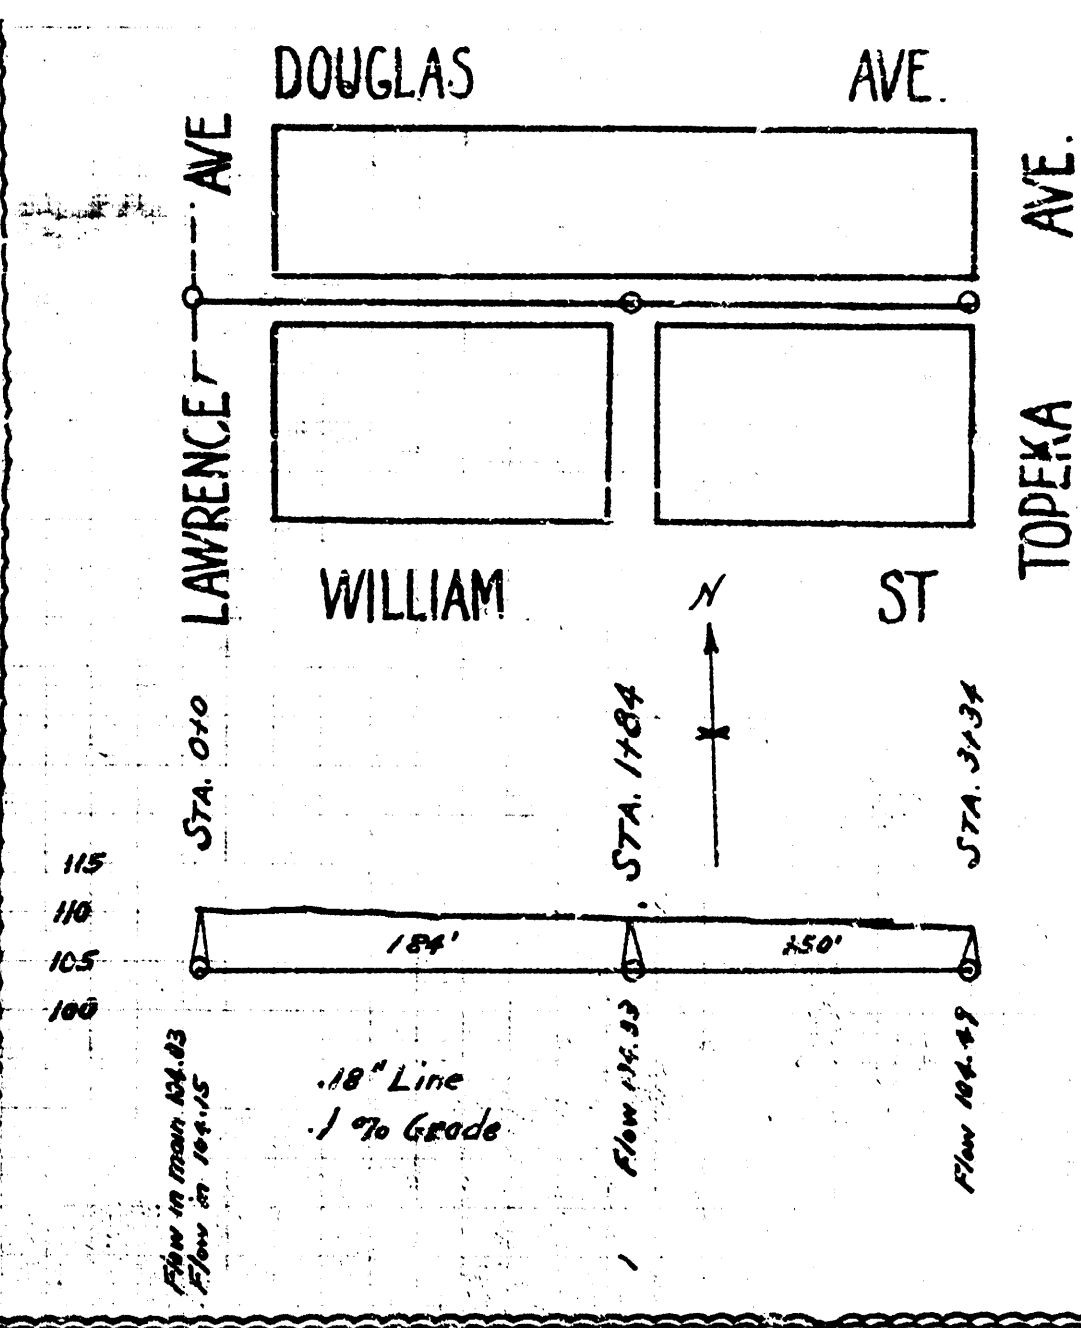
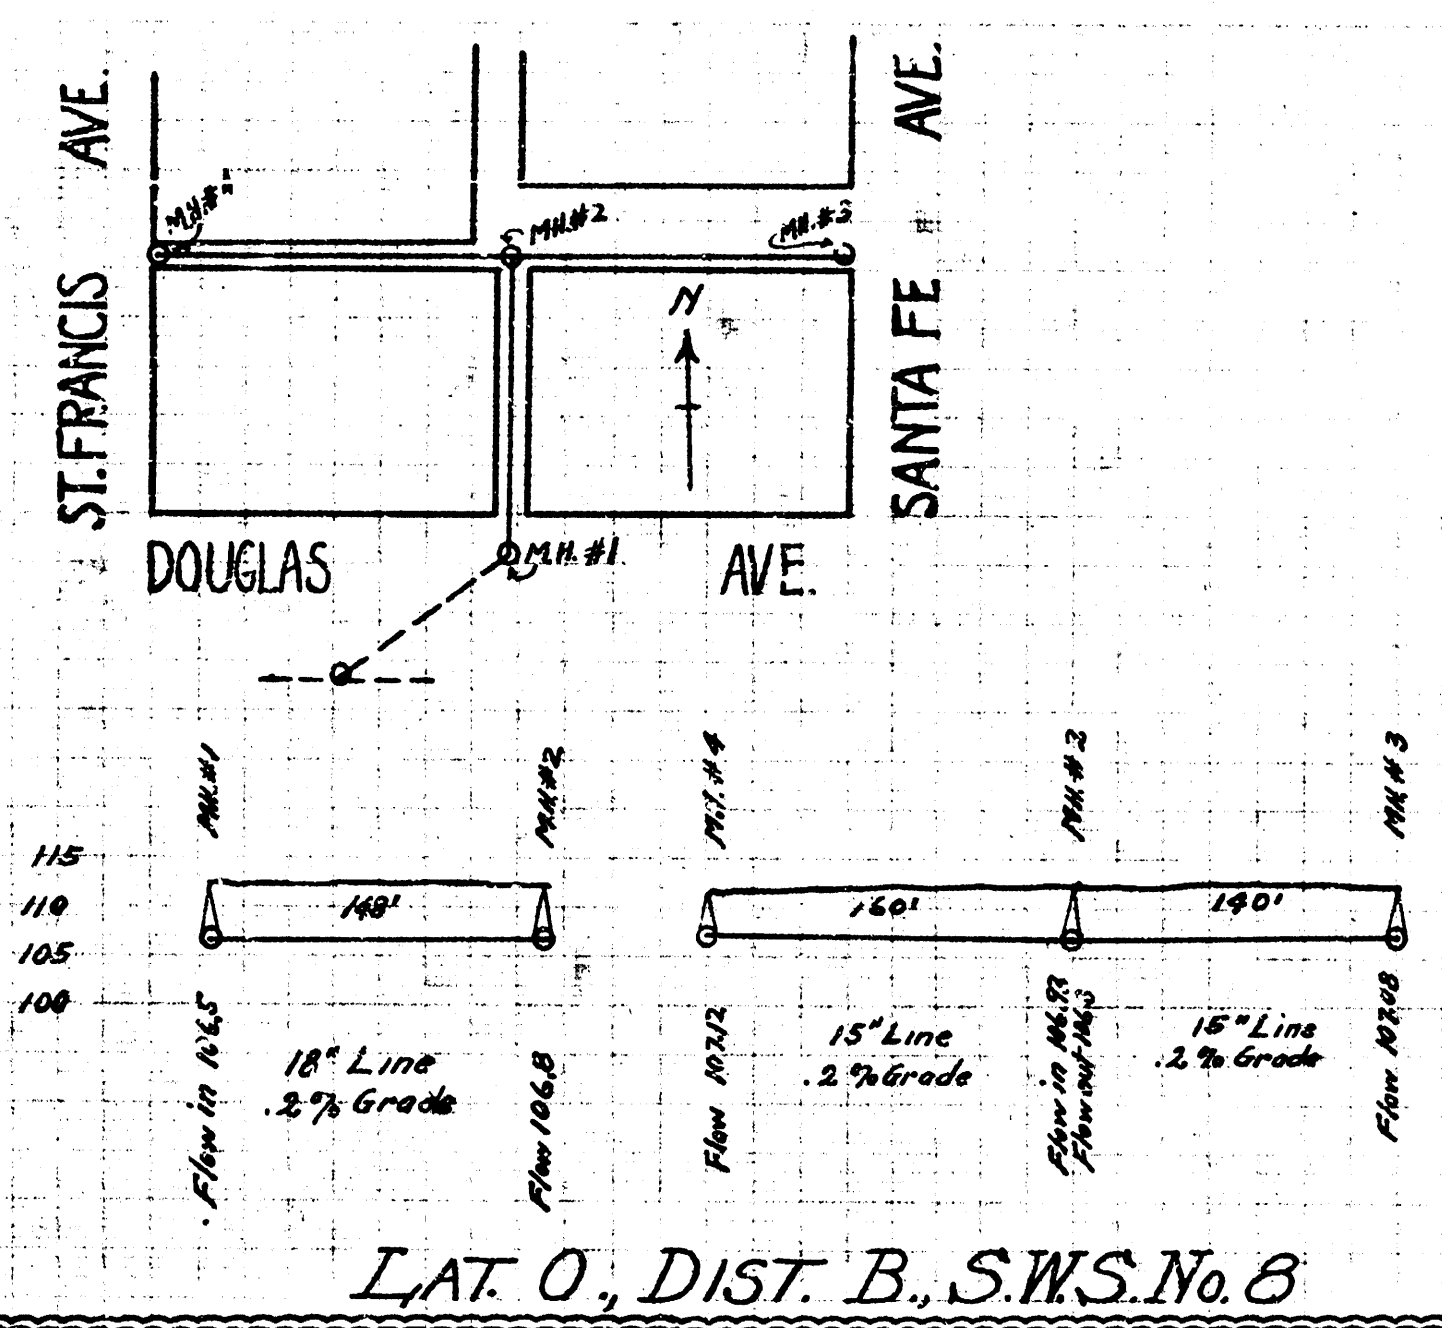
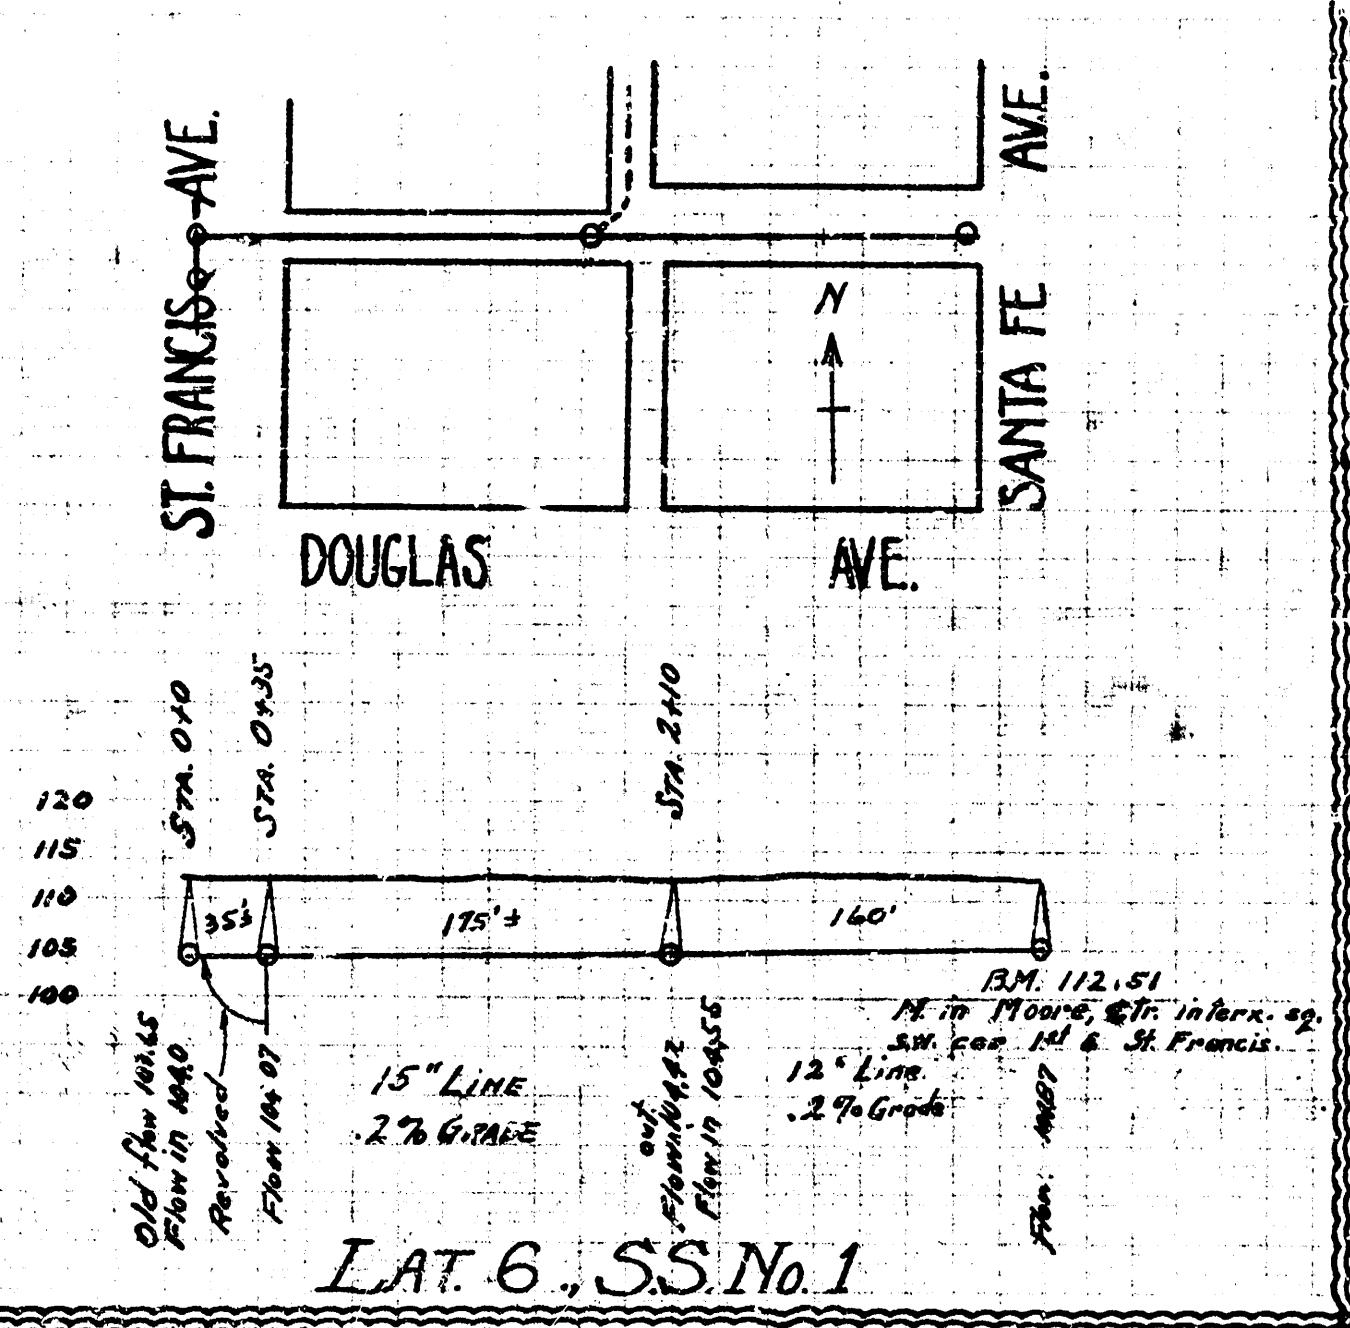
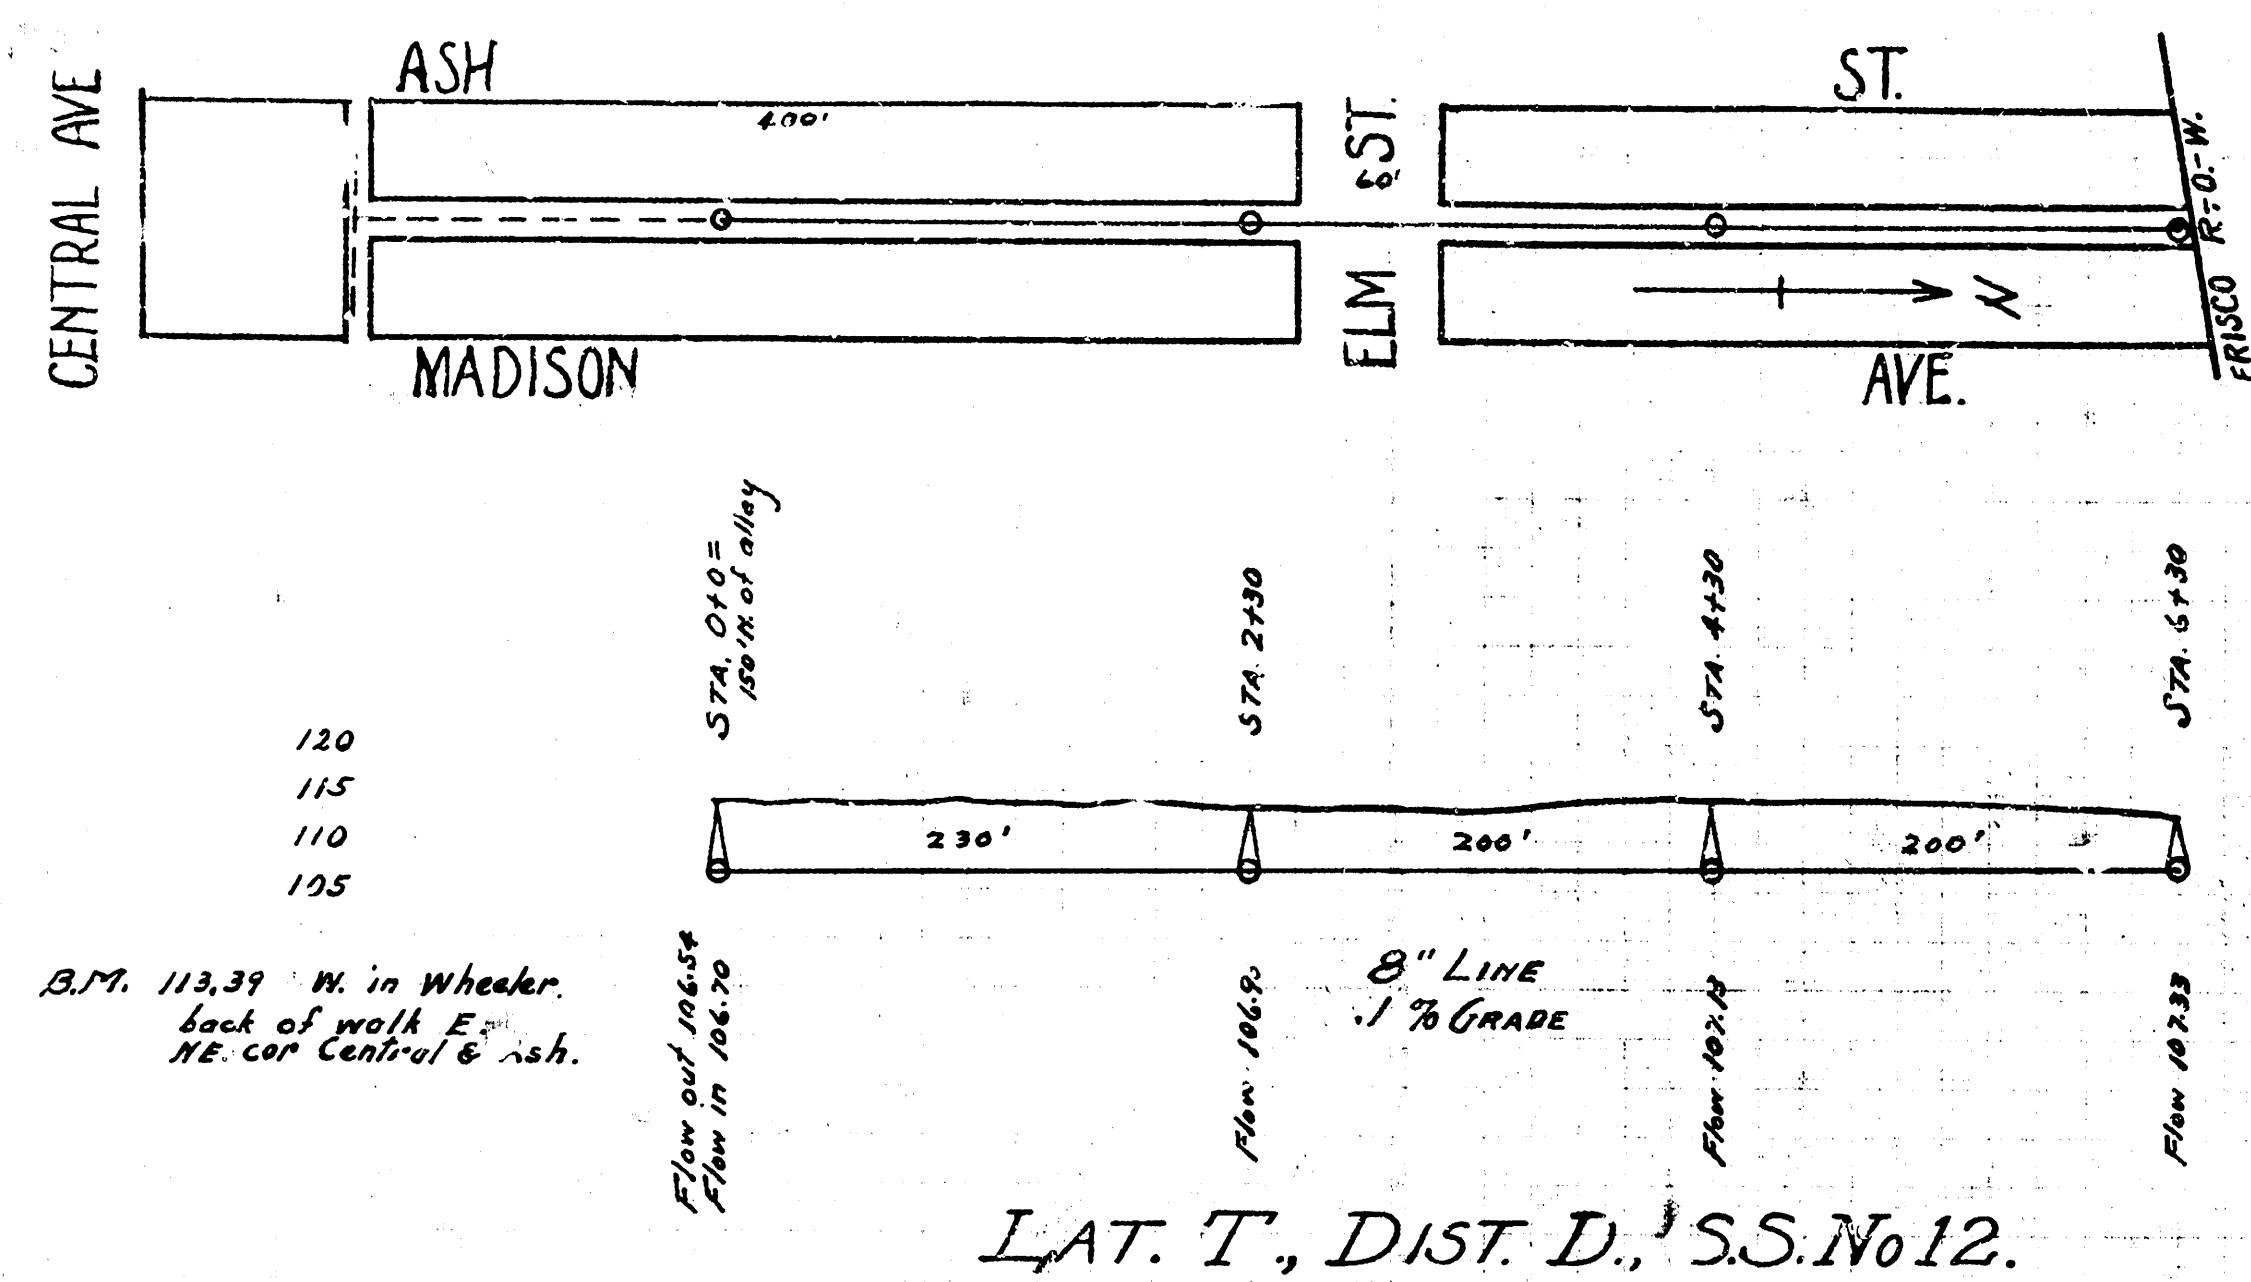


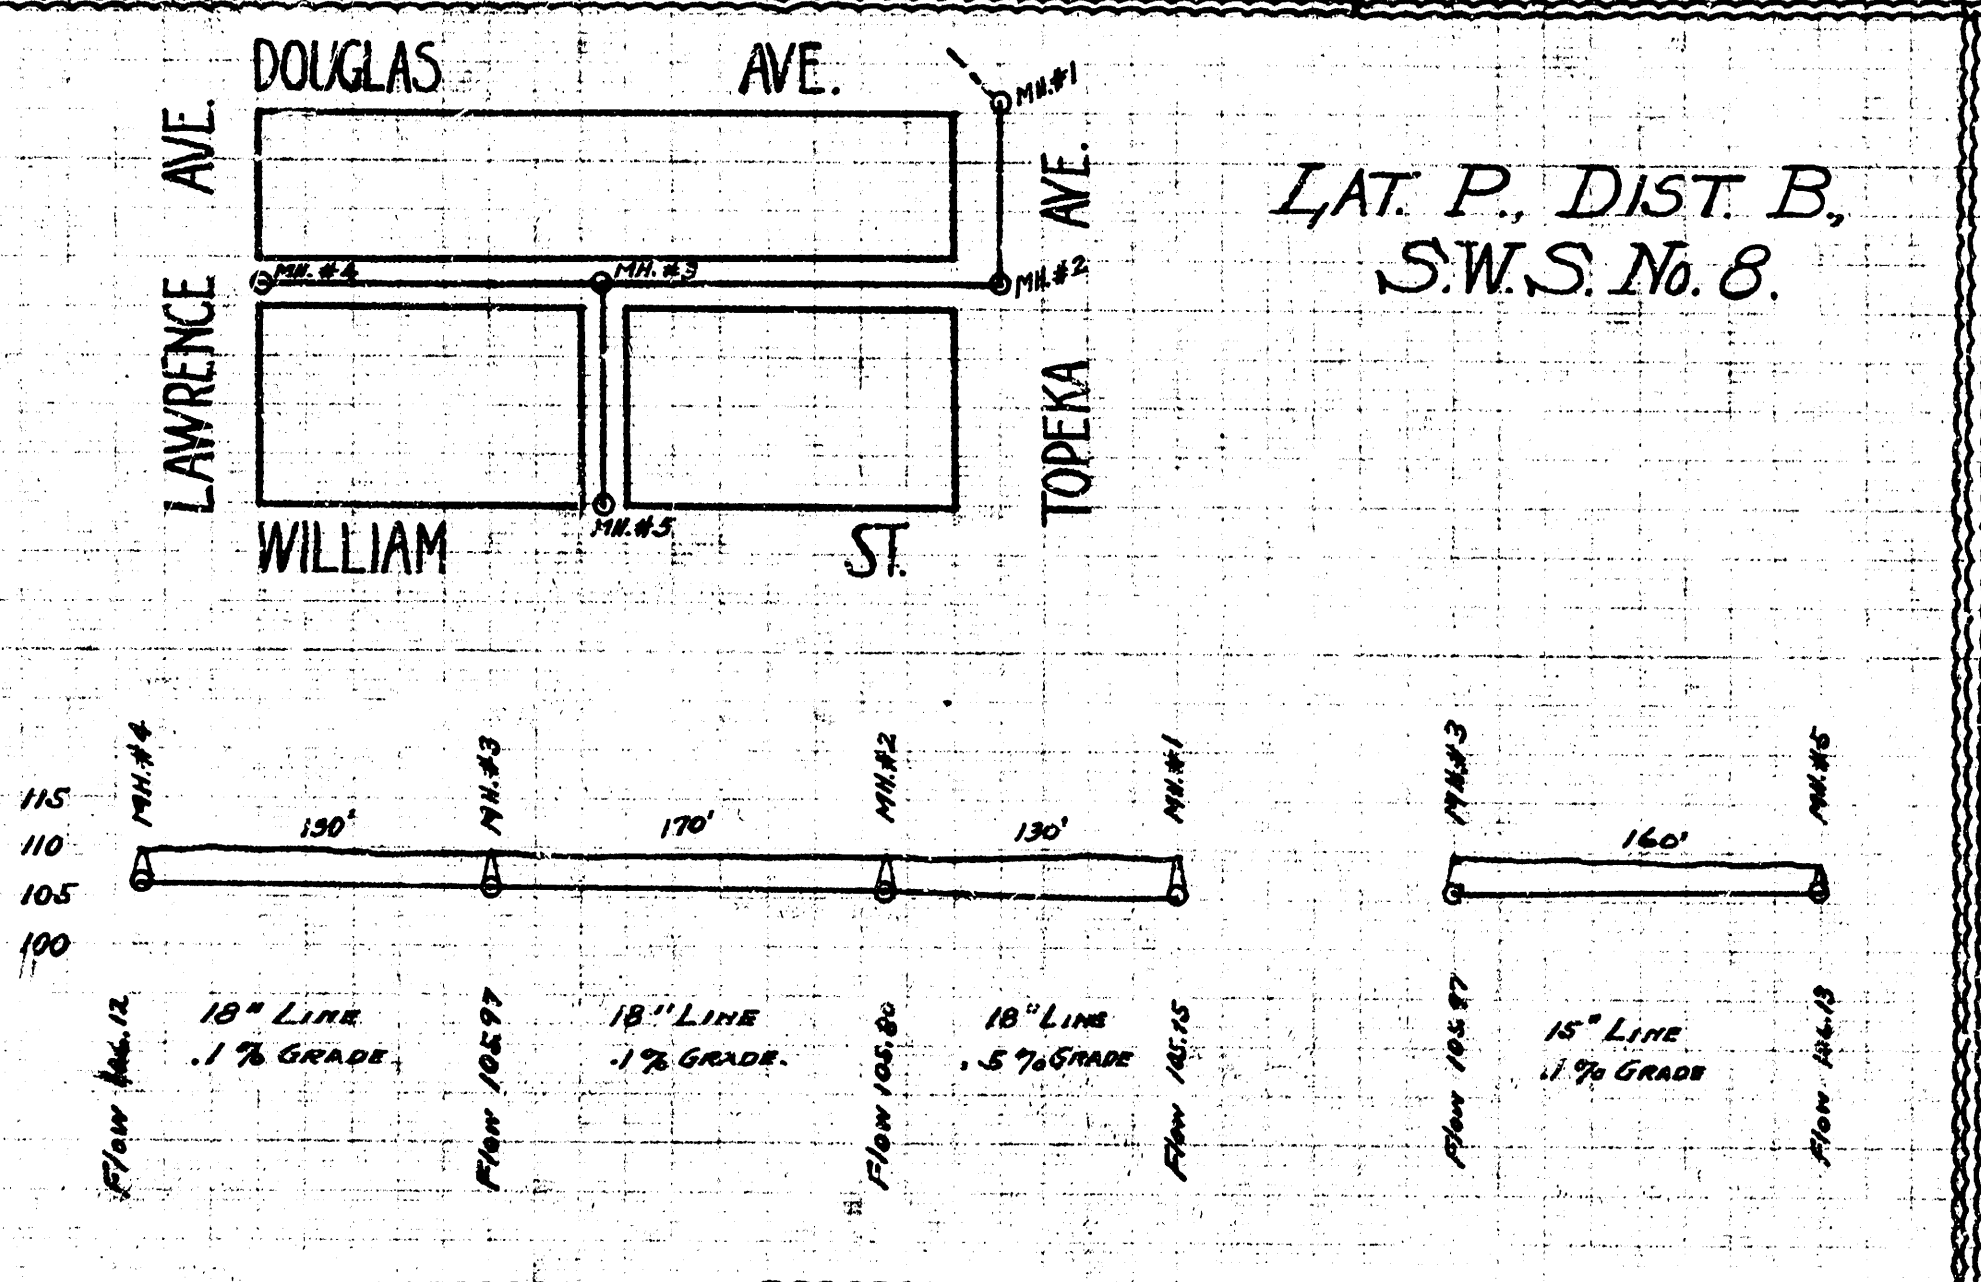

LAT. 7, S.S. No. 1.

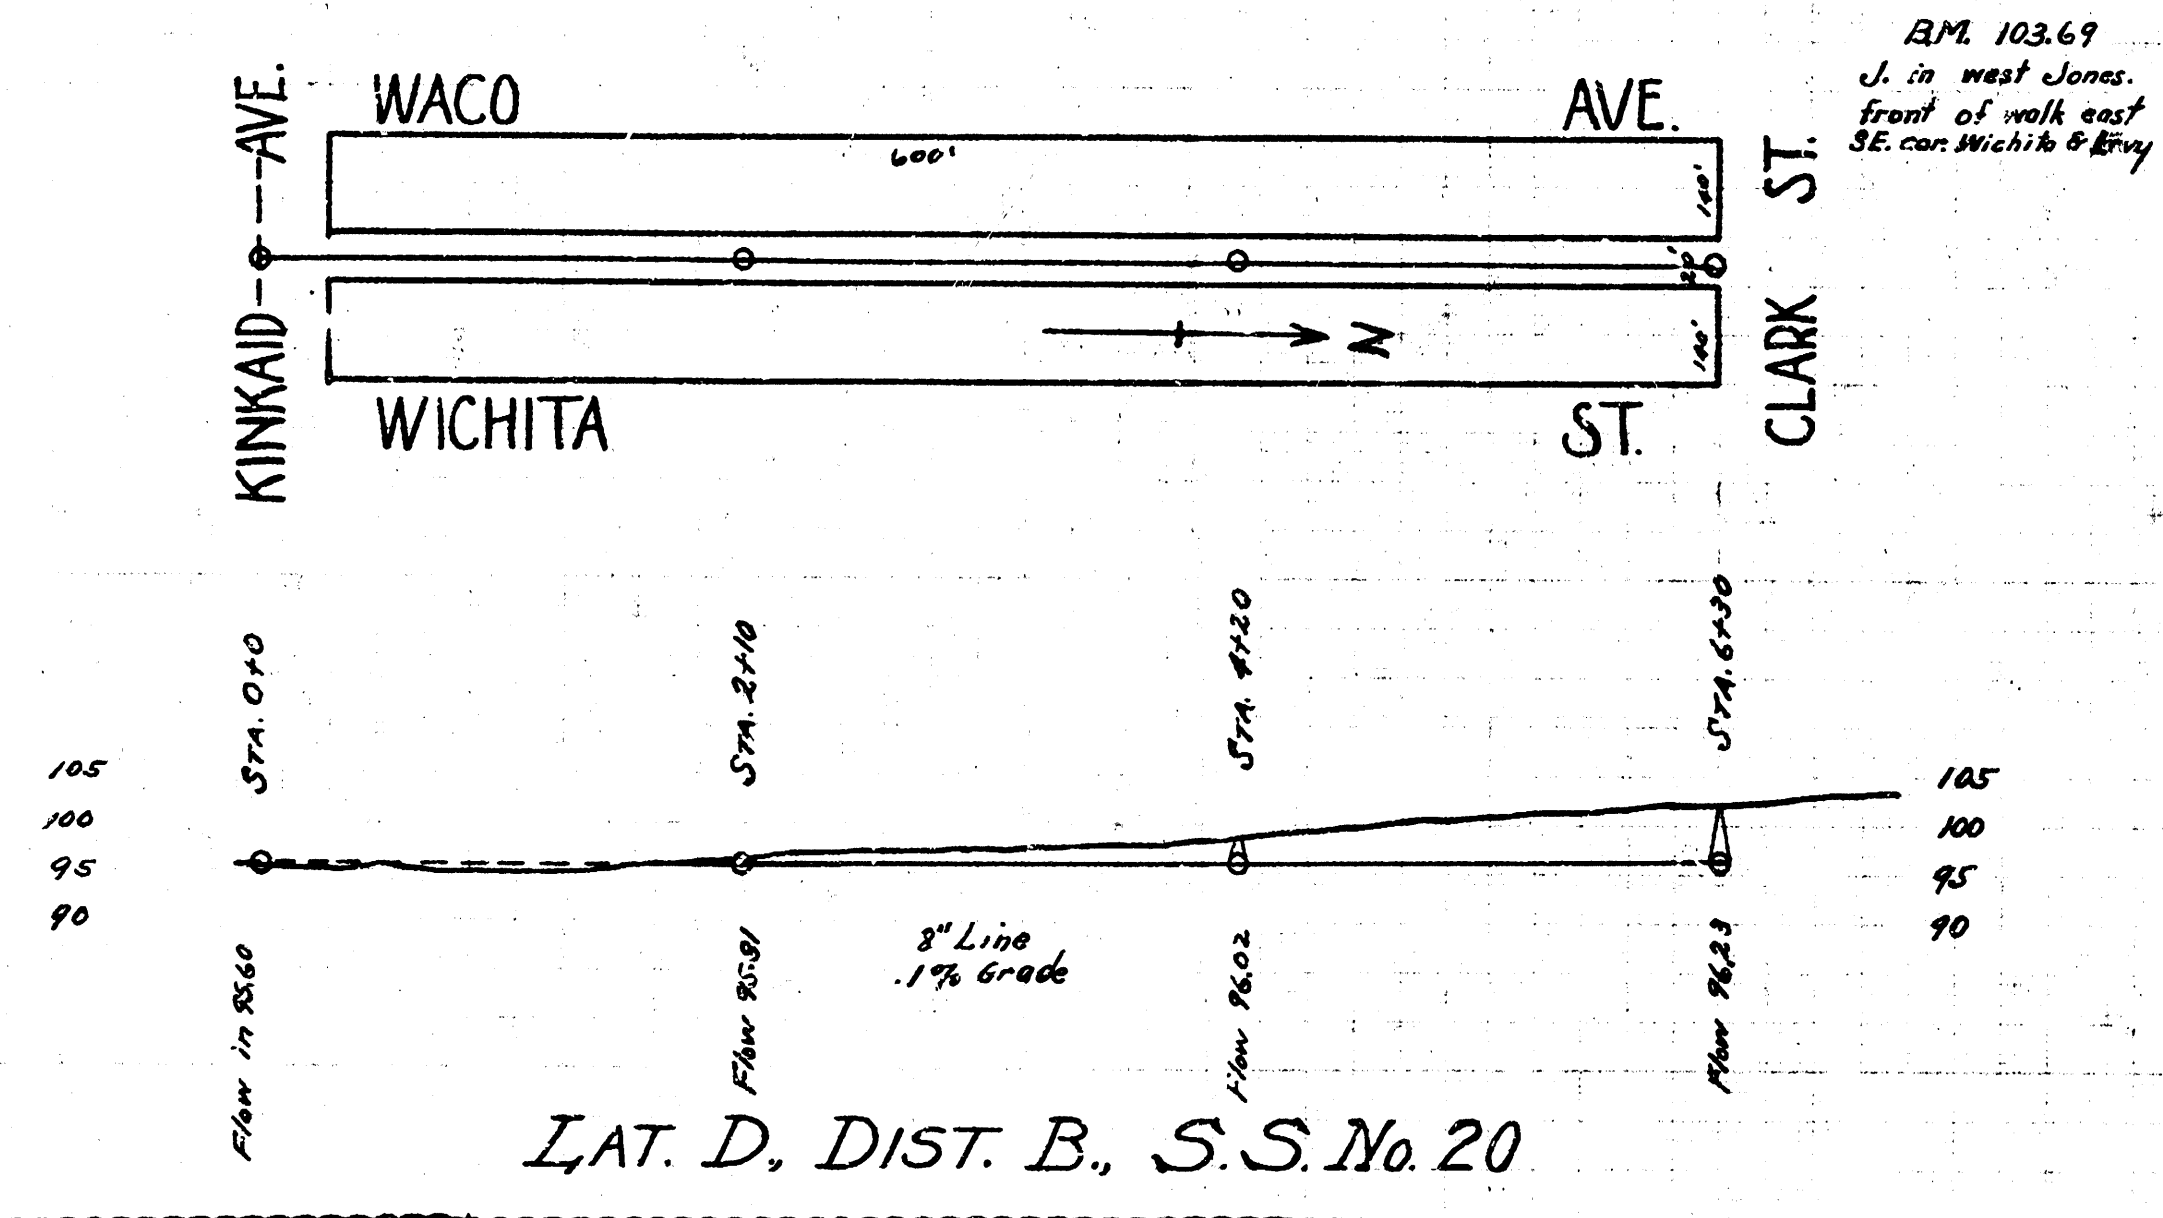

