





B.M. 10.00 "F" in Fisher Front of W.R.W. NW Waco & Pine
[Assumed]

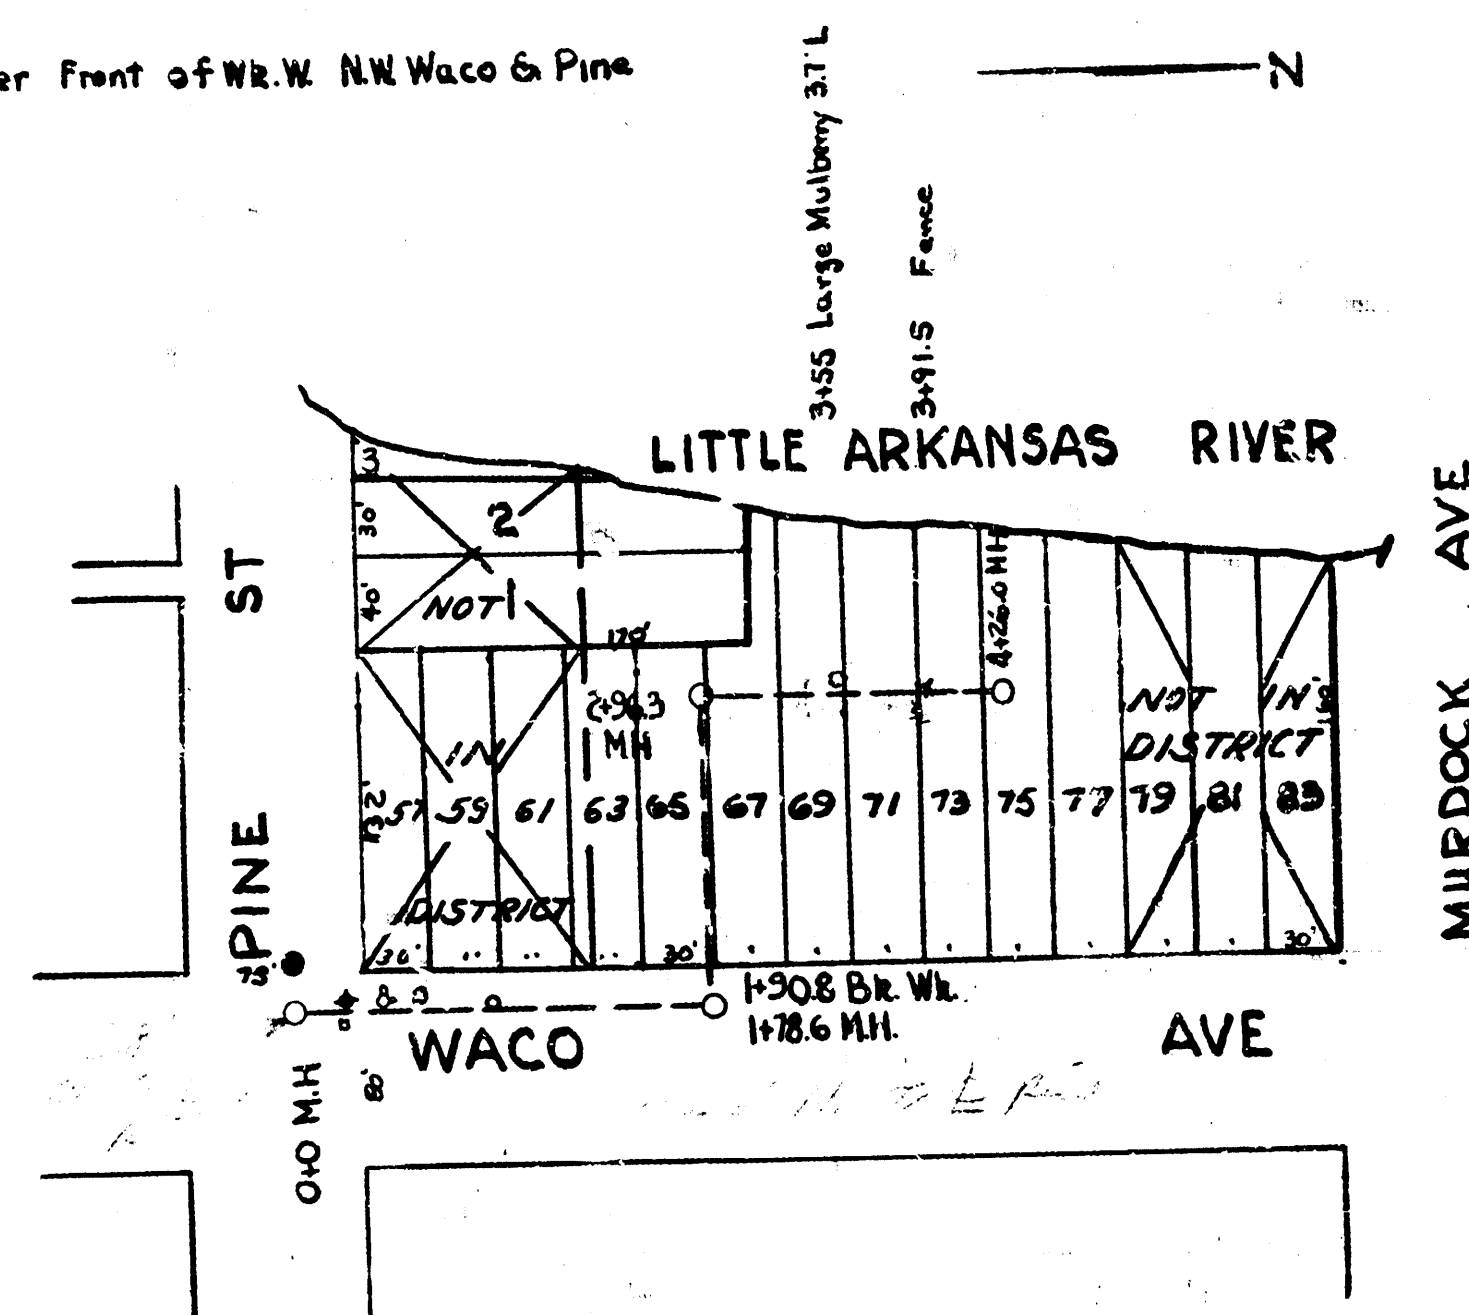


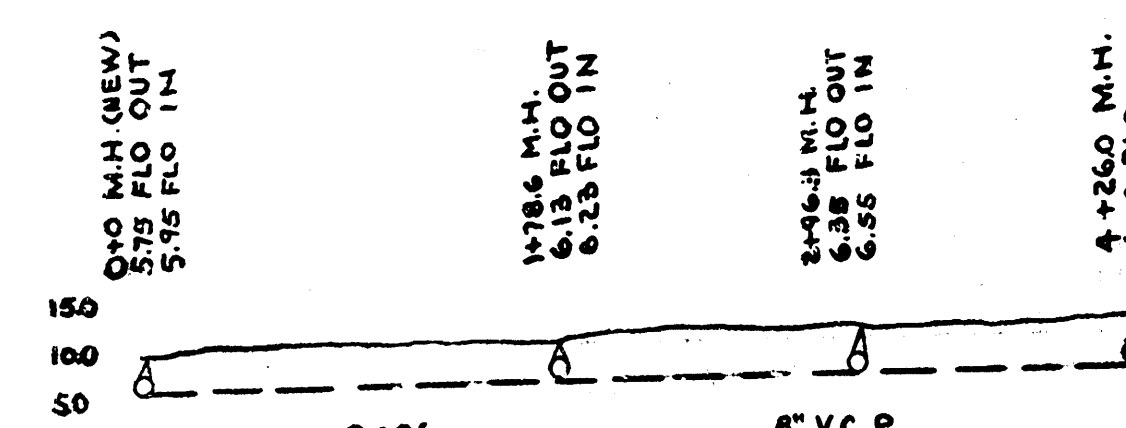


LAT 10 S.S.1
DEPT. of SERVICE
CITY of WICHITA, KANS.
Engineering Division
L.K. WHITE City Engineer
Sanitary Sewer
Scale 1" = 80'

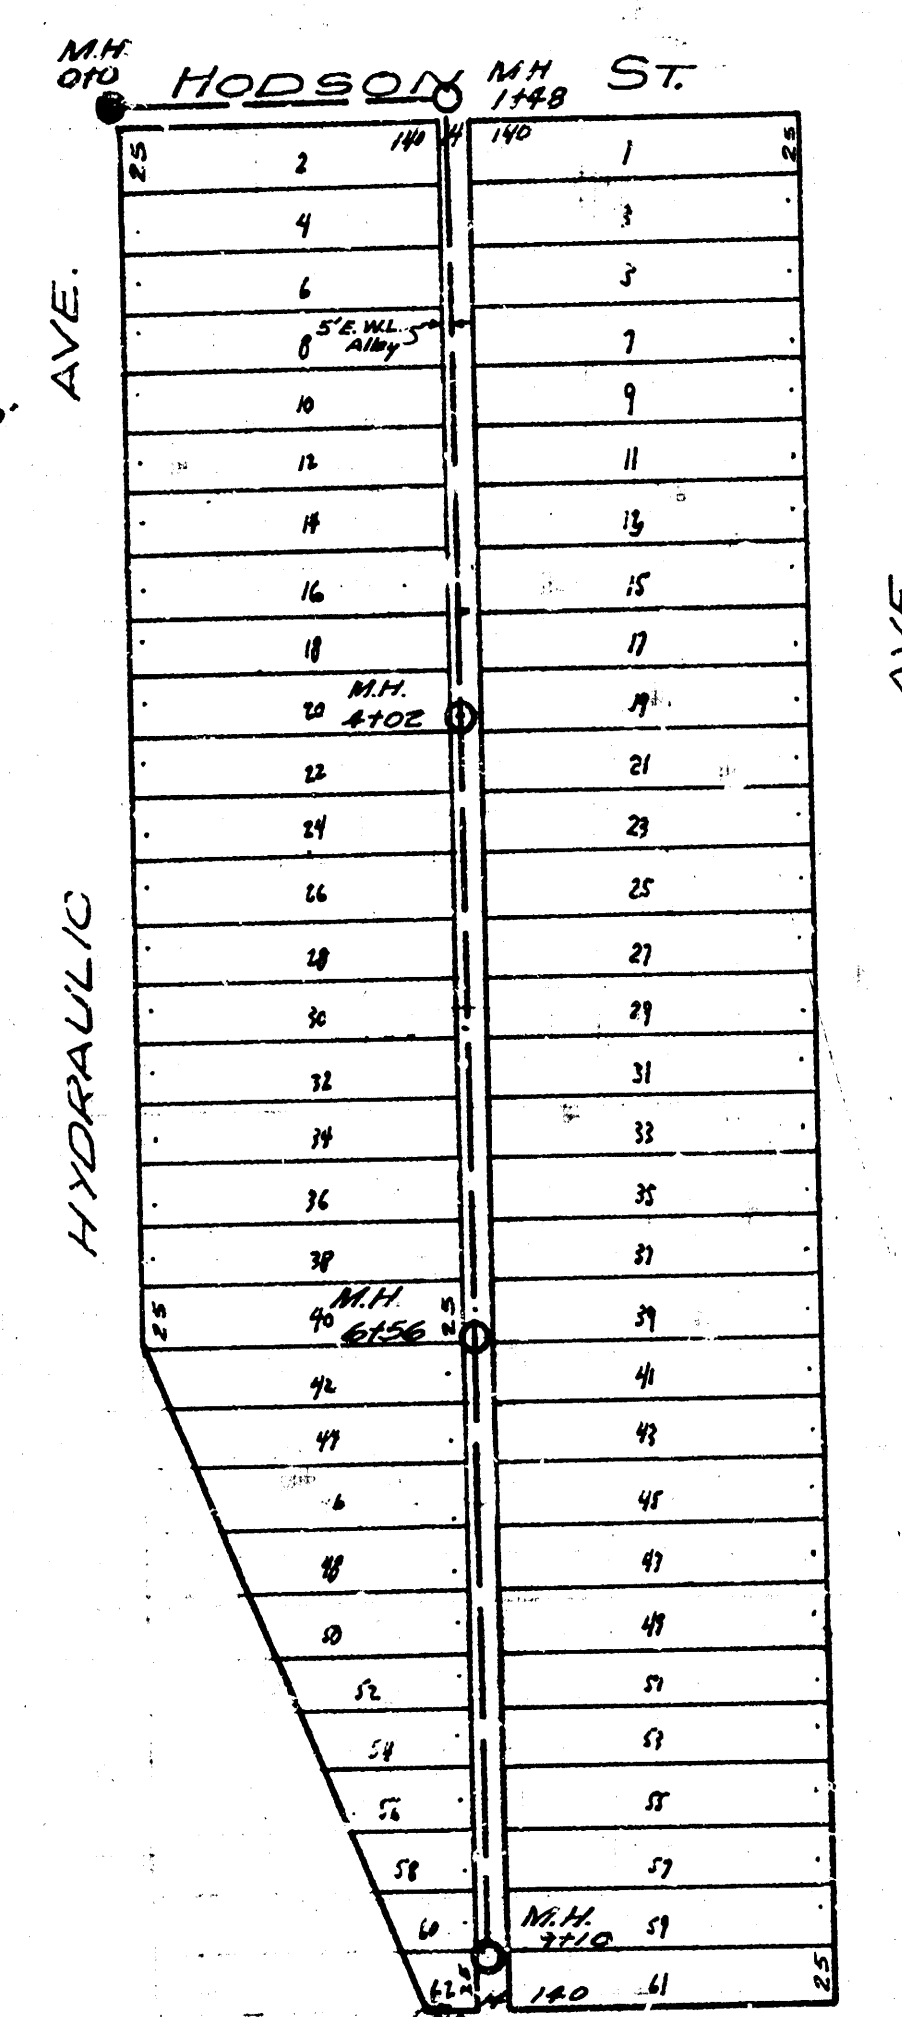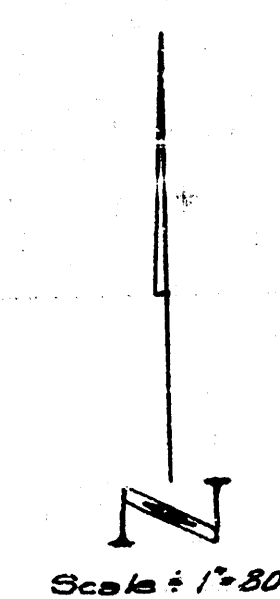

B.M. 97.10 "P" IN BITCHIE E.C. RET. ALLEY S.S. HODSON
BETWEEN KANSAS & HYDRAULIC
B.M. 97.18 NW COR CONC. PARK 1ST HOS. WEST
KANSAS S.S. STAFFORD.

LAT 1 DIST. B MIAN 20

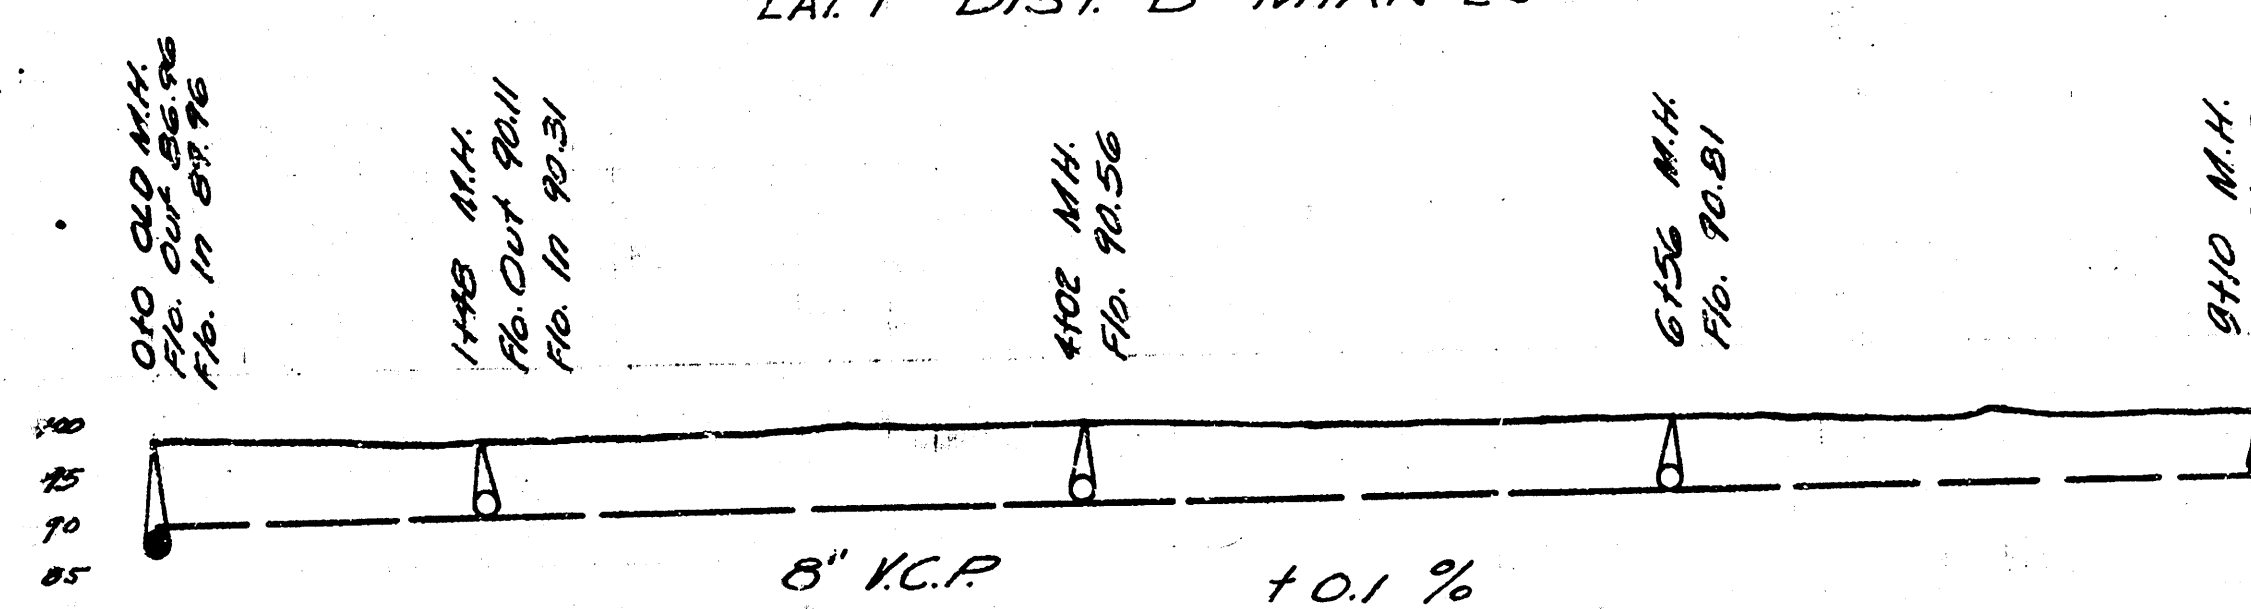

DEPARTMENT OF SERVICE
WICHITA CITY OF KANSAS
Engineering Division
L.K. WHITE City Engineer
Sanitary Sewer Scale 1" = 80'