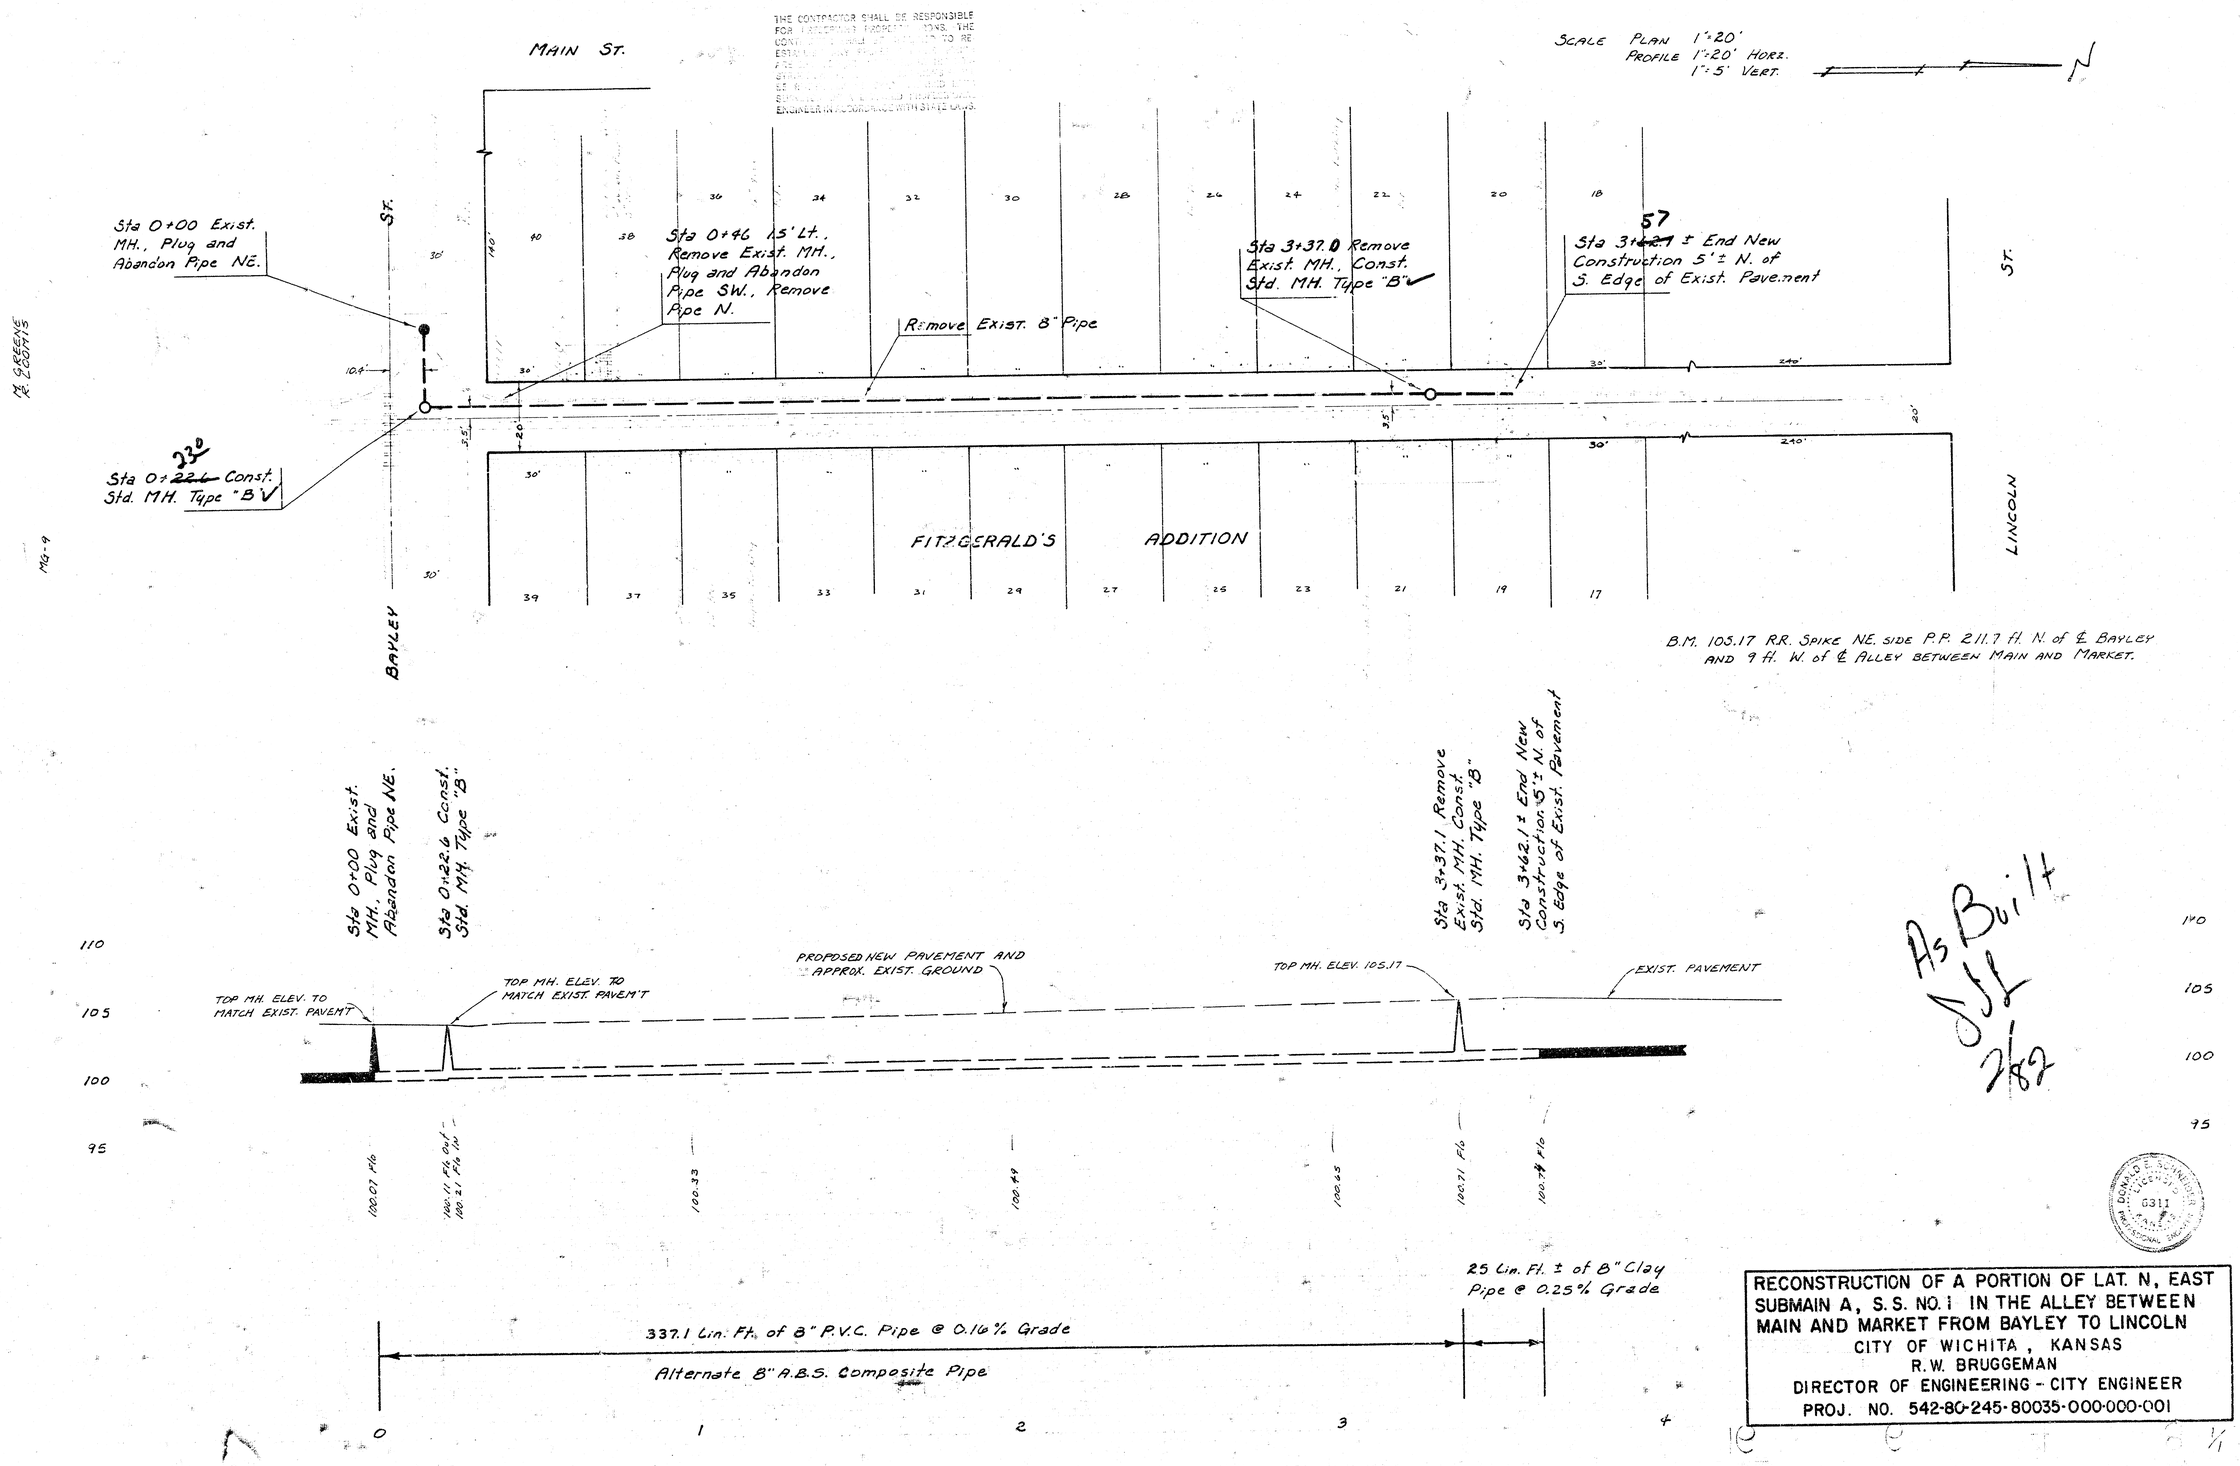

As Built
JJL
2/82

RECONSTRUCTION OF A PORTION OF LAT. N, EAST SUBMAIN A, S.S. NO. 1 IN THE ALLEY BETWEEN MAIN AND MARKET FROM BAYLEY TO LINCOLN
CITY OF WICHITA, KANSAS
R.W. BRUGGEMAN
DIRECTOR OF ENGINEERING - CITY ENGINEER
PROJ. NO. 542-80-245-80035-000-000-001