

NOTE: CONTRACTOR'S METHOD FOR HANDLING SEWAGE FLOWS DURING CONSTRUCTION OF THIS PROJECT SHALL BE APPROVED BY THE ENGINEER.

B.M. 117.39 R.R. Spk. N.W. face of Tele. Pole ≈ 305' So. of ℄ of 8th St. & W. of WACO.

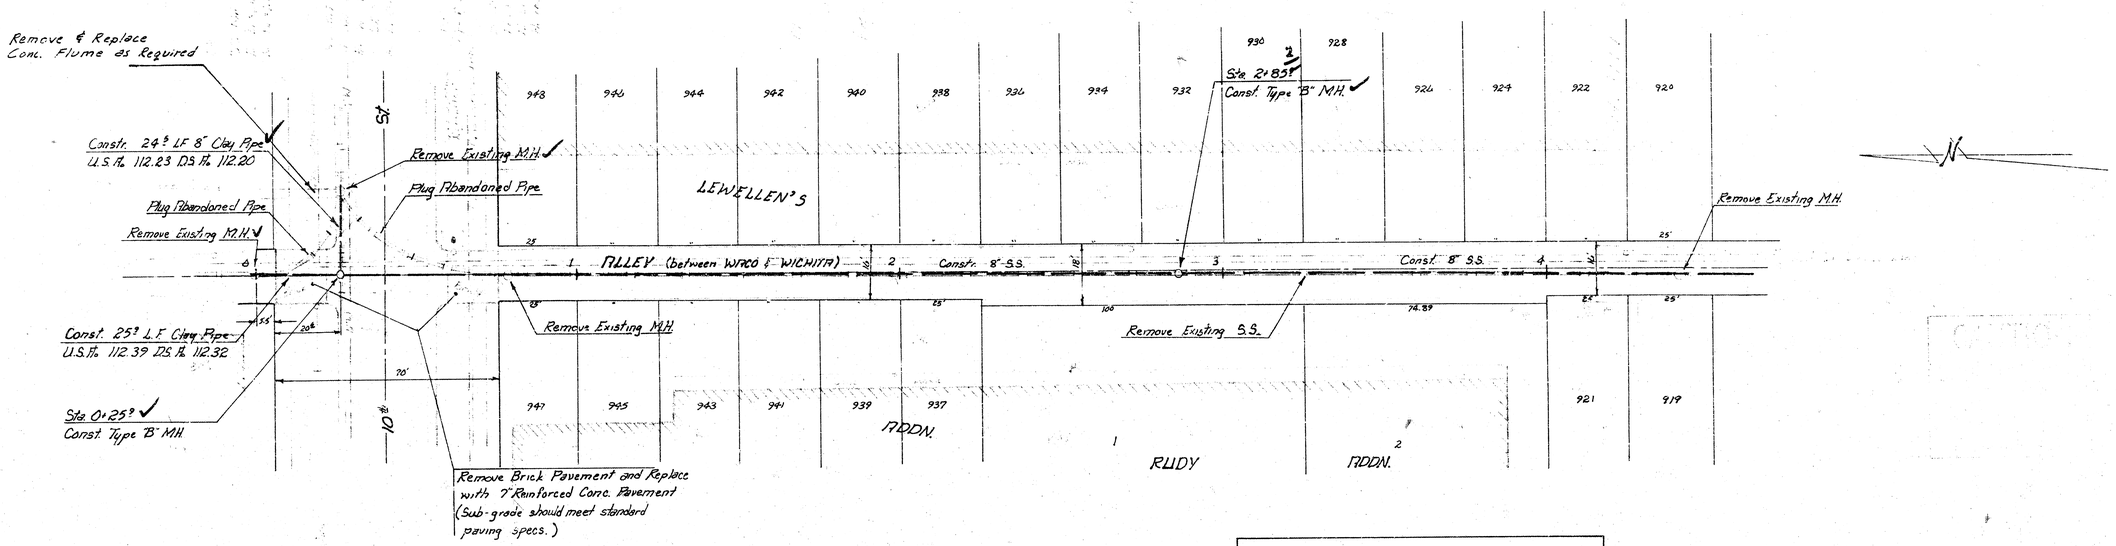

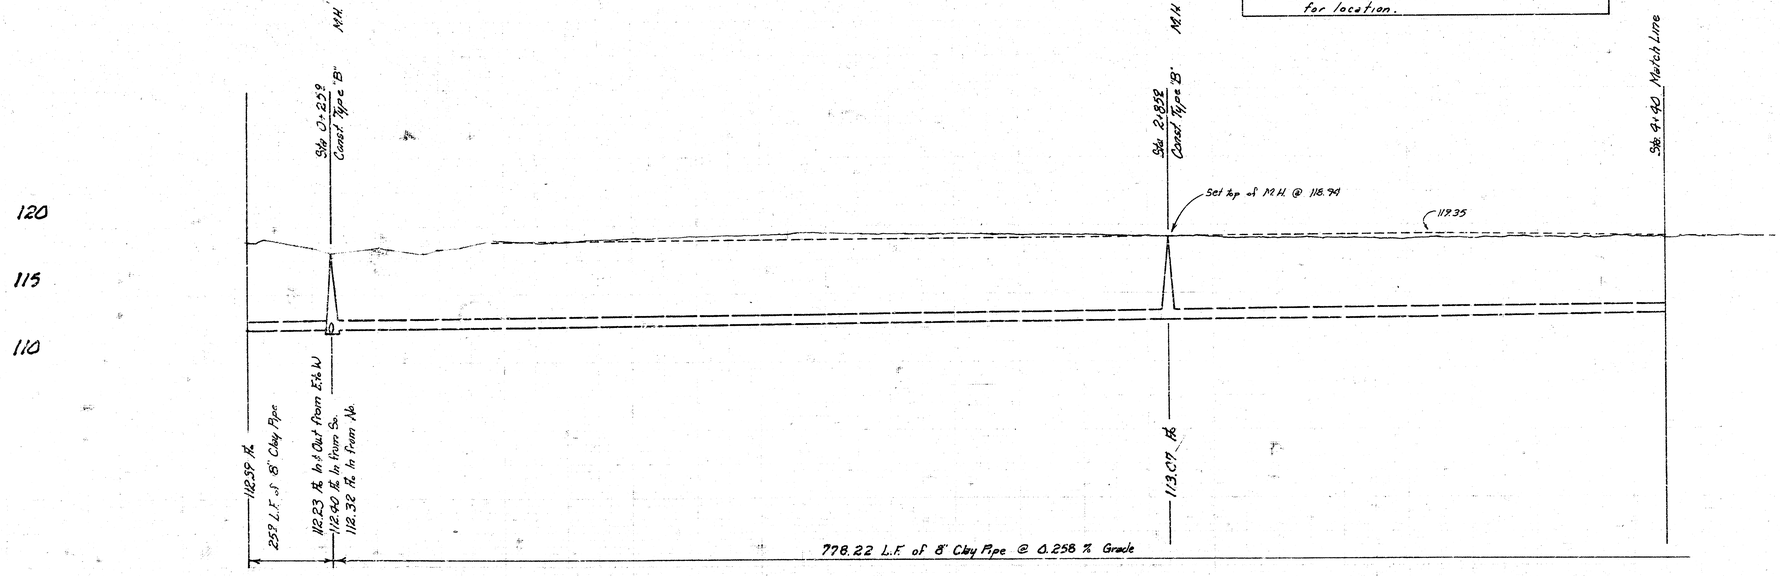

+SCALE+
PLAN 1"=20'
PROFILE
Horz. 1"=20'
Vert 1"=5'

As Built
10/61

Reconstruct a portion of Lat. N & S. W. Submain R, S.S.#1 in the Alley between Waco & Wichita from 9th to 10th


City of WICHITA, KANSAS
R.W. Bruggeman — City Engineer

DATE _____ Sheet 1 of 2

Proj. No.: 542-80-249-80006-000-000-031

B. Rouse
J. Nyfeler, Jr.
8/29
4/30

BR-10

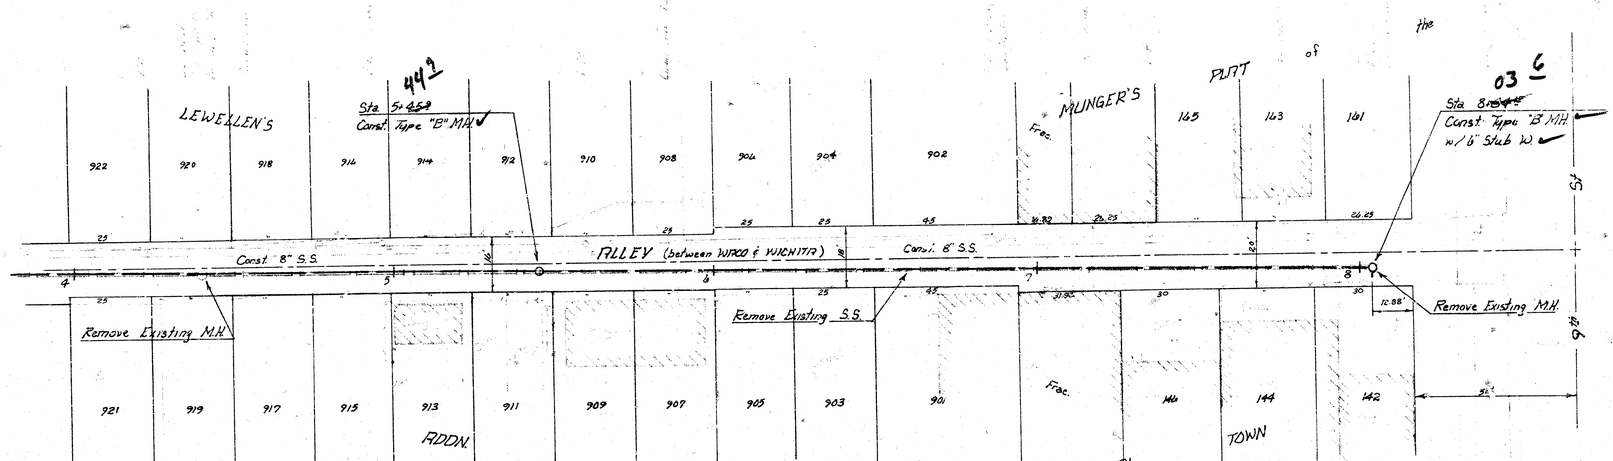

÷ SCALE ÷

PLAN 1" = 20'

PROFILE

Horz. 1" = 20'

Vert. 1" = 5'

As Built 10/81

Sheet 2 of 2

Proj. No. : 542·80·245·80006·000·000·001