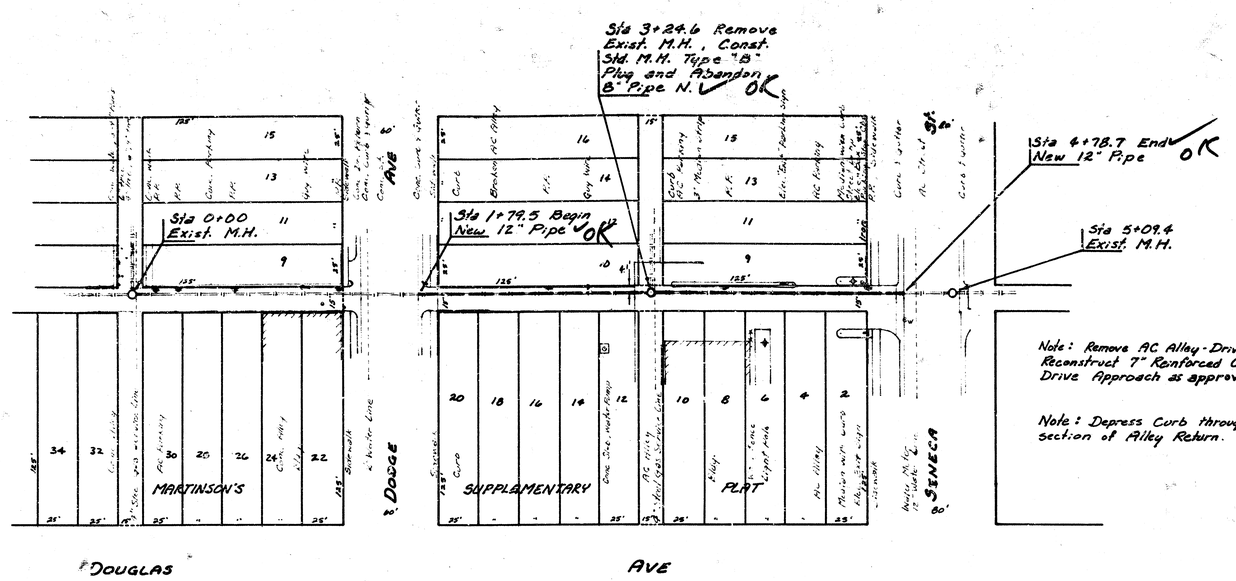

Scale Plan 1" = 40'
Profile 1" = 40' Horz.
1" = 5' Vert.

Note: Remove AC Alley-Drive Approach. Reconstruct 7" Reinforced Conc. Alley-Drive Approach as approved by Engineer.

Note: Depress Curb through Sidewalk section of Alley Return.

B.M. 113.67 'x' Bk. Walk at corner Bldg. NE. corner Seneca and Douglas.

B.M. 109.777 City Disc. 32.6' S and 39' W of ℄ both Seneca and Maple.

B.M. 112.655 'x' on side walk at SE. corner of Bldg. NW corner of Douglas and Dodge

NOTE: CONTRACTOR'S METHOD FOR HANDLING SEWAGE FLOWS DURING CONSTRUCTION OF THIS PROJECT SHALL BE APPROVED BY THE ENGINEER. CONTRACTOR WILL BE REQUIRED TO OBTAIN PERMITS FROM PUBLIC WORKS ADMINISTRATION BEFORE RECONNECTING BUILDING SERVICE LINES. PERMIT FEE WILL BE WAIVED. BID ITEM FOR SERVICE CONNECTIONS SHALL COVER ALL COSTS FOR FURNISHING AND INSTALLING SADDLE INCLUDING TAPPING FEE. PIPE CAPS ARE TO BE MADE BY CITY MAINTENANCE DEPARTMENT PERSONNEL UNLESS APPROVED OTHERWISE BY THE ENGINEER. ONLY ACTIVE BUILDING SANITARY SEWER LINES ARE TO BE RECONNECTED TO THE NEW SEWER. CONTRACTOR SHALL VERIFY WHICH LINES ARE ACTIVE. EVERY BUILDING SEWER RECONNECTED TO THE NEW SEWER SHALL BE TRAPPED. CLEAN OUTS SHALL BE INSTALLED WITH THE TRAPS. [illegible] CLEAN OUTS SHALL BE CLASS 52 CAST IRON PIPE AND WILL BE PAID FOR AT THE UNIT PRICE BID PER LINEAL FOOT OF CAST IRON PIPE. LOCATION OF TRAPS AND CLEAN OUTS SHALL BE AS APPROVED BY THE ENGINEER. [illegible] CONTRACTOR SHALL GIVE ALL PROPERTY OWNERS AND TENANTS AFFECTED BY THE CONSTRUCTION OF THIS PROJECT A MINIMUM OF 24 HOURS ADVANCE NOTICE PRIOR TO START OF CONSTRUCTION.

ALL 4" AND 6" SEWER CONSTRUCTION SHALL CONFORM TO THE APPLICABLE SECTIONS OF THE CITY OF WICHITA CODE.

As Built

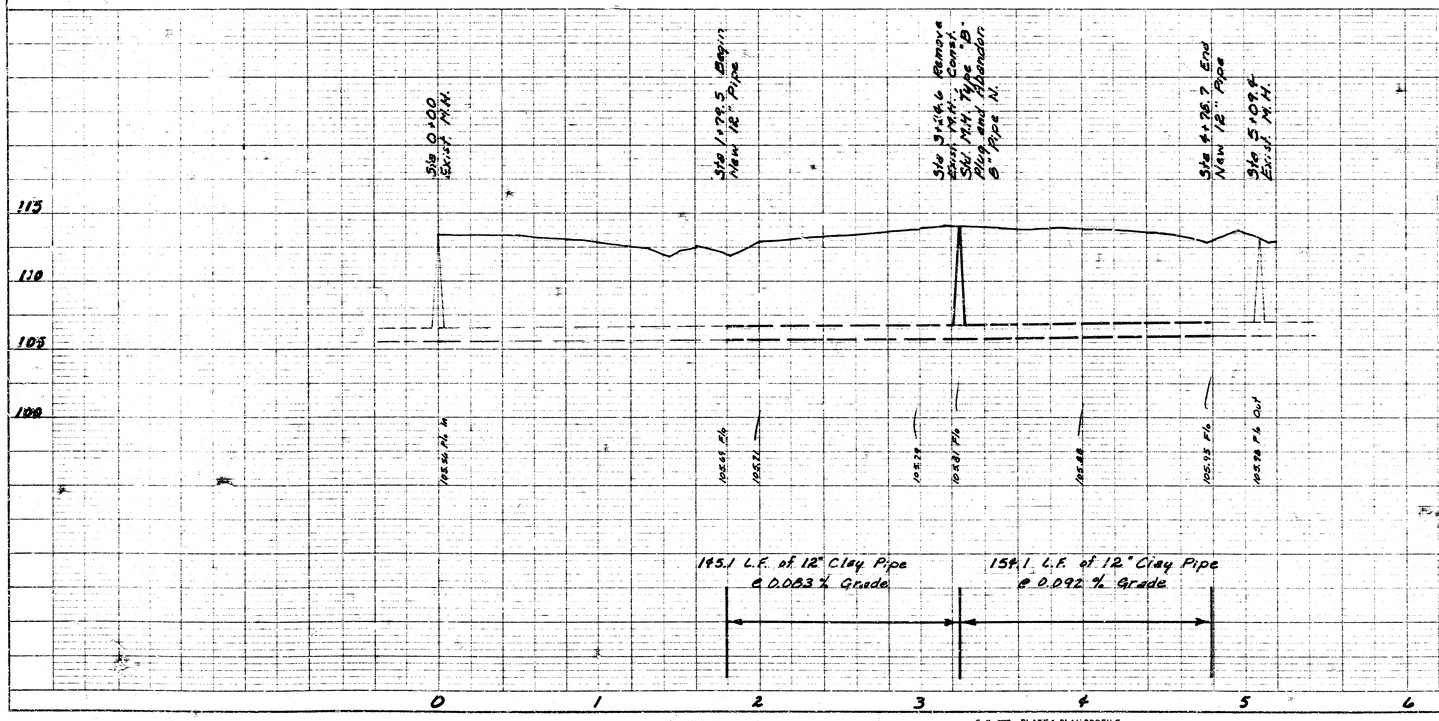

DONALD E. SCHNEIDER LICENSED 6311 KANSAS PROFESSIONAL ENGINEER

RECONSTRUCTION OF A PORTION OF SAN. SEWER NO. 8 IN THE E-W ALLEY N. OF DOUGLAS, SENECA TO DODGE

CITY OF WICHITA, KANSAS
DEAN SELLERS — CITY ENGINEER
PROJ. NO. 542-80-245-80005-000-000-001

1/1

K+E PLATE 1, PLAN-PROFILE KEUFFEL & ESSER CO. 48 7024 MADE IN U.S.A.

FILMED FROM THE BEST AVAILABLE COPY