


B.M. 107.22 BRASS ROD IN CONCRETE POST.
NW CORNER 32' N & 27.3' W OF CENTERLINE
BOTH SENECA & MCCORMICK.

SCALE Plan 1" = 40'
Profile 1" = 40' Horiz.
1" = 5' Vert.

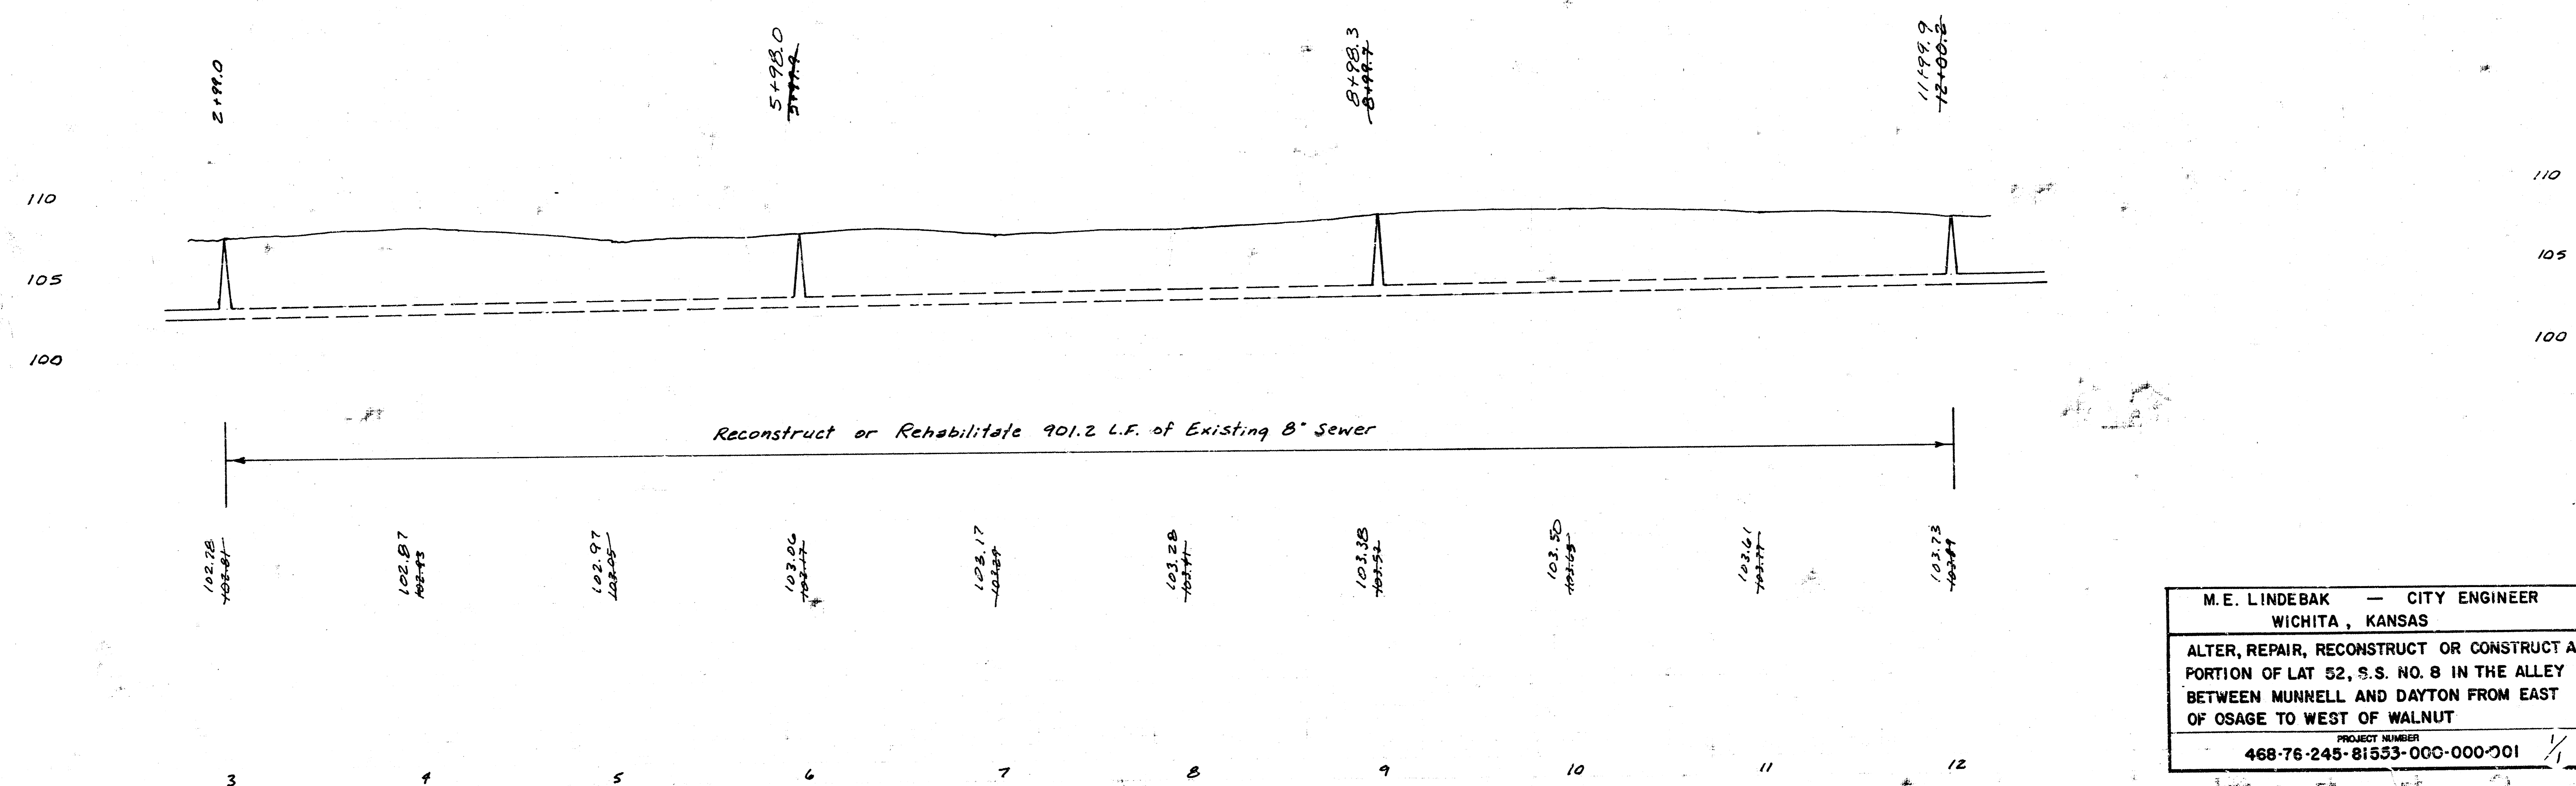

M. E. LINDEBAK — CITY ENGINEER
WICHITA, KANSAS
ALTER, REPAIR, RECONSTRUCT OR CONSTRUCT A
PORTION OF LAT 52, S.S. NO. 8 IN THE ALLEY
BETWEEN MUNNELL AND DAYTON FROM EAST
OF OSAGE TO WEST OF WALNUT
PROJECT NUMBER
468-76-245-81553-000-000-001

FILMED FROM THE BEST
AVAILABLE COPY