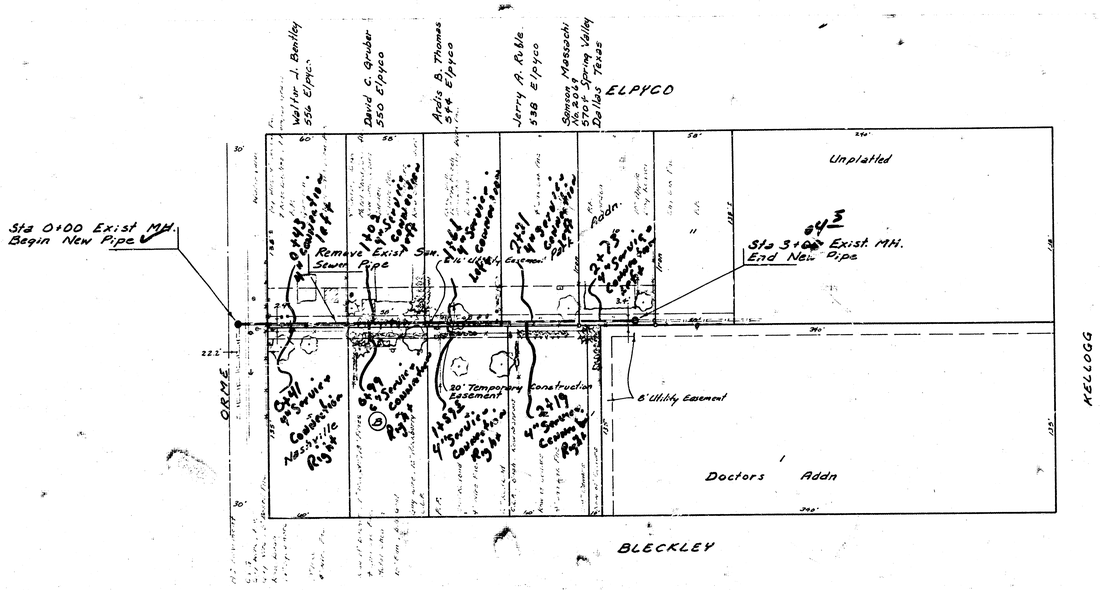

Scale Plan 1" = 40'
Profile 1" = 40' Horz.
1" = 5' Vert.

THE CONTRACTOR SHALL BE RESPONSIBLE FOR PRESERVING PROPERTY IRONS. THE CONTRACTOR SHALL BE REQUIRED TO RE-ESTABLISH ANY PROPERTY IRONS WHICH ARE DAMAGED OR DESTROYED BY HIS CONSTRUCTION OPERATIONS. SUCH IRONS SHALL BE RE-ESTABLISHED BY A LICENSED LAND SURVEYOR OR A LICENSED PROFESSIONAL ENGINEER IN ACCORDANCE WITH STATE LAWS.

B.M. 151.61 City Std. on NE Corner of RCBC at Pinecrest and E. Fork of Dry Creek.

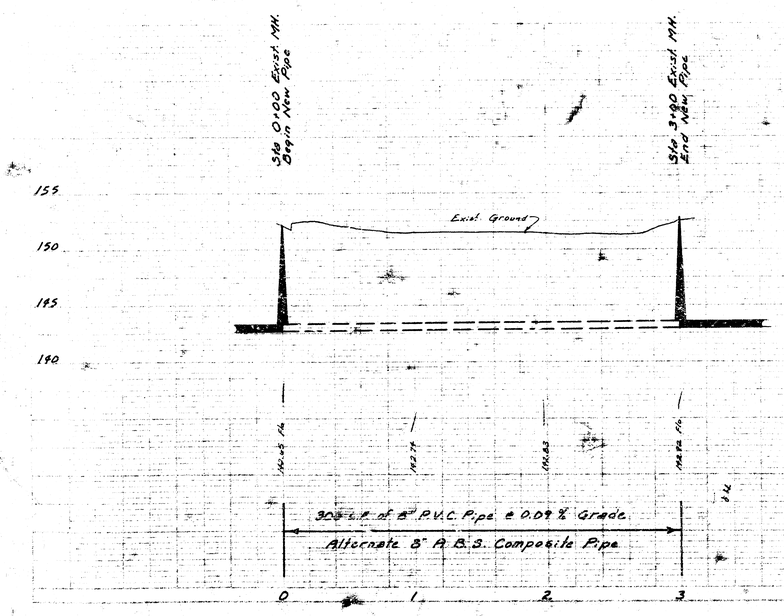

As Built
1/82

DONALD E. SCHNEIDER LICENSED 6311 KANSAS PROFESSIONAL ENGINEER

REPAIR OF A PORTION OF LAT 38, DRY CREEK SEWER, S. S. #12 BETWEEN ELPYCO AND BLECKLEY ON THE NORTH SIDE OF ORME
CITY OF WICHITA, KANSAS
R.W. BRUGGEMAN
DIRECTOR OF ENGINEERING / CITY ENGINEER
PROJ. NO. 468-76-245-81080-000-000-001

FILMED FROM THE BEST