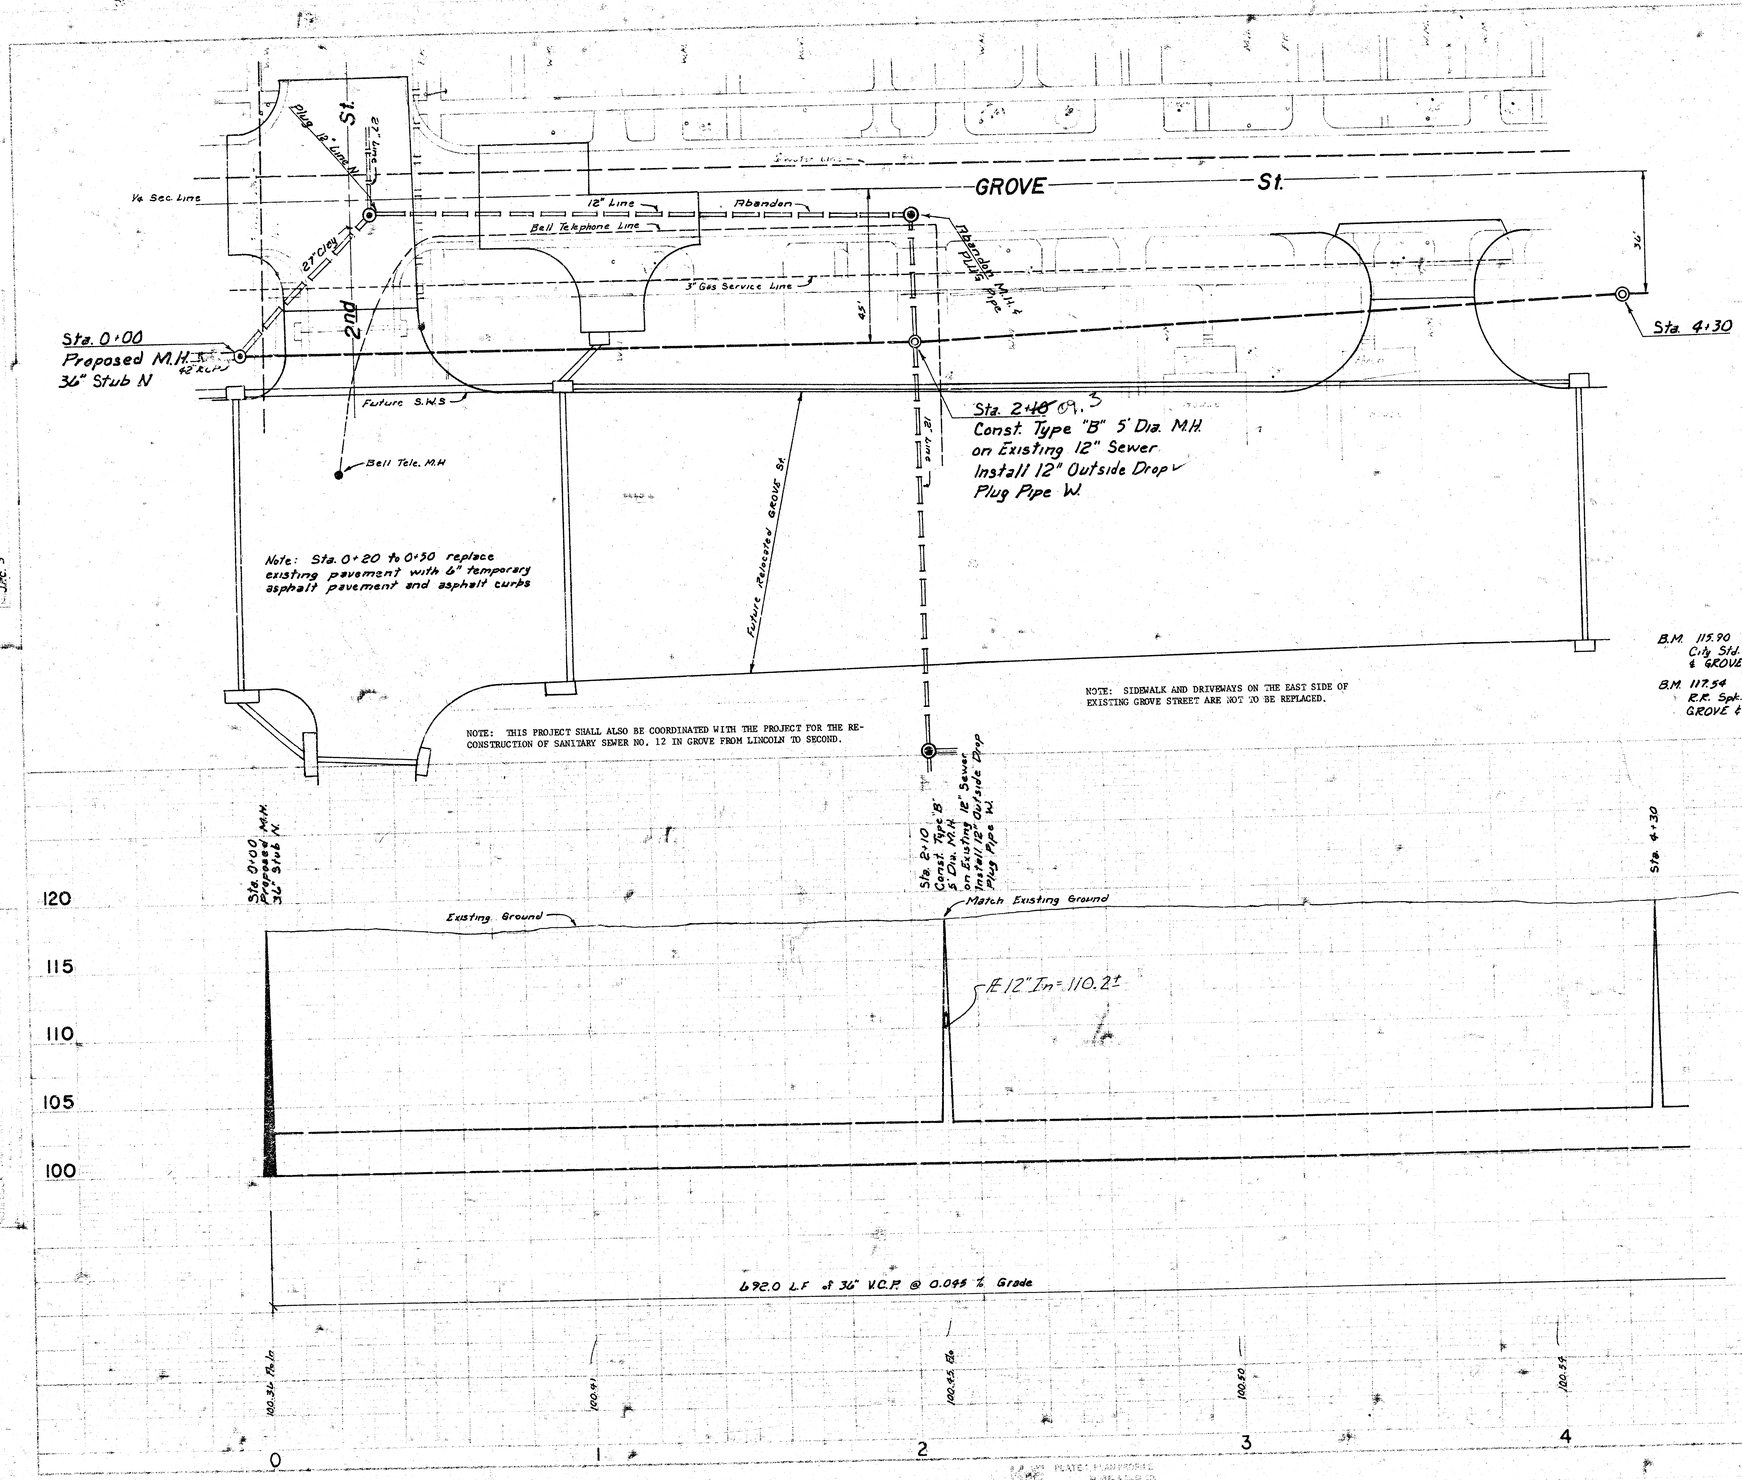

GENERAL NOTE

RIGHT-OF-WAY MUST BE ACQUIRED FOR THIS PROJECT BEFORE CONSTRUCTION CAN BEGIN. THE CITY OF WICHITA ANTICIPATES THAT ALL RIGHT-OF-WAY NECESSARY TO FACILITATE CONSTRUCTION OF THIS PROJECT WILL BE ACQUIRED BY MARCH 15, 1979. CONTRACTORS BIDDING THIS PROJECT SHOULD ANTICIPATE THAT CONSTRUCTION OF THIS PROJECT WILL NOT BE ABLE TO BEGIN UNTIL SOMETIME IN MARCH OF 1979.

ALL BUILDINGS AND IMPROVEMENTS LOCATED IN THE PROPOSED RIGHT-OF-WAY FOR THIS PROJECT SHALL BE CLEARED AND REMOVED FROM THE PROJECT AREA PRIOR TO THE CONSTRUCTION OF THE SEWER. THE CONTRACTOR SHALL SIDE OF EXISTING GROVE STREET SHALL BE CLEARED AND REMOVED FROM THE PROJECT AREA TO FACILITATE CONSTRUCTION OF THIS PROJECT. THE CONTRACTOR SHALL BE RESPONSIBLE FOR THE REMOVAL AND REPLACEMENT OF ANY FENCES, THOSE TREES, HEDGES, AND SHRUBS WHICH ARE ESTABLISHED AS LANDSCAPING ON THE PROPERTY ADJACENT TO THE RIGHT-OF-WAY. THE CONTRACTOR SHALL BE RESPONSIBLE FOR OBTAINING ANY PERMITS NECESSARY TO REMOVING ANY TREES, HEDGES, OR SHRUBS. THE CONTRACTOR SHALL OBTAIN THE ENGINEER'S APPROVAL PRIOR TO REMOVING ANY TREES, HEDGES, OR SHRUBS. TREES, HEDGES, AND SHRUBS WHICH ARE NOT REMOVED BY THE CONTRACTOR SHALL BE PROTECTED FROM DAMAGE. THIS WORK WILL BE PAID FOR AT THE LUMP SUM PRICE BID FOR CLEARING RIGHT-OF-WAY.

CONSTRUCTION OF THIS PROJECT SHALL BE COORDINATED WITH THE CONSTRUCTION OF RELOCATED GROVE STREET. MANHOLE AT STATION 0 + 92 SHALL NOT BE CONSTRUCTED UNTIL GROVE STREET IS CLOSED AT THIS LOCATION BY PAVING CONTRACTOR.

RECONSTRUCTION of S.S. # 12
in GROVE St. from 2nd to 3rd
City of WICHITA, KANSAS
R.W. LINN - CITY ENGINEER
Date: NOV 3 1978
Project No. 468-76-245-80592-000-000-001

Sheet 1 of 3

FILMED FROM THE BEST AVAILABLE COPY

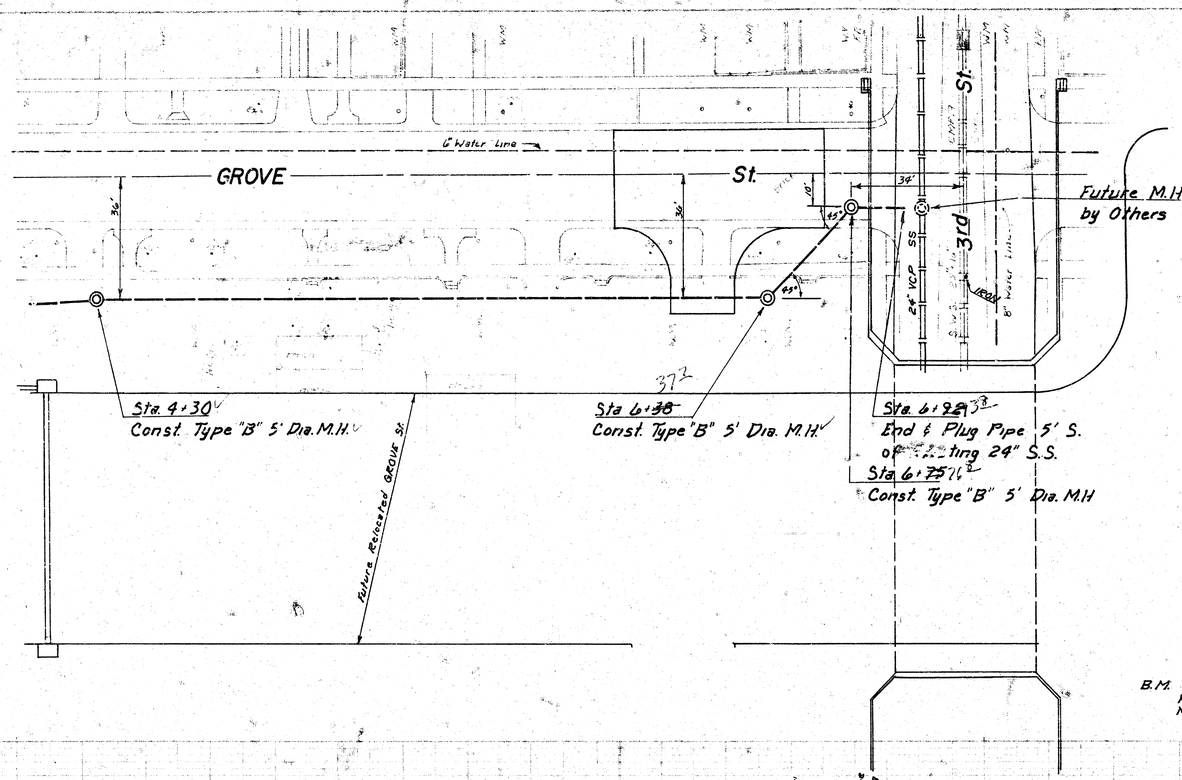

Scale:
Plan 1" = 20'
Profile
Ver. 1" = 5'
Horz. 1" = 20'

B.M. 117.39
R.R. Spike S.E. Side of P.P. on N.W. Cor. of 3rd & Grove

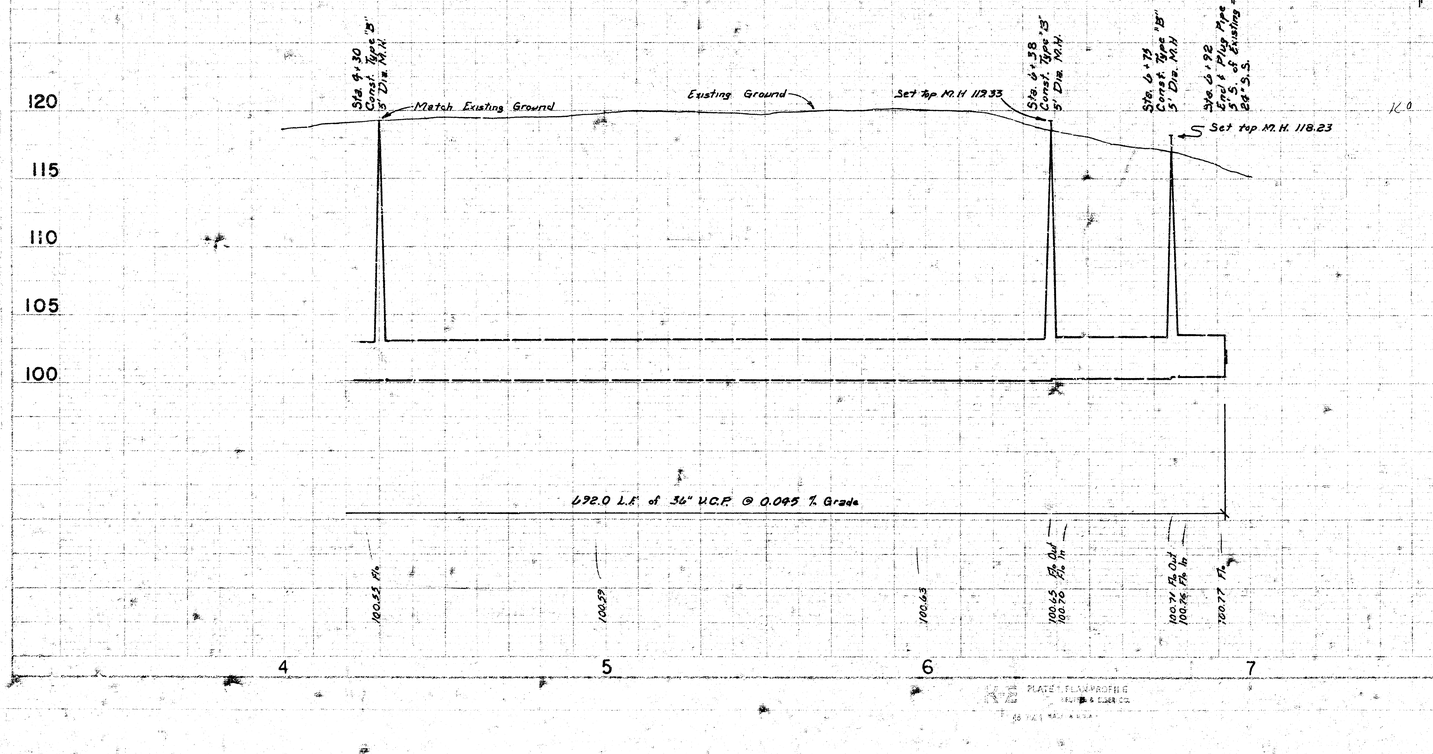

As-Built
6/81

S.S. 12 in GROVE St. from 2nd to 3rd
Project No. 468-76-245-80592-000-000-001
Sheet 2 of 3