


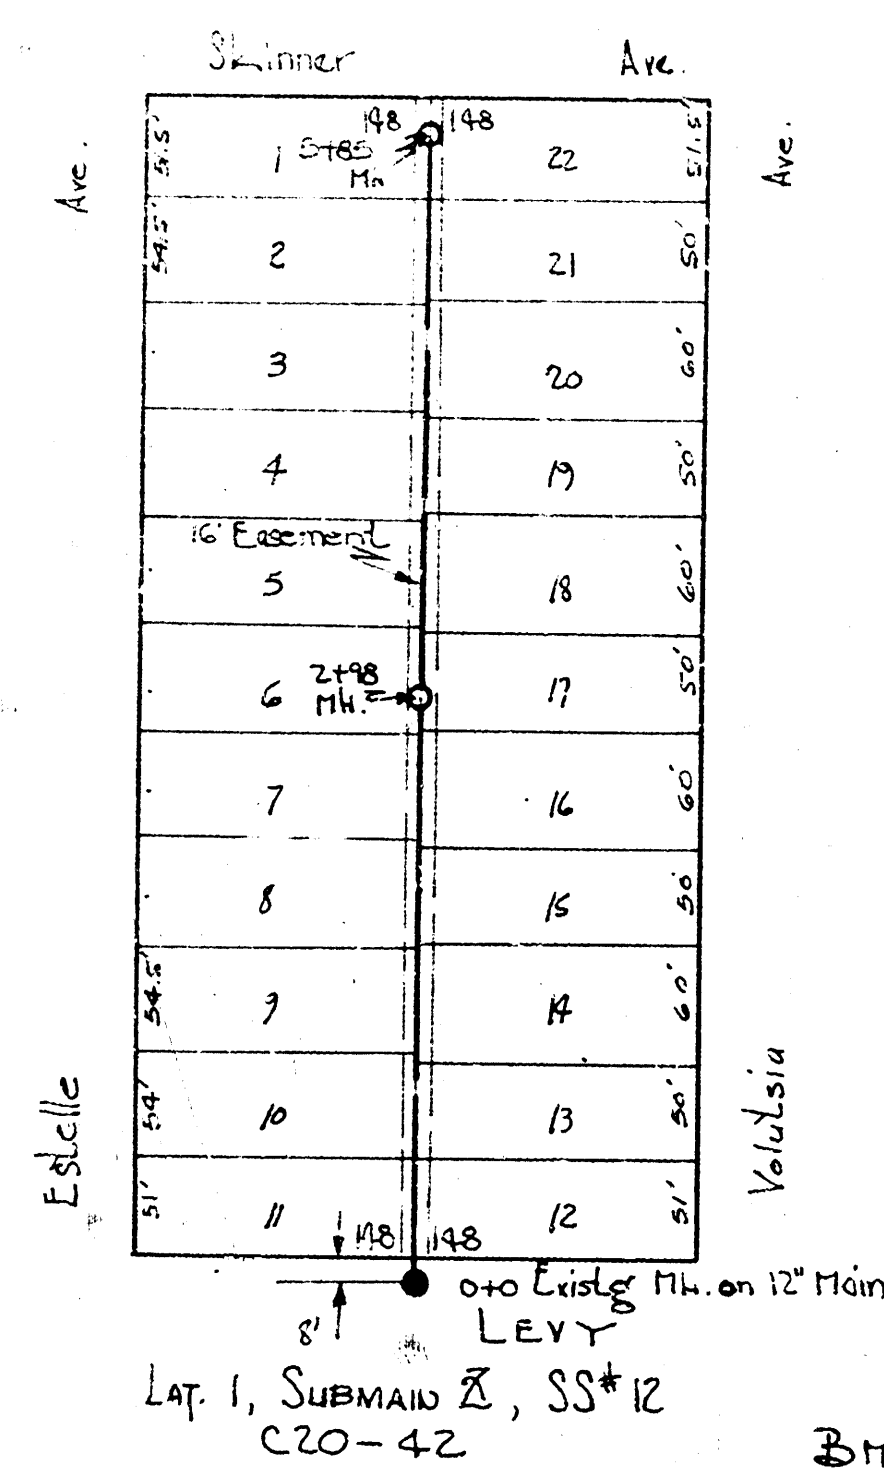
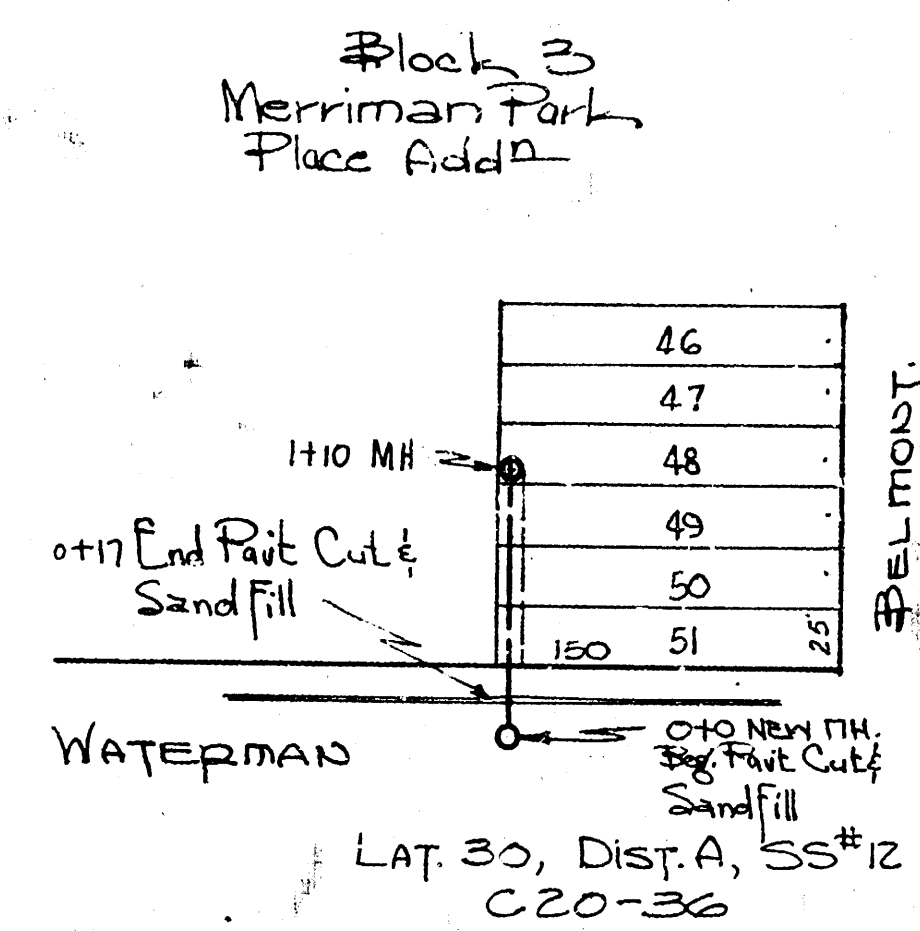
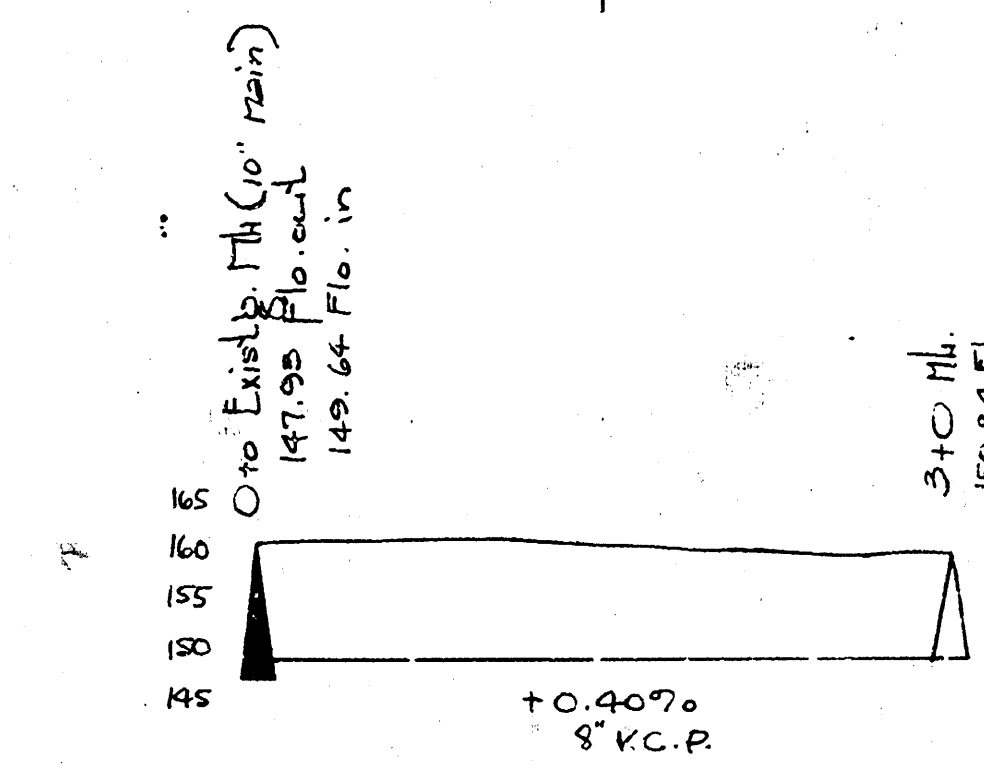


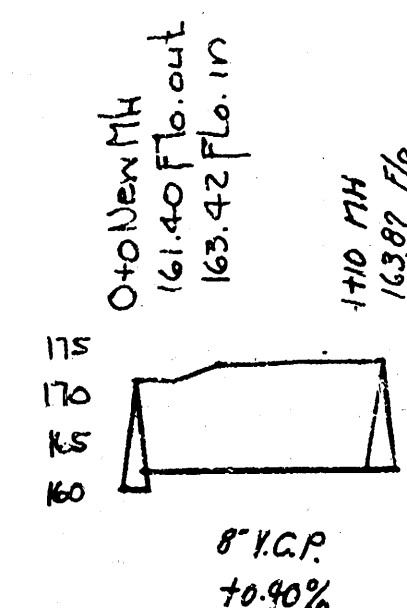

B.M. 98.59 Prop. from N.L. Levy & El. Grove
B.M. 100.76 "G" in Gable S. end E. ch. Estelle & Funston.

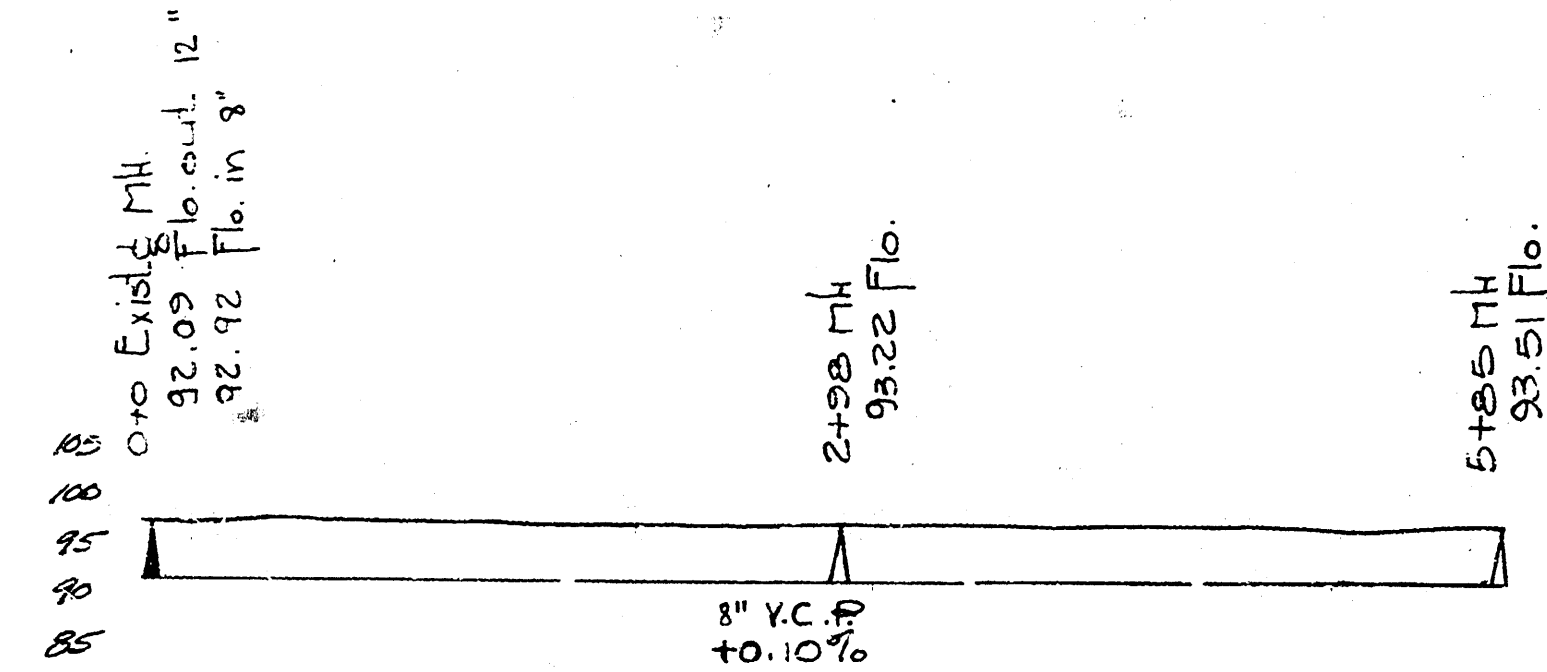

B.M. 115.43 "T" Troy T.P. NW Corner
Waterman & Belmont.

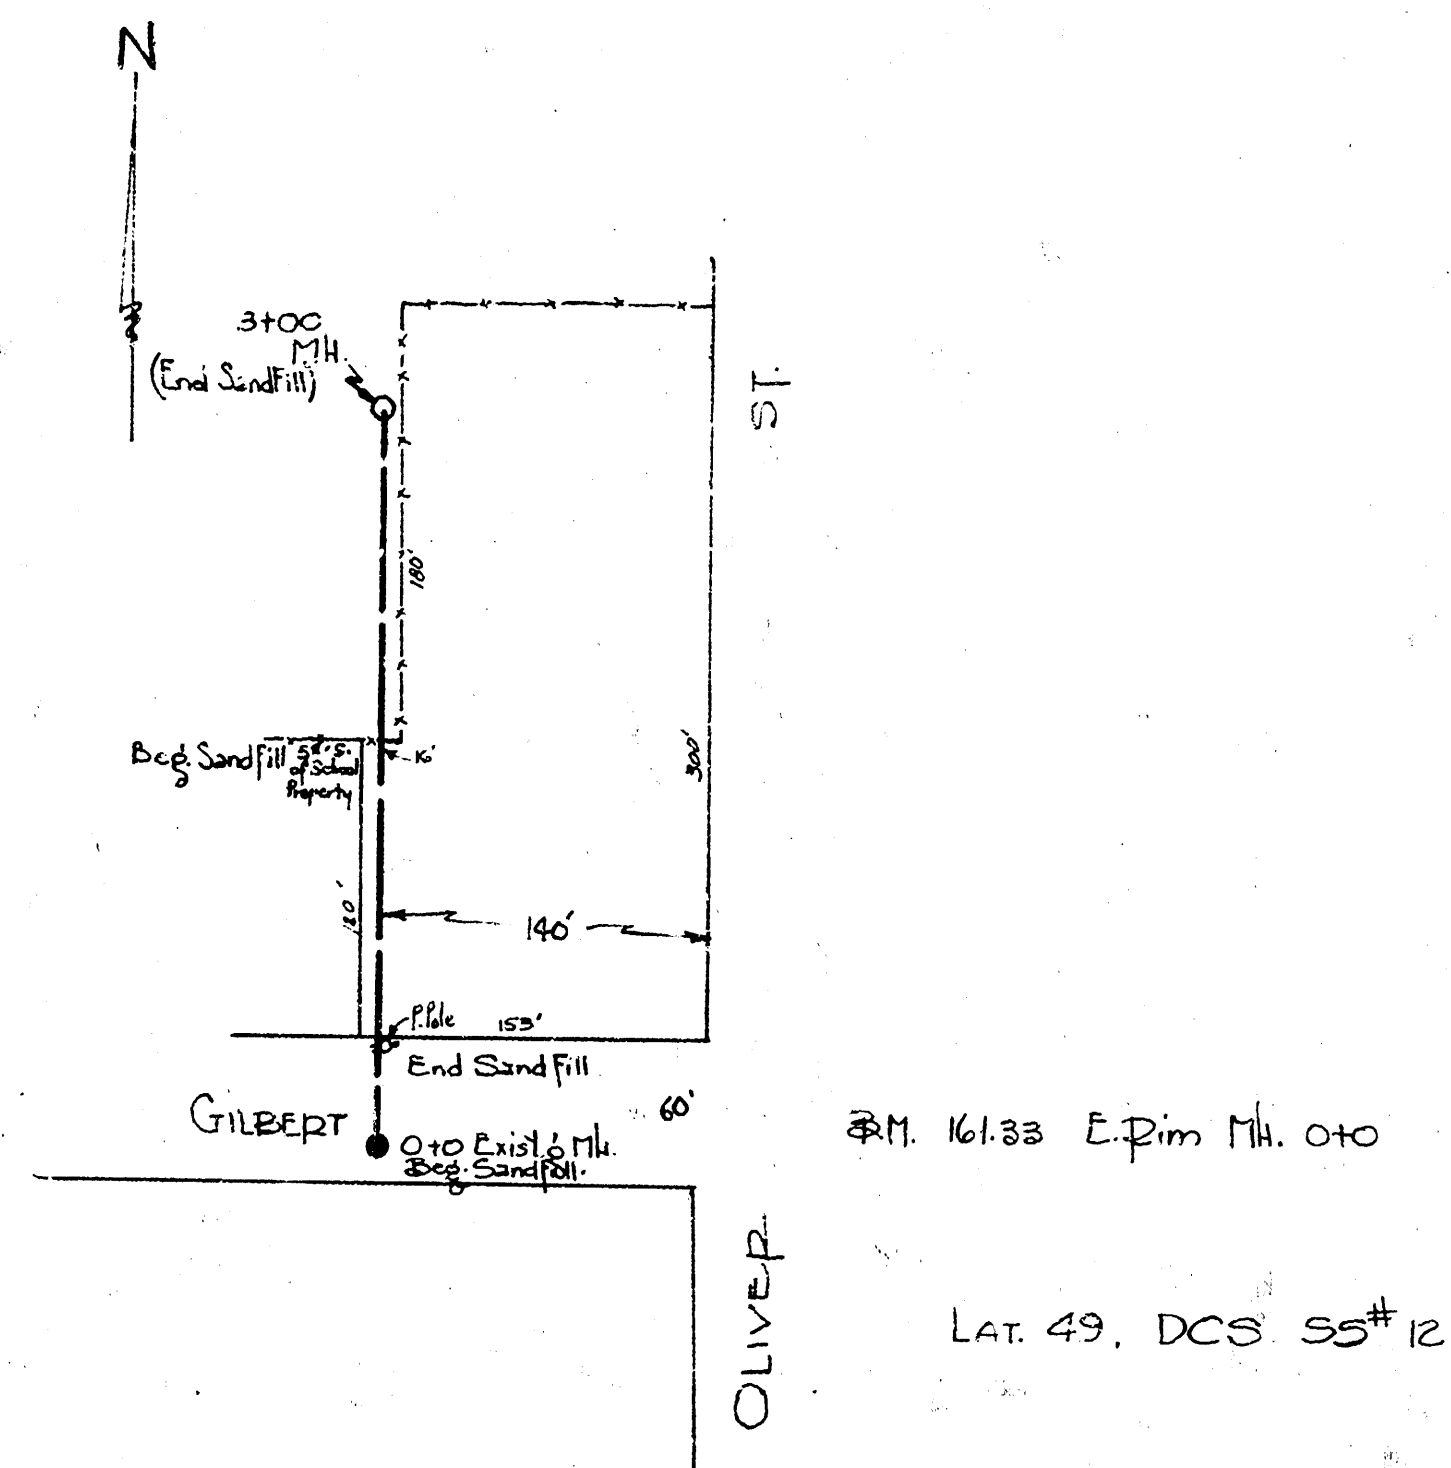

LAT. 49, D.C.S. SS#12
LAT. 30, DISTRICT A, SANITARY SEWER #12
LAT. 1, SUBMAIN Z, SANITARY SEWER #12
CITY OF WICHITA, KANSAS
L.K. White City Engineer
DATE 5-24-50 Proj. No. C20