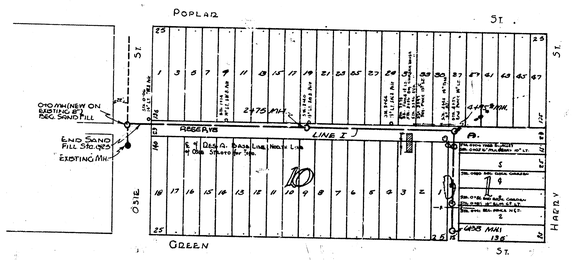

B.M. 100.97 D.R. SPIKE N.S. U.G.E. TRANSFORMER POLE N.S. OSIE. 165.9' W. OF W.L. GREEN.

CLEARANCE OF SEWER LINE
S.W.B. Poles to the Lt. 7.8' from Sewer Line,
Chicken House & Fence to the Rt. 12.5' Fence on the Lt. 7.8' from Sewer Line.

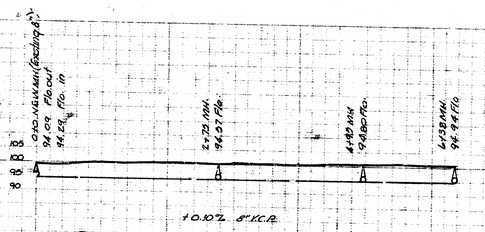

LAT. 5, DIST. A5, MAIN 12
CITY OF WICHITA, KANSAS
L.U. WHITE City Engineer
Date: March 1949 Proj. No. C28-41