

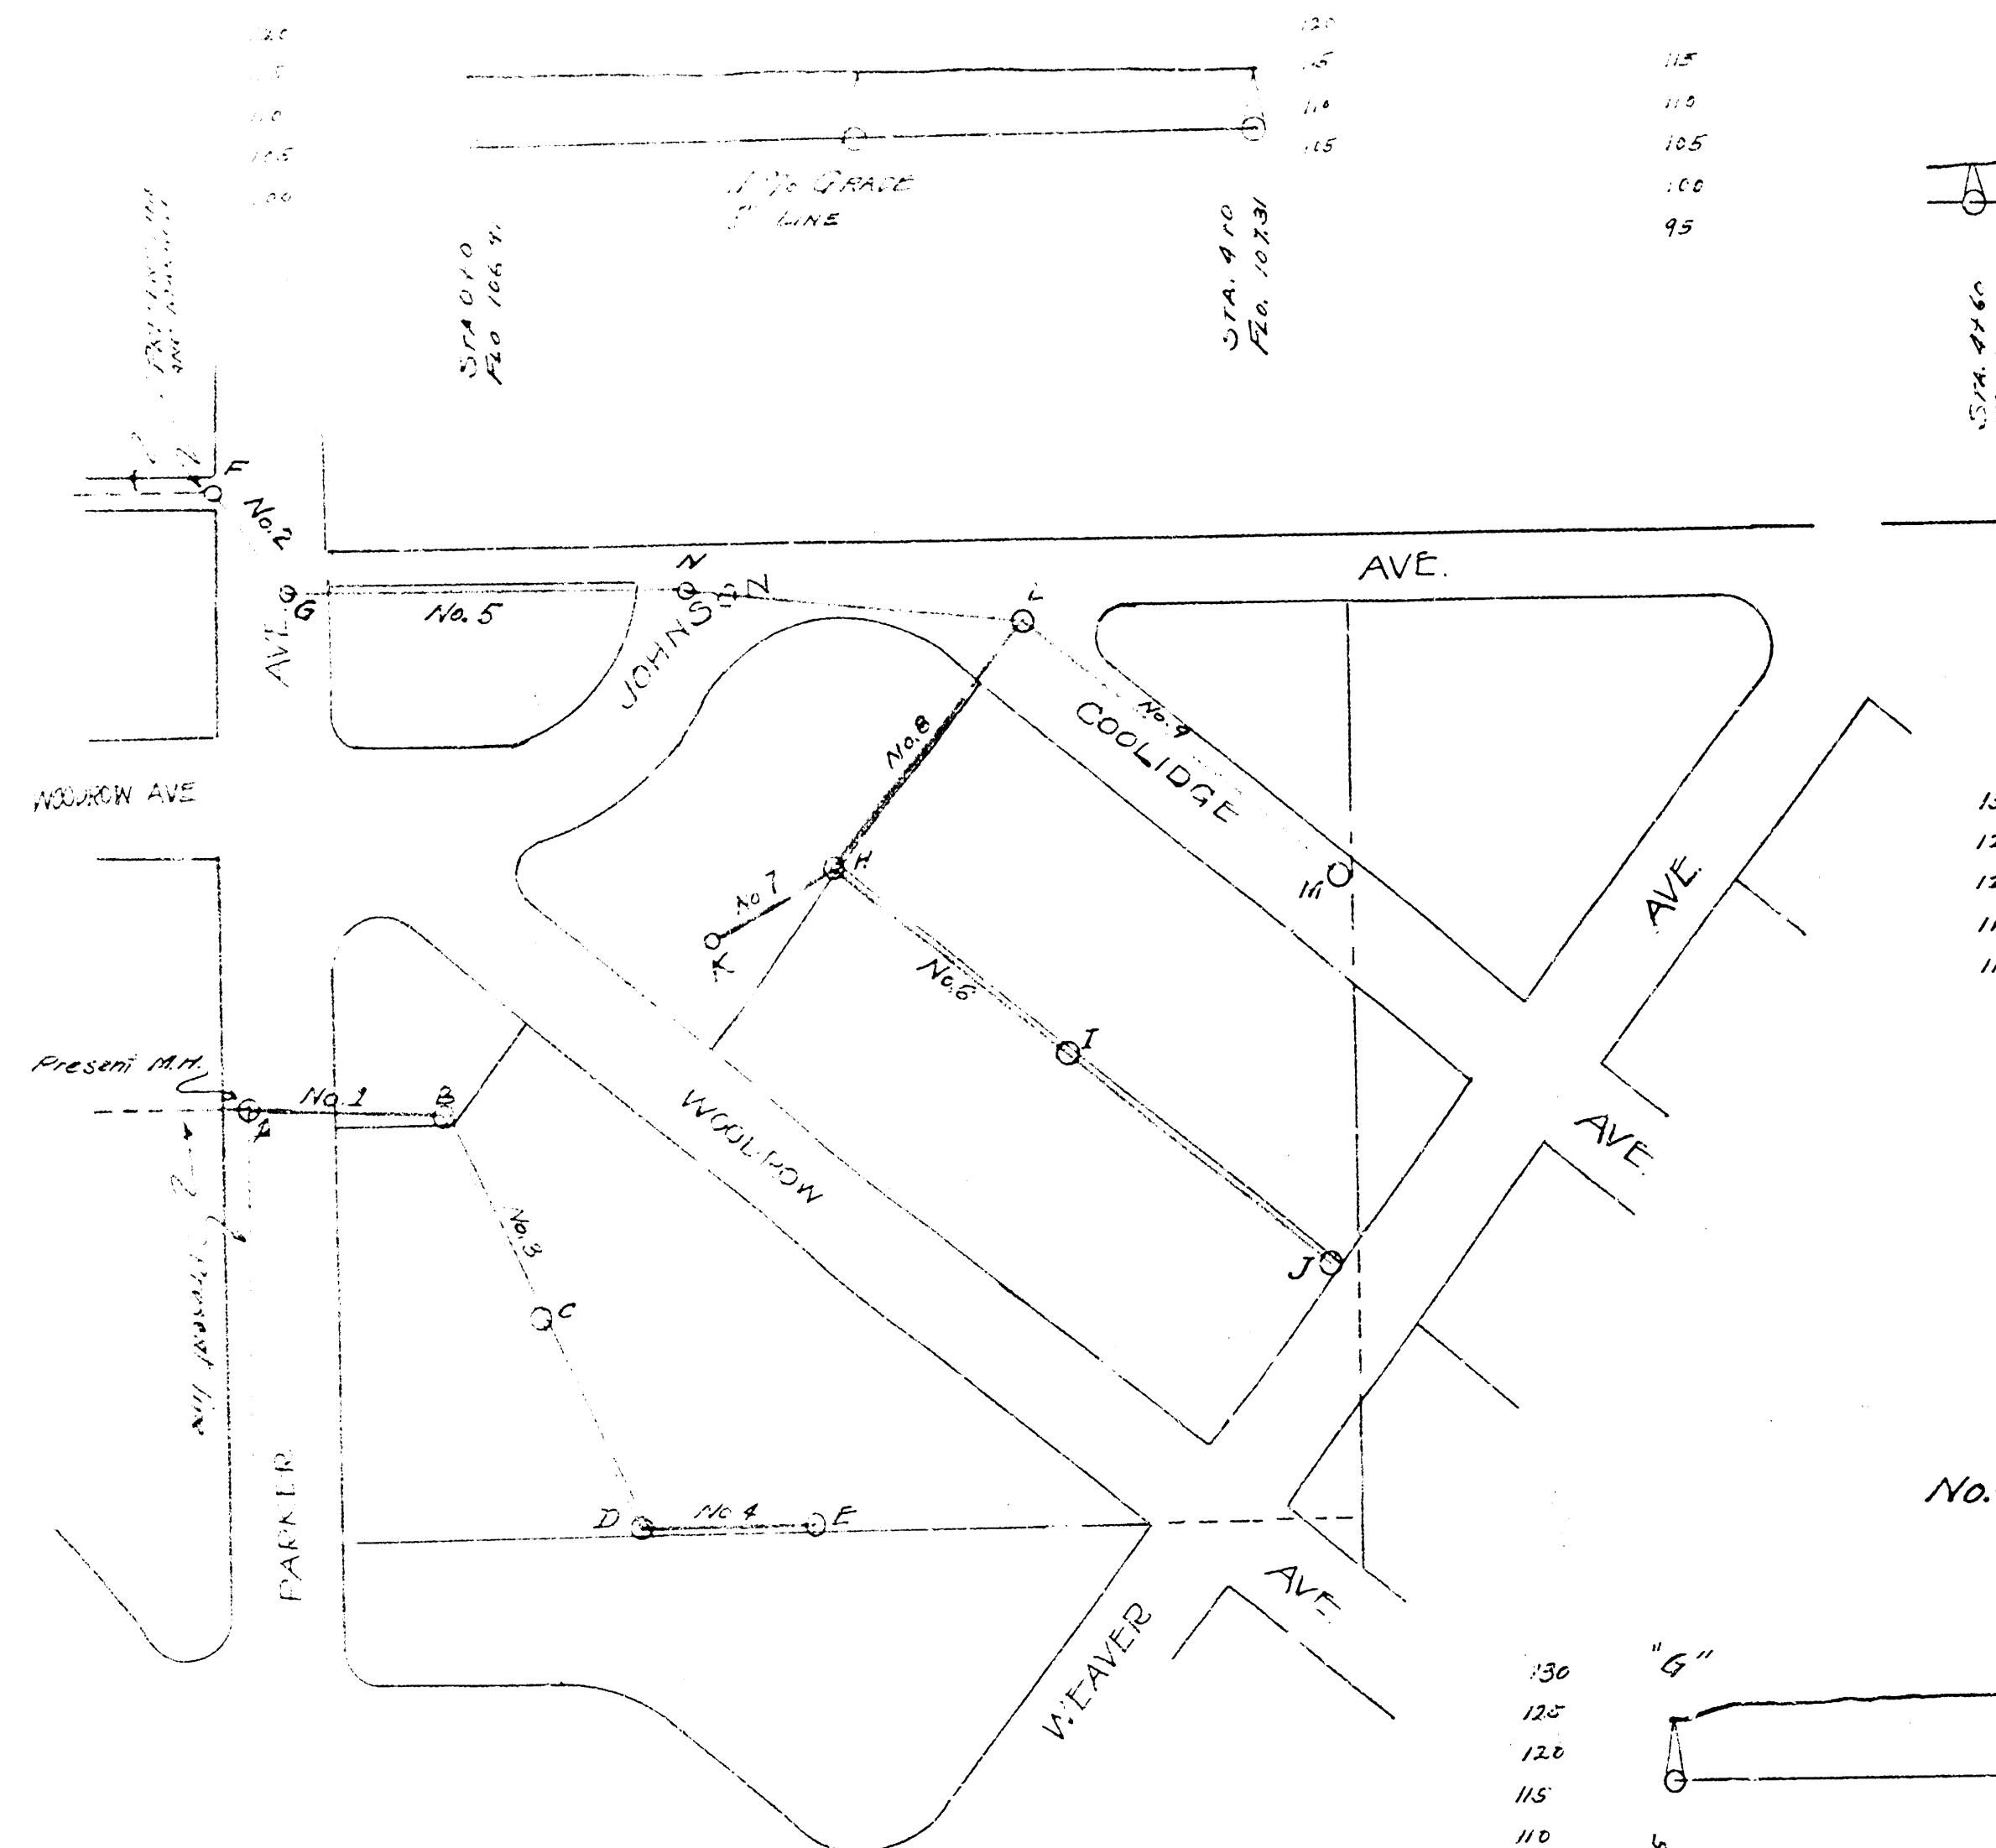
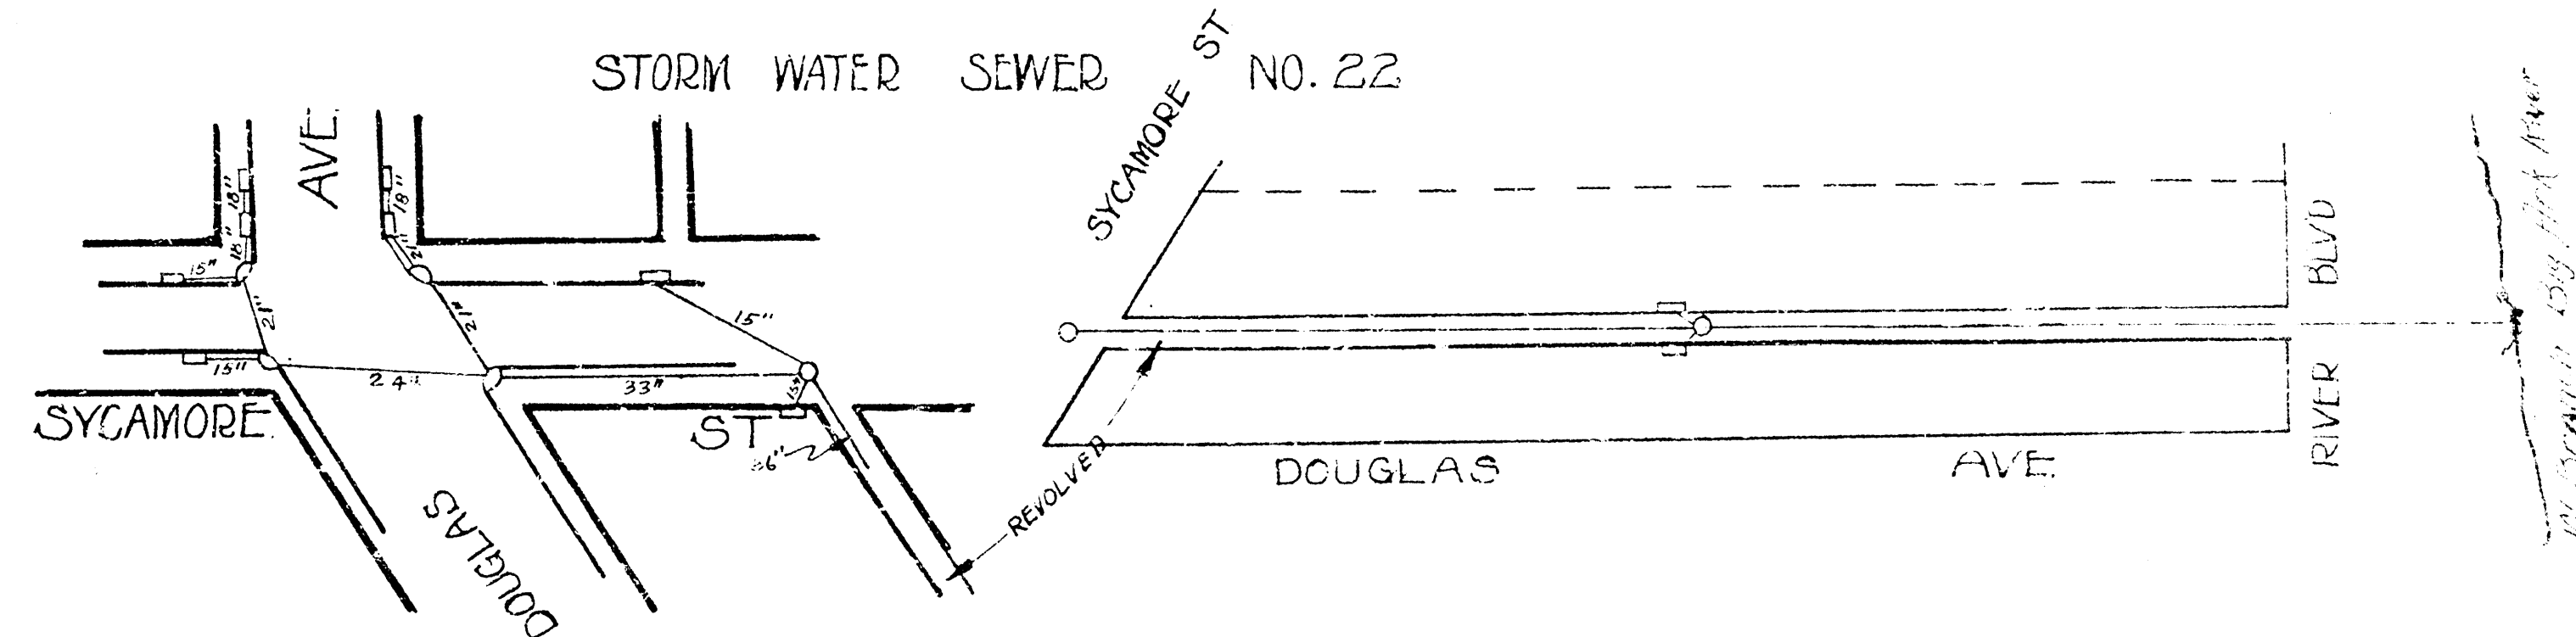
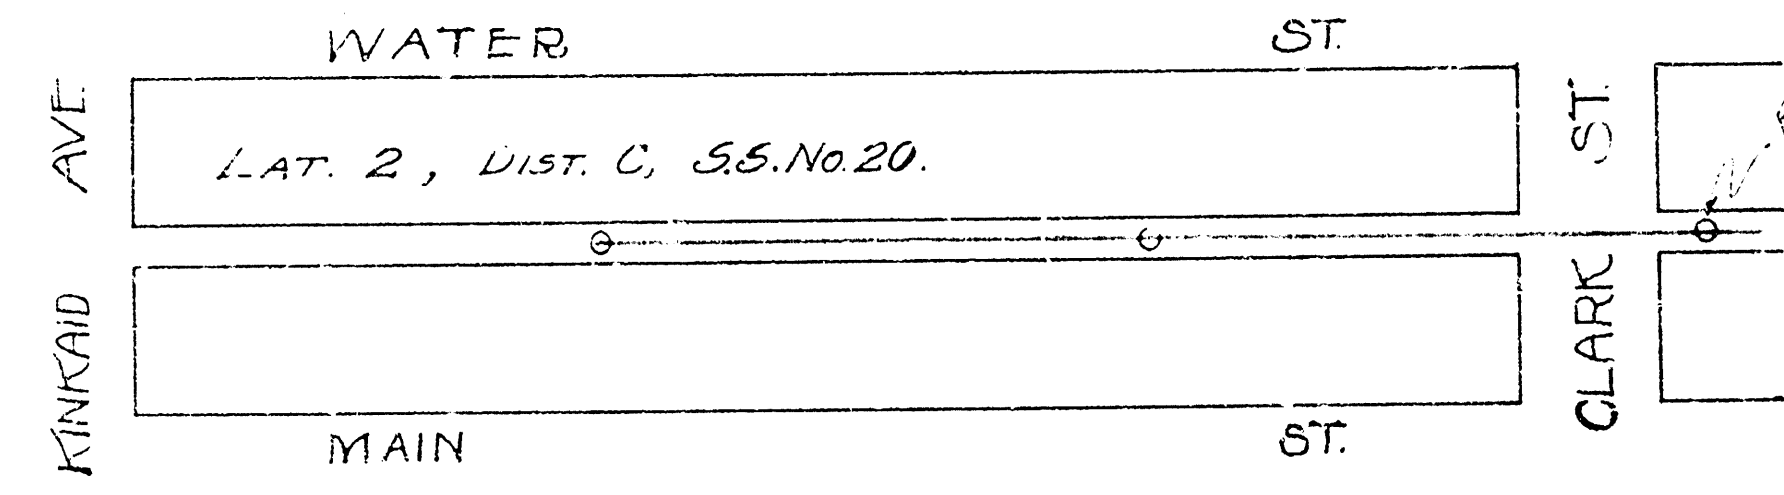
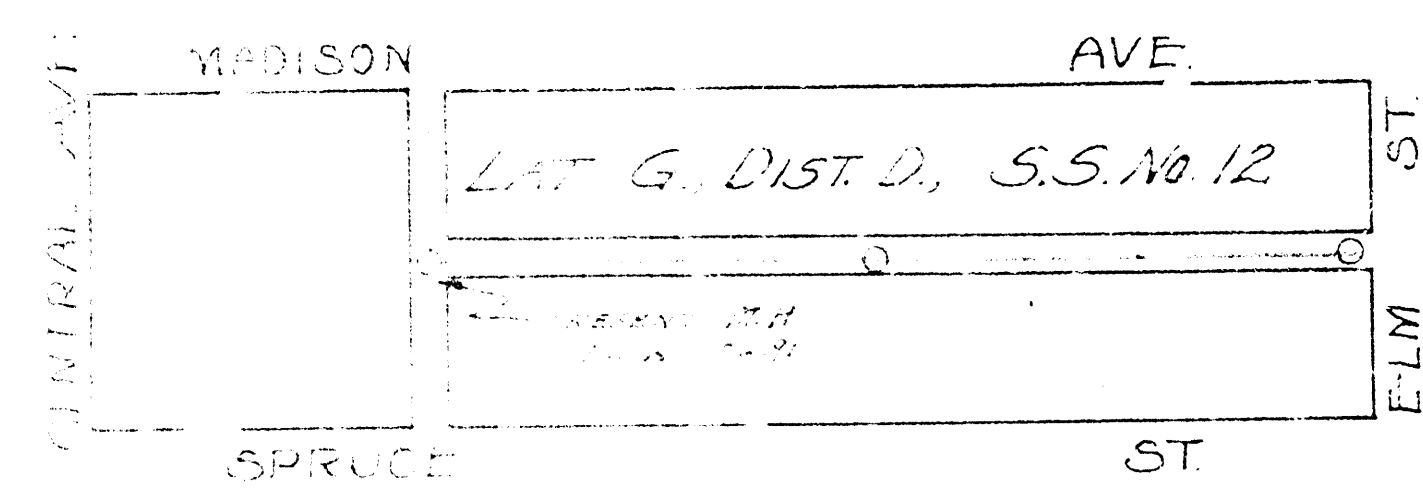
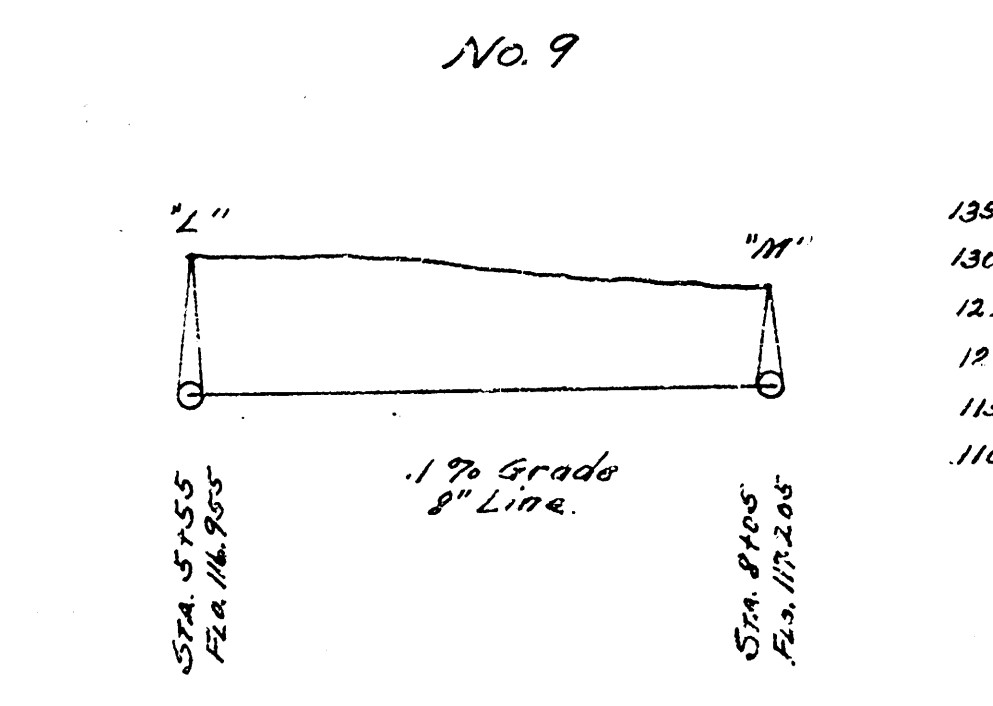
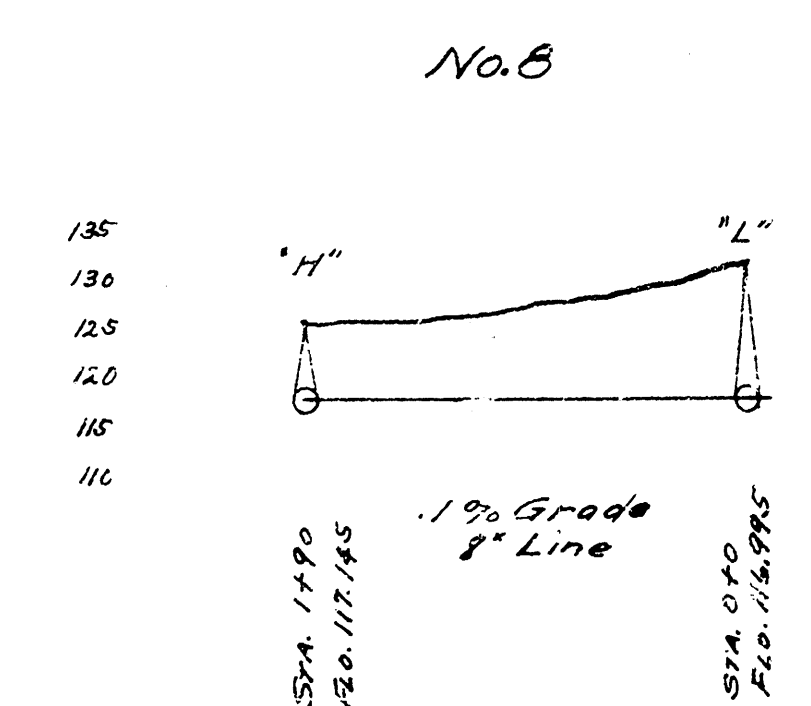
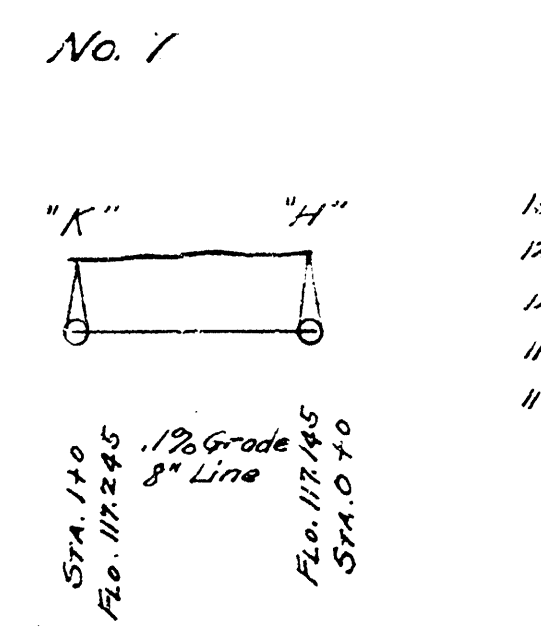
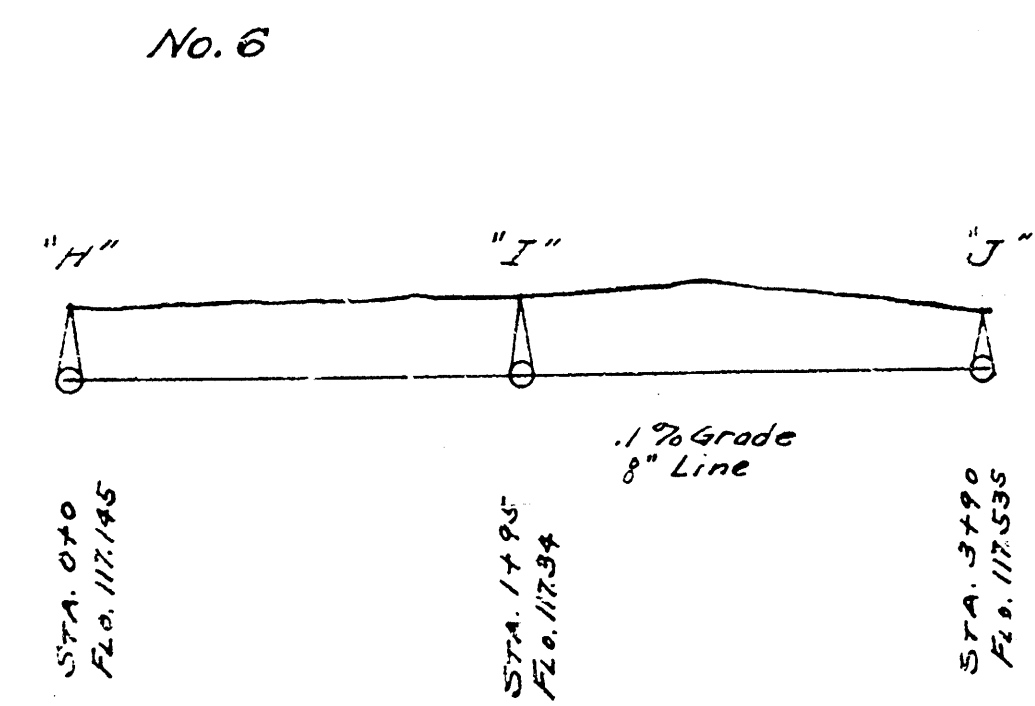
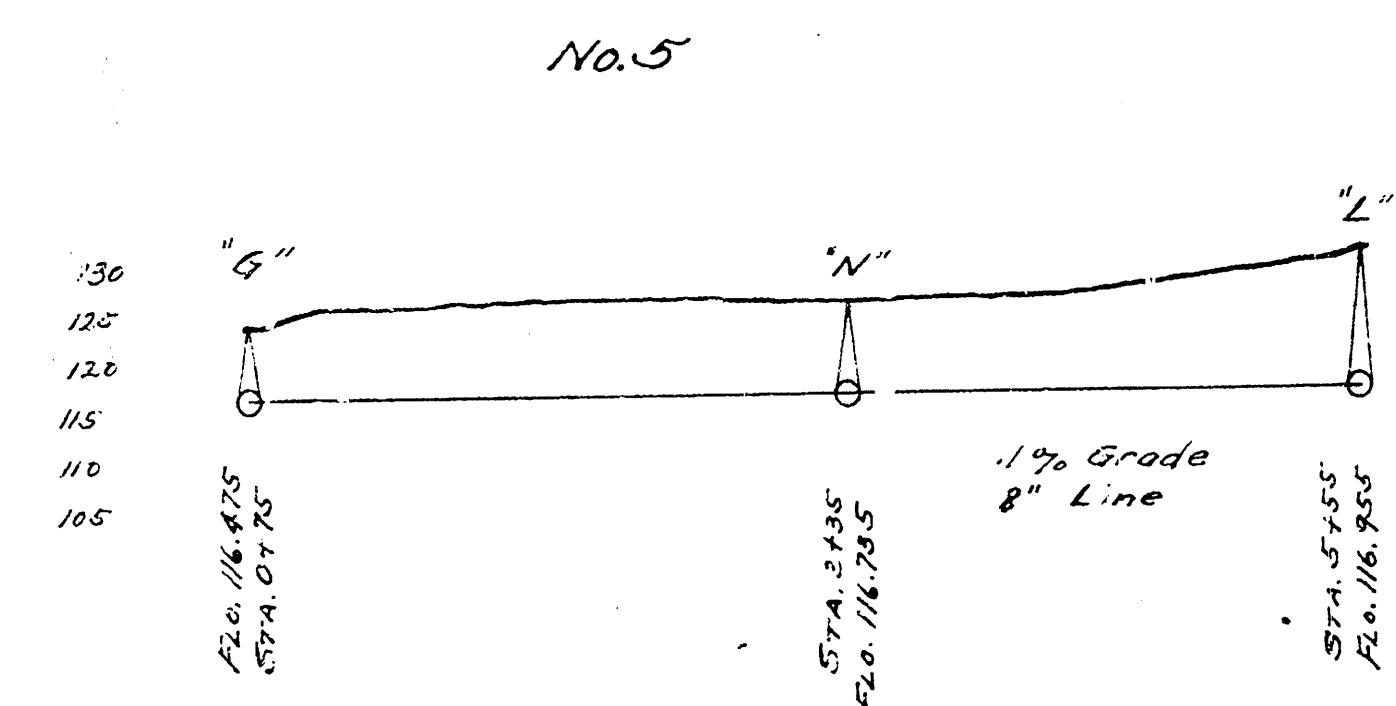
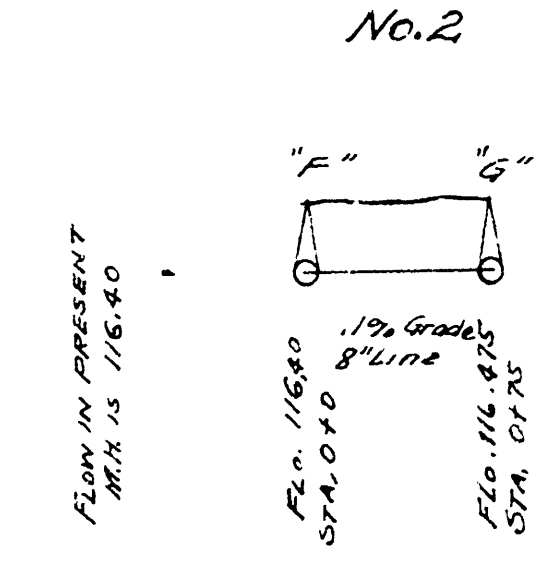
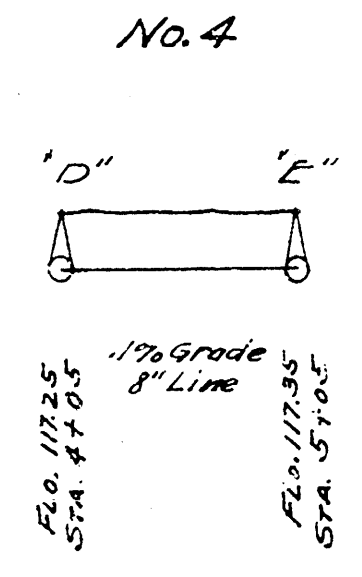
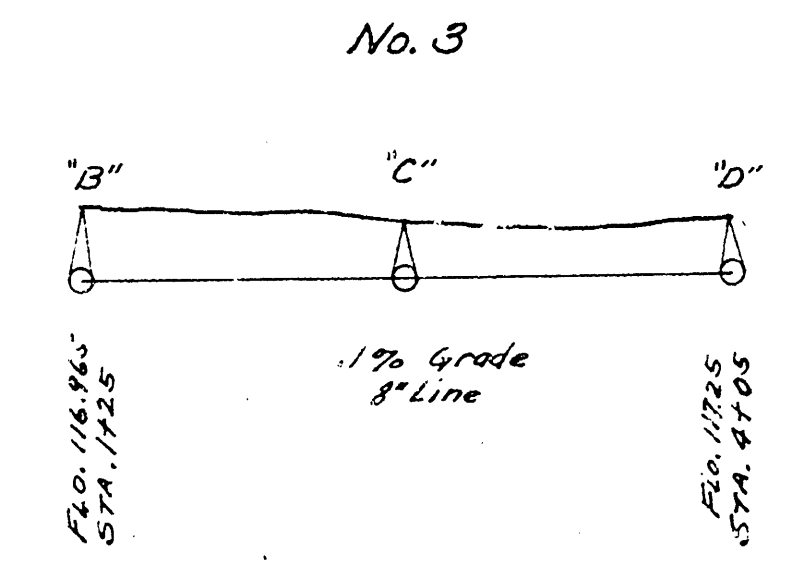
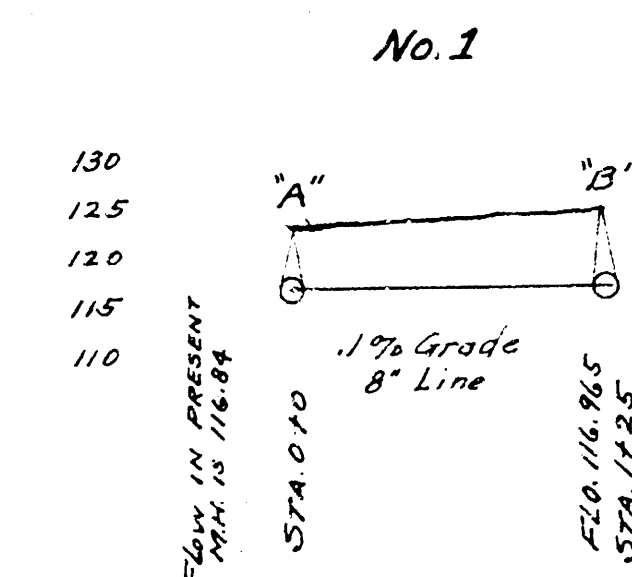
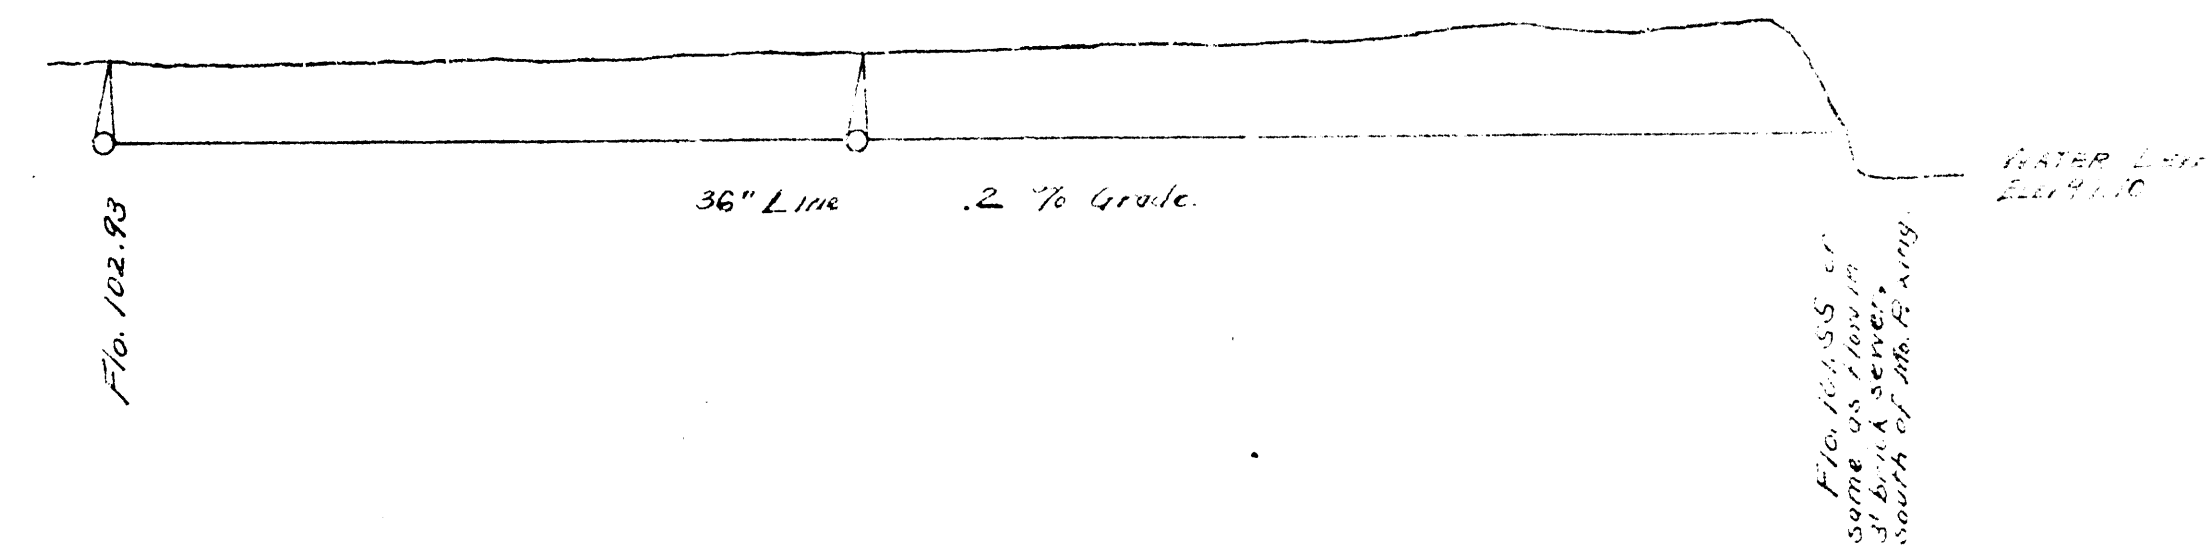


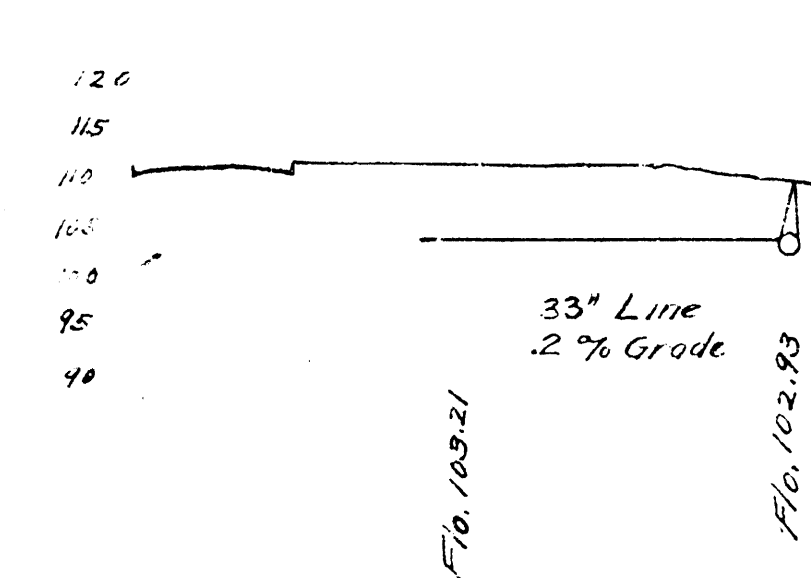

DIST.
LAT. A
S.S. No. 15

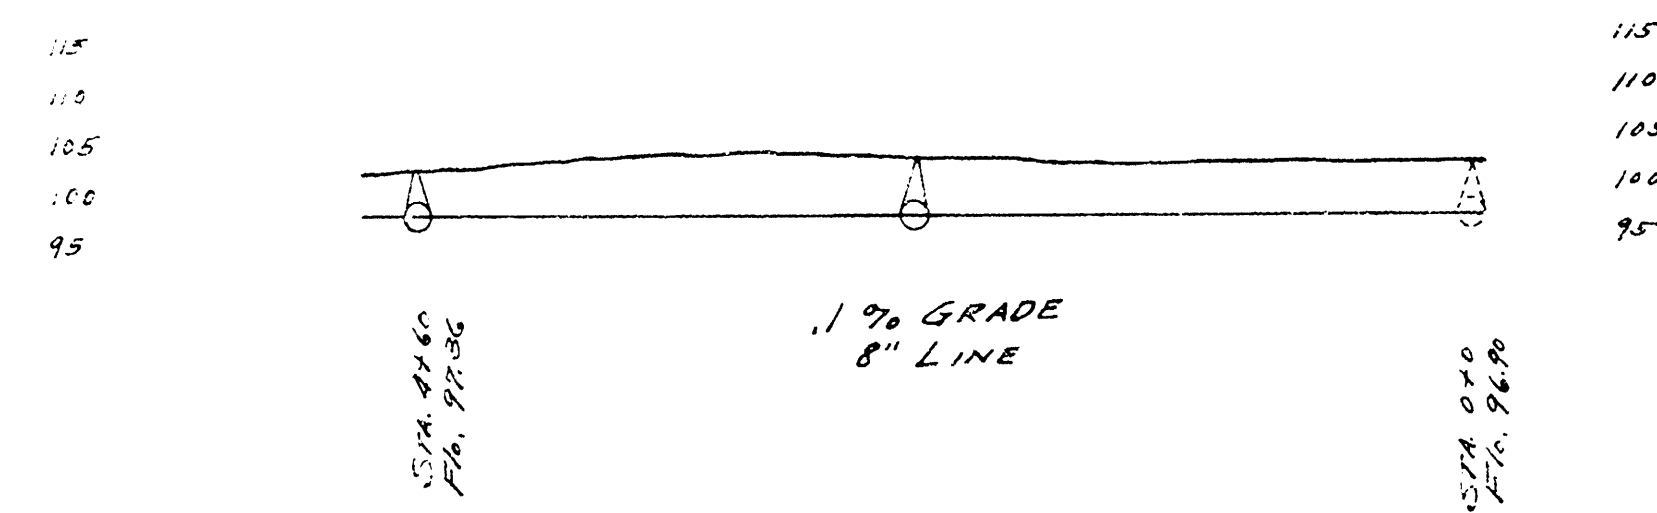

Note:
SEE PLAT AT LEFT FOR LOCATION OF
LINES AS DESIGNATED BY NUMBERS AND
MANHOLES AS DESIGNATED BY LETTERS.