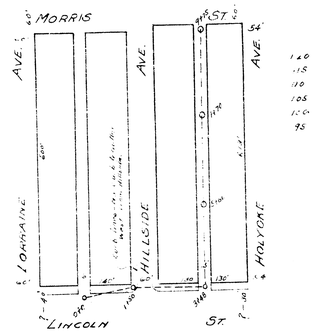

MORRIS
AVE.
1ST. ST.
AVE.
AVE.
HILLSIDE
HOLYOKE
LINCOLN
ST.
54'
40'
60'
66'
40'
60'
60'
60