
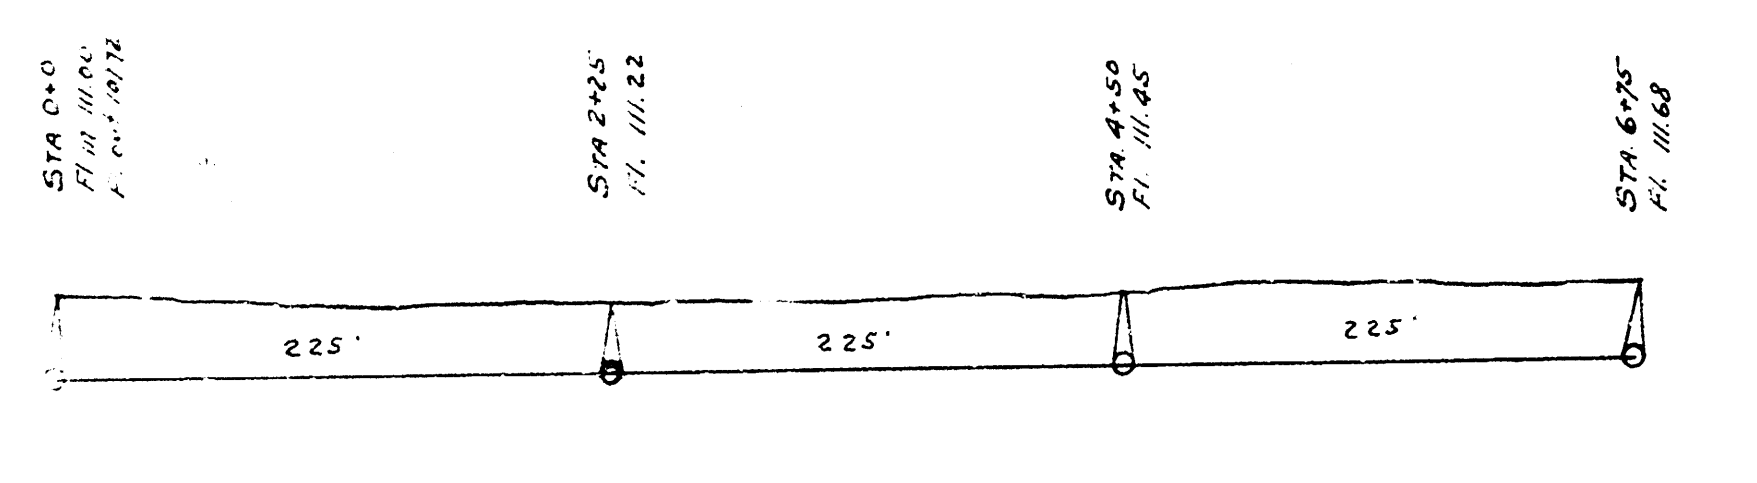
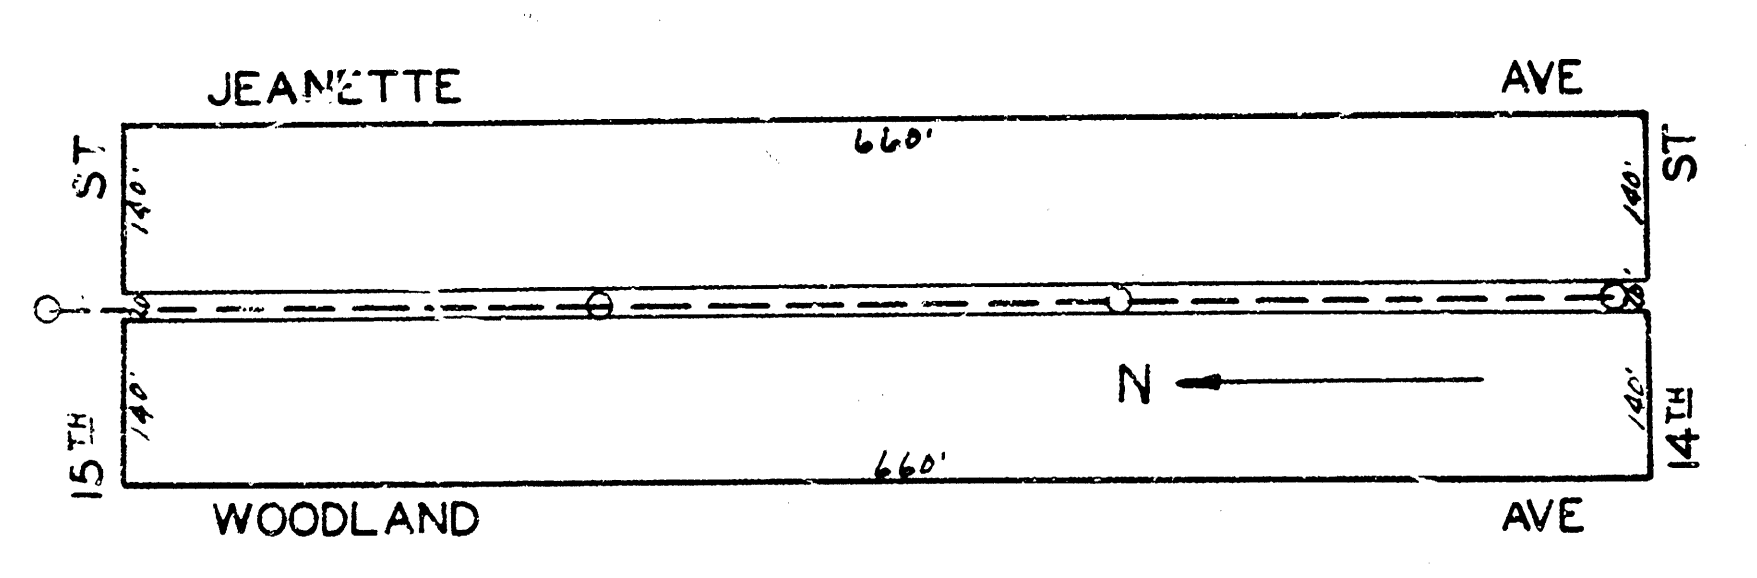
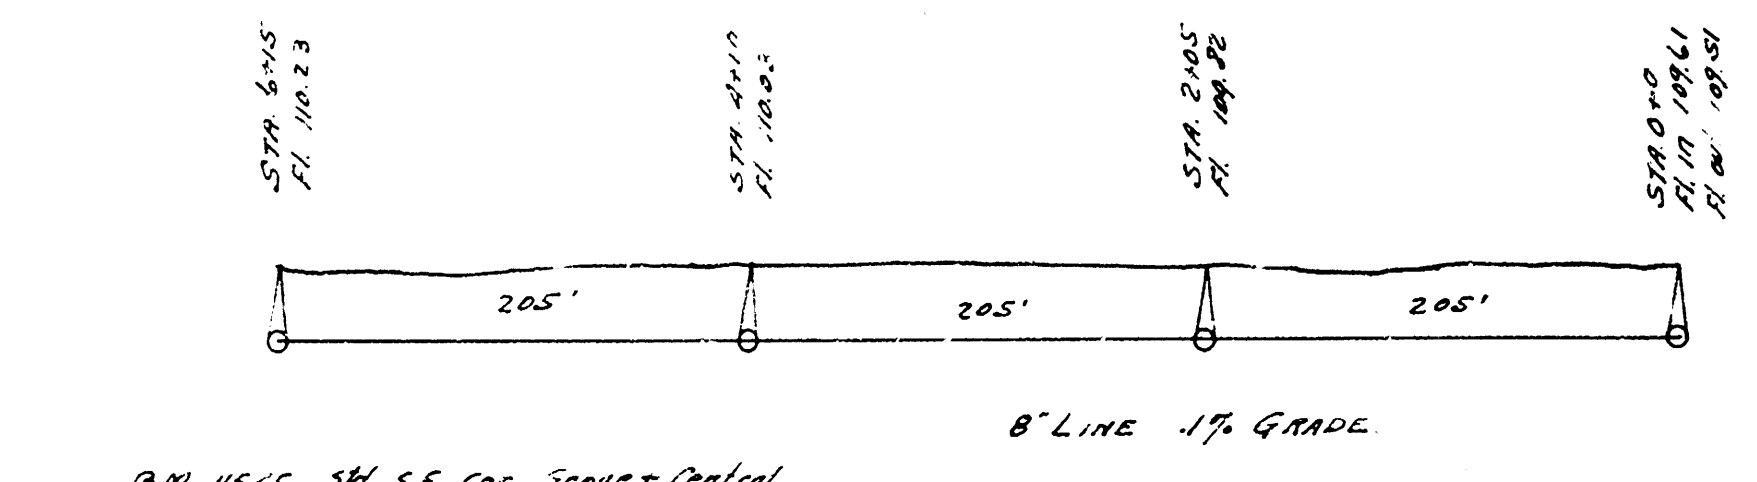
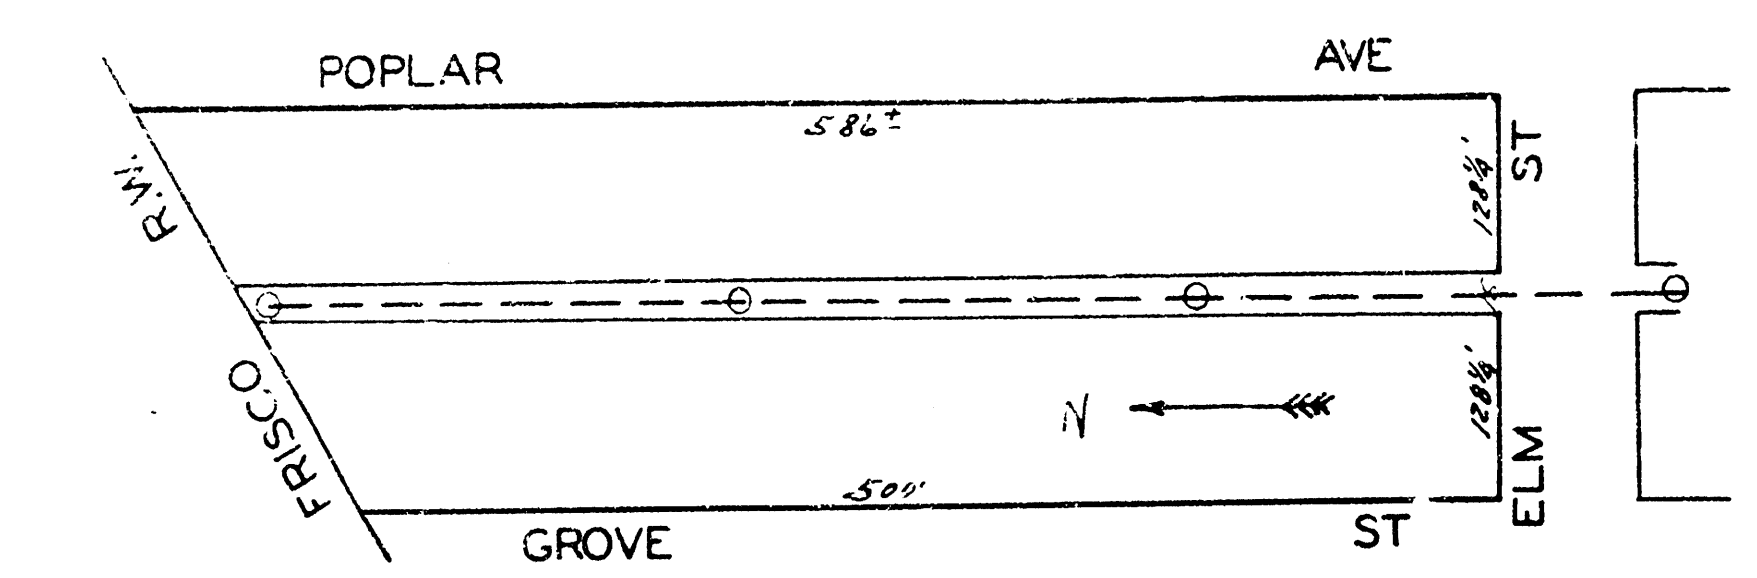
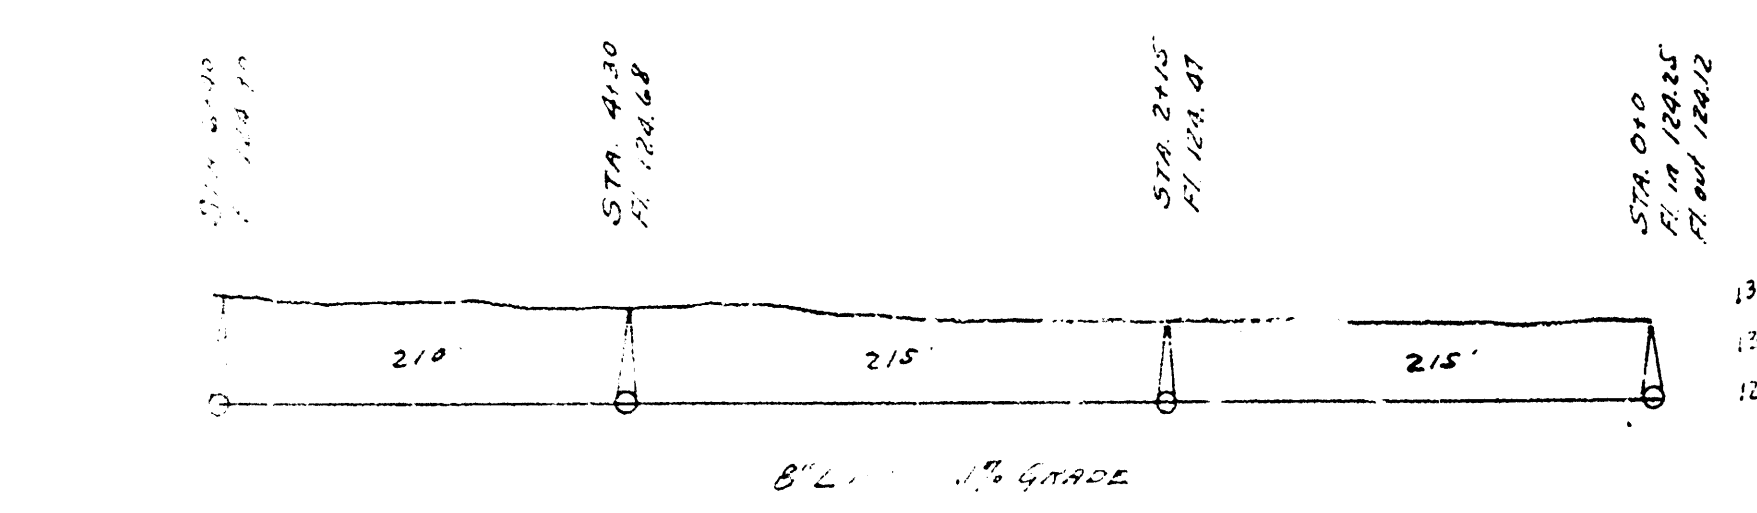








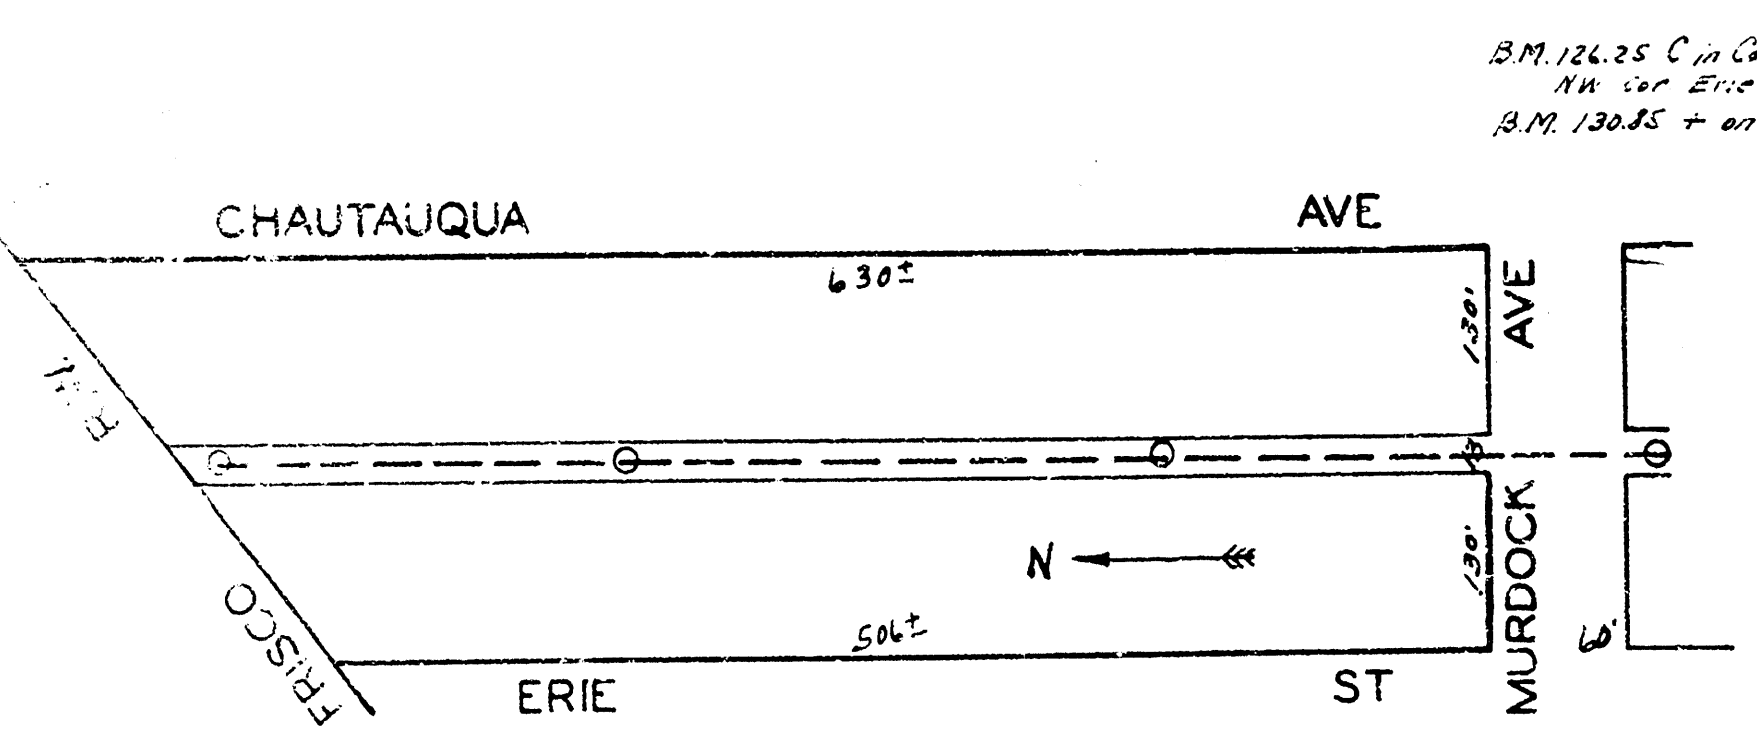


B.M. 119.40 in Kessler oak walk north 11W on Woodland = 15.46
B.M. 124.3 in Leiferer oak walk east 11E on Woodland = 14.12

B.M. 124.25 in Chapin oak approx end of prop line

LAT. 7 DIST. D, S.S. 12.

LAT. N. DIST. R, S.S. 20.

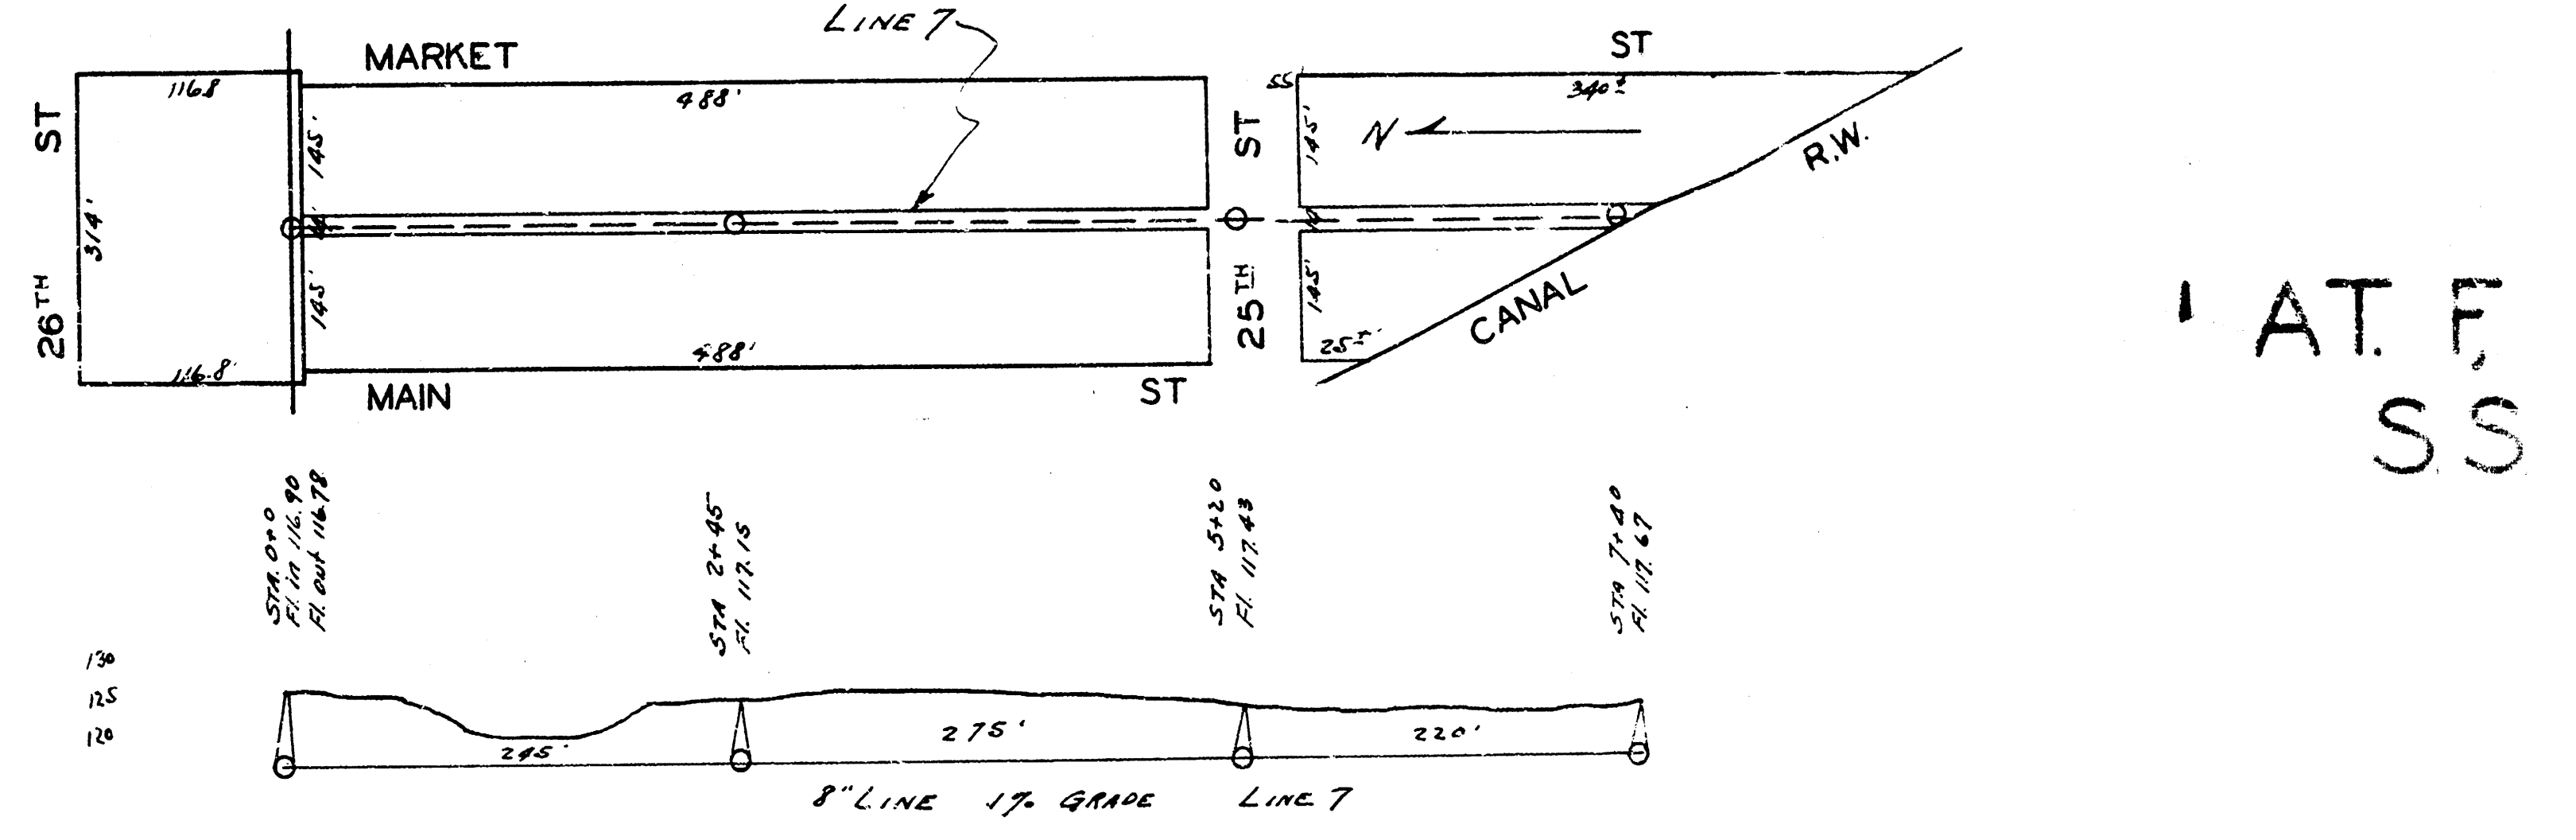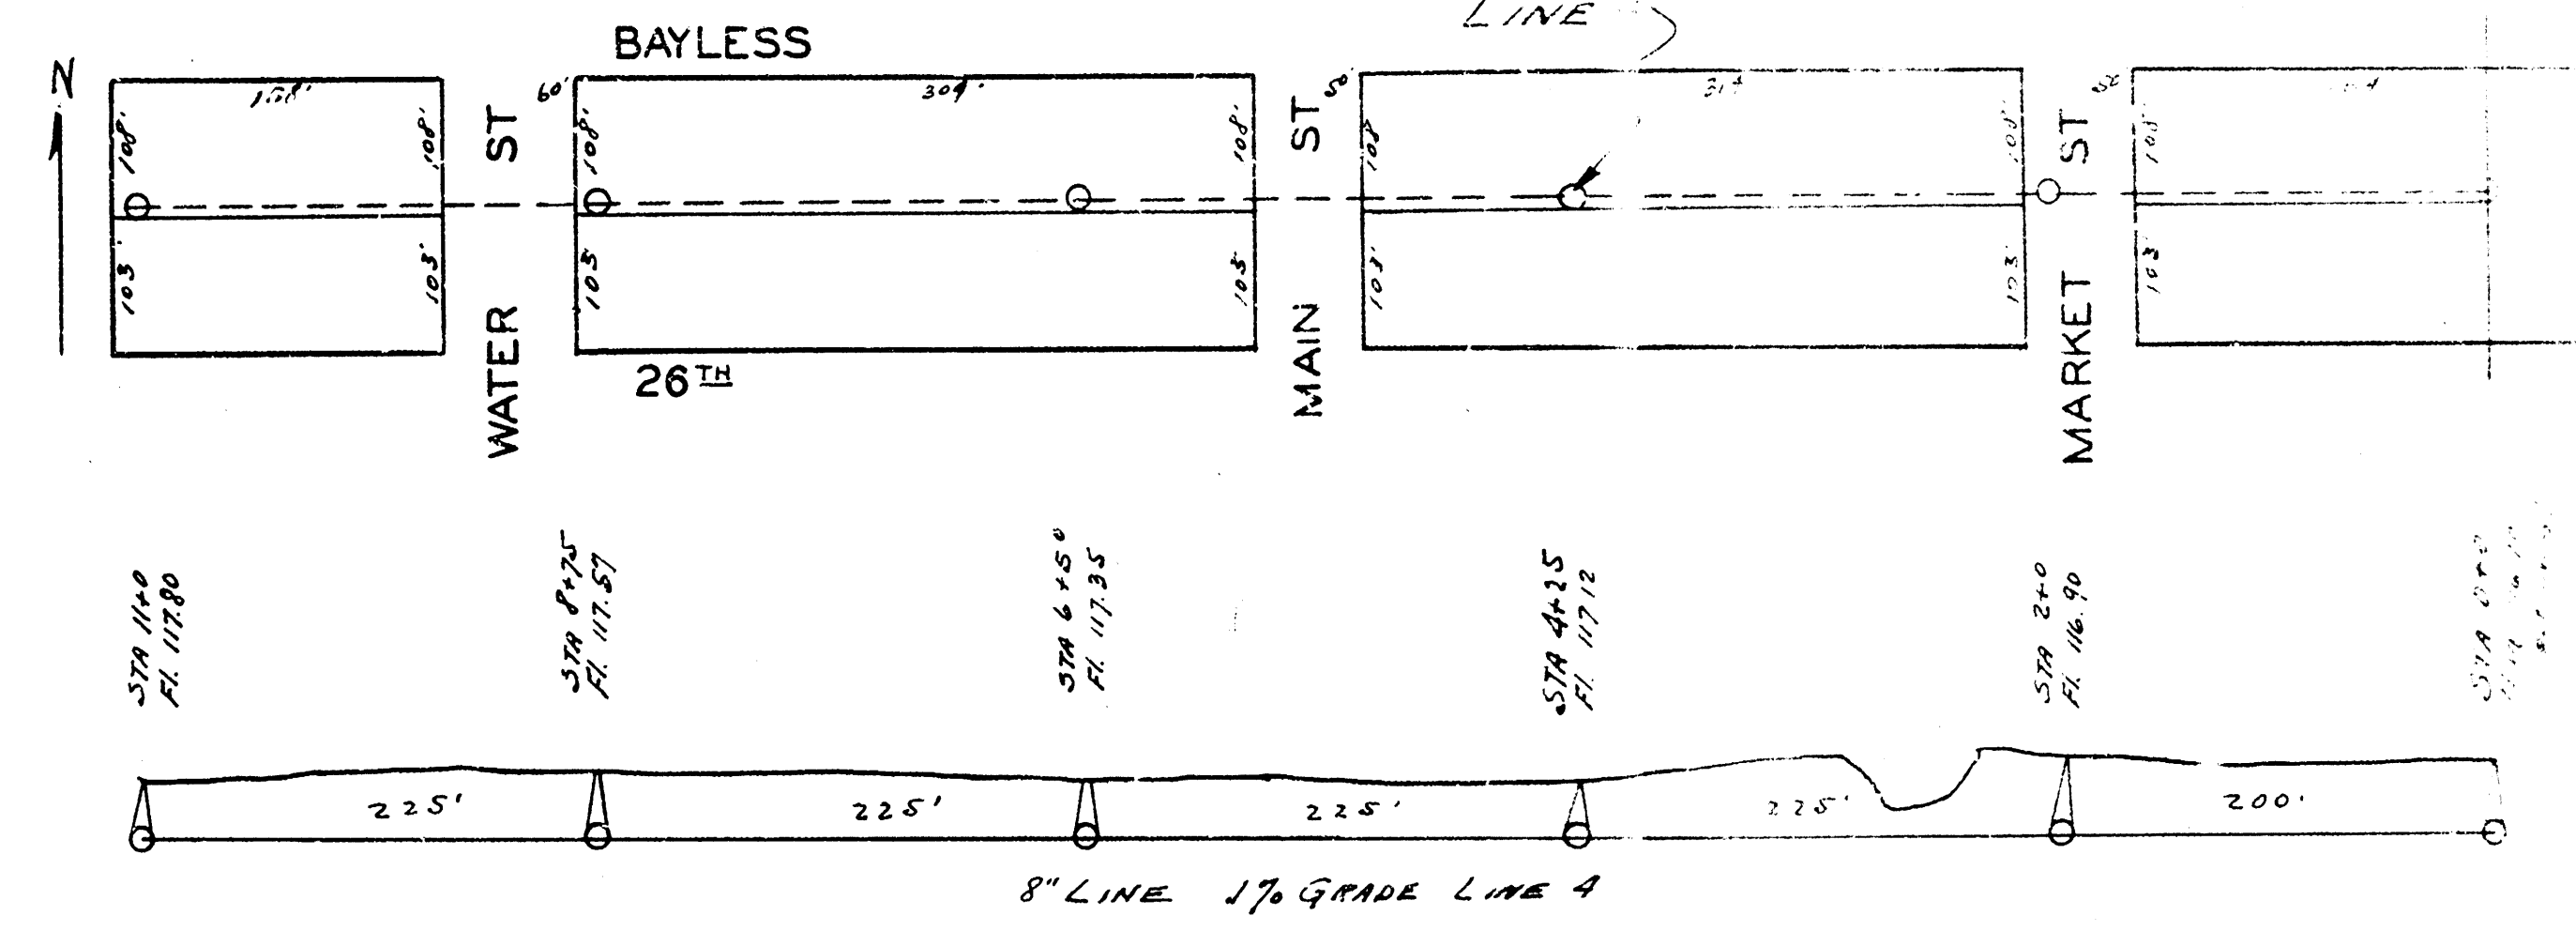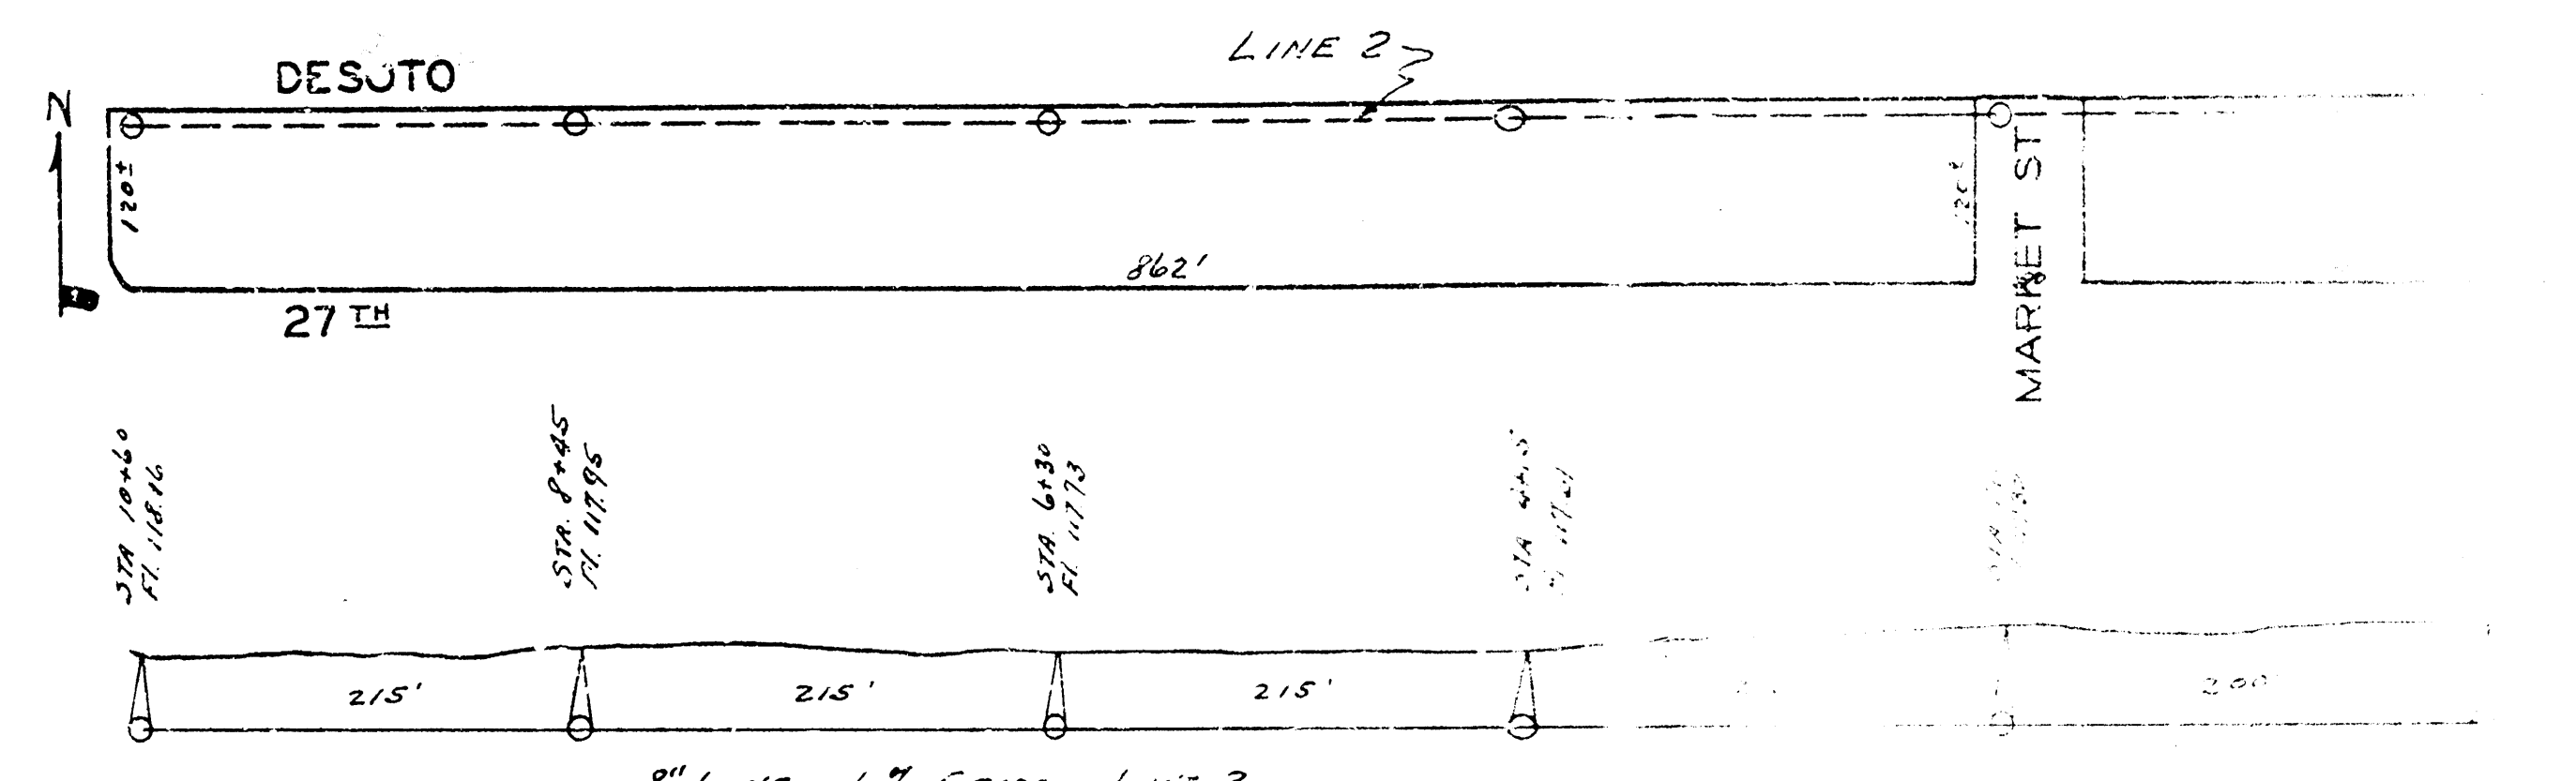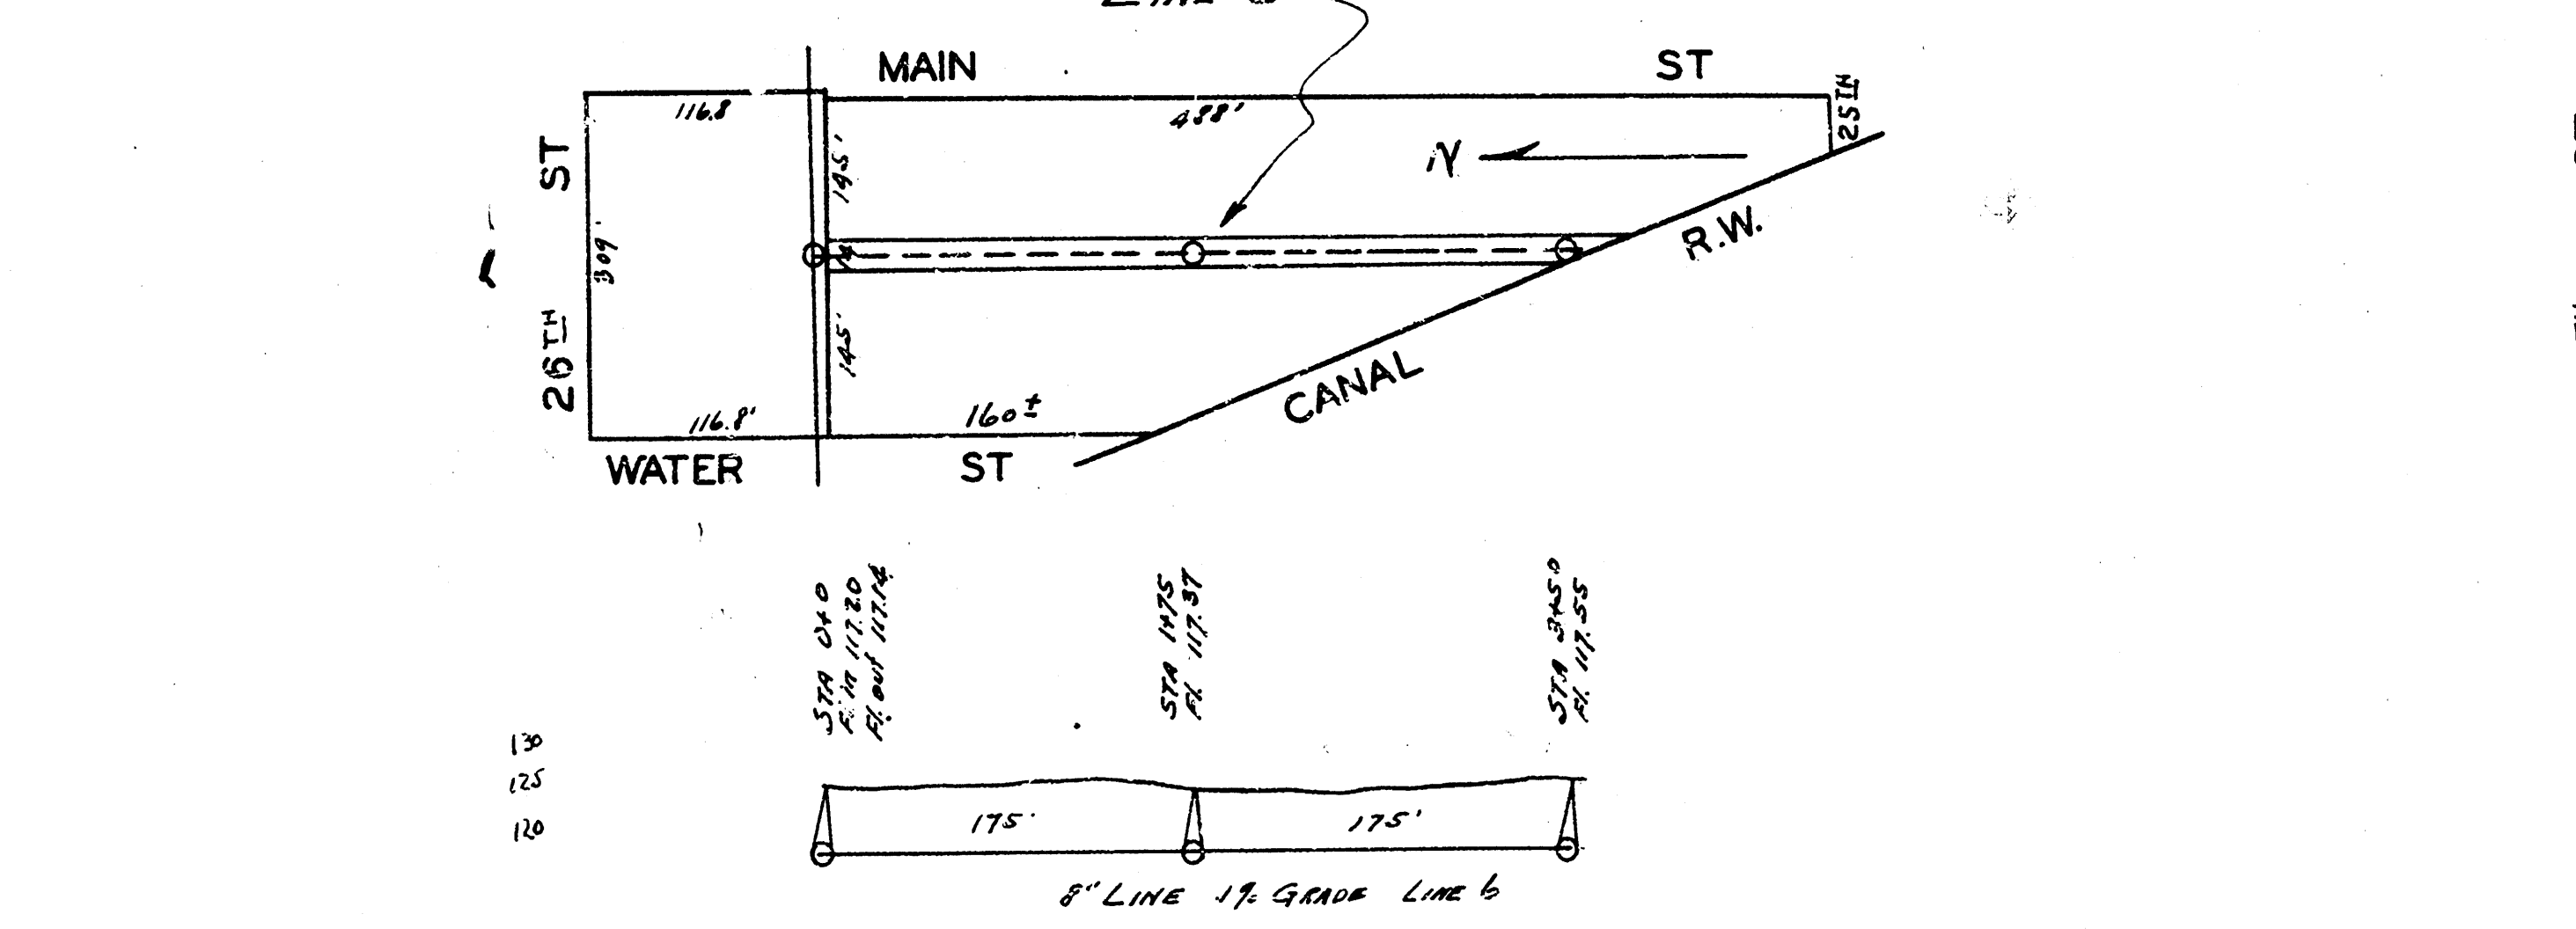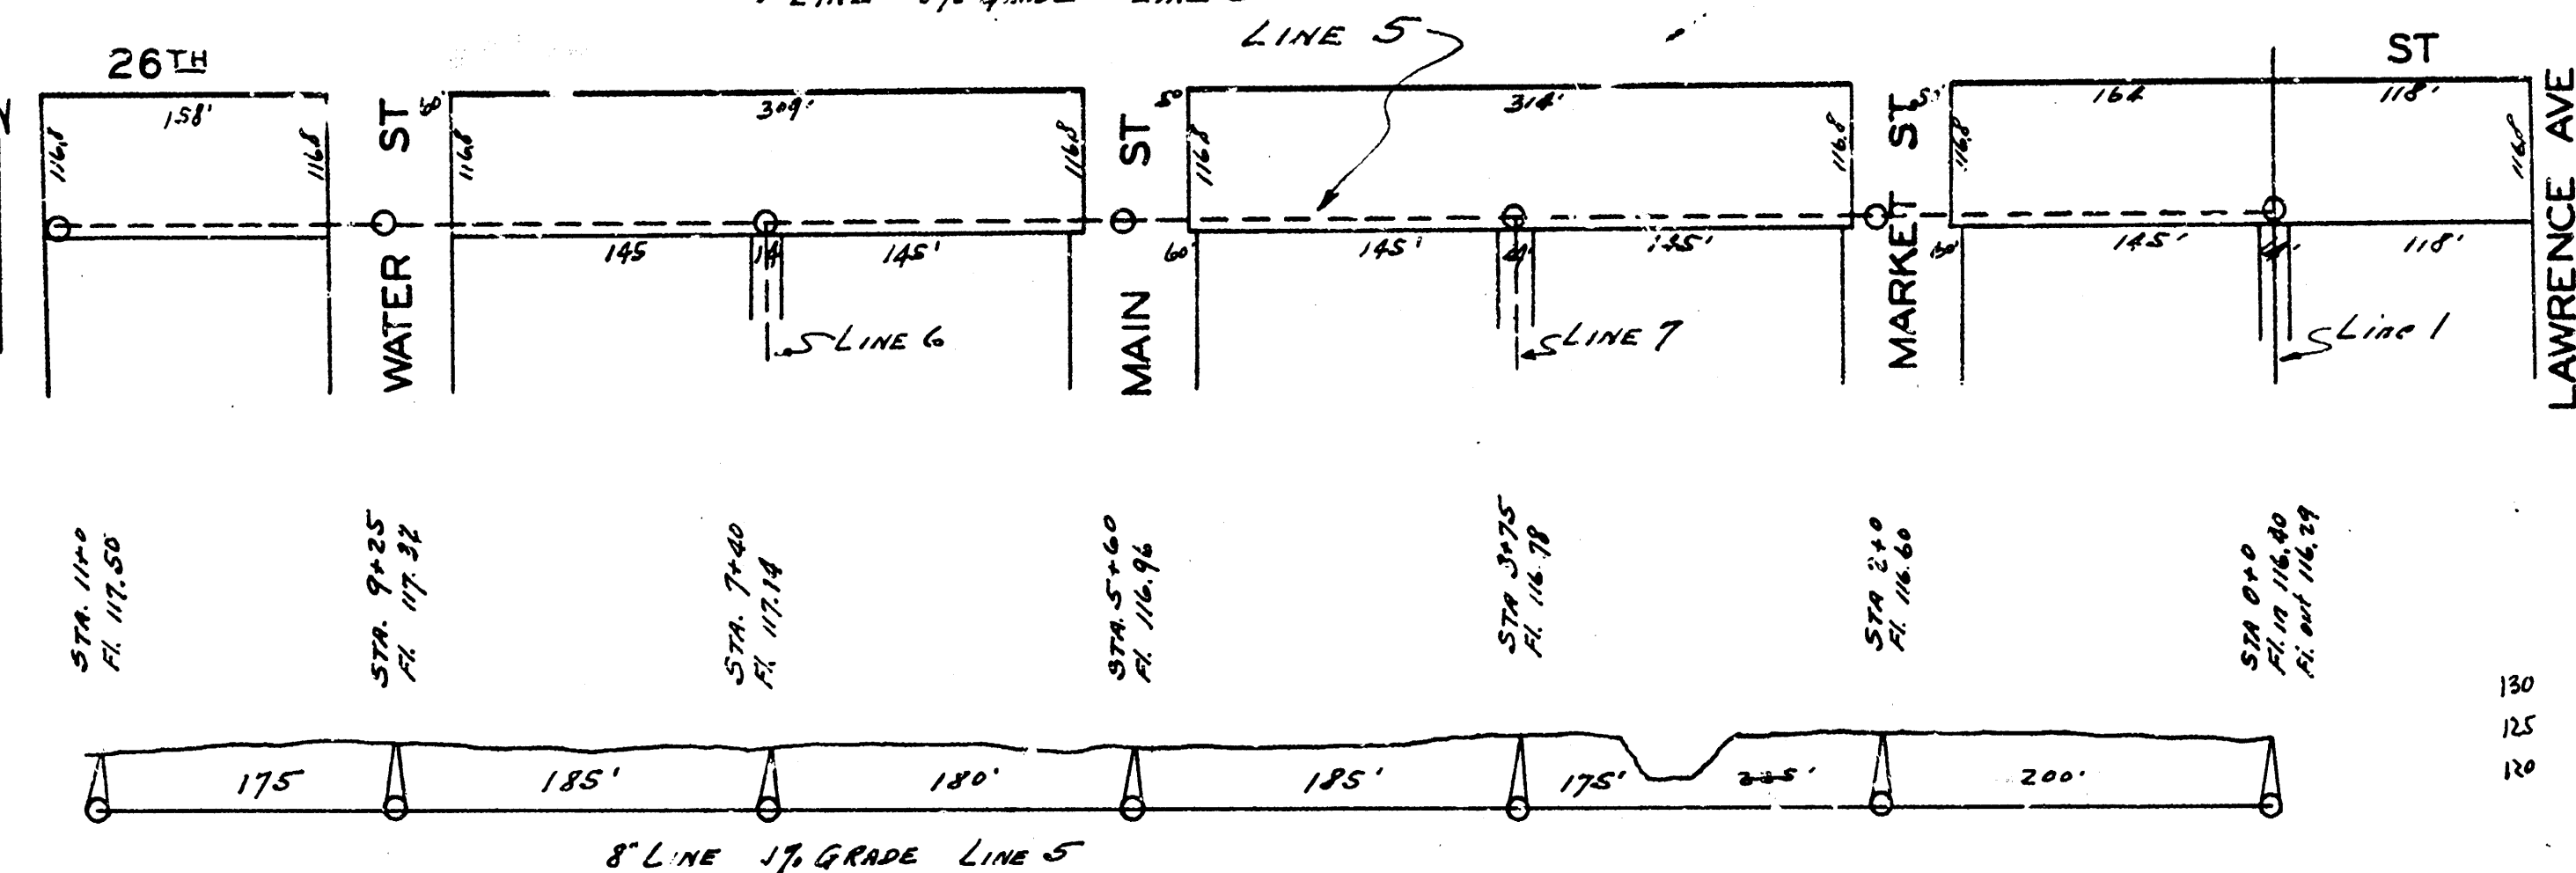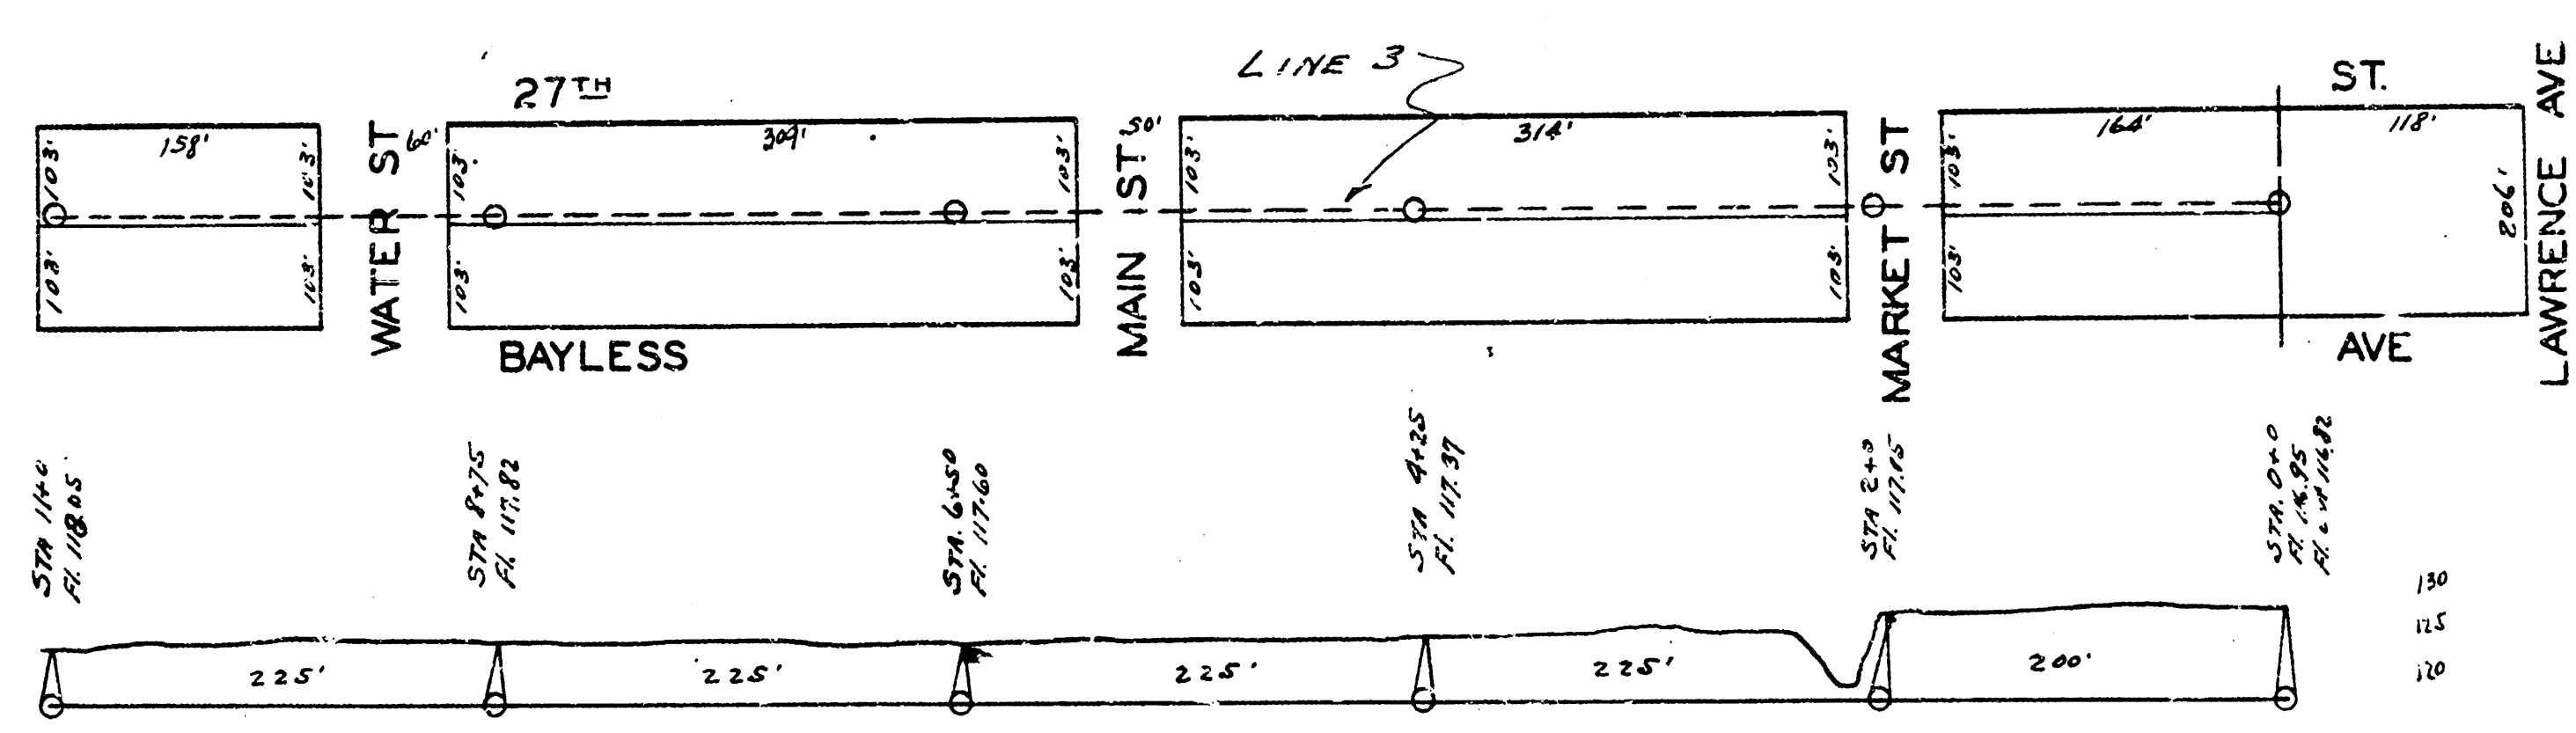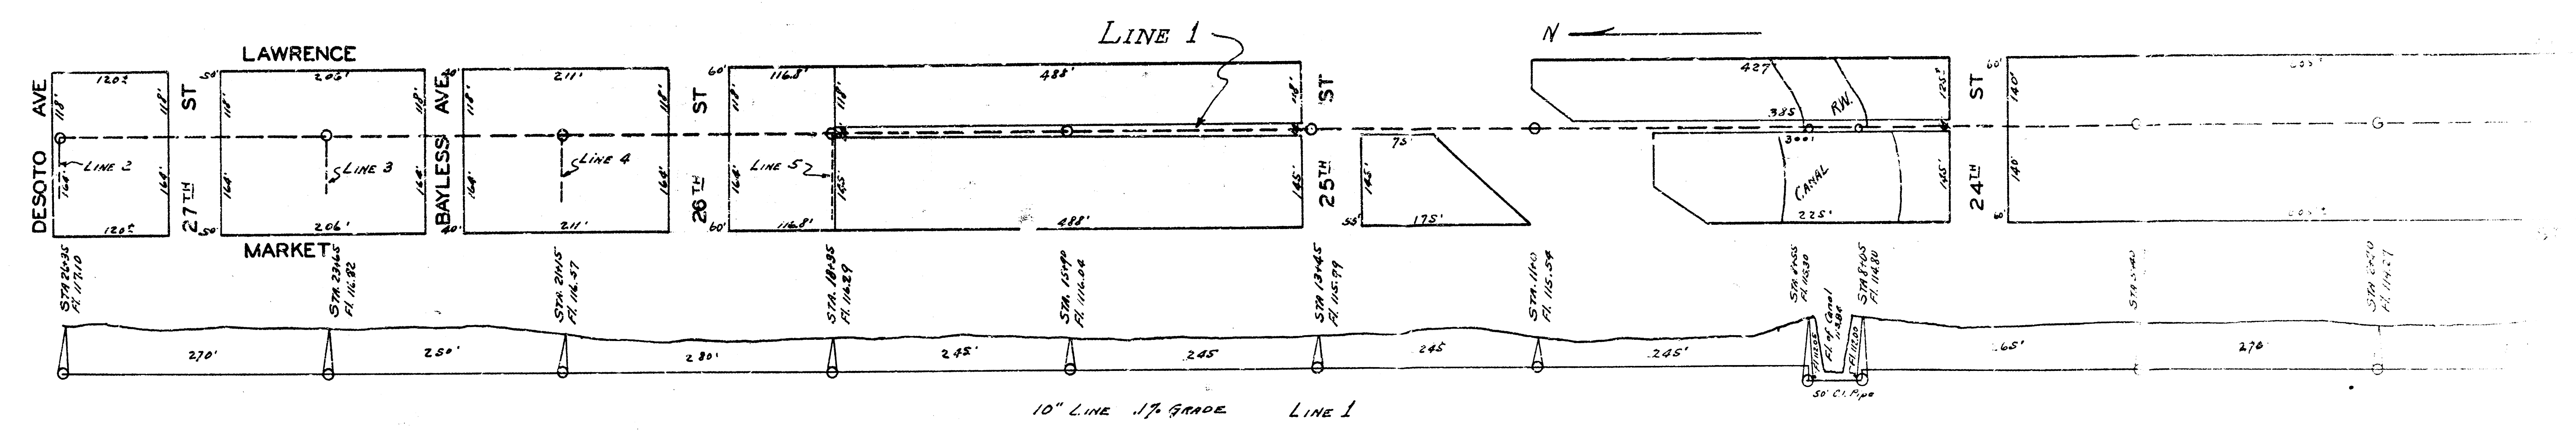

LAT. F DIST. SS 20

