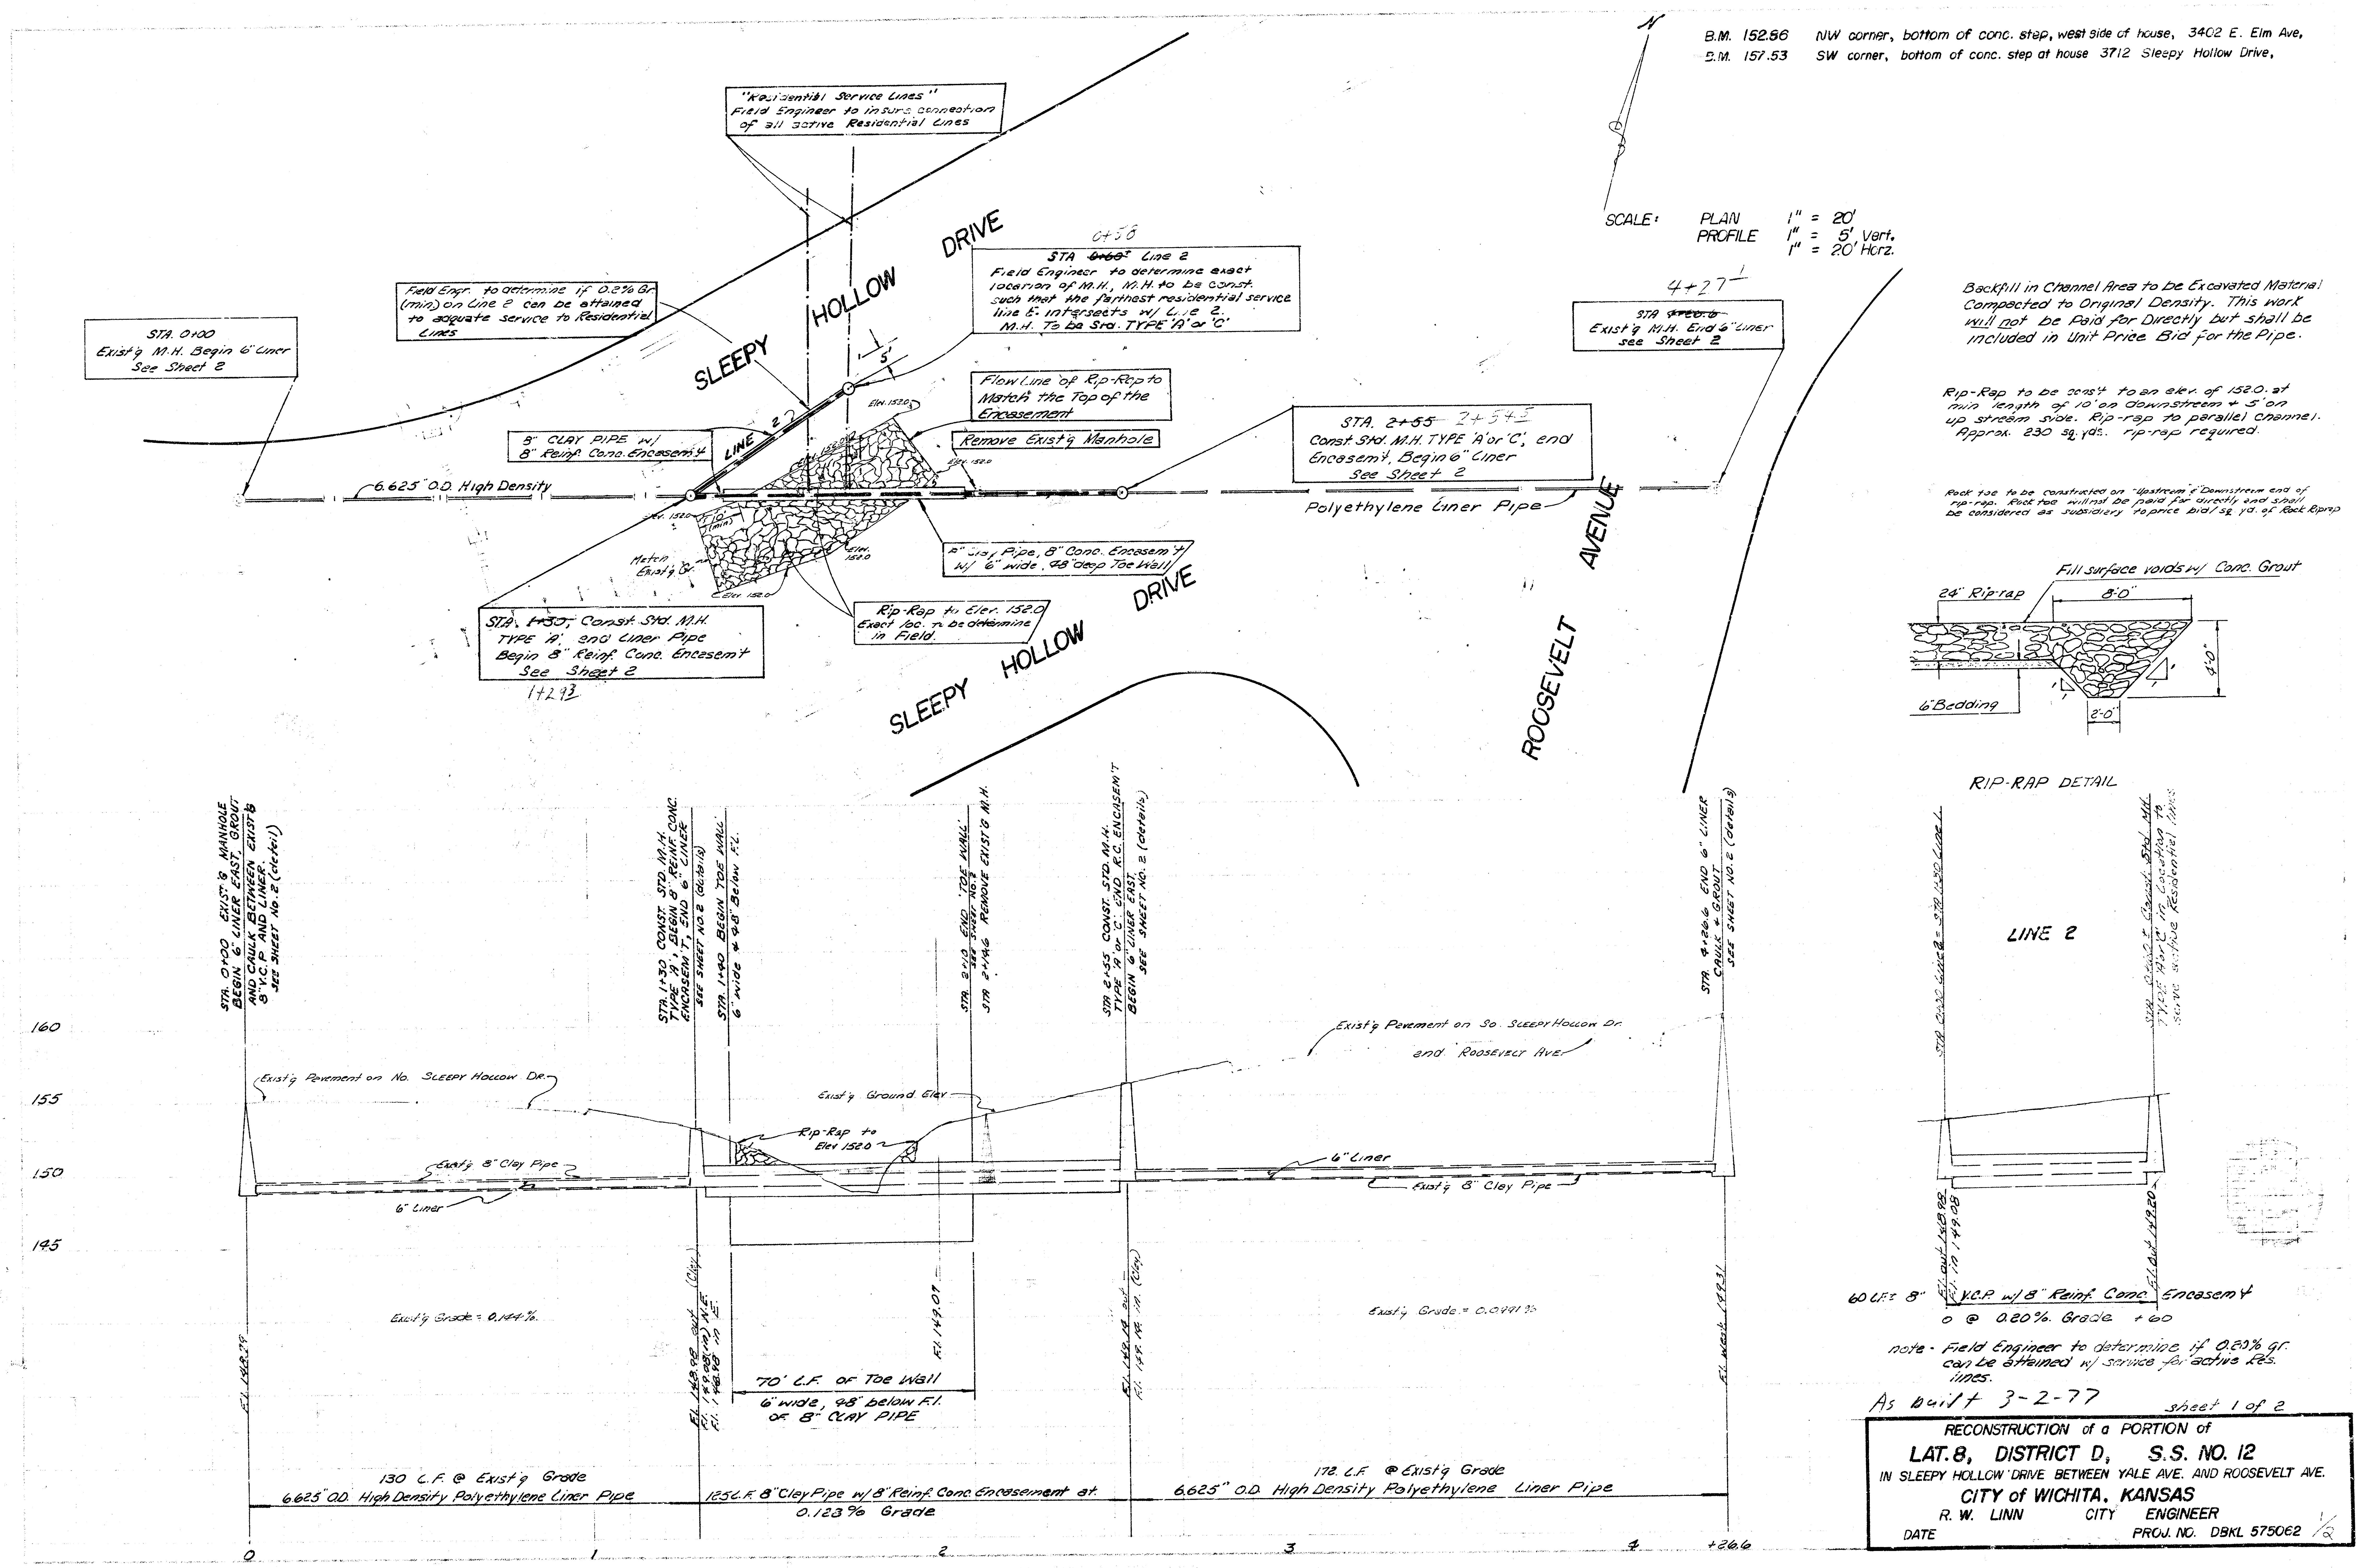


As built 3-2-77

sheet 1 of 2

RECONSTRUCTION of a PORTION of

LAT. 8, DISTRICT D, S.S. NO. 12


IN SLEEPY HOLLOW DRIVE BETWEEN YALE AVE. AND ROOSEVELT AVE.

CITY of WICHITA, KANSAS

R. W. LINN CITY ENGINEER

DATE

PROJ. NO. DBKL 575062 1/2

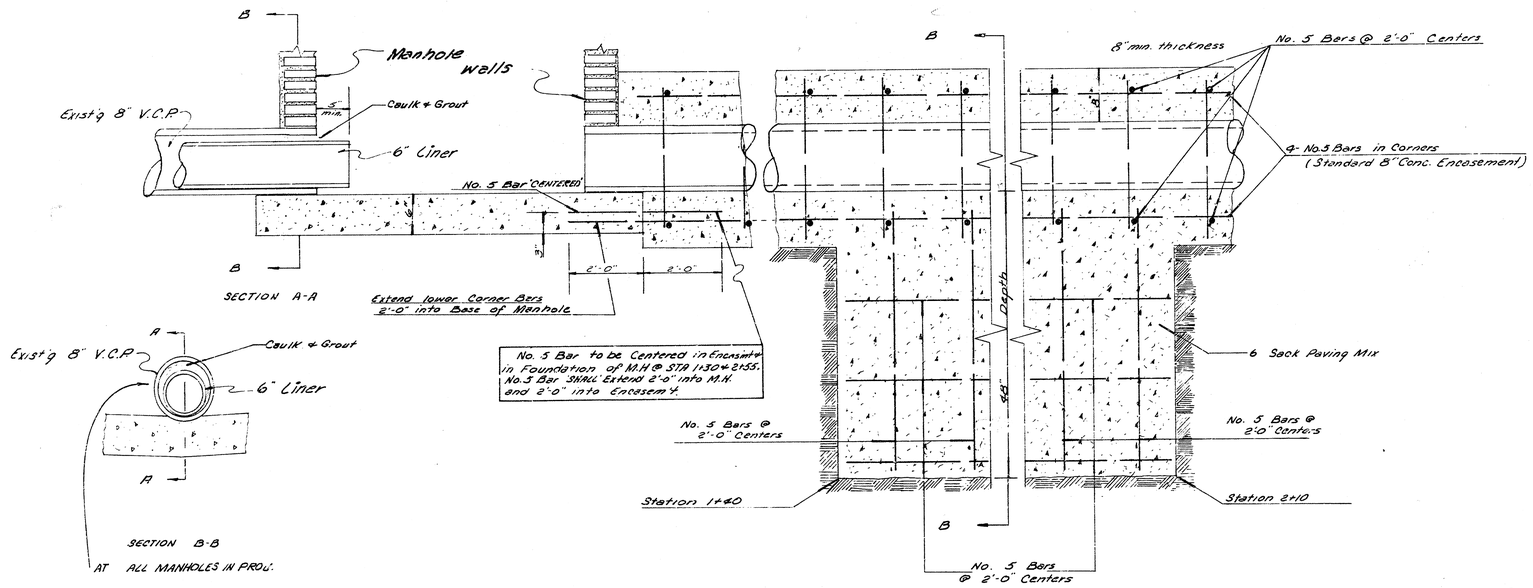

'No Scale'

Reconst of Portion of
LAT. 8, DIST. D. S.S. NO. 12
Proj. No. DBKL 575062
Sheet 2 of 2

2/12