

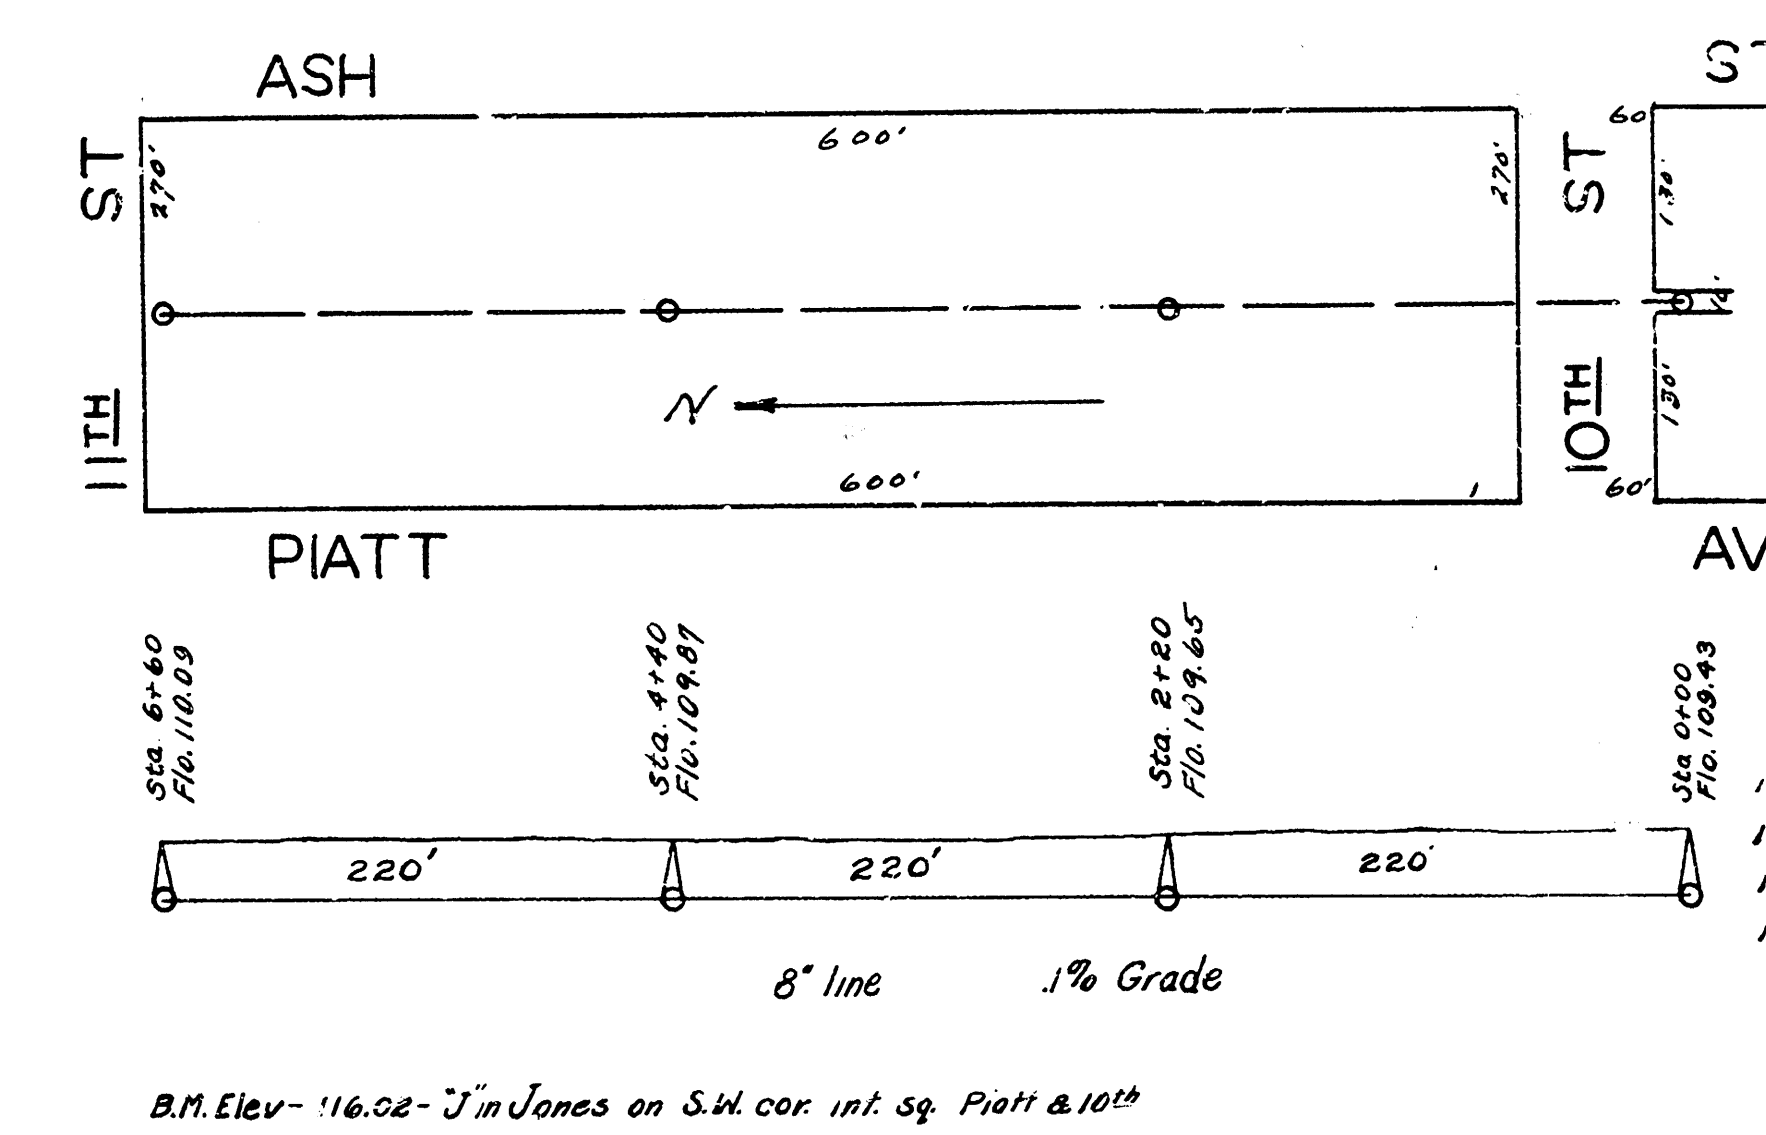
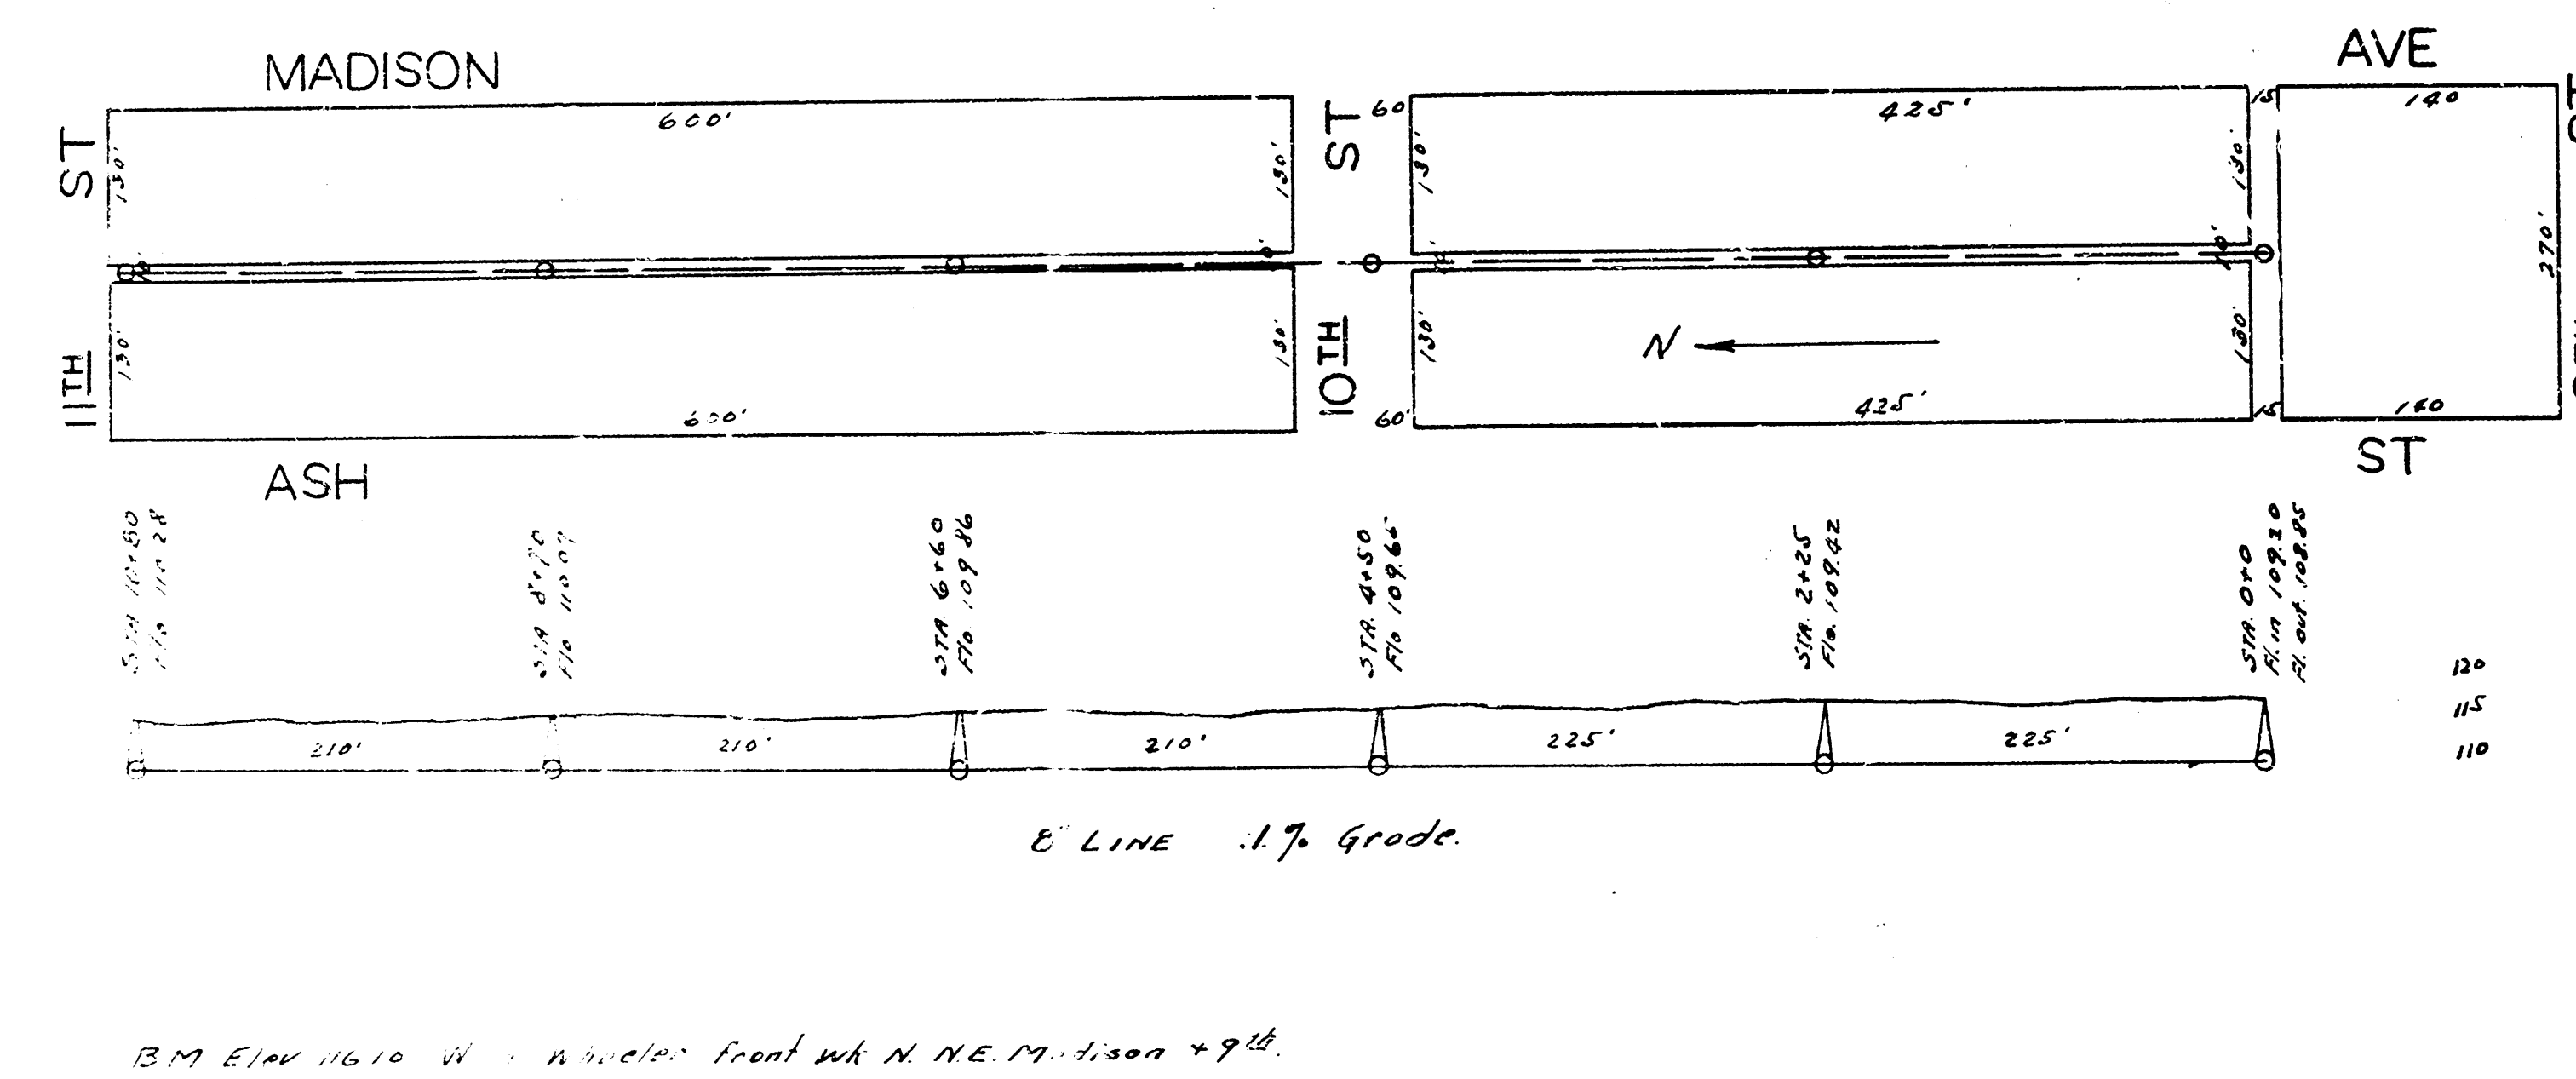
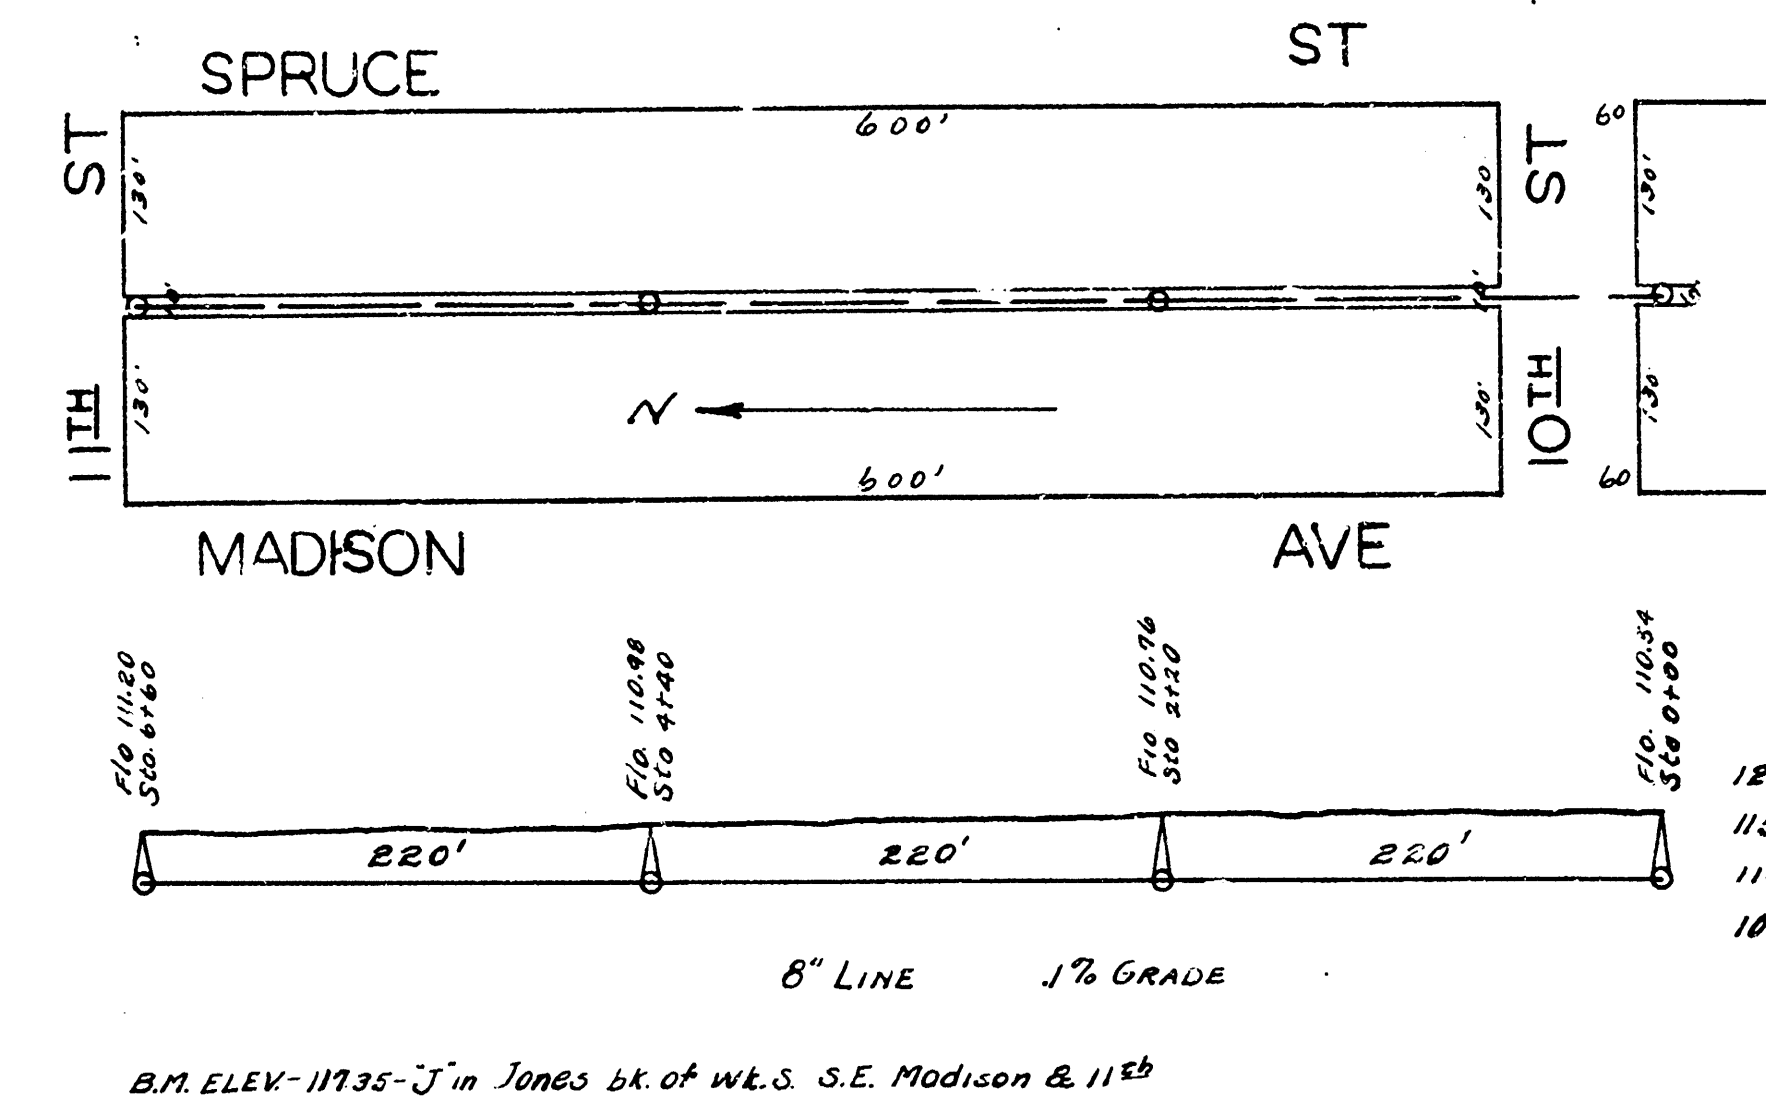
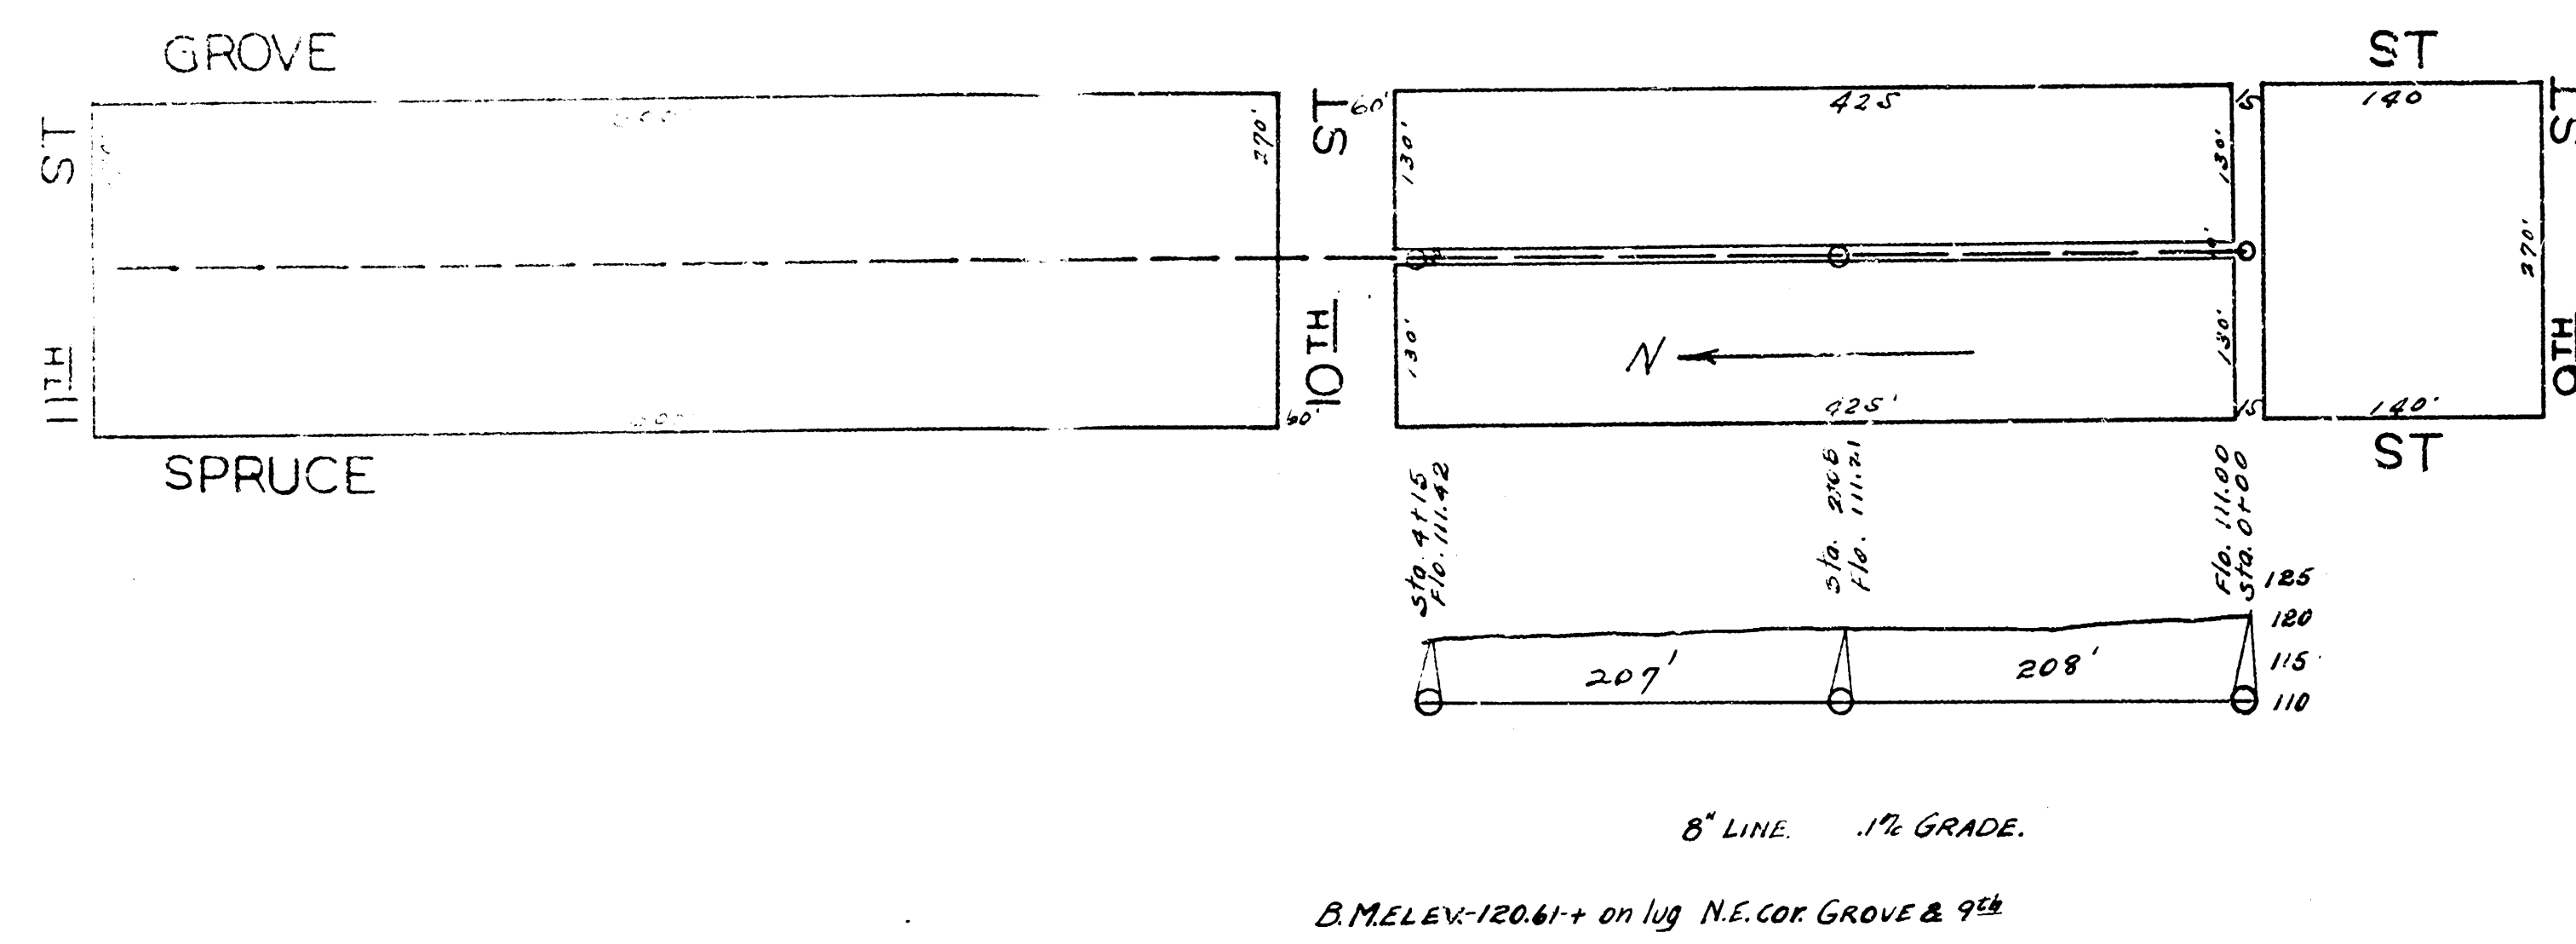
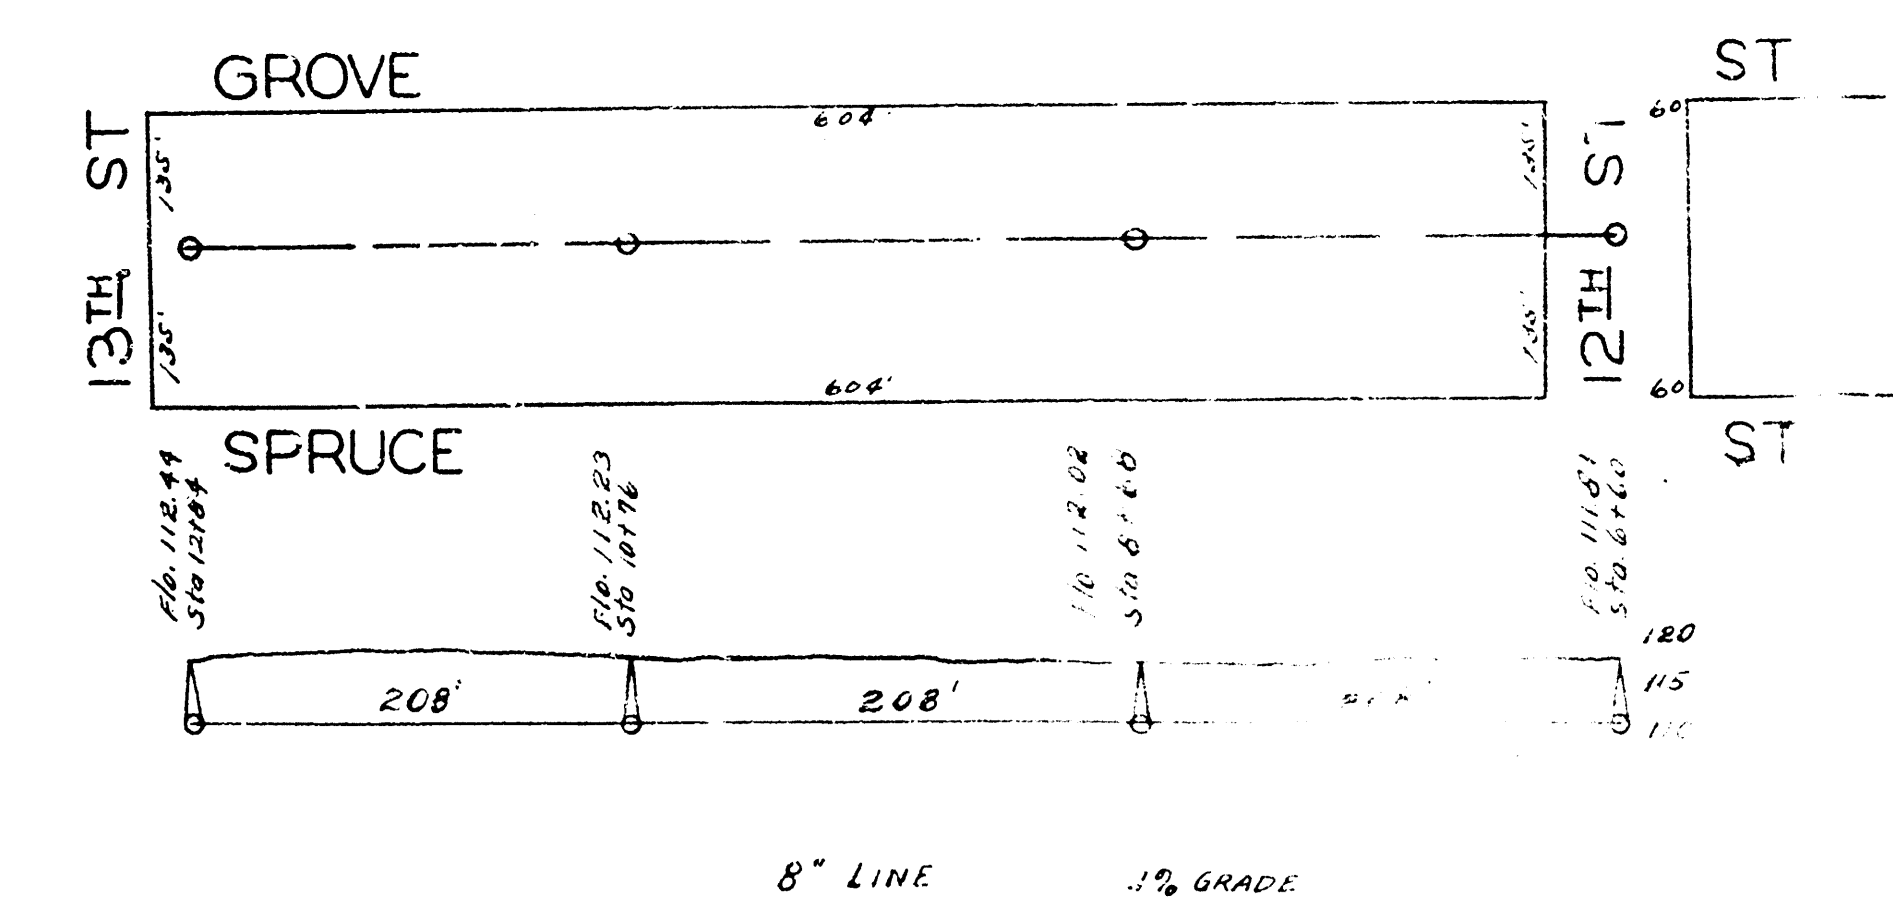


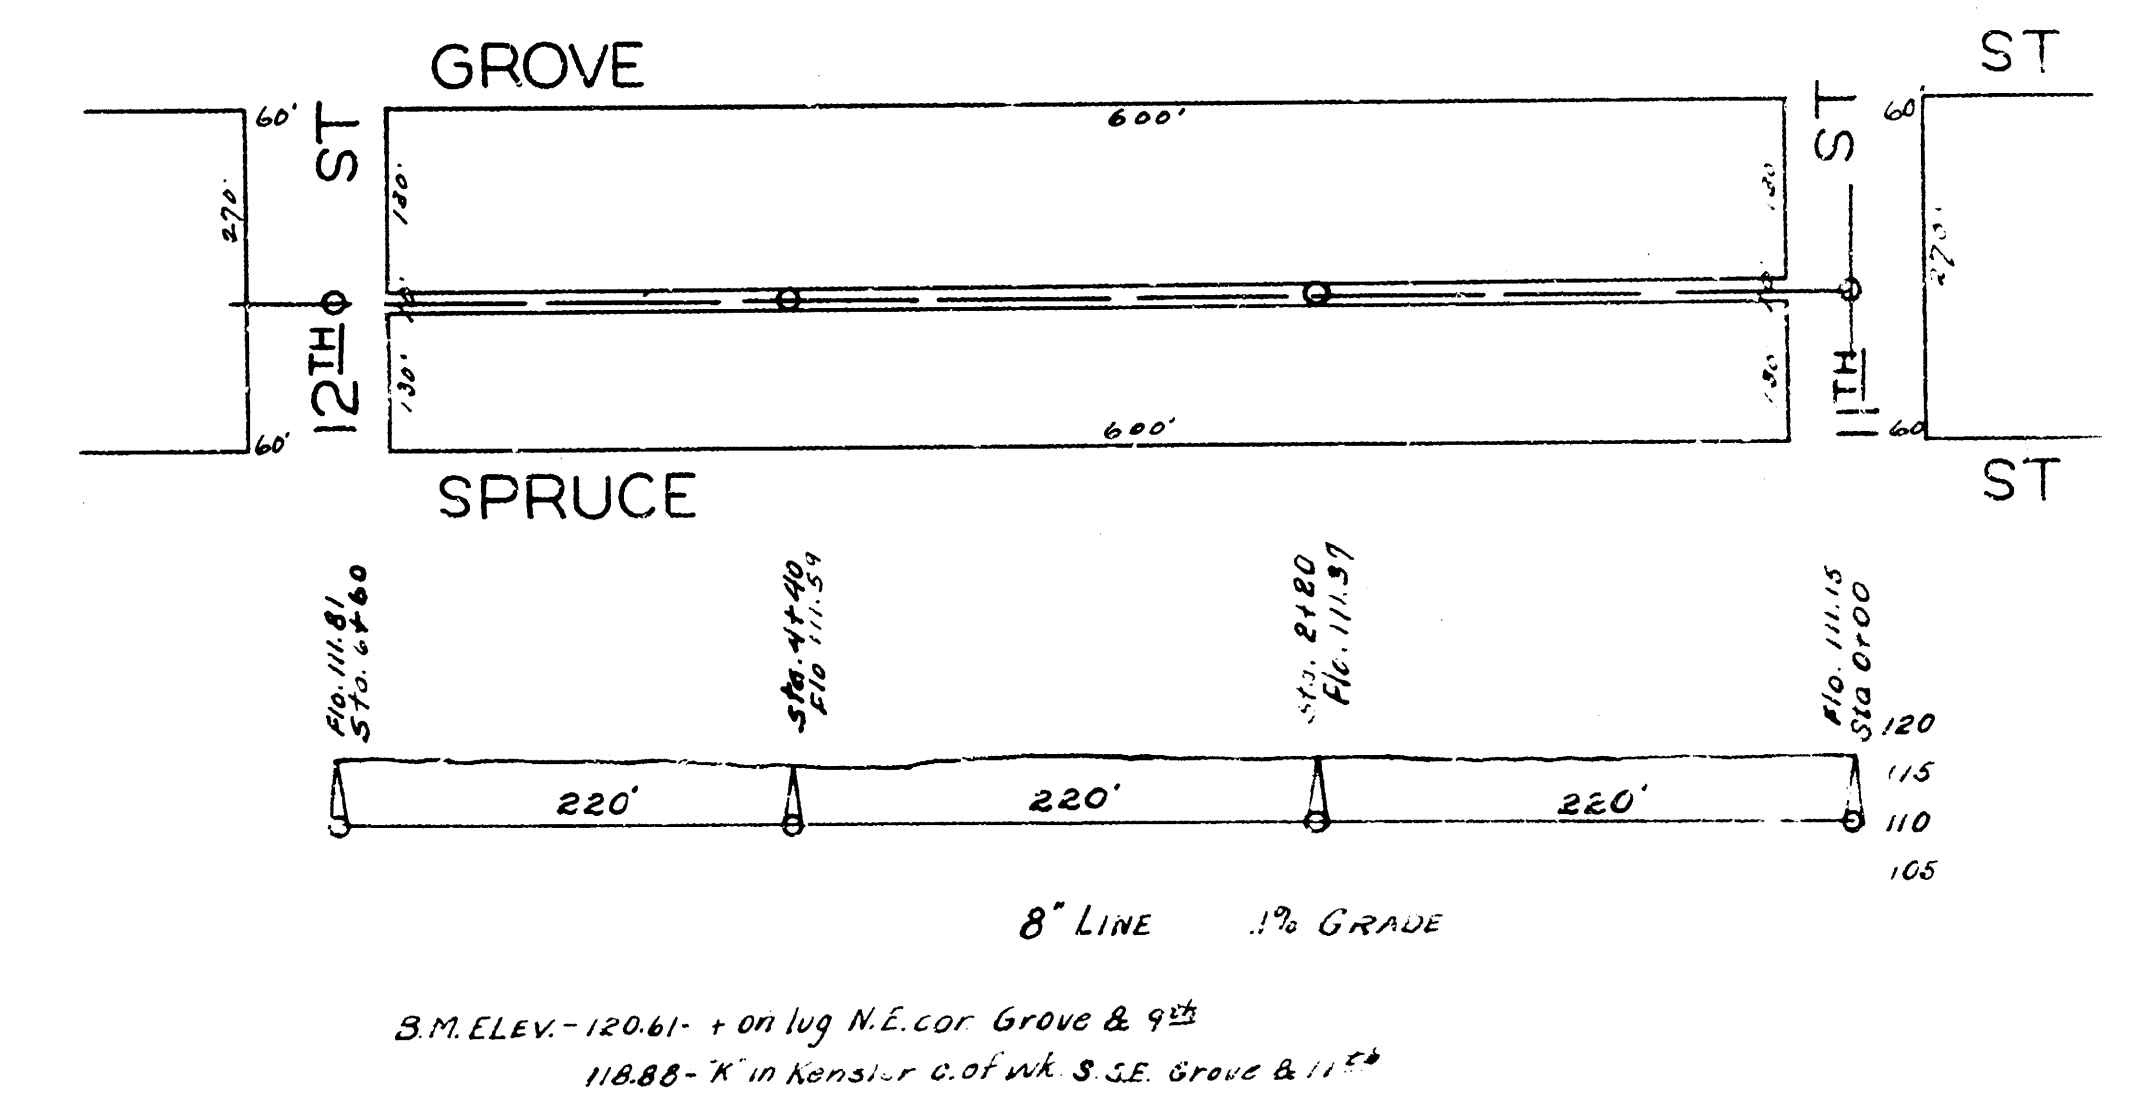

LAT. H, DIST. E, S.S. 12.

LAT. M, DIST. O, S.S. 12.

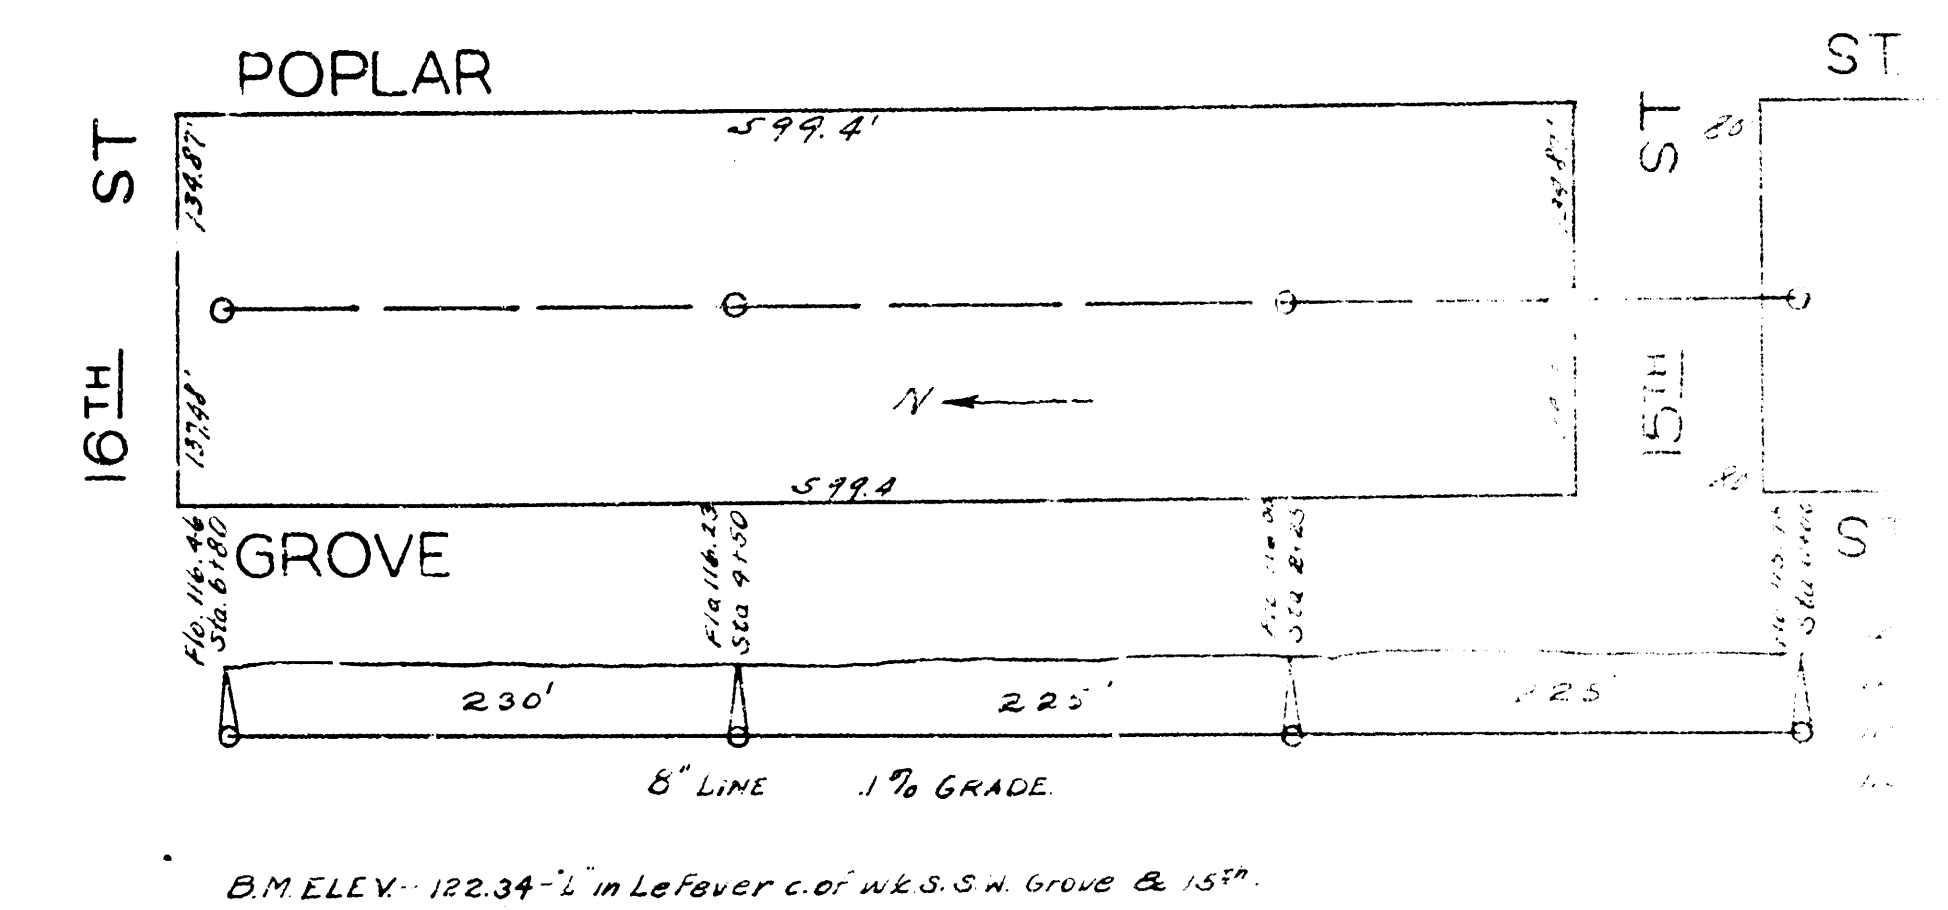

LAT. I, DIST. E, S.S. 12.