
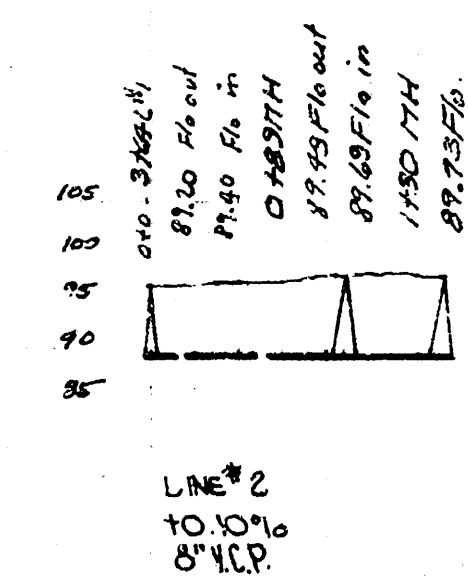


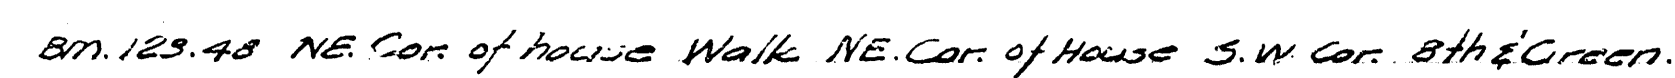

'LAT. 10, DIST. E, S.S. #12  
'E. 11, DIST. A, S.S. #20  
City of Wichita, Kansas  
L. K. White City Engineer  
date 8-8-49 Proj. No. C27-12