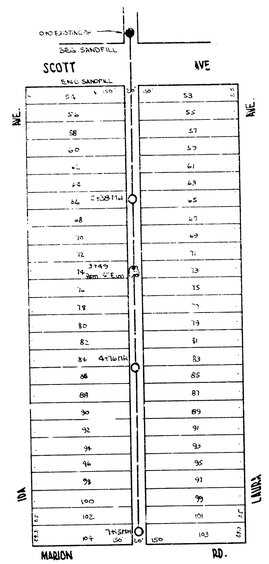

LAT. 14, DIST. R, SS# 20

BM. 96.32 ft. Side of Pole So. Side Scott (Spike in Base of Pole)

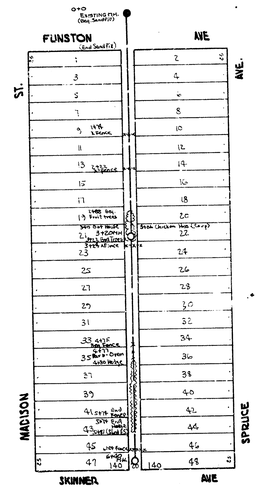

LAT. 10, DIST. AS, SS# 12

BM. "99.30" G." in Globe So. End. W. Cor. Spruce & Funston

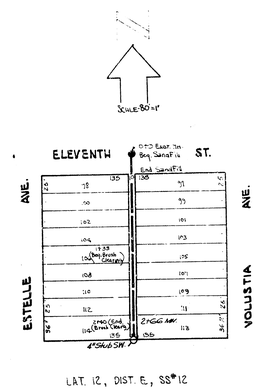

LAT. 12, DIST. E, SS# 12

BM. 123.11 No. Rim MH. in Eleventh Street.

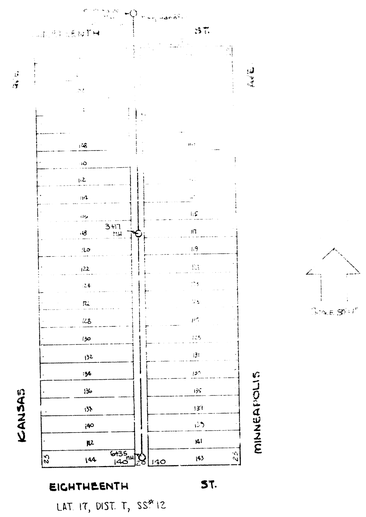

LAT. 17, DIST. T, SS# 12

BM. 120.7.3 No. Rim of So. Spindle 19 M. & Hydraulic

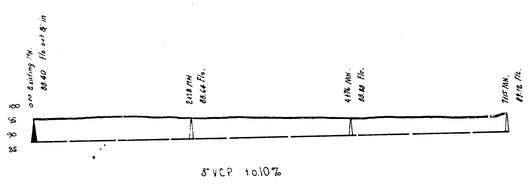

LAT. 14, DIST. R, SS# 20

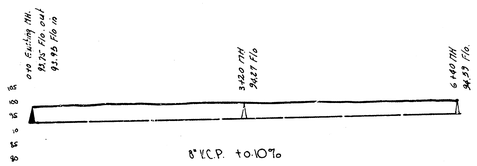

LAT. 10, DIST. AS, SS# 12

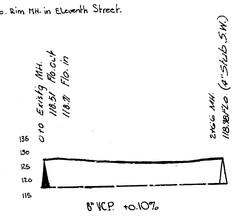

LAT. 12, DIST. E, SS# 12

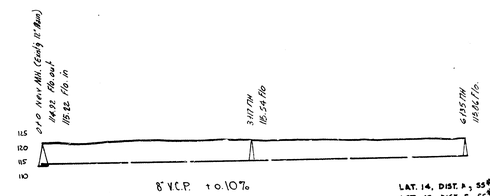

LAT. 17, DIST. T, SS# 12

LAT. 14, DIST. R, SS# 20 — LAT. 10, DIST. AS, SS# 12
LAT. 12, DIST. E, SS# 12 — LAT. 17, DIST. T, SS# 12

CITY OF WICHITA, KANSAS

L.K. WHITE - CITY ENGINEER

1949