
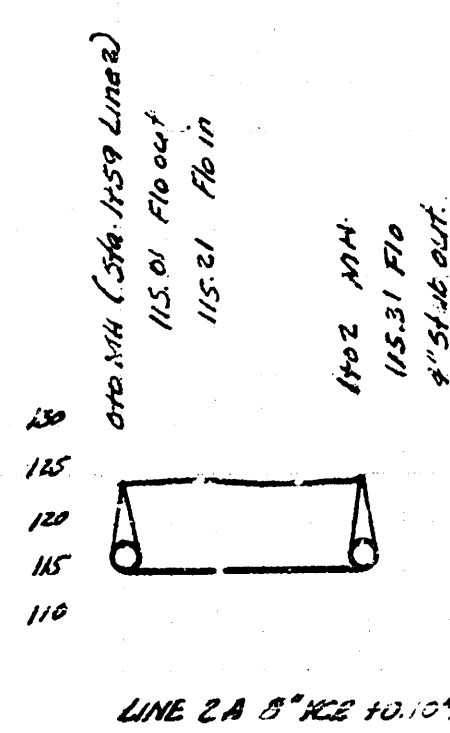
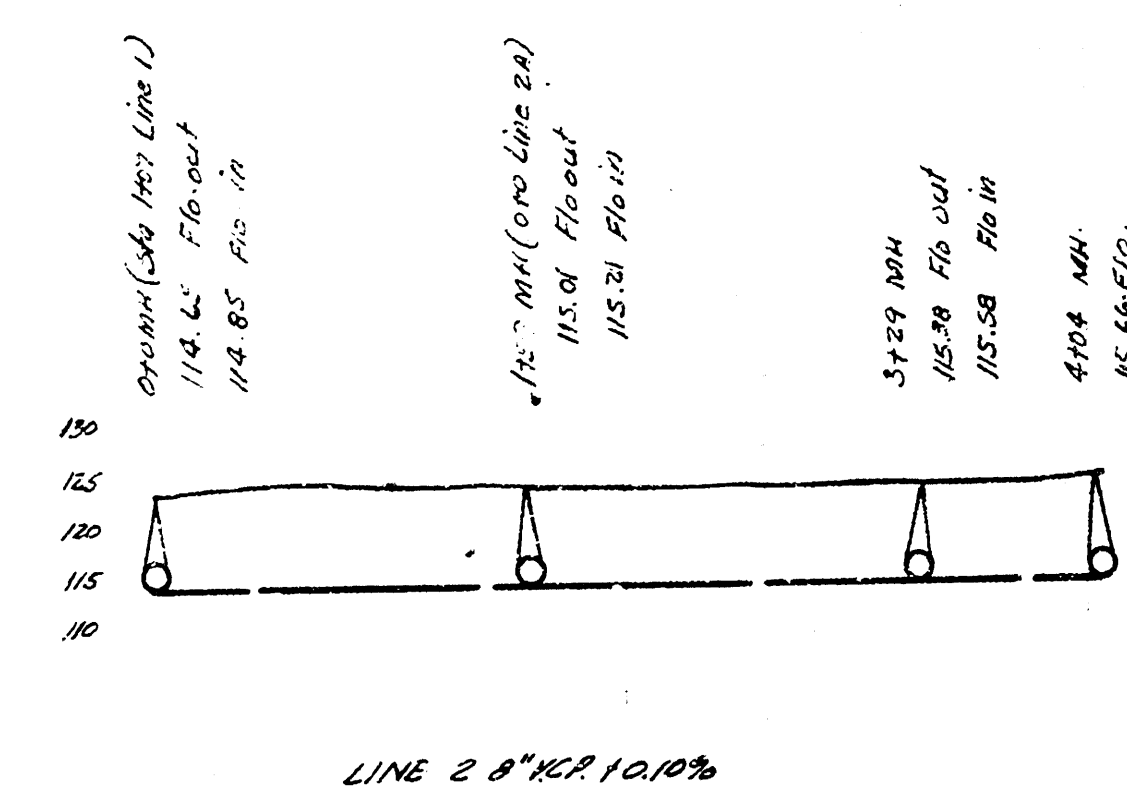
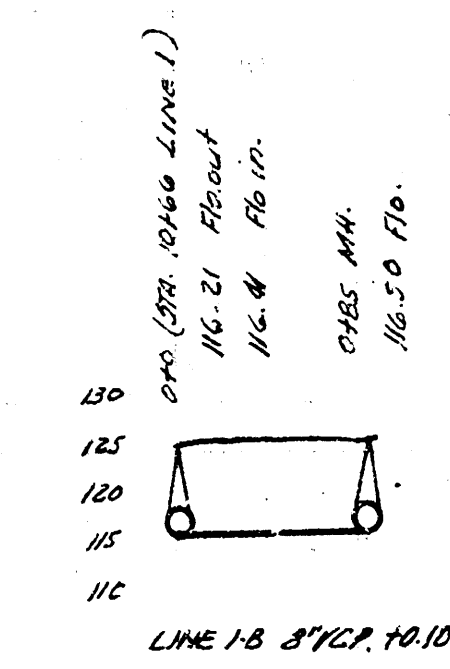
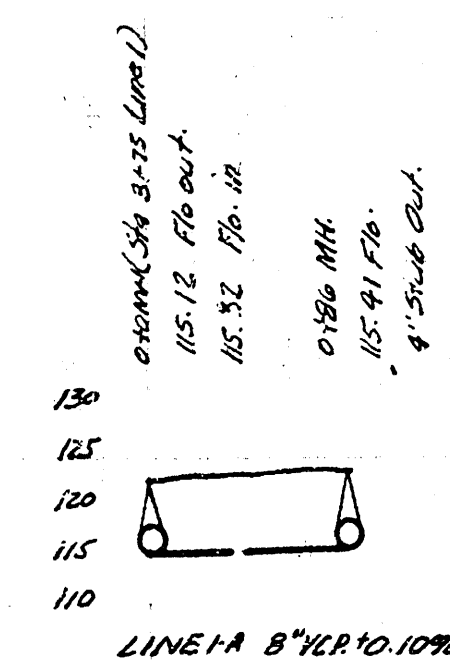
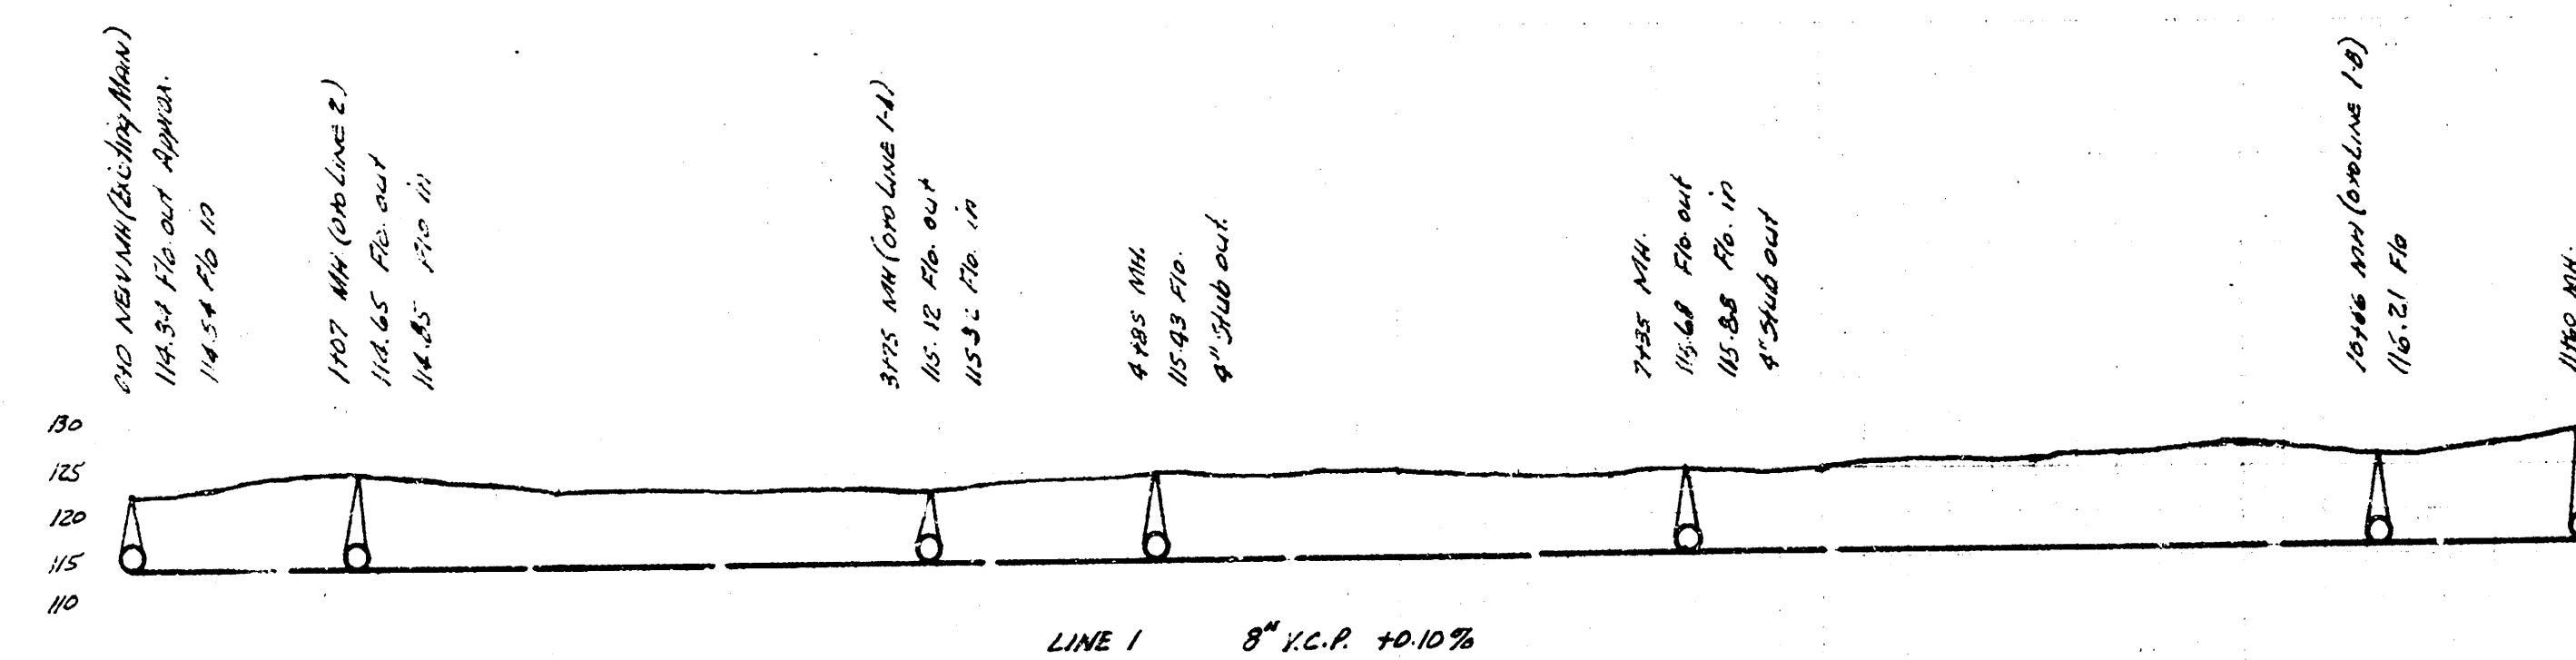


BUILDER'S SECOND ADDITION

N

B.M. 126.57' IN TOP CURB SPRUCE ST. 17TH

LAT. 5, DIST. E, MAIN 12.

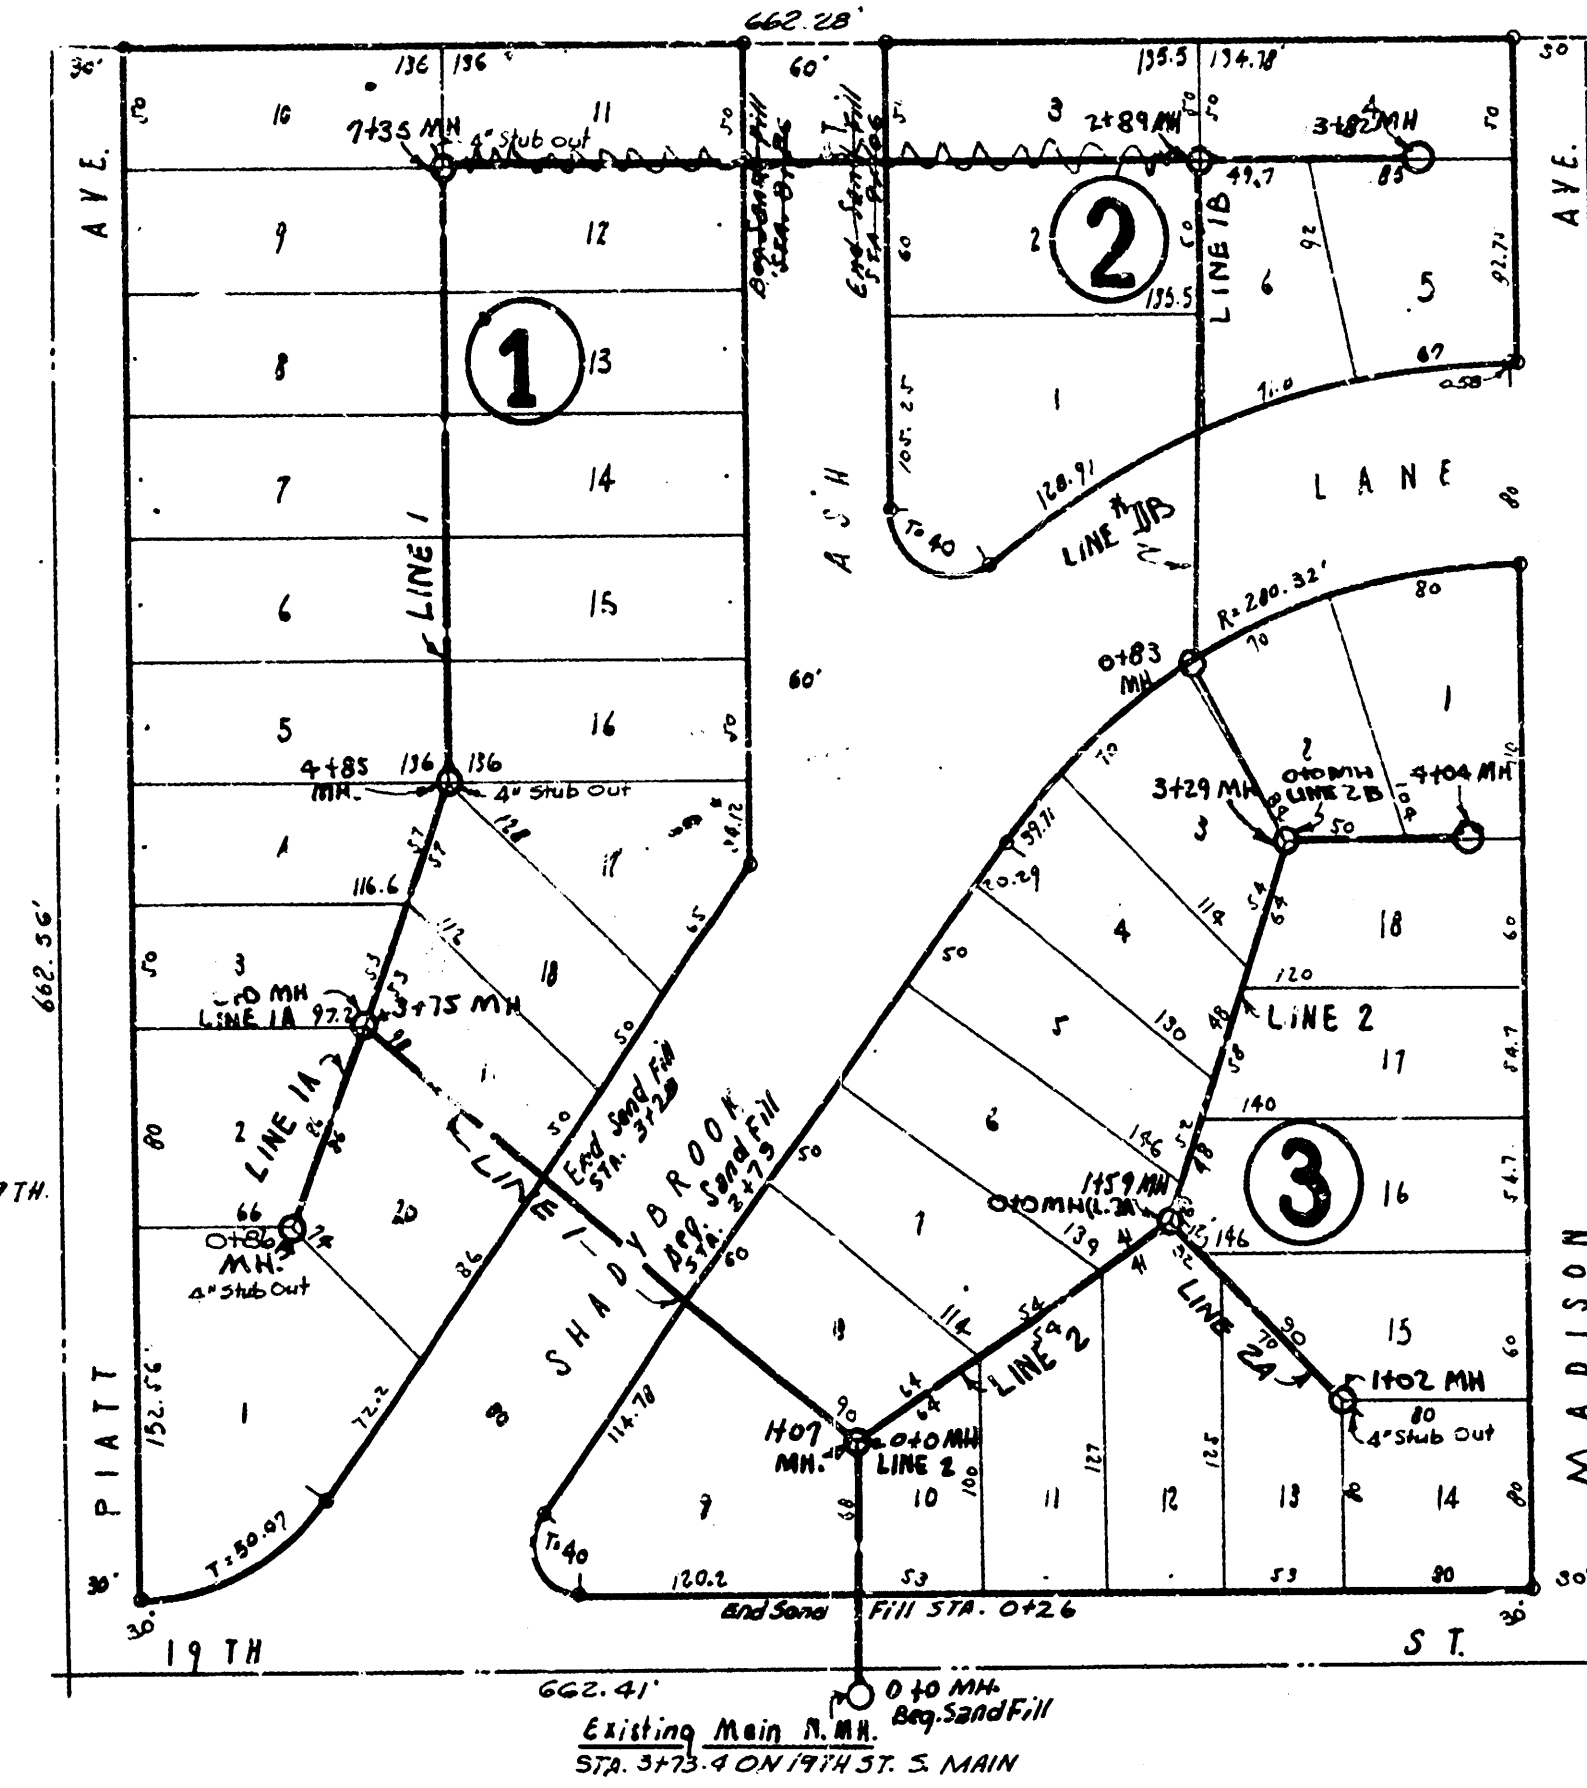

LAT. 5, DIST. E, MAIN 12.

CITY OF WICHITA, KANSAS

L. K. WHITE City Engineer

DATE 11-15-48 Proj. No. C-28-25