
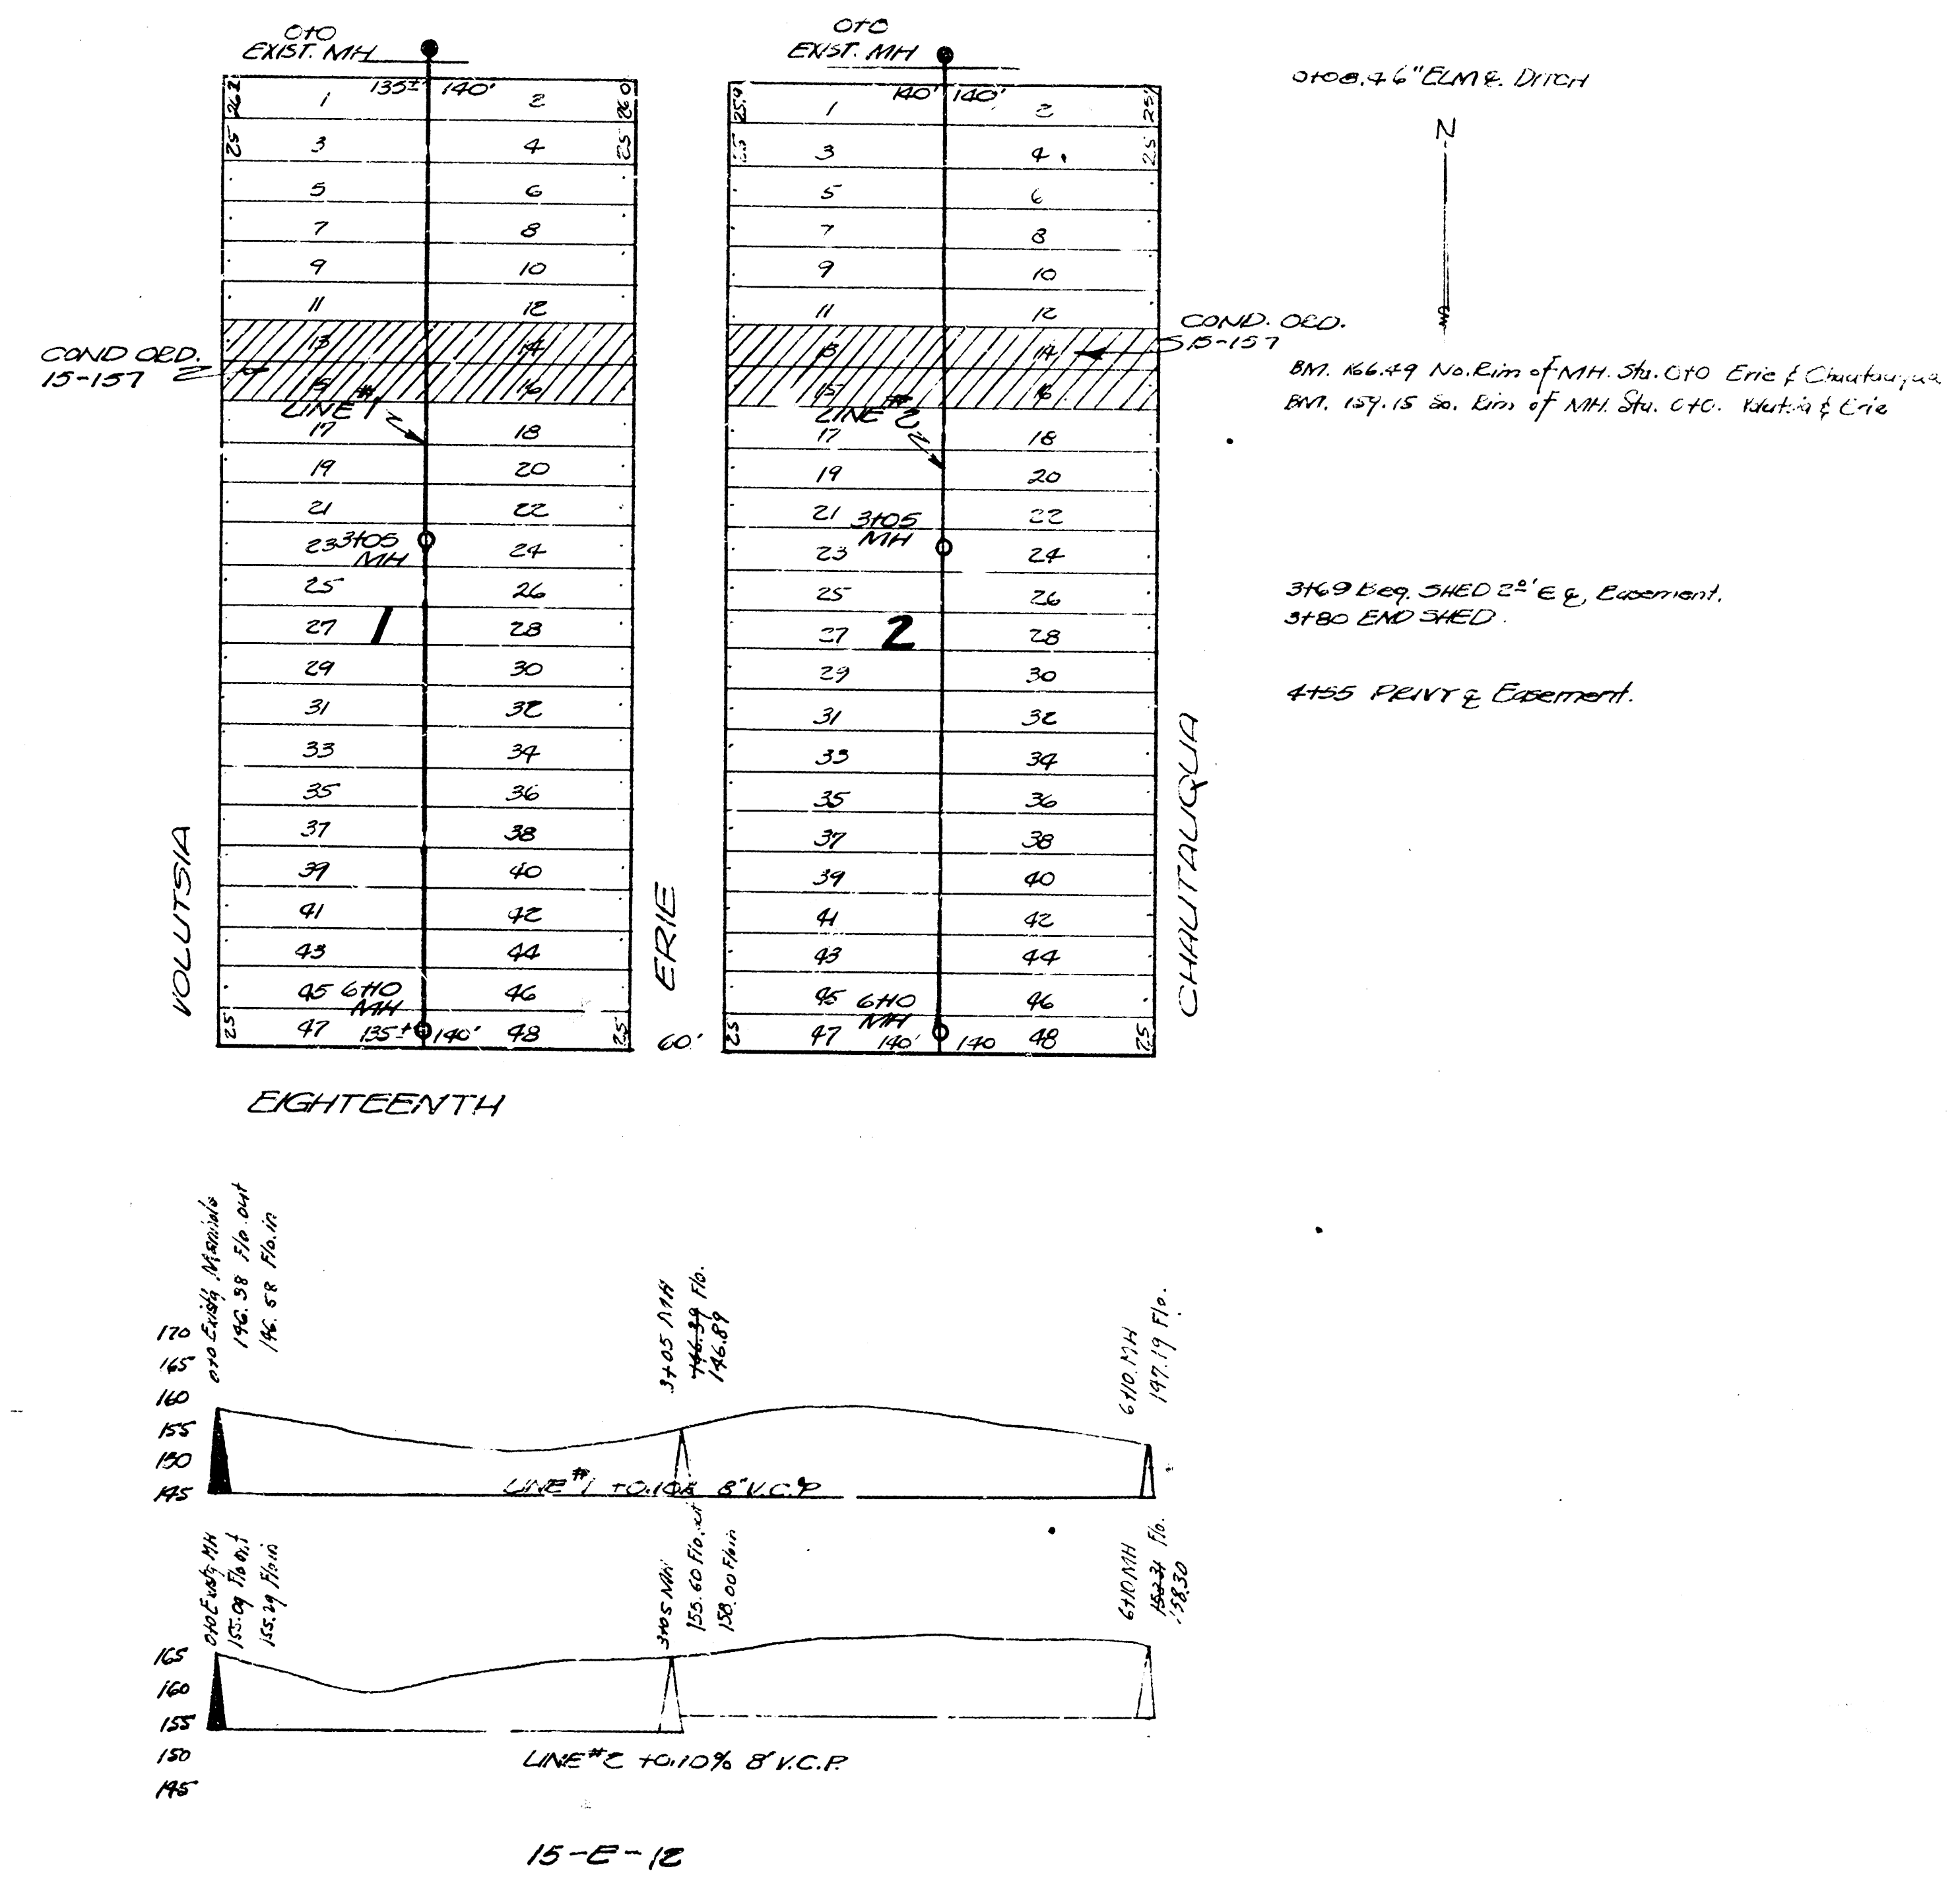


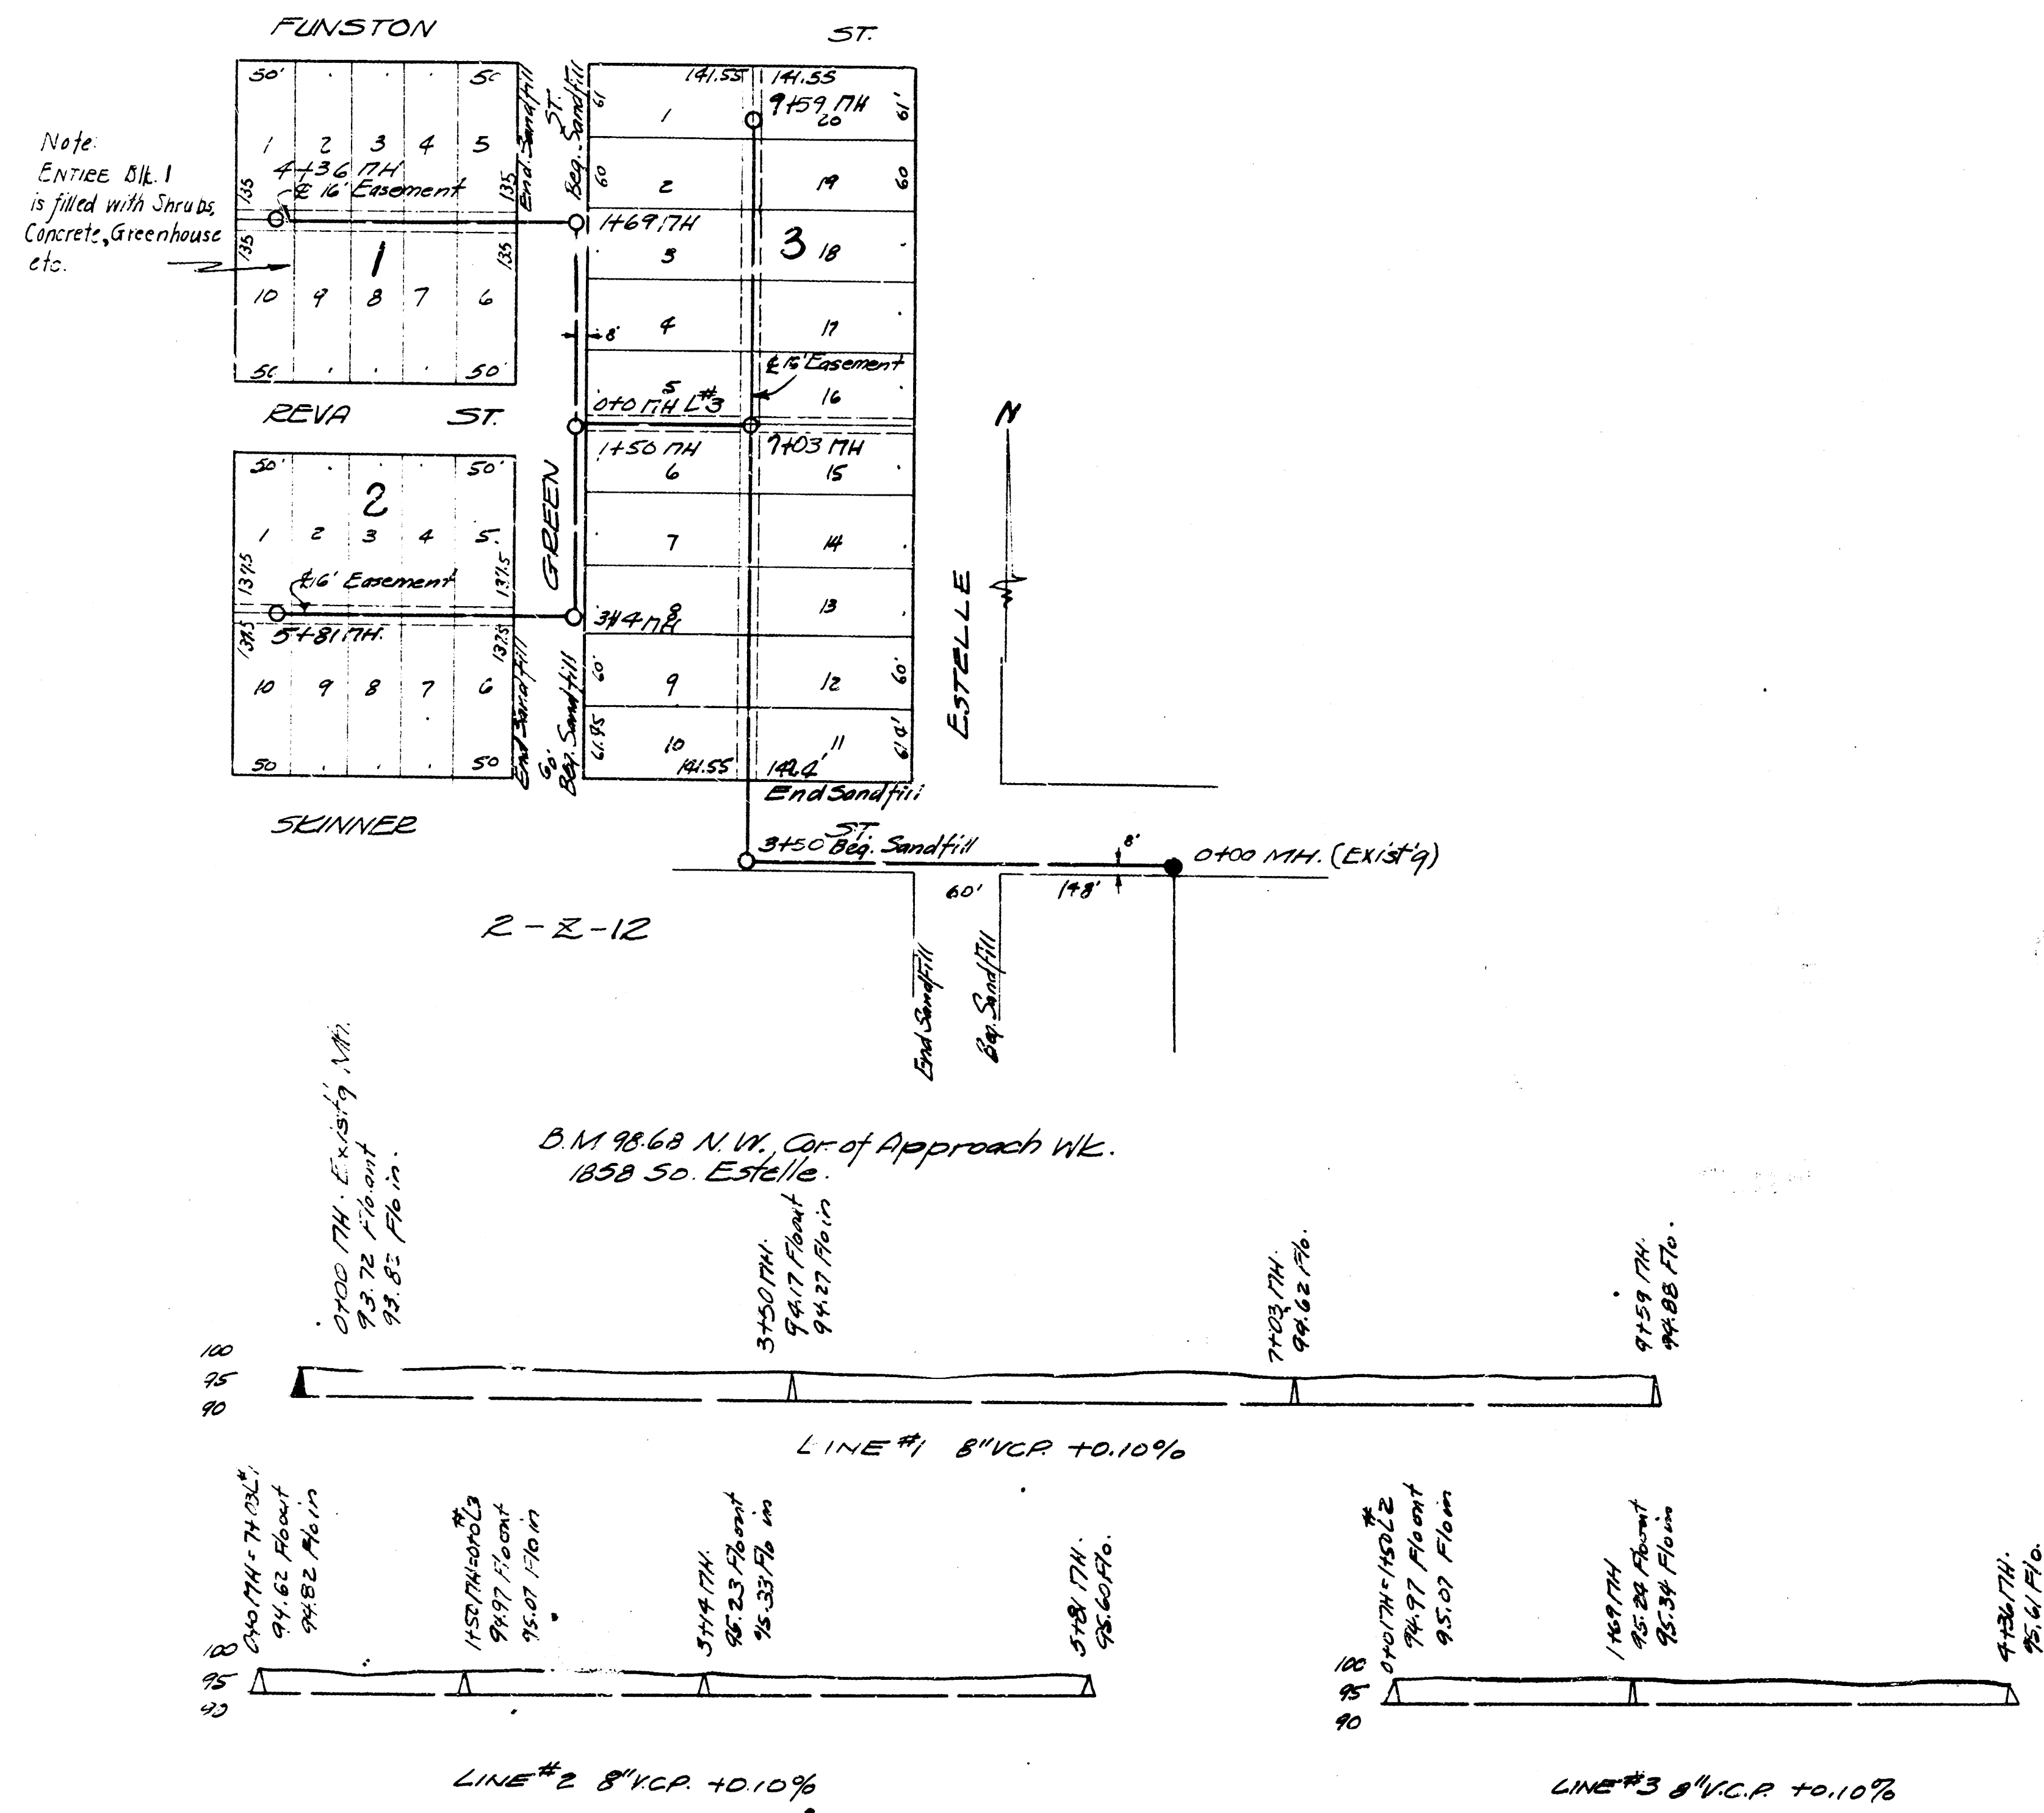

LAT. 15, DIST. E, 35th 12
LAT. 2 SUBMAIN E, 55th 12
CITY OF
WICHITA - KANSAS
L.H. WHITE - City Engineer
DATE 1950 Proj. No. C20-43