


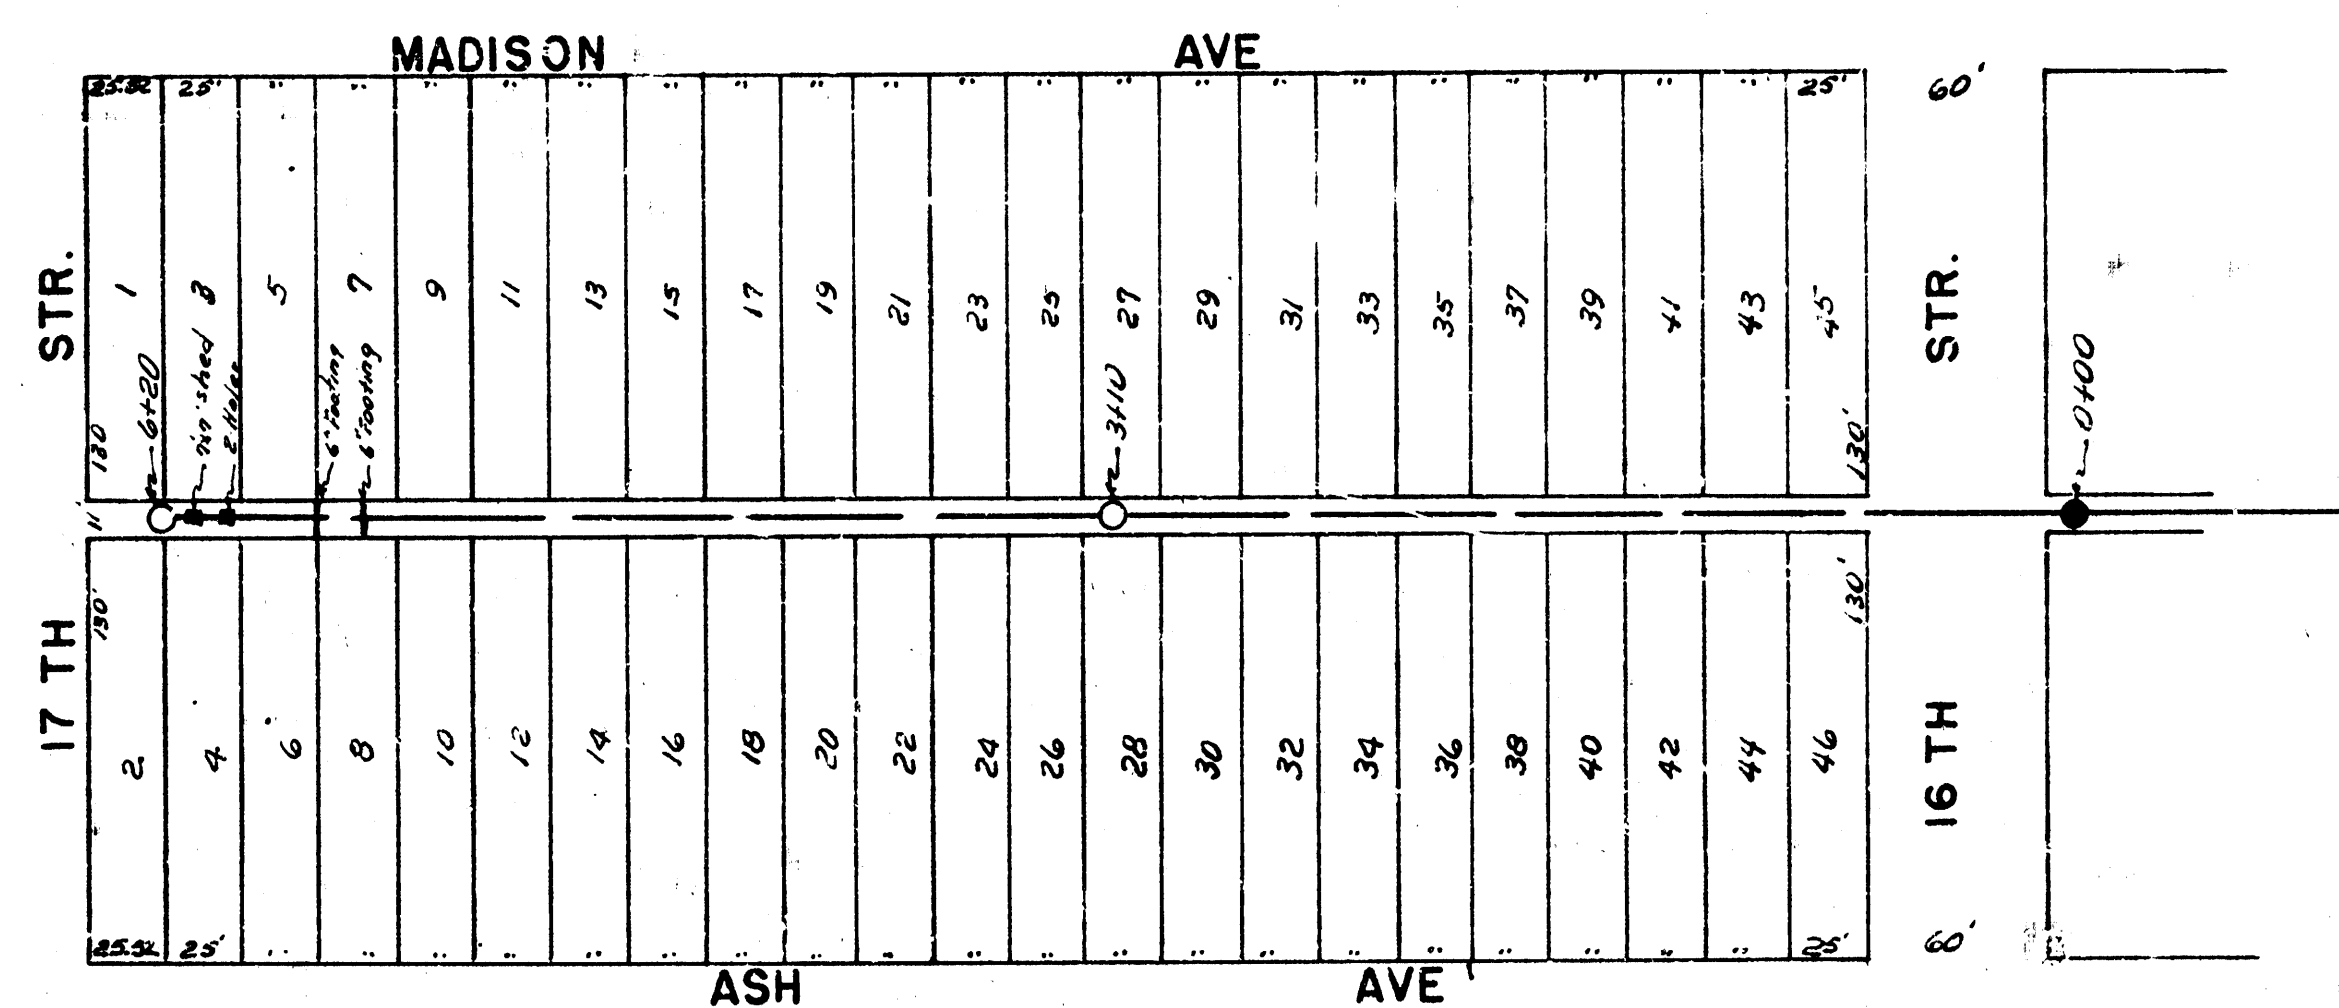
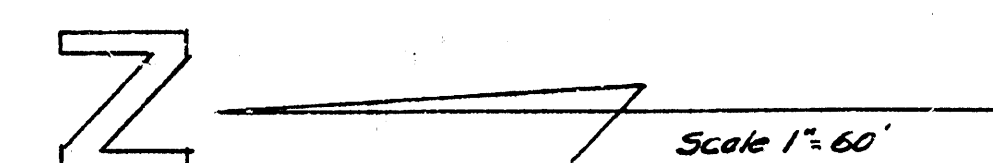
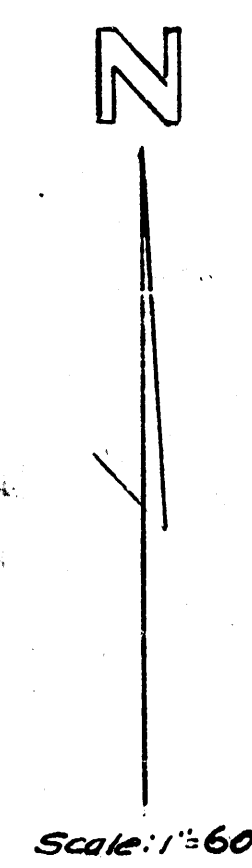


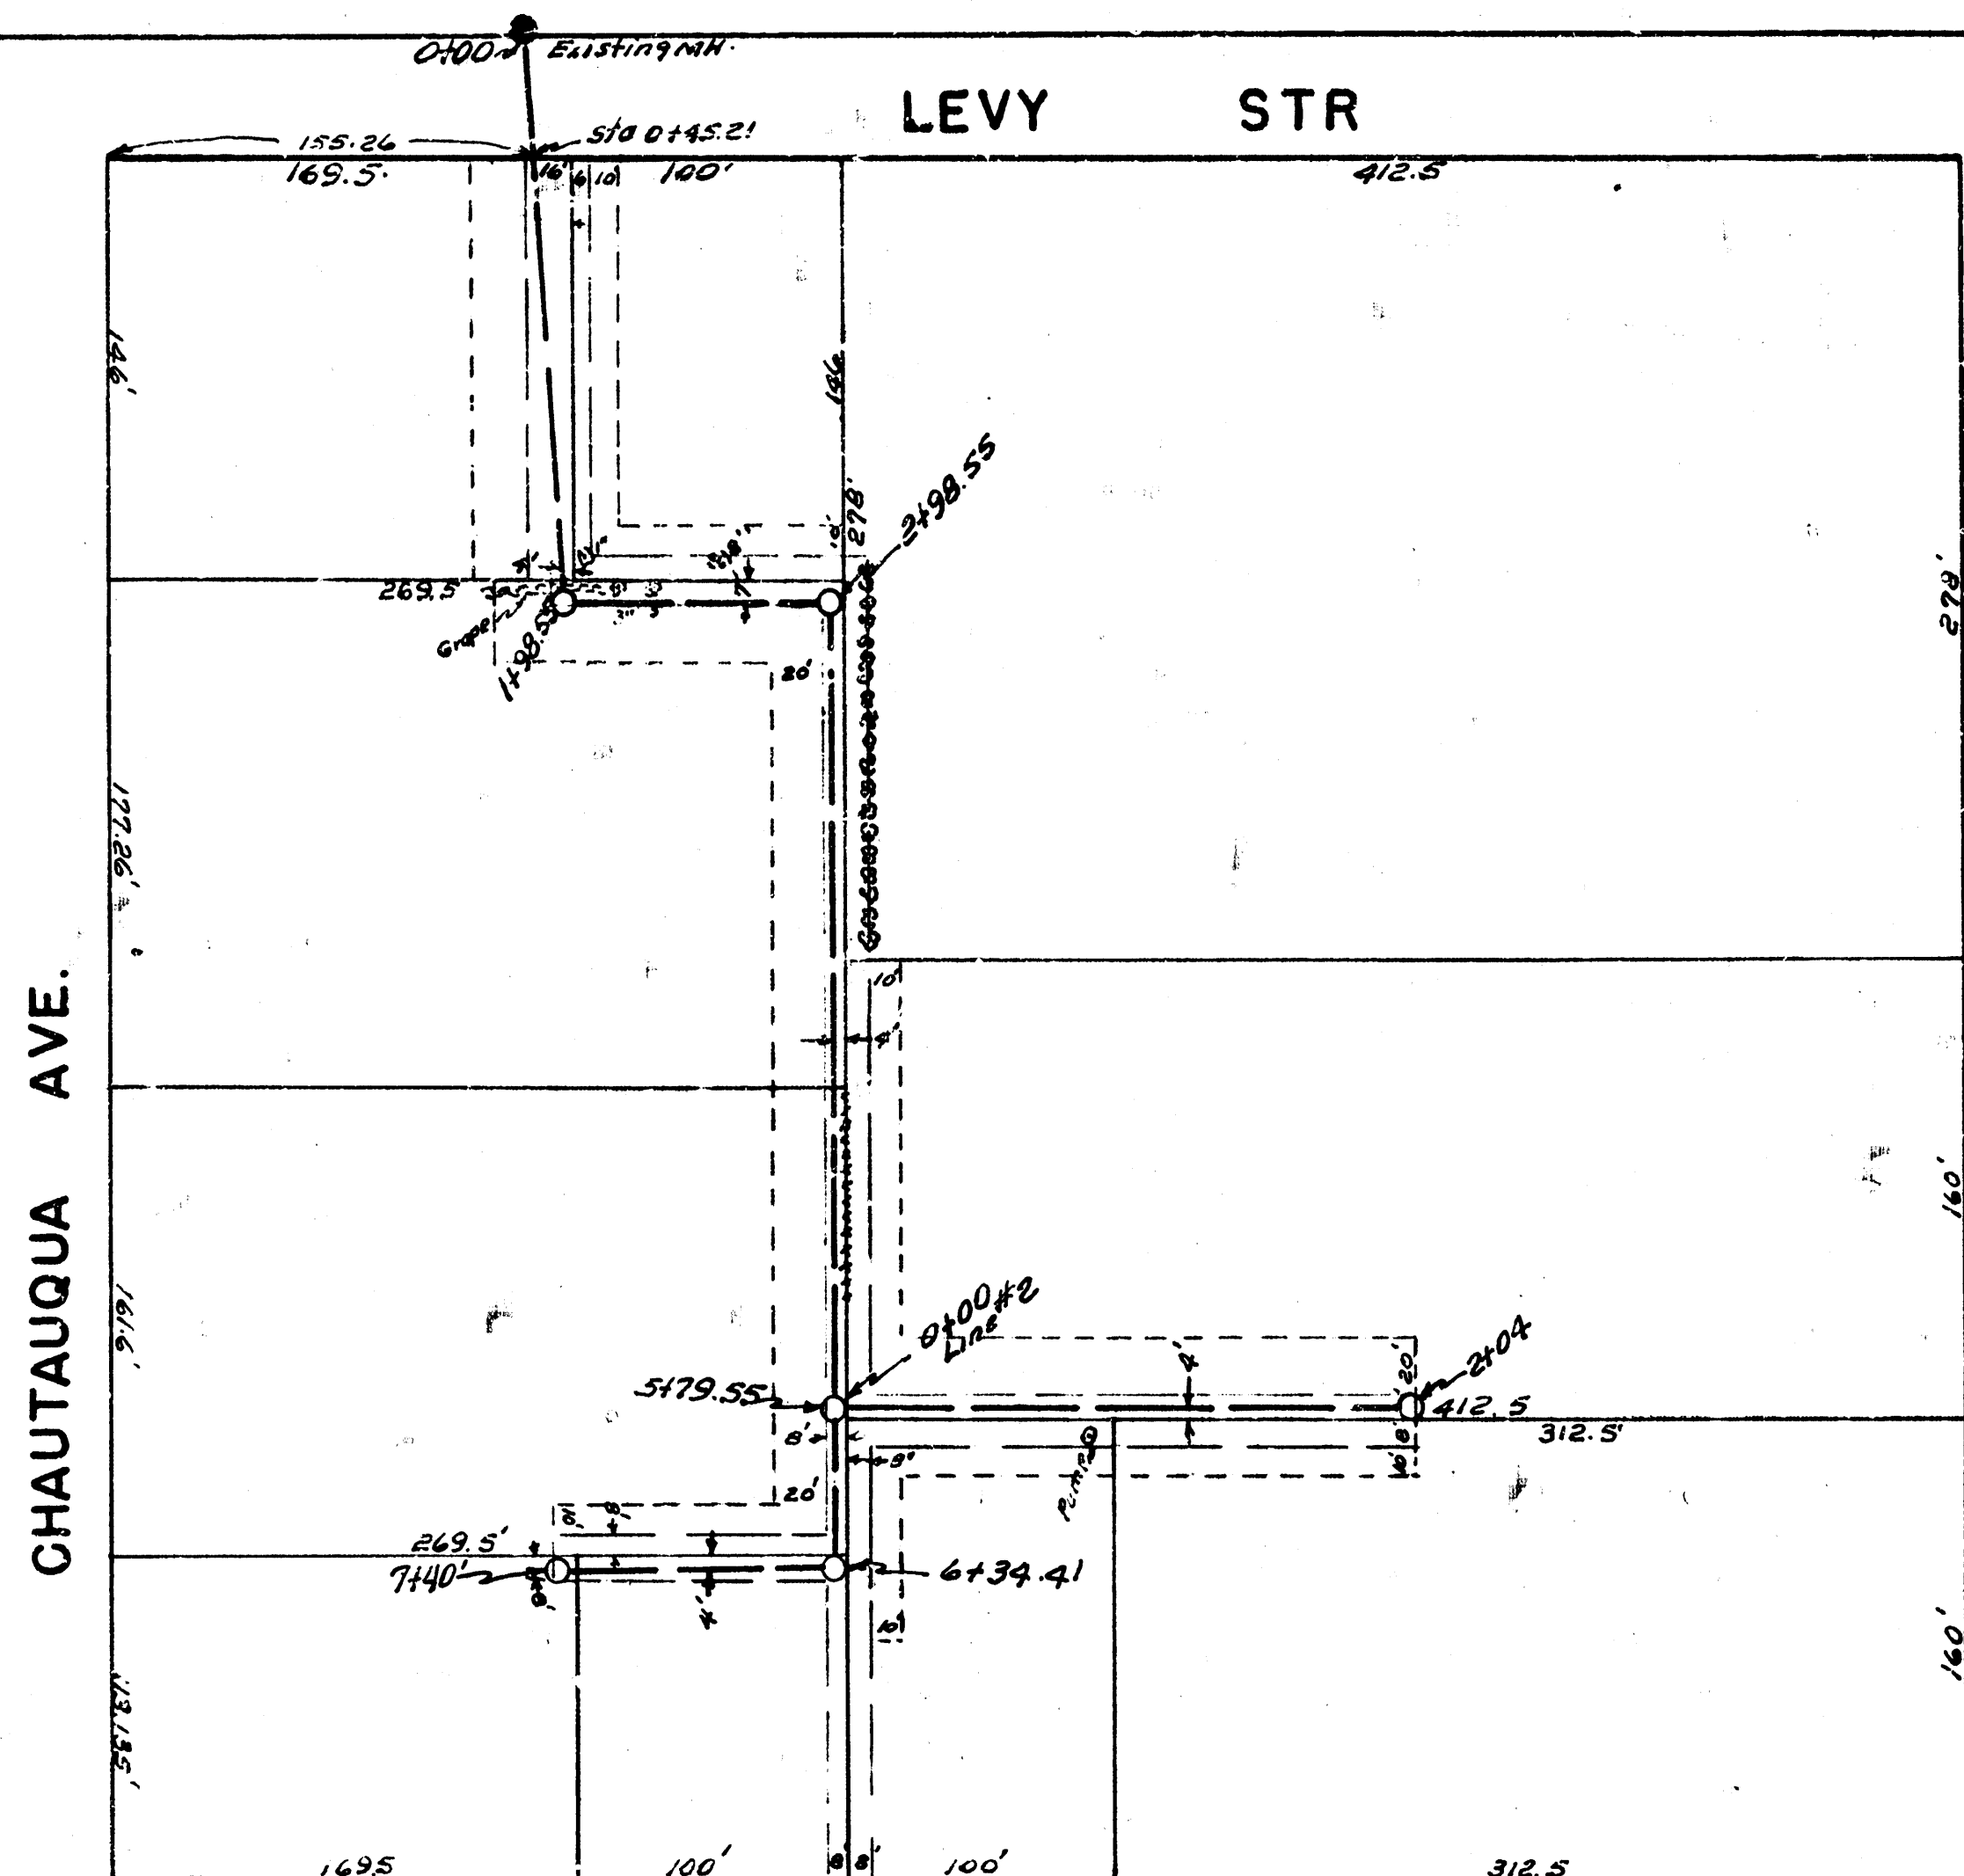

Date 9-19-52
Drawn by McElroy
Checked by
Block No. N-26

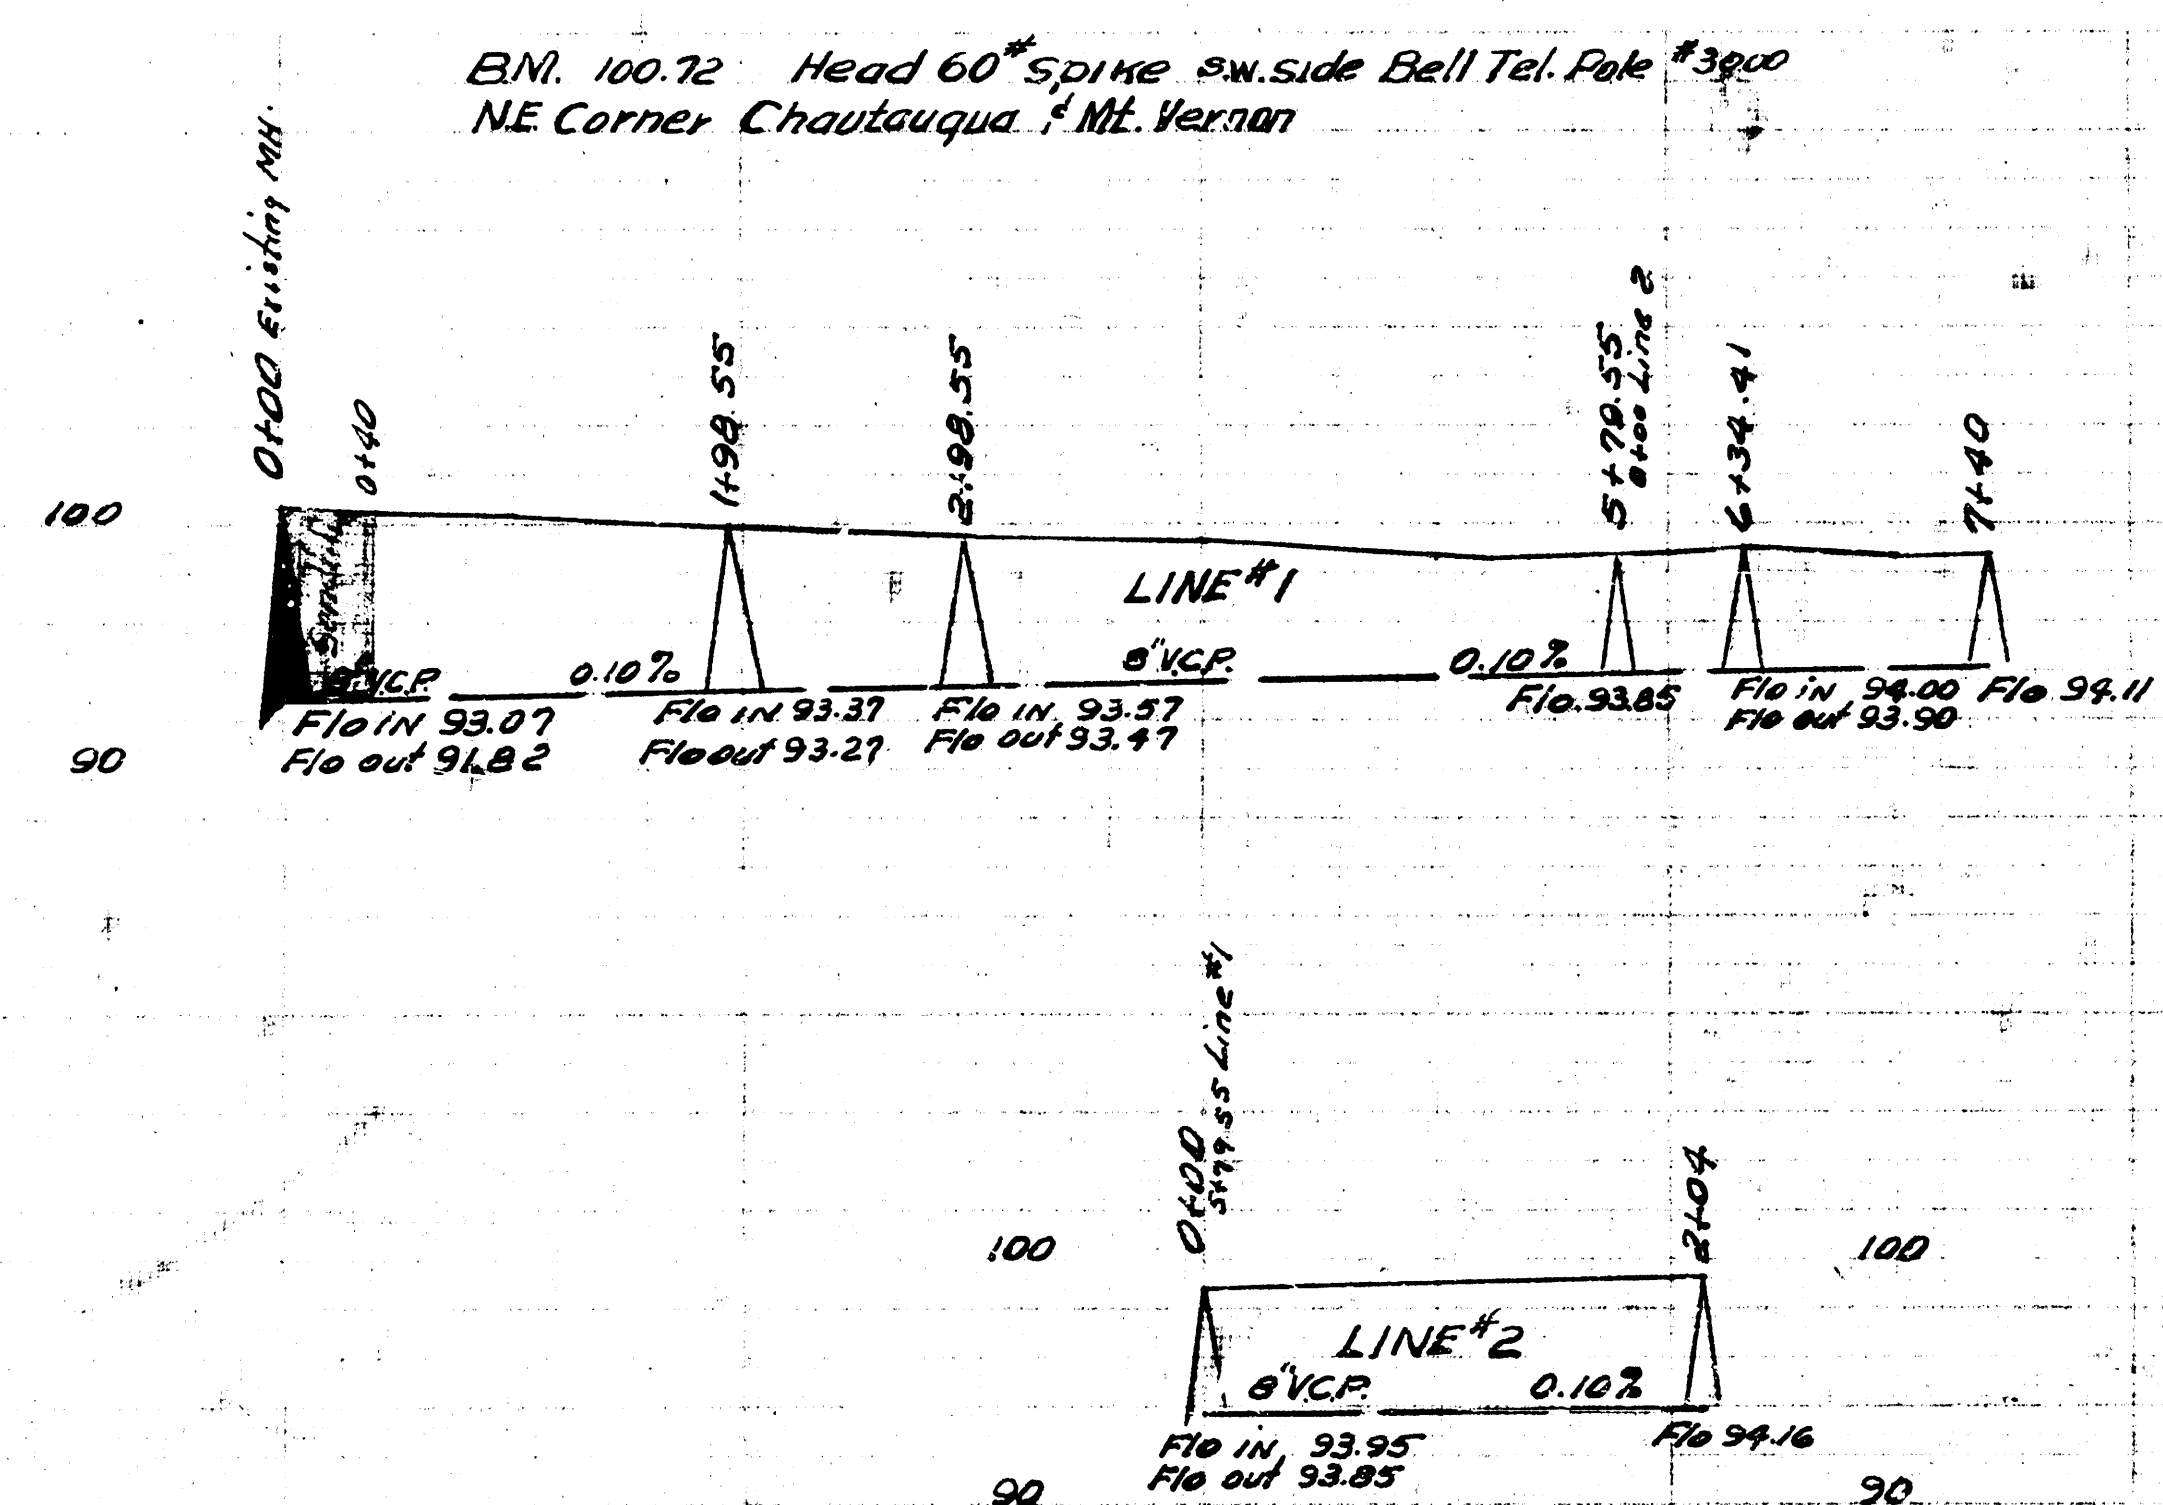

Date 9-23-52
Drawn by McElroy
Checked by
Block No. N-26

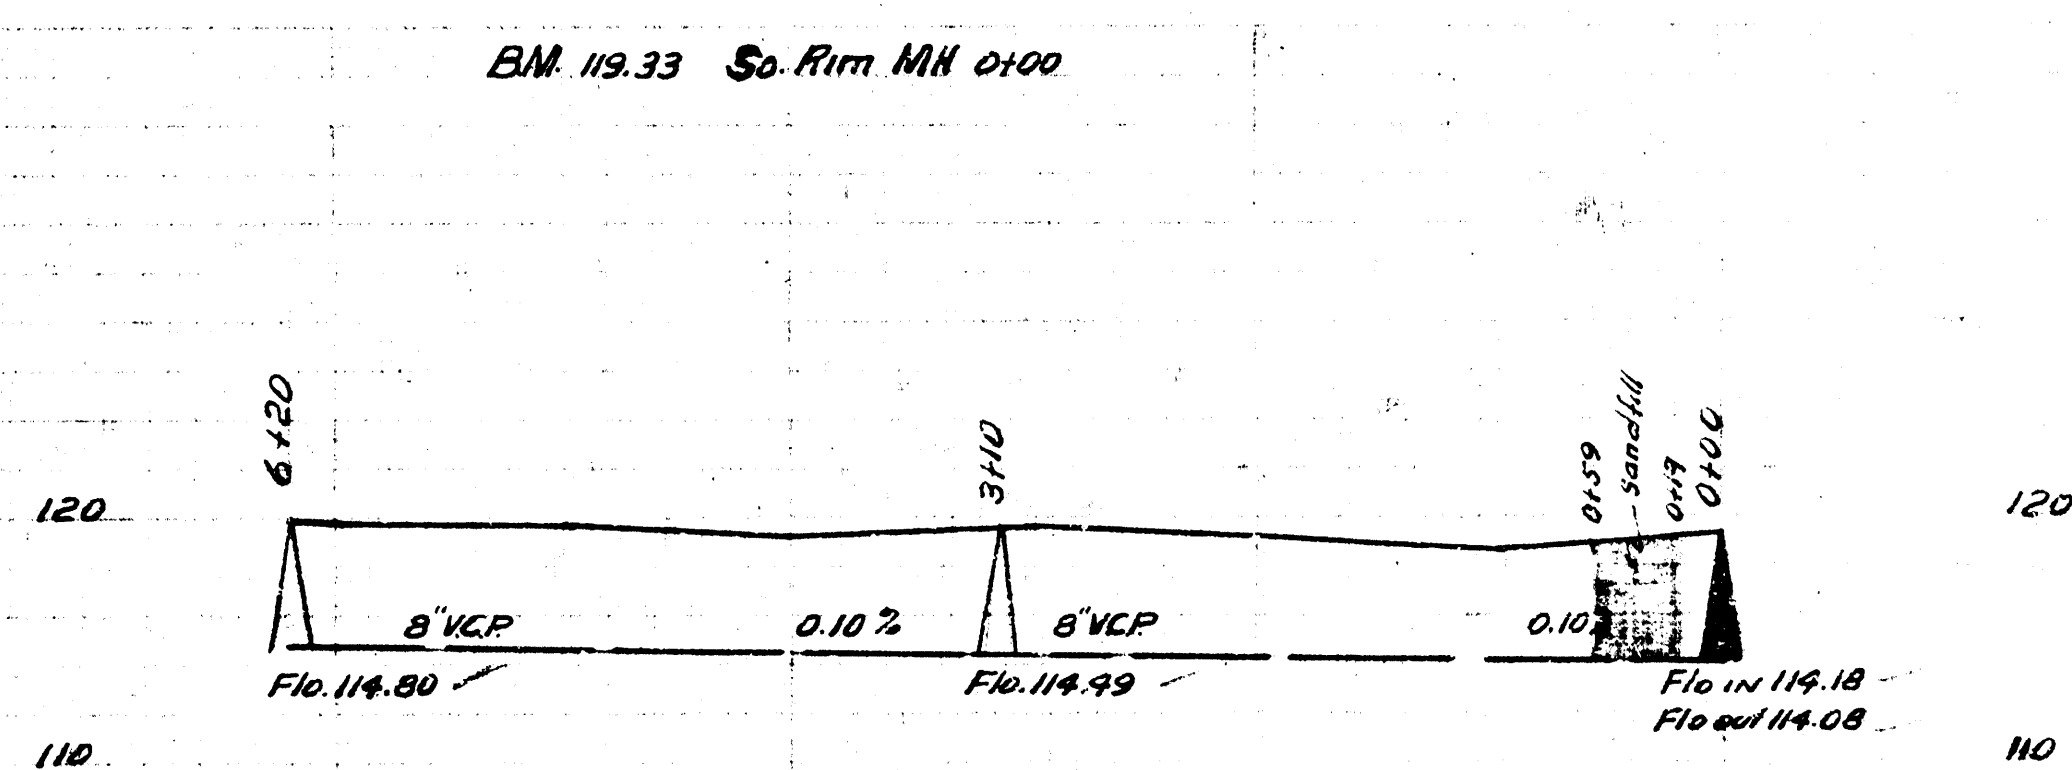

LAT 13 DGS 2 5512
CITY OF WICHITA KANSAS
LKW WHITE CITY ENGINEER
Proj No. C-22-79

LAT. Q DIST. D 5512
CITY OF WICHITA KANSAS
LKW WHITE CITY ENGINEER
Proj No. C-22-79

