

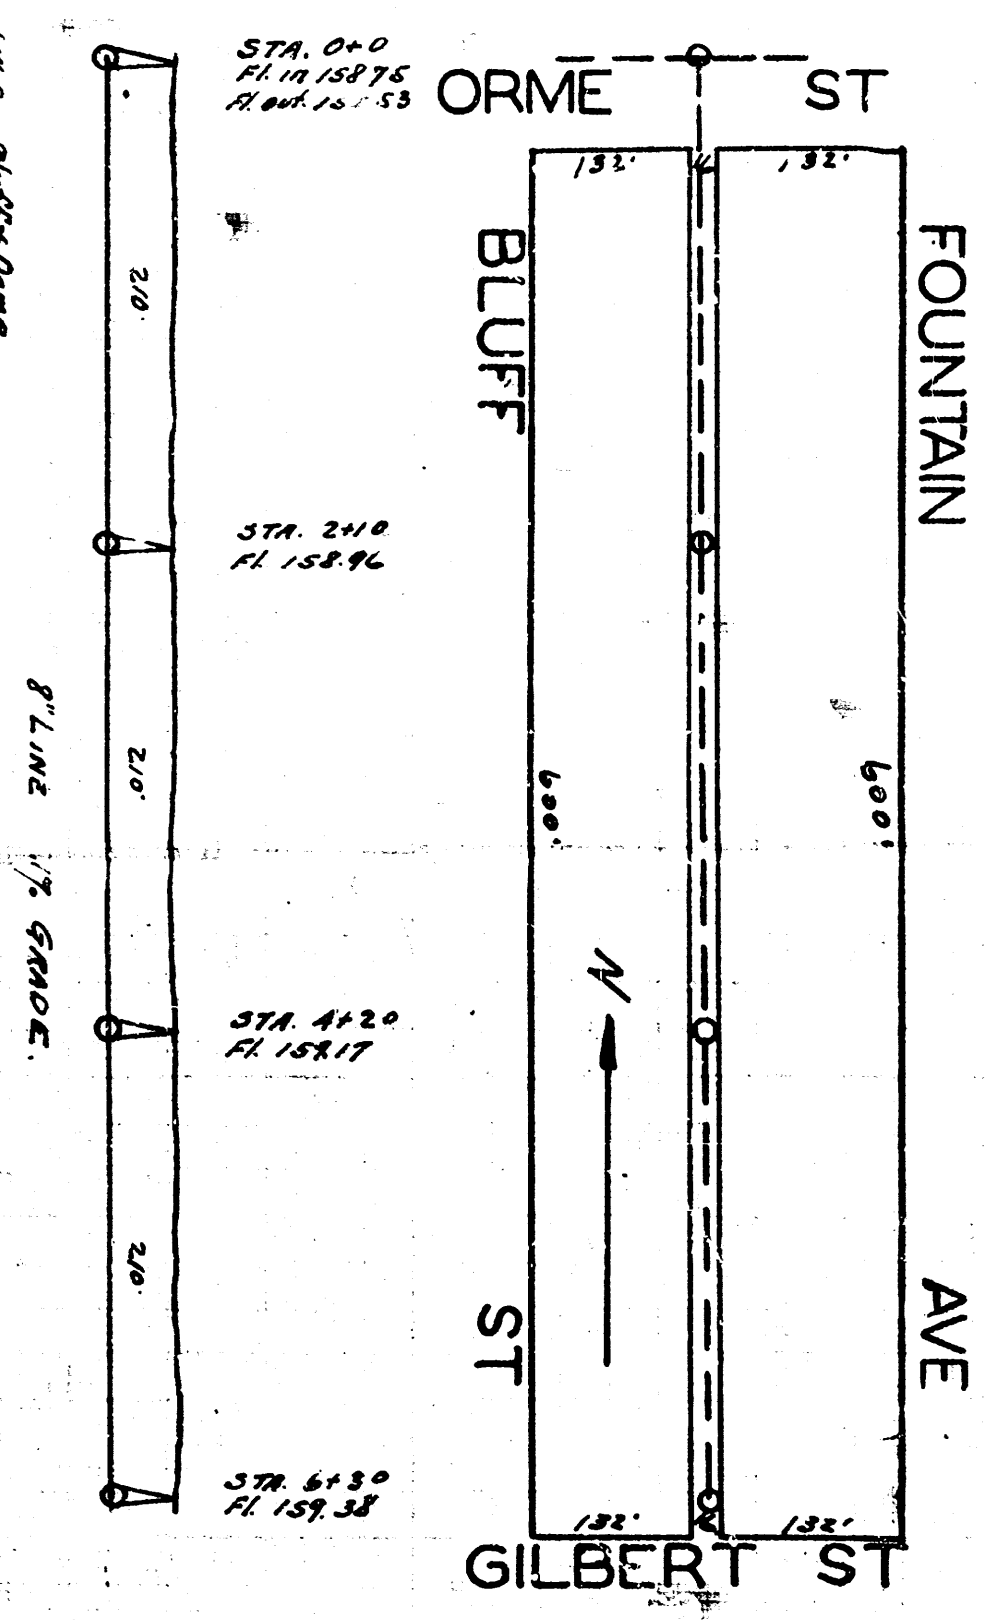








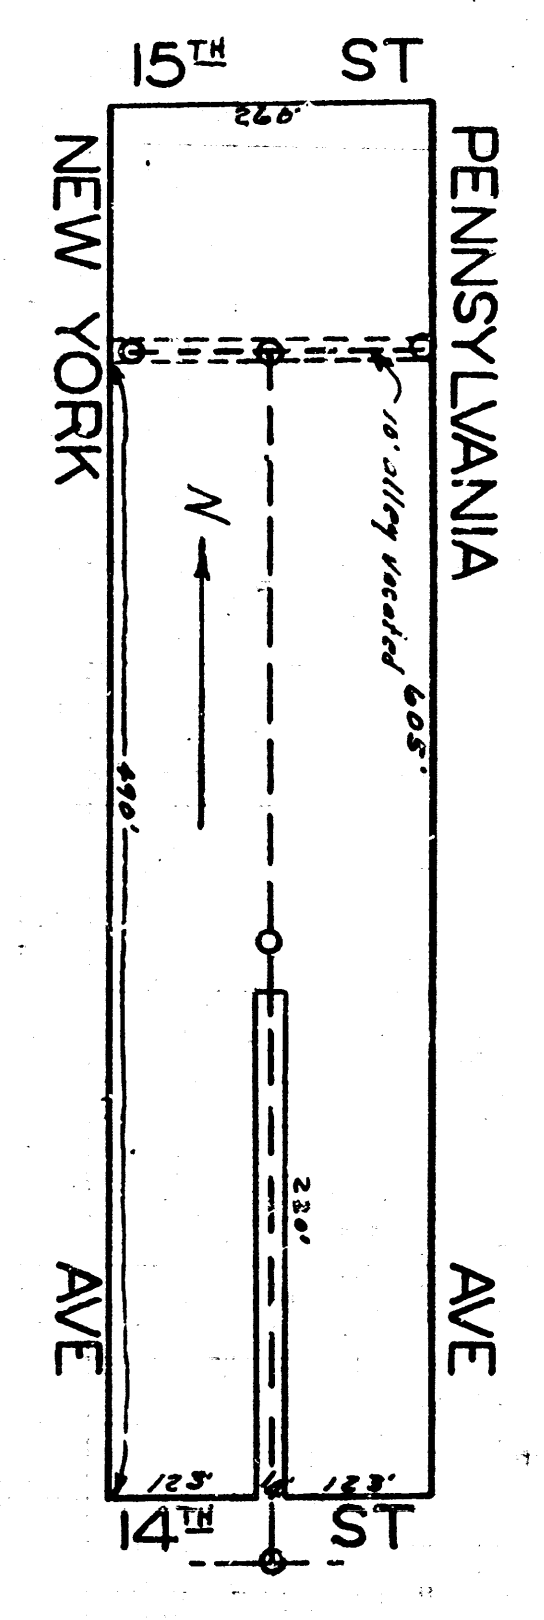

LAT. H, DIST. 6,
S.S. 12.

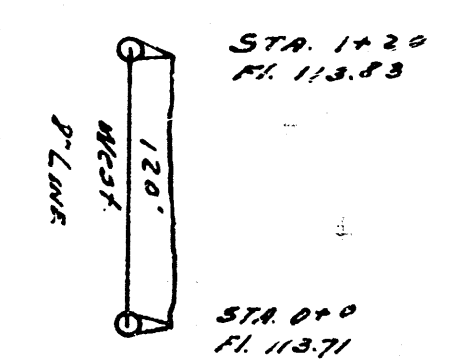

LAT. C, DIST. R, S.S. 12.

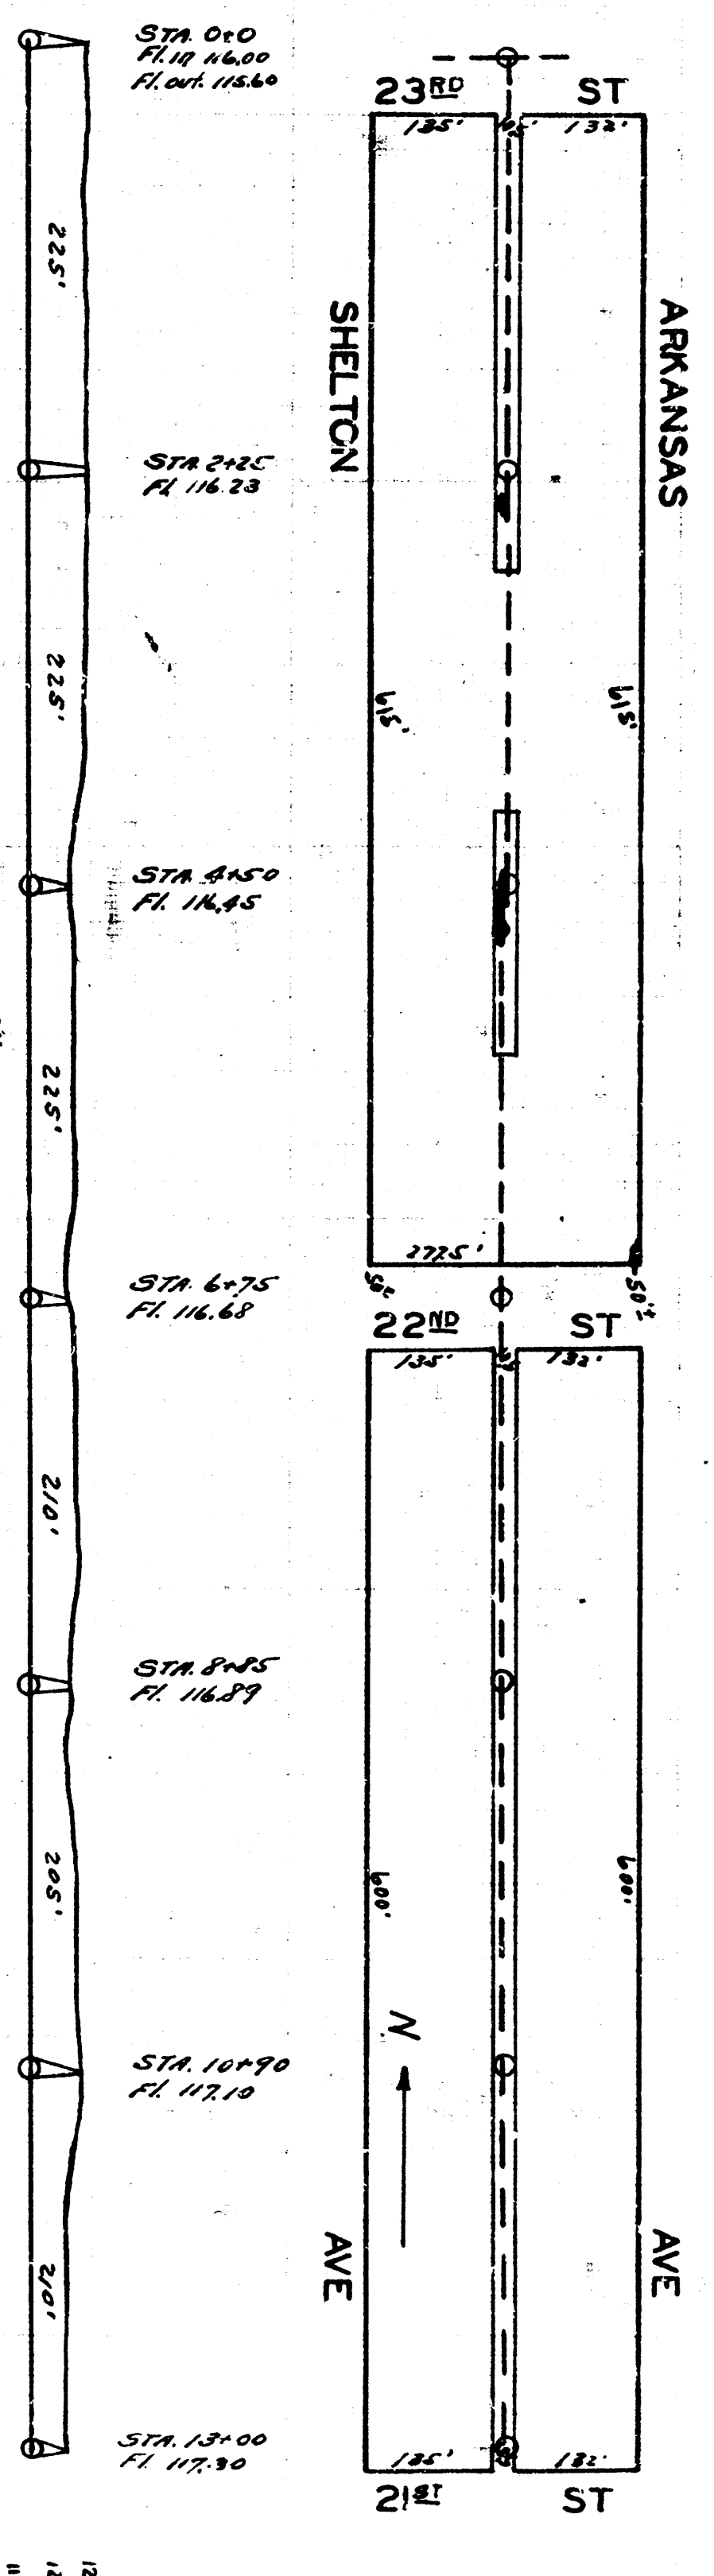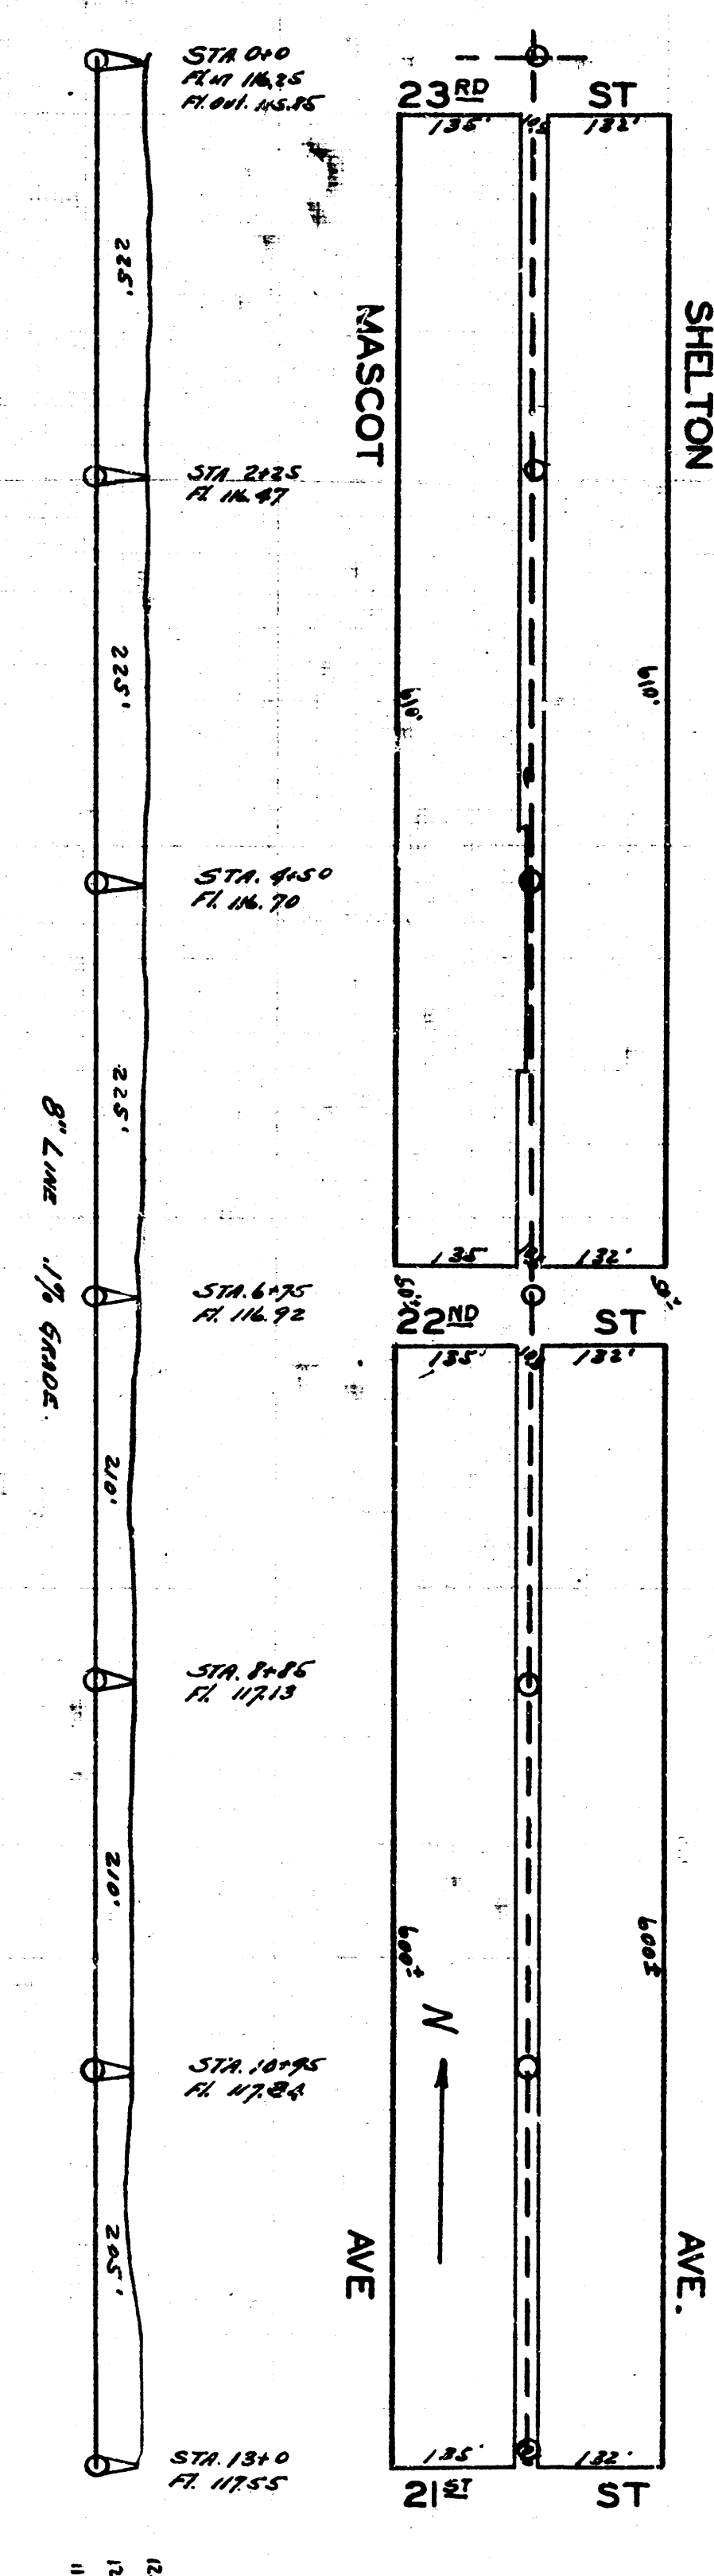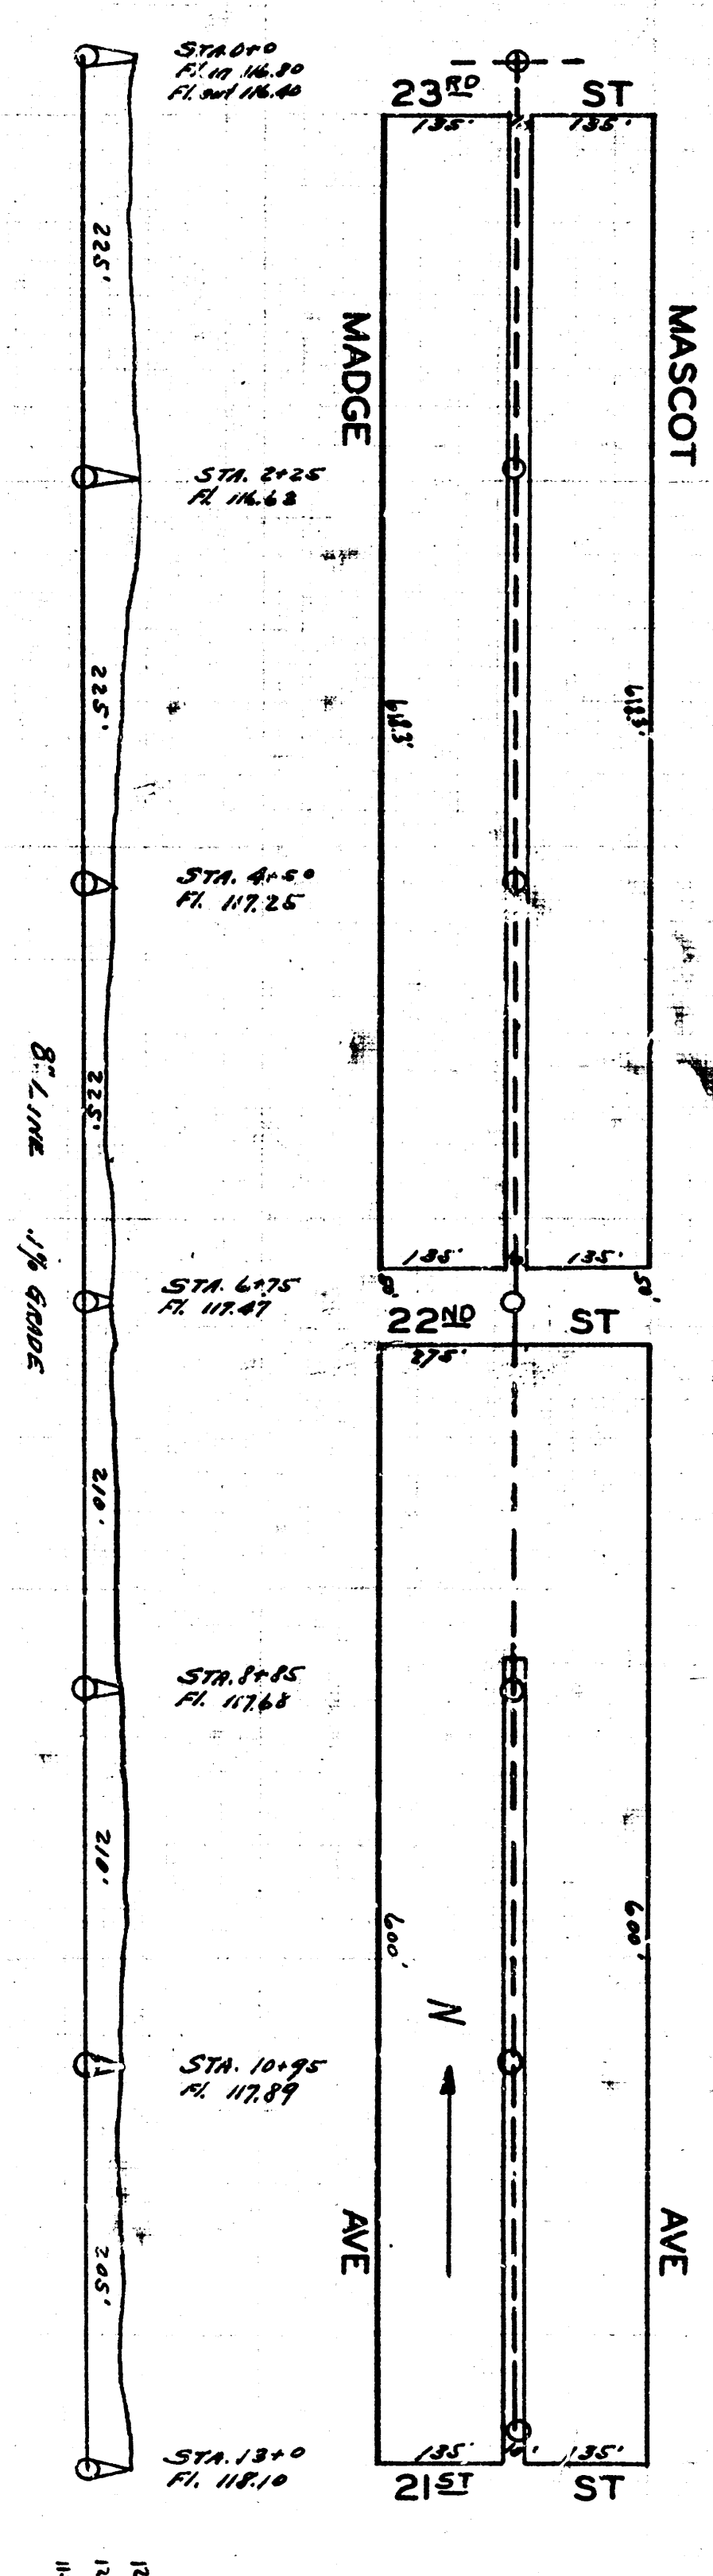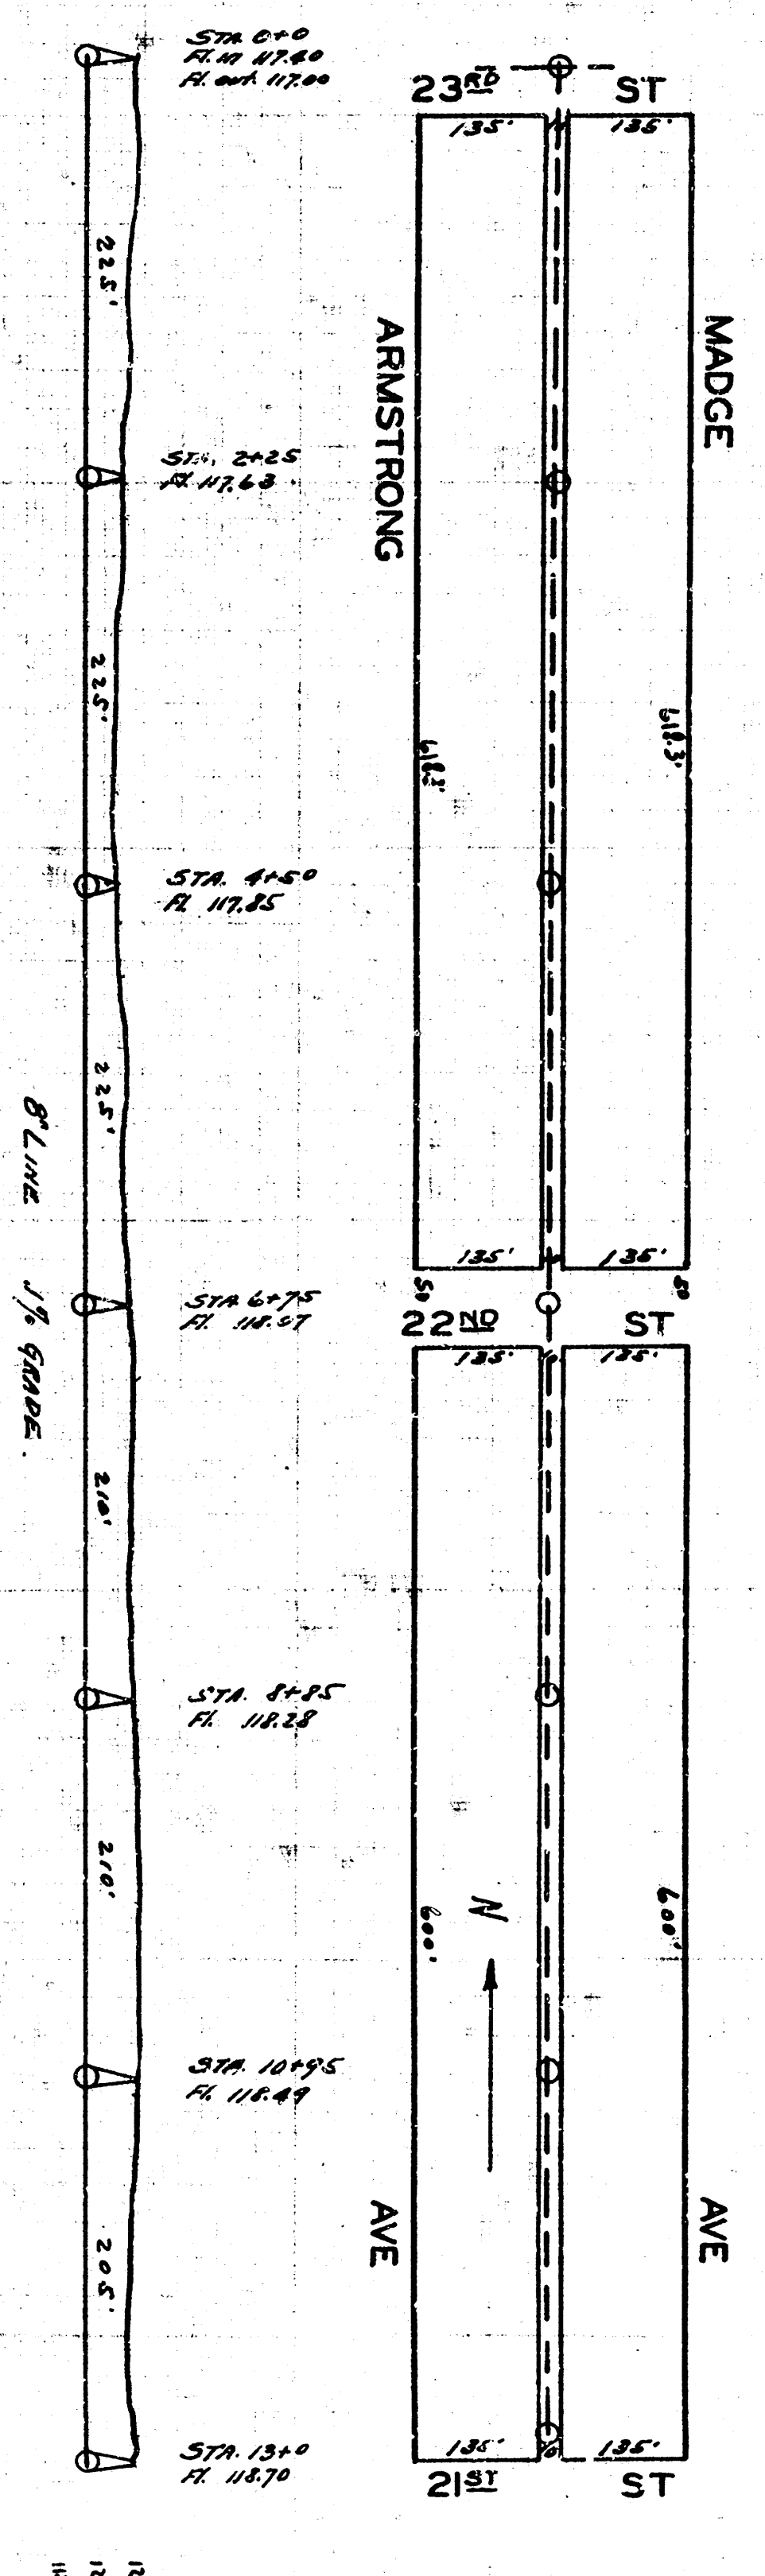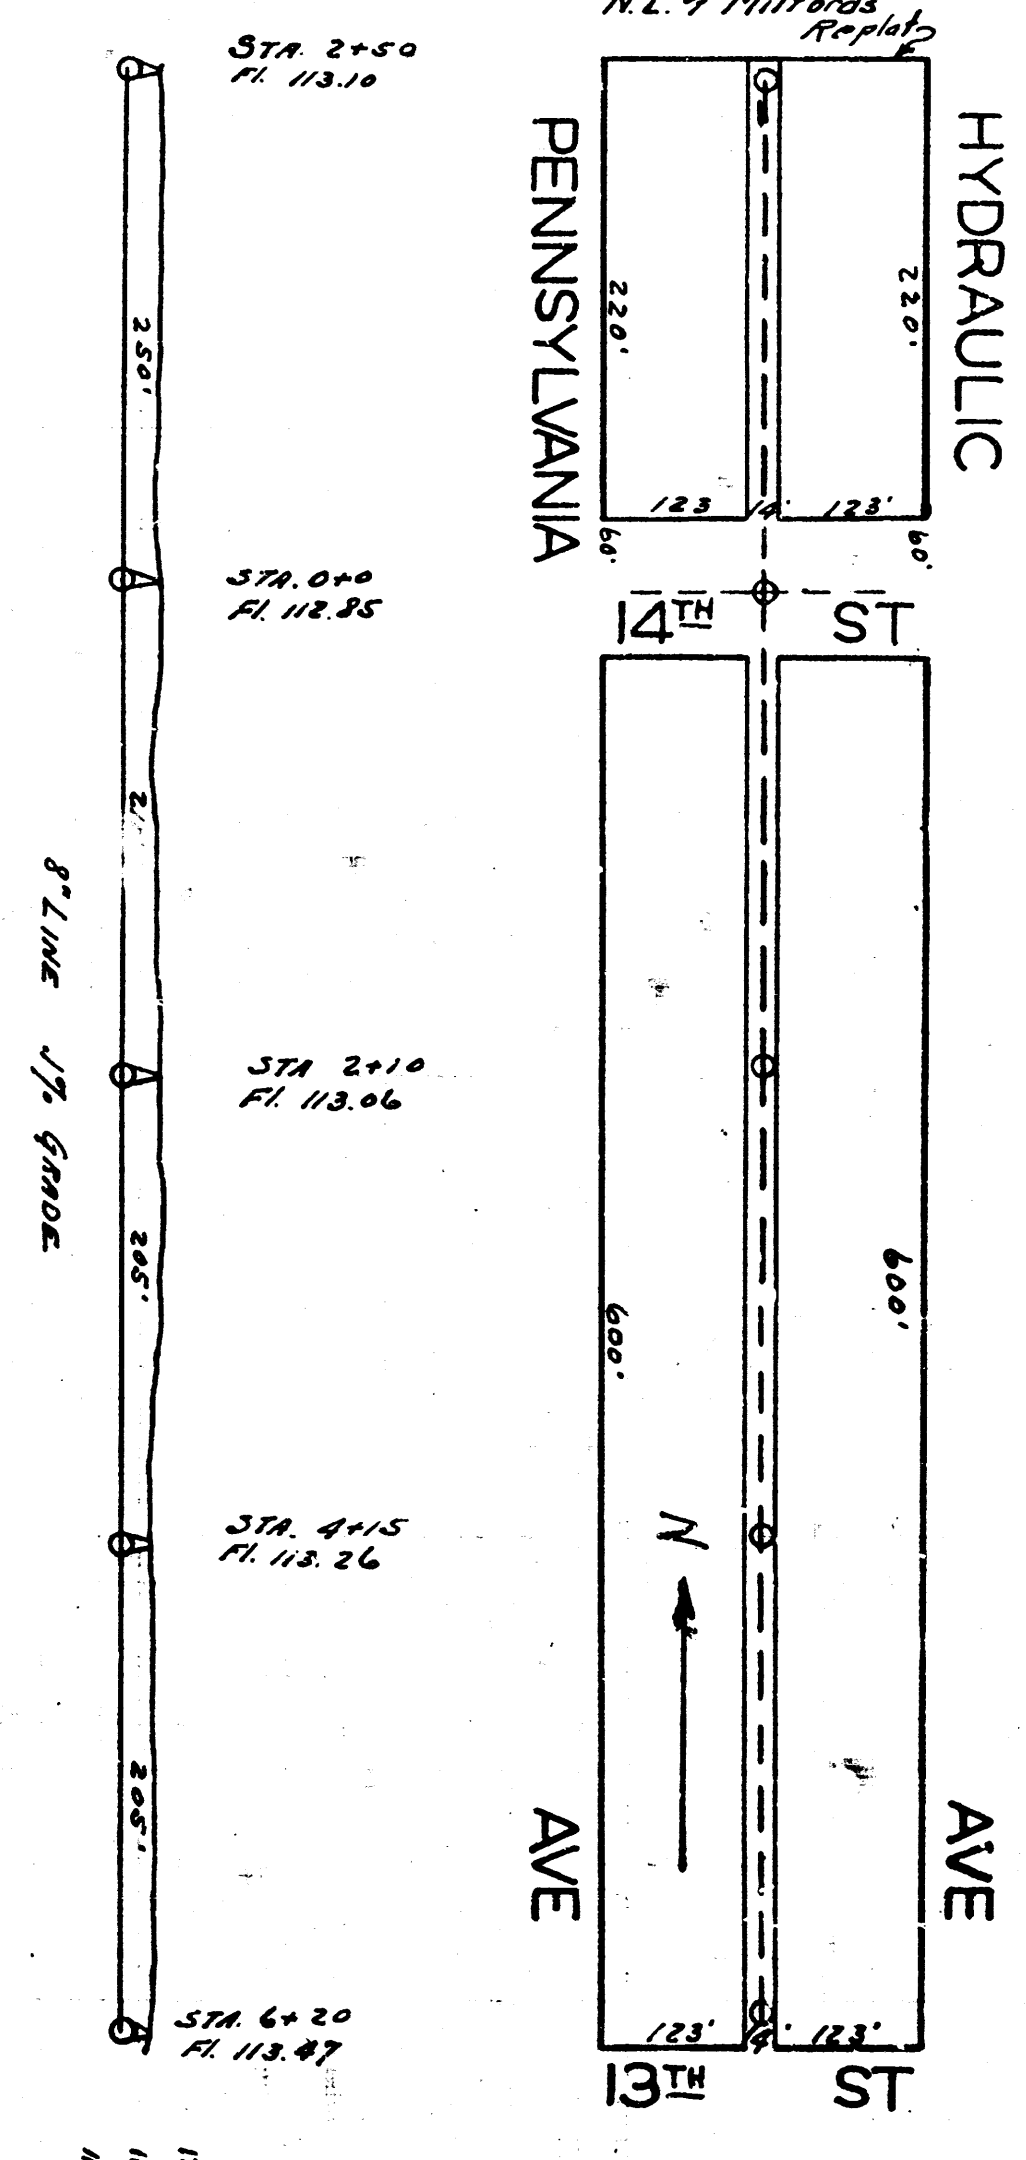

LAT. E, DIST. T, S.S. 20.

